
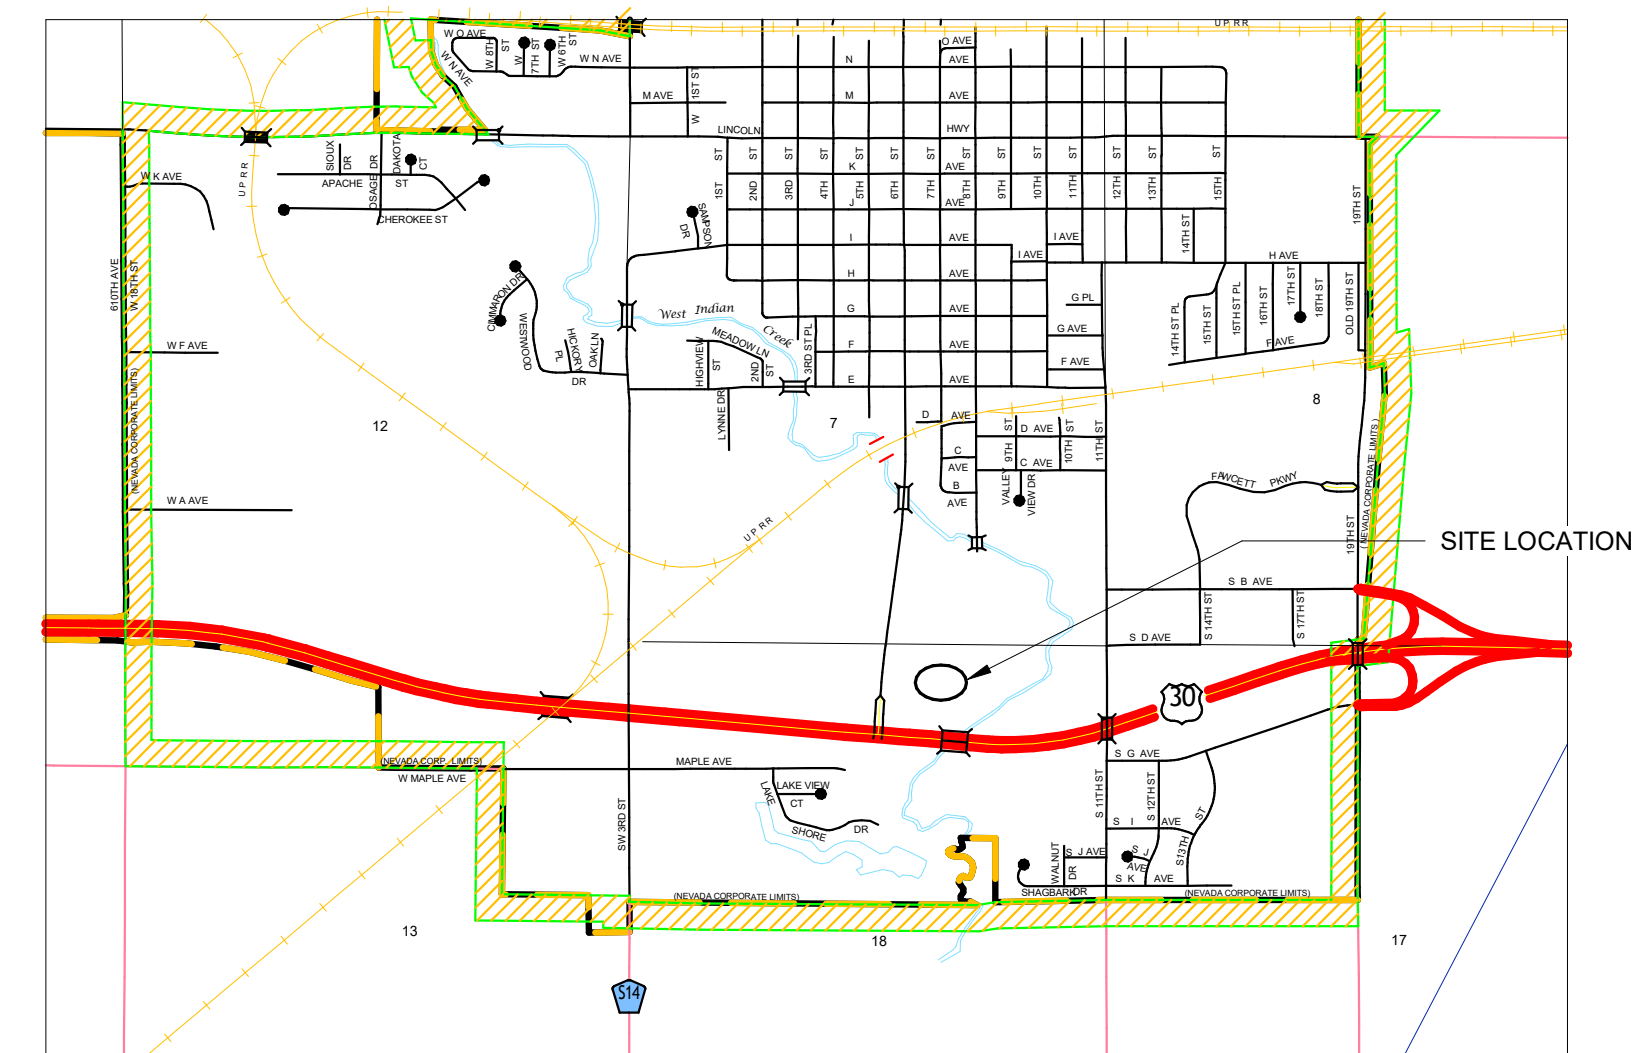


BOOMERANG

NEVADA WWTP IMPROVEMENTS LIMITED CONCRETE REPAIR

457 S. 6th STREET NEVADA IOWA 50201

STRUCTURAL DRAWINGS	
S0.00	NOTES
S1.01	PLAN
S1.02	TOP & BOTTOM OF SLAB EL. AT 952.5
S1.03	TOP & BOTTOM OF SLAB EL. AT 952.5
S2.01	WALL ELEVATIONS
S2.02	WALL ELEVATIONS
S2.03	WALL ELEVATIONS
S2.33	WALL ELEVATIONS
S3.01	CONCRETE REPAIR DETAILS

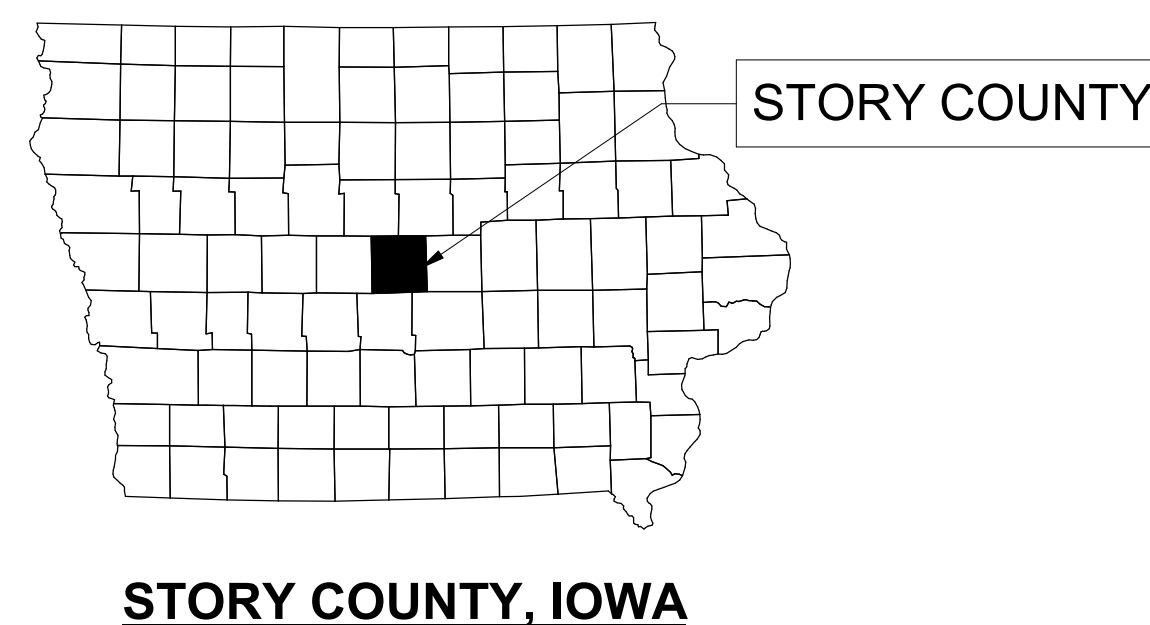

LOCATION MAP



SHUCK
BRITSON

400 E COURT AVENUE
DES MOINES, IOWA 50309
PH 515/243-4477
FAX 515/243-4479

GENERAL

1. THE CONTRACTOR SHALL VERIFY ALL EXISTING DIMENSIONS PRIOR TO COMMENCING FABRICATION OR CONSTRUCTION.
2. IT SHALL BE THE RESPONSIBILITY OF THE CONTRACTOR TO ACQUAINT THEMSELVES AND ALL SUPERVISORY PERSONNEL WITH ALL DRAWINGS AND DOCUMENTS.
3. ALL CONSTRUCTION SHALL CONFORM TO INTERNATIONAL BUILDING CODE 2015 AND THE ORIGINAL DRAWINGS BY HR GREEN DATED 9/27/2021 UNLESS NOTED OTHERWISE.
4. IF CONFLICTS ARE FOUND BETWEEN DETAILS SHOWN ON THESE PLANS AND OTHER DISCIPLINES' PLANS OR MANUFACTURERS PRODUCTS, NOTIFY ENGINEER IMMEDIATELY FOR CLARIFICATION PRIOR TO PERFORMING WORK.
5. ALL MATERIALS TO BE USED IN STRICT ACCORDANCE WITH MANUFACTURERS RECOMMENDATIONS.
6. QUALITY CONTROL OF REPAIRS; ALL METHODS IN ORIGINAL CONTRACT AND PERIODIC REVIEWS AND OBSERVATIONS BY SBI.
7. QUESTIONS OF SOME AS-BUILT REINFORCED CONCRETE WALL ITEMS FOR NEVADA WWTF IMPROVEMENTS – PHASE 3 WERE IDENTIFIED IN:
 - A. HRGREEN LETTER DATED 2022-10-17
 - B. HRGREEN LETTER DATED 2022-12-07
 - C. HRGREEN LETTER DATED 2023-03-02

PROCESS TO PROVIDE RESPONSES TO THESE QUESTIONS:

- A. LOCATE ITEMS
 - i. TERRACON GEOPHYSICAL EXPLORATION REPORT DATED 2022-12-01
 - ii. SBI SITE VISITS DATED 2023-02-13, 2023-03-08, 2023-03-23 TECHNIQUES USED INCLUDED OBSERVATION AND SURFACE SOUNDING (HAMMER TAP)
 - iii. ADDITIONAL TEST LOCATION IDENTIFIED ON THESE PLANS
 - B. REPAIR EACH ITEM THAT IS LOCATED
 - i. THESE REPAIR PLANS AND ATTACHMENTS ARE INTENDED TO CLEARLY AND CONCISELY DOCUMENT THE ITEMS LOCATED ABOVE AND INDICATE THE REPAIR FOR EACH ITEM.
 - C. DOCUMENT REPAIR
 - i. PHOTOGRAPH PREPARED AREA.
 - ii. PHOTOGRAPH FINAL REPAIRED AREA.
8. PRODUCT DATA ATTACHMENTS:
 - A. SIKAGARD - 62
 - B. SIKACRETE - 211 SCC PLUS
 - C. SIKA ARMATEC -110 EPOCEM
 - D. SIKAQUICK FNP
 - E. SIKAQUICK VOH

CONCRETE

1. ALL CONCRETE REPAIR SHALL BE IN ACCORDANCE WITH ACI 562 CURRENT EDITION.
2. CONCRETE TO BE IN ACCORDANCE WITH "SPECIFICATIONS FOR STRUCTURAL CONCRETE FOR BUILDINGS (ACI 301 CURRENT EDITION)".
3. CLEAR DISTANCE FROM FACE OF CONCRETE TO NEAR REINFORCING BAR TO BE: PER THE ORIGINAL HRGREEN DRAWINGS OR AS INDICATED ON THE WALL ELEVATIONS.

DEMOLITION AND REPAIRS

1. ENSURE SAFE PASSAGE OF PERSONS AROUND AREA OF DEMOLITION AND CONSTRUCTION. CONDUCT OPERATIONS TO PREVENT INJURY TO STRUCTURES, EQUIPMENT, OTHER FACILITIES AND PERSONS.
2. ALL REMOVALS OF EXISTING CONCRETE SHALL BE INITIATED WITH A NEAT, 1/2" DEEP STRAIGHT SAW CUT.
3. PROTECT EXISTING REINFORCING STEEL IN PLACE. EXERCISE EXTREME CARE TO AVOID DAMAGING EXISTING REINFORCEMENT.
4. EXACT LOCATION OF EXISTING REINFORCEMENT IS TO BE DETERMINED BY THE CONTRACTOR USING A REBAR LOCATOR OR SIMILAR METHOD.
5. LOCATE HOLES FOR ANCHORS/FASTENER TO AVOID EXISTING REINFORCEMENT.
6. IN THE EVENT OF CONFLICTS, NOTIFY ENGINEER PRIOR TO FIELD MODIFICATIONS OF DETAILS, CONNECTIONS, OR DIMENSIONS SHOWN ON THE DRAWINGS.



SHUCK - BRITSON

400 E COURT AVE.
SUITE 140.
DES MOINES, IOWA 50309
515-243-4477
www.shuck-britson.com

NEVADA WWTP IMPROVEMENTS LIMITED
CONCRETE REPAIR

BOOMERANG
457 S. 6th STREET NEVADA IOWA 50201

Project Status


PROJECT NUMBER 123.0172.03

DATE 01/20/2025

NOTES

SHEET NO.

S0.00

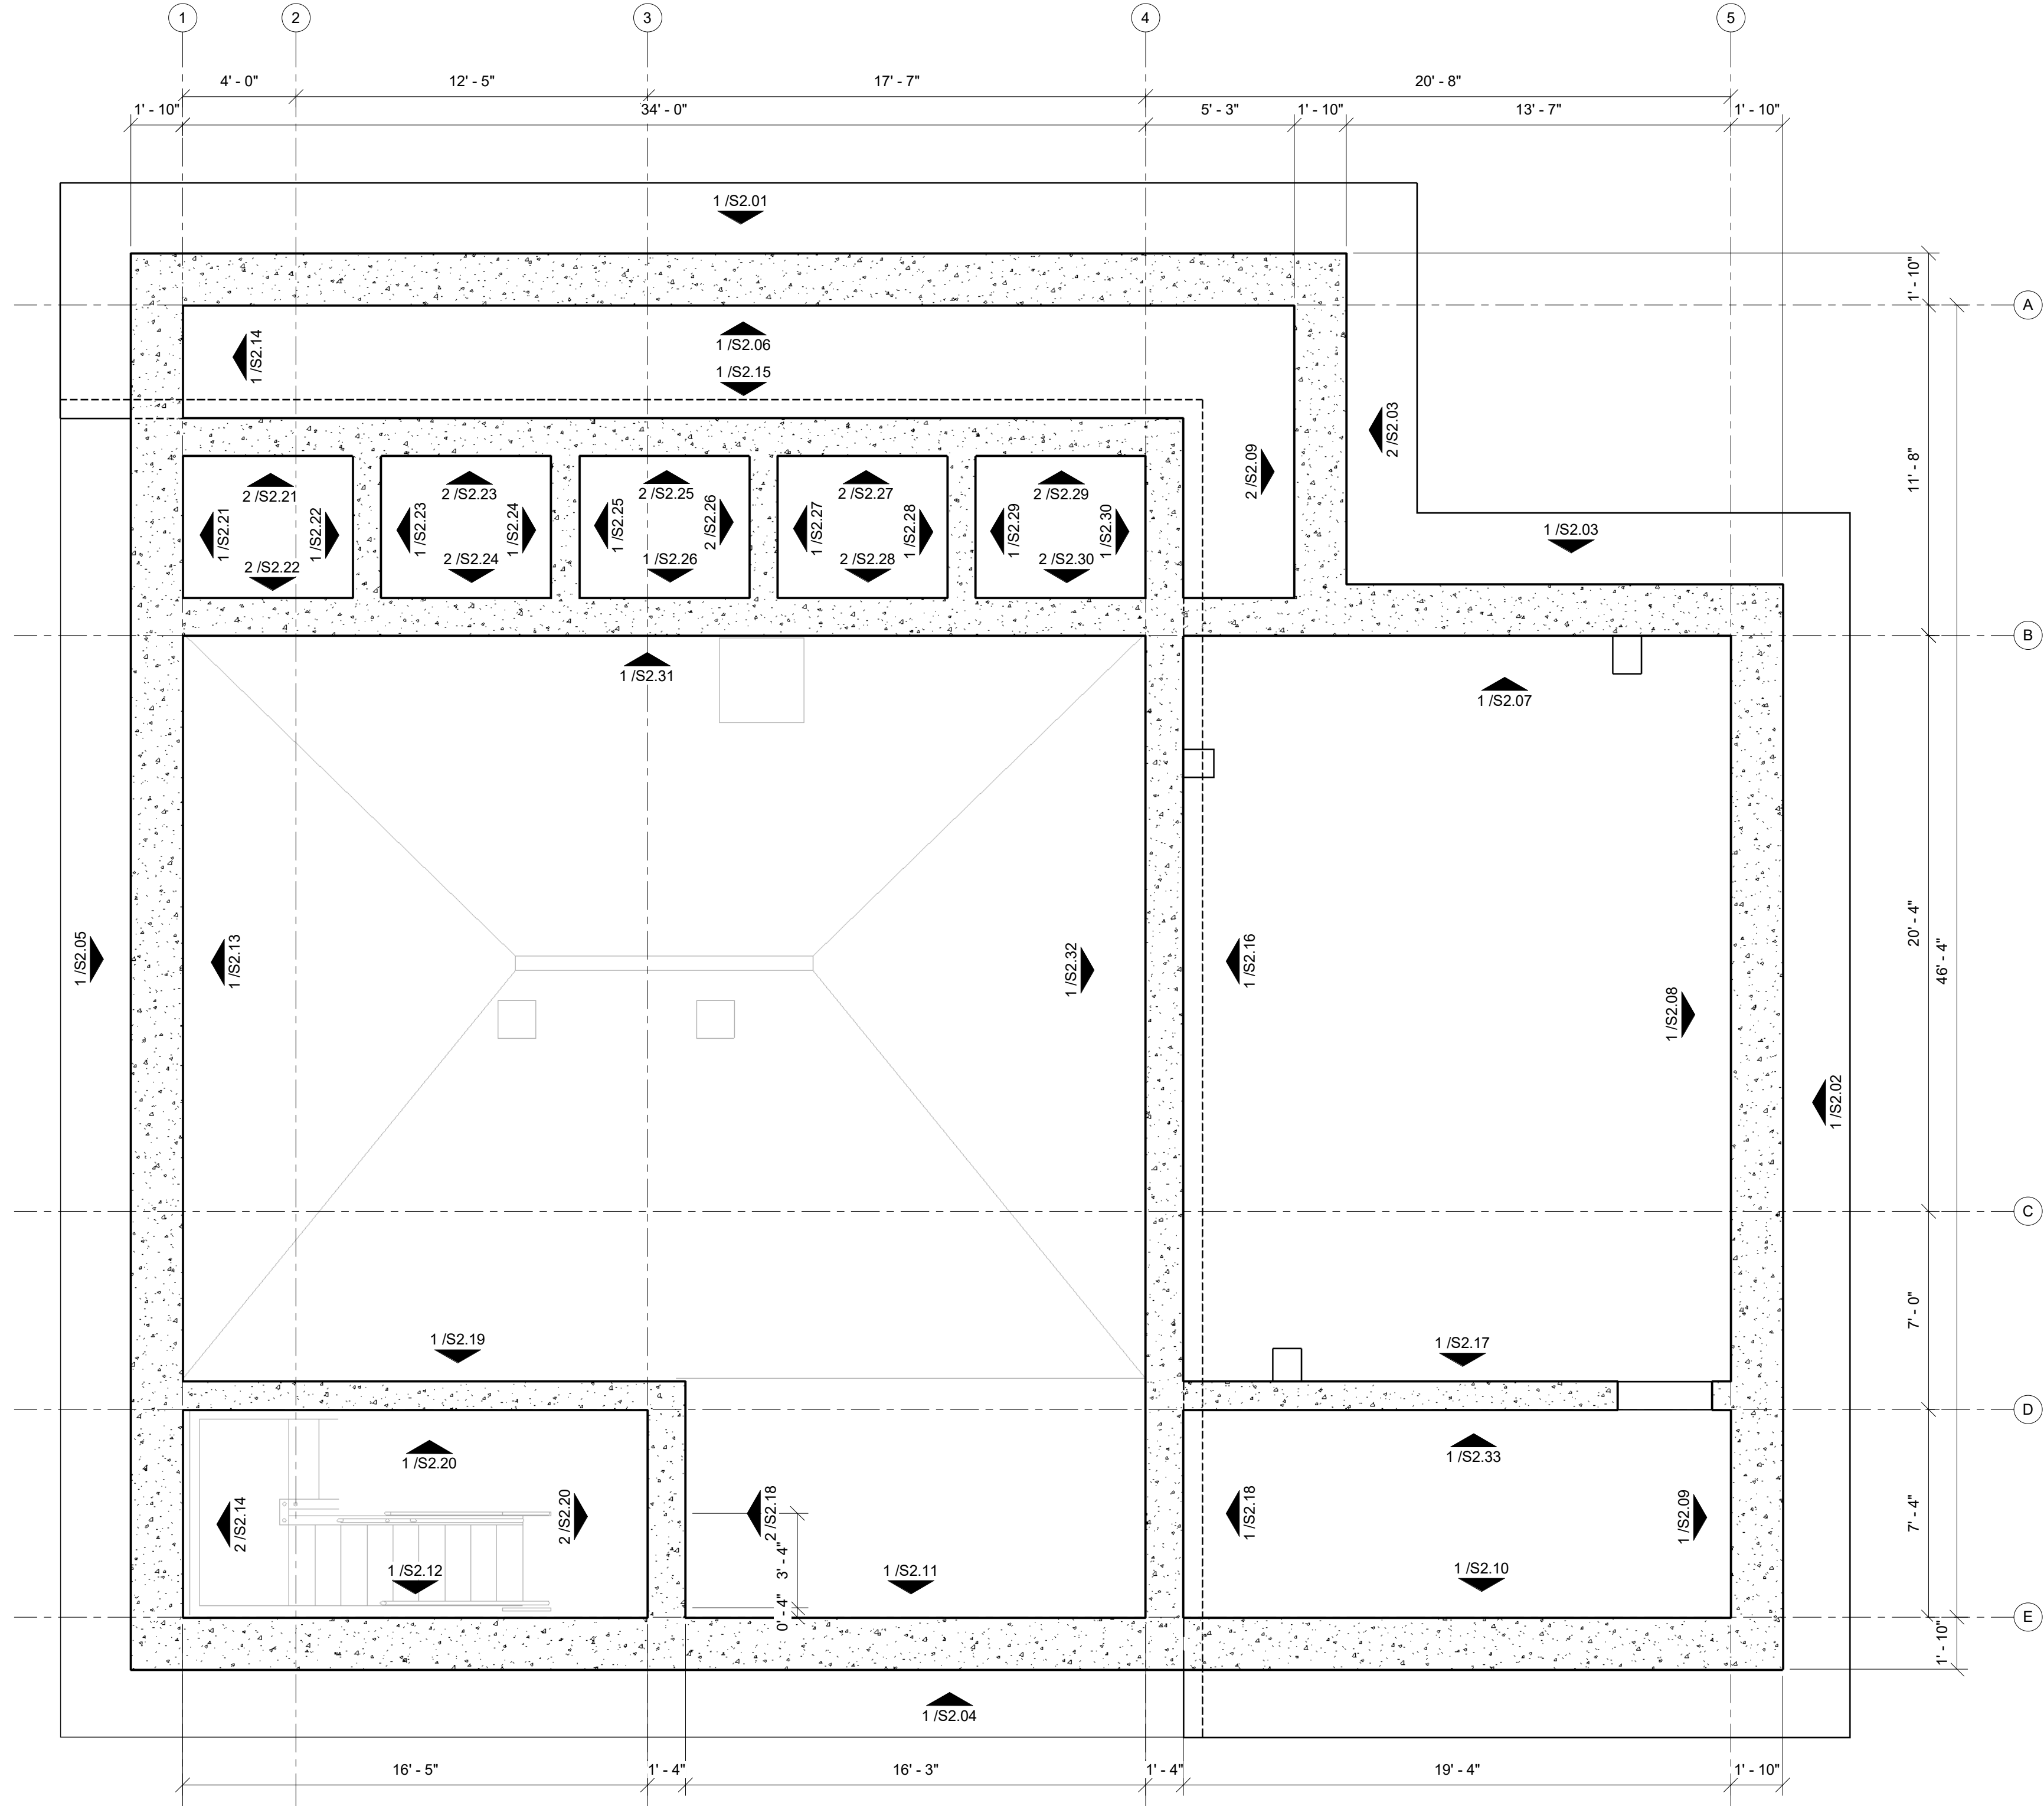

4 SITE PLAN

1/4" = 1'-0"

NOTE : DIMENSIONS BASED UPON ORIGINAL DRAWINGS BY HRGREEN. FIELD VERIFY ALL DIMENSIONS. SEE ORIGINAL DRAWINGS FOR CONCRETE DETAILS AND REINFORCING.



SHUCK BRITSON

400 E COURT AVE.
SUITE 140.
DES MOINES, IOWA 50309
515-243-4477
www.shuck-britson.com

NEVADA WWTP IMPROVEMENTS LIMITED
CONCRETE WALL REPAIR

BOOMERANG

457 S. 6th STREET NEVADA IOWA 50201

Project Status


PROJECT NUMBER 123.0172.03

DATE 03/24/2023


PLAN

SHEET NO.

S1.01

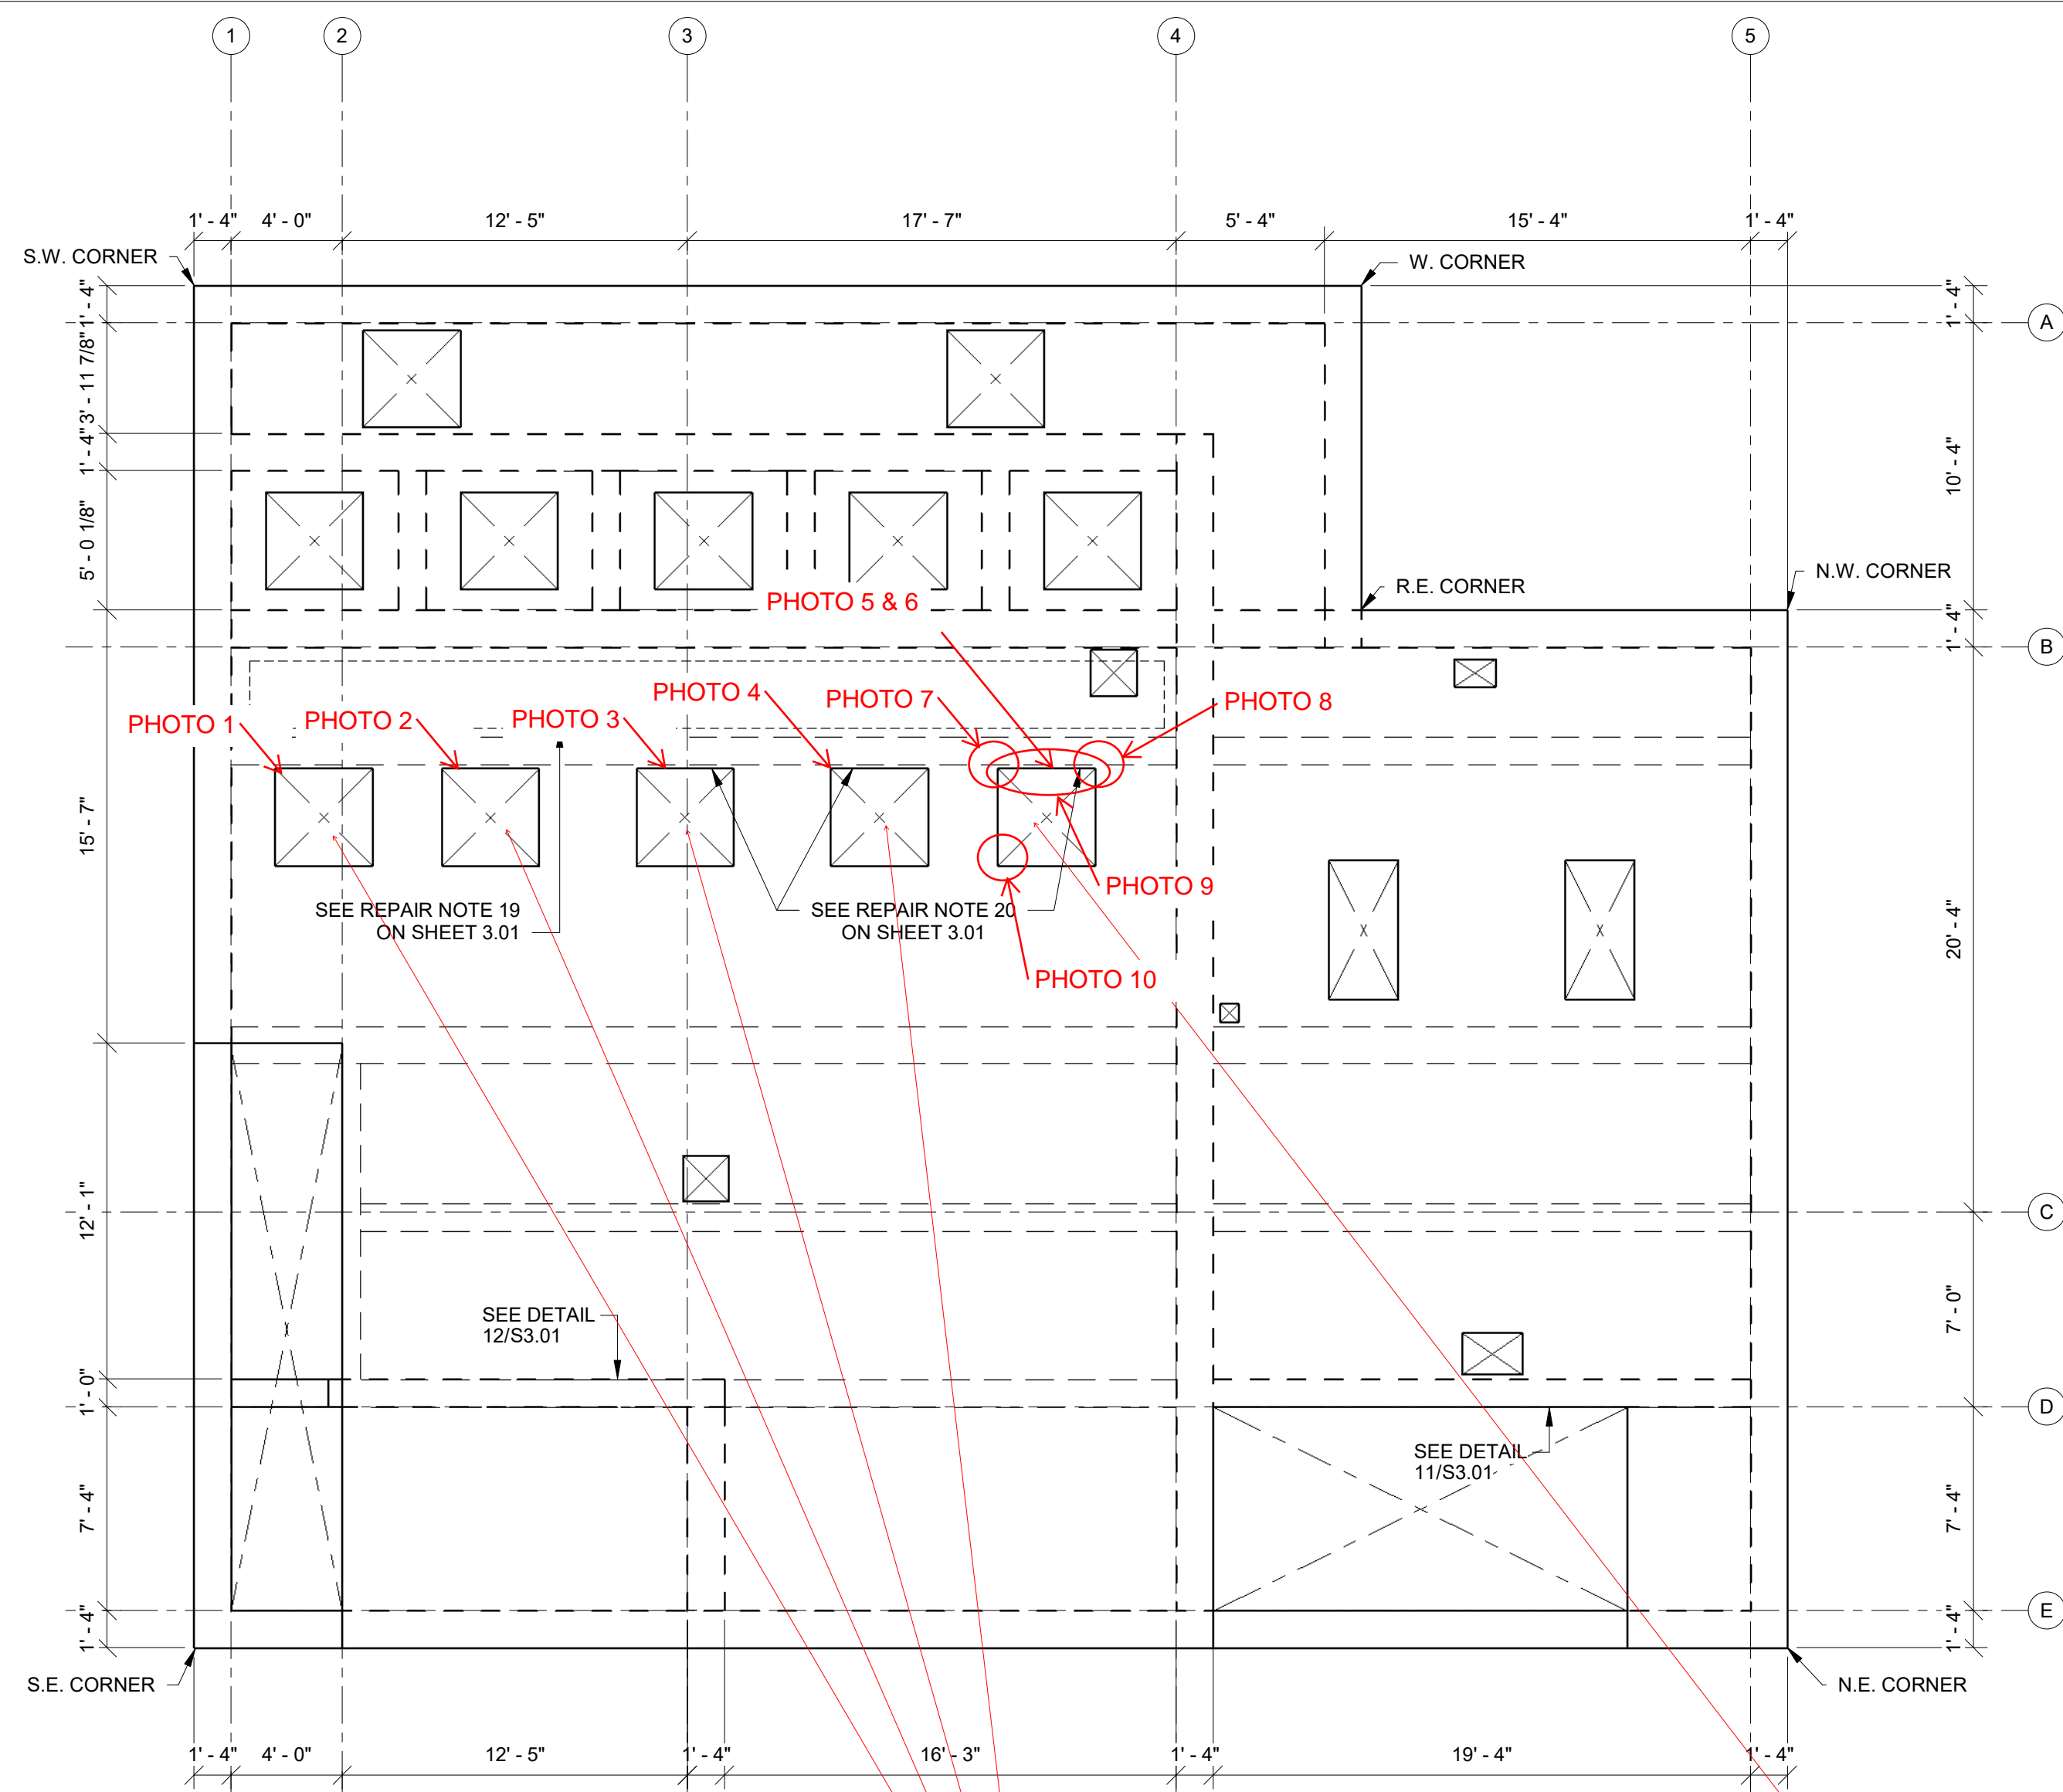

1 TOP OF SLAB PLAN @ EL. 952.50'
3/16" = 1'-0"

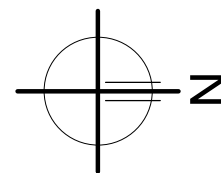

NOTE: REPAIR AREAS MARKED IN THE FIELD

Sequence on hatch removals:

1. brace hatch in place
2. protect all exist reinforcing in place
3. initiate removals with neat 1/2" deep saw cut
4. carefully remove concrete (light chipping) from between the hatch and the existing reinforcing (do not damage the existing reinforcing)
5. carefully remove the hatch
6. carefully clean the hatch
7. place hatch in correct position
8. form and pour SIKACrete 211 SCC Plus.

Sequence on hatch removals:

1. carefully repair reinforcing as indicated.
2. place hatch in correct position
3. form and pour SIKACrete 211 SCC Plus

Elevations:


Top Slab:
 -Top of floor slab elevation did not align with plans and was uneven.
 -Top of floor slab was lowered by grinding. Surface was prepared. Surecrete Resist Mortar and Surecrete Resist Sand Finish were installed to overlay the floor slab and bring it to plan elevation.
 - No reinforcing was impacted by these adjustments
 -Boomerang collected slab elevations using laser level based off of benchmark CO 80672 on 5/15/24 with HR Green Observer, all elevations aligned with plans.

Hatches:


- 5 hatches were not installed in alignment with plan elevations.
- Reference above for corrective actions.
- Boomerang hatch elevations using laser level based off of benchmark CO 80672 on 5/15/24 with HR Green Observer, all elevations aligned with plans.

Elevation control:
CP 80672 (on HRG SHT. C.001),
Elev: 955.33 Northing: 3465504.05 Easting: 4934712.34
Description: Cut "X" located approximately northeast corner of existing splitter structure

HRG Sheet reference are from Nevada WWTF Improvements Phase 3 - Lift Station City of Nevada document

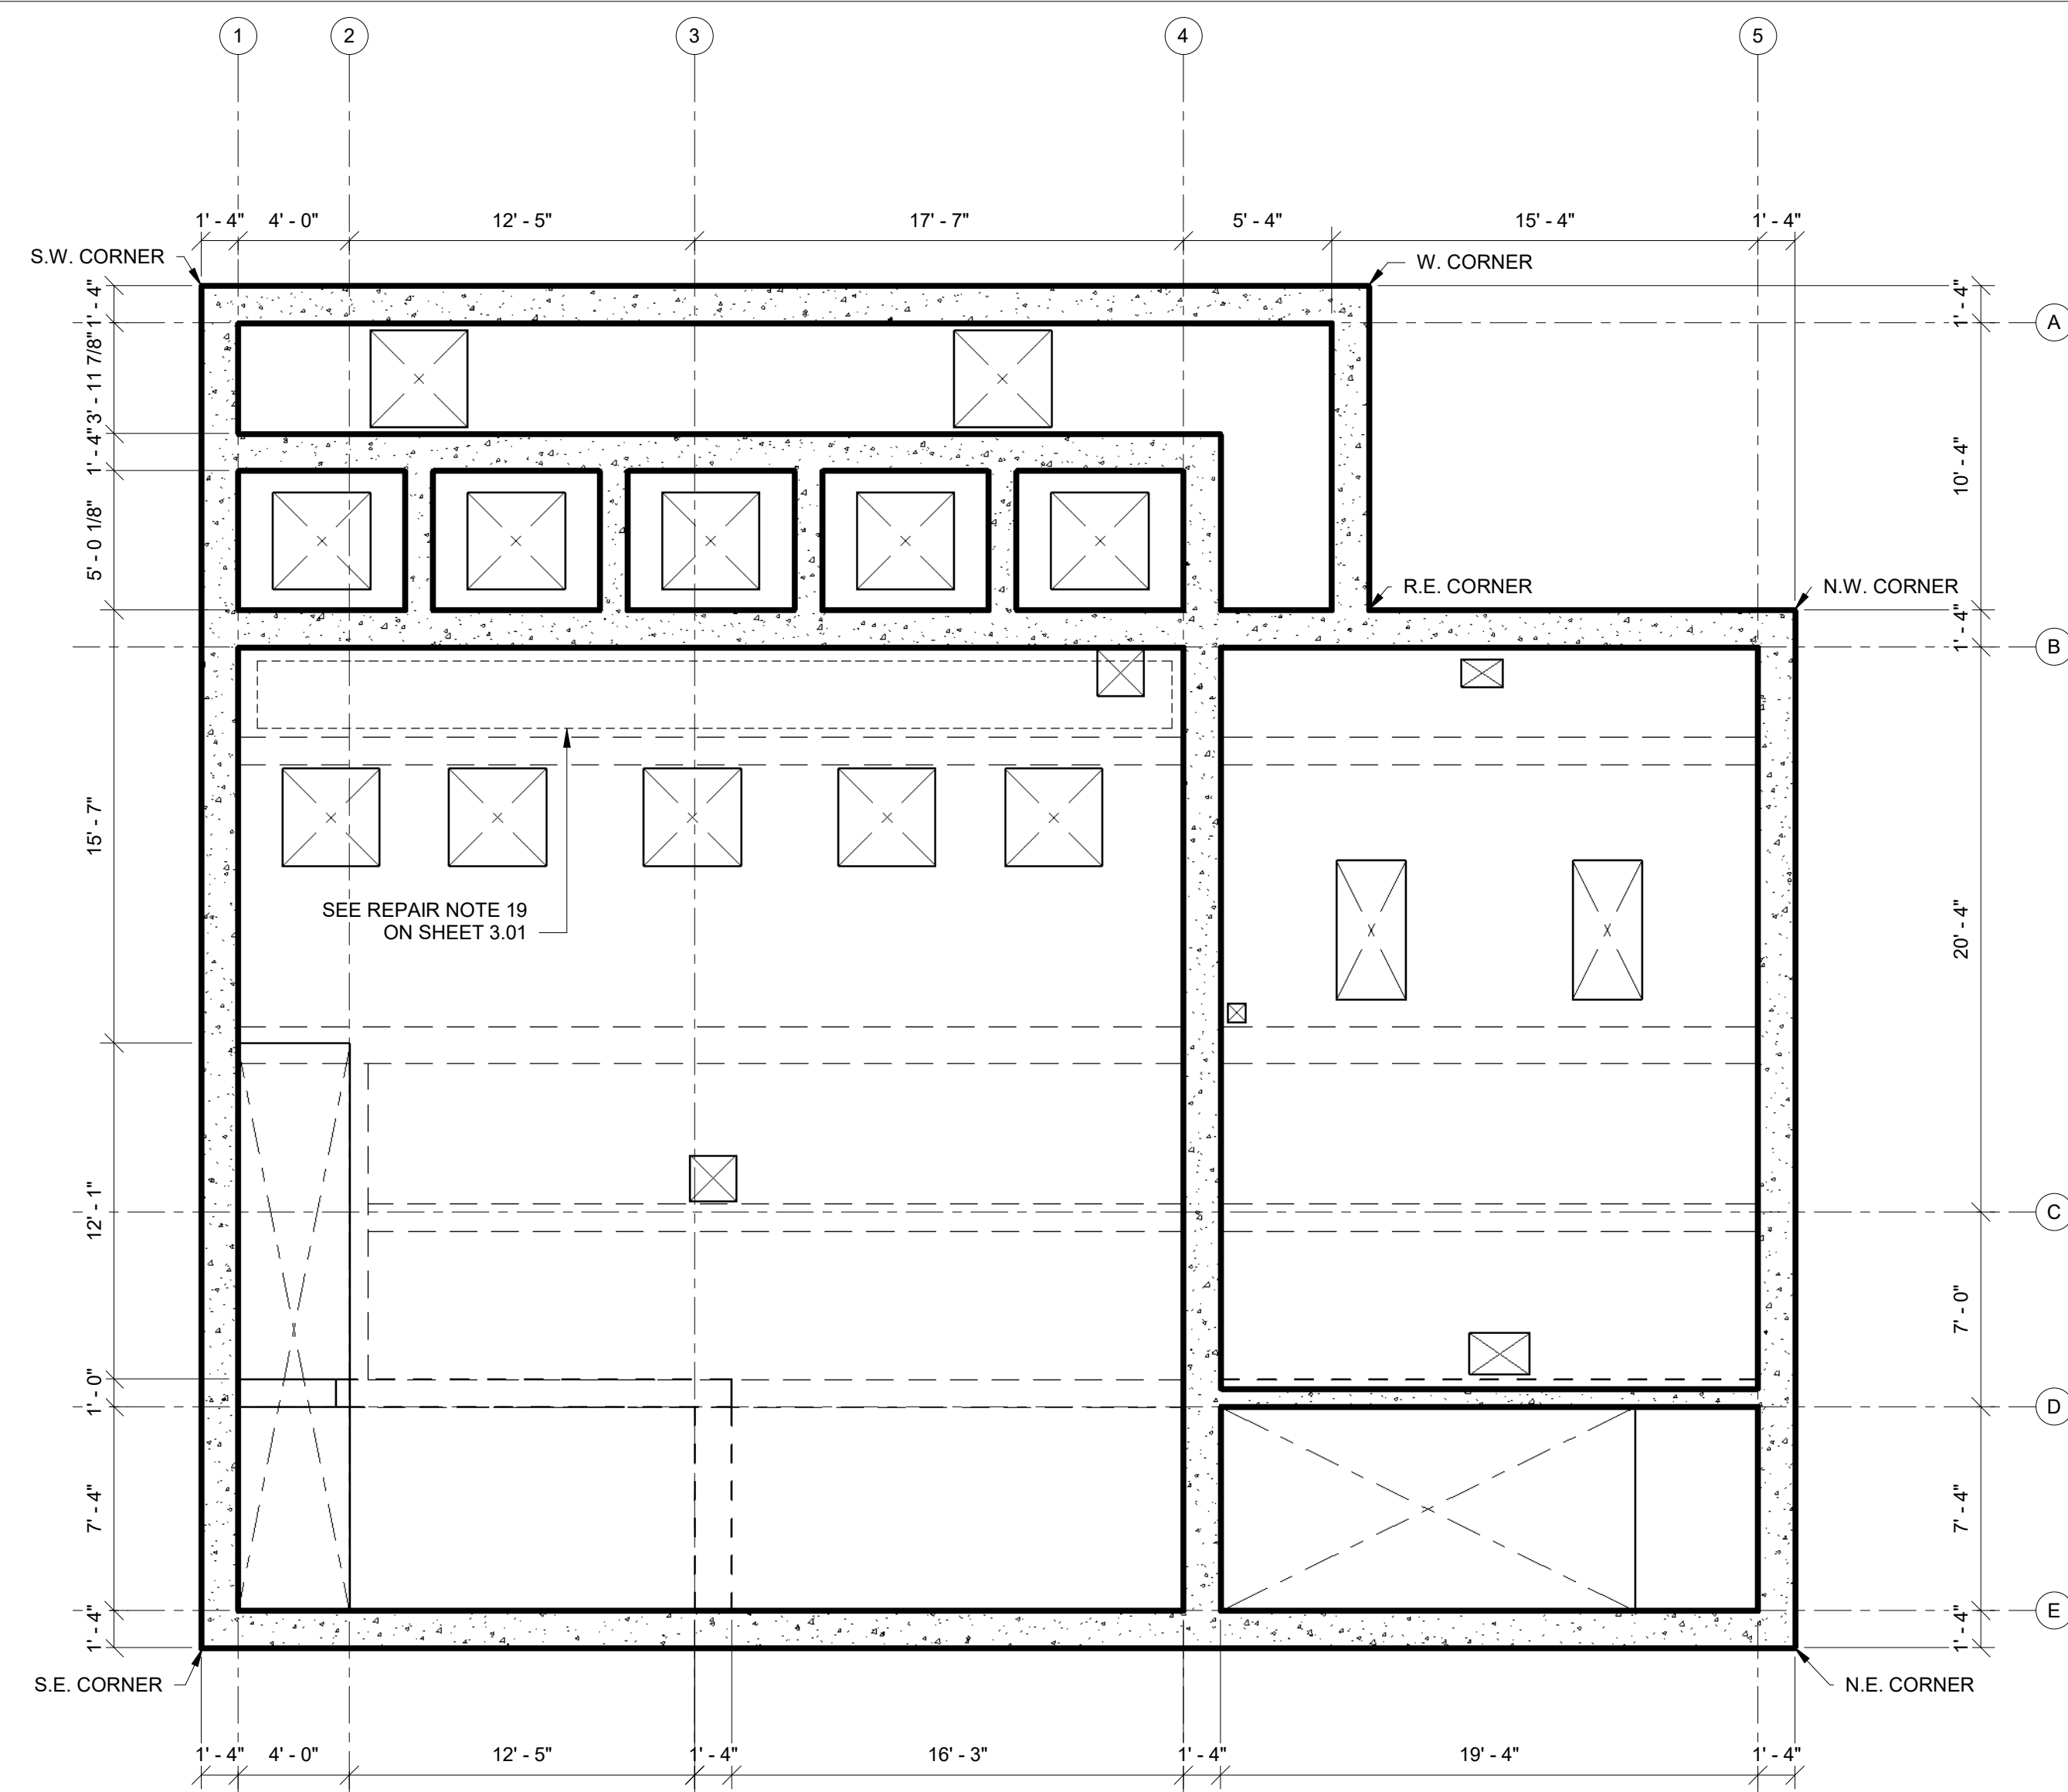

2 BOTTOM OF SLAB PLAN @ EL. 952.50'

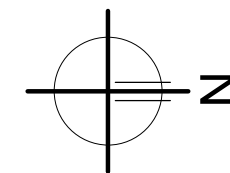

NOTE: REPAIR AREAS MARKED IN THE FIELD.



Before Repair



After Repair

PHOTO 1




Before Repair




After Repair

PHOTO 2

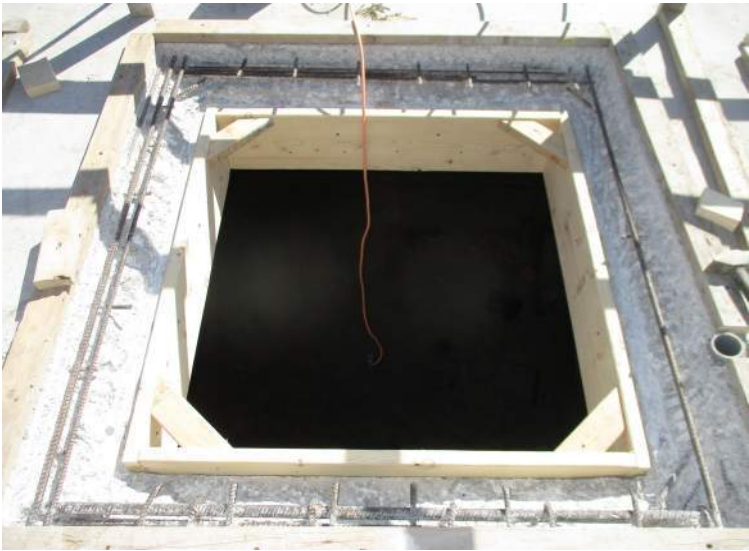

Before Repair

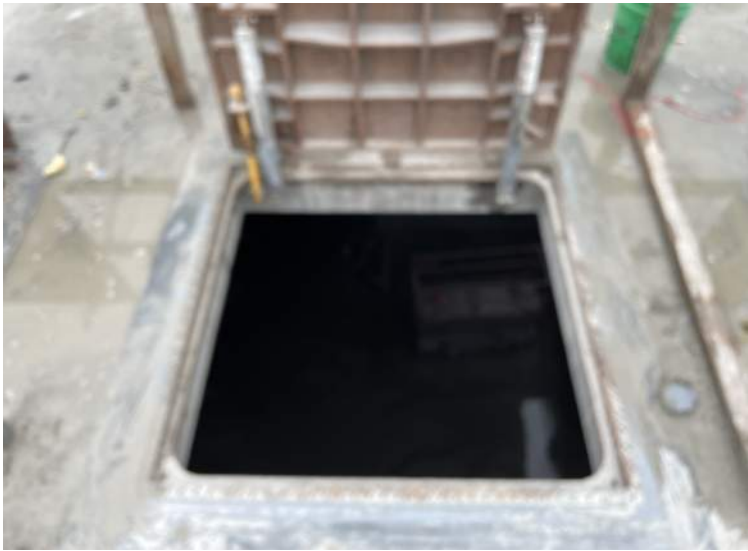

After Repair

PHOTO 3



Before Repair



After Repair

PHOTO 4



Before Repair

SEE DETAIL
1S/1.02 & 2S/1.02

PHOTO 5



After Repair



Before Repair

SEE DETAIL
1S/1.02 & 2S/1.02

PHOTO 6



After Repair

1. initiate removals with neat 1/2" deep saw cut
2. carefully remove concrete (light chipping)(do not damage the existing reinforcing)
3. remove only to depth required to place couplers and replace concrete topping.

carefully remove concrete to verify which are beam closed ties & to provide enough exposed bar to install couplers.

New #4 Diag. Bars to match existing (typ)

Bar Splice Dayton Superior D250 SCA Bar Lock 4S/CA Coupler, each end (typ)

but end of new bar to existing bar (typ)

New #4 Bars to match existing (typ)


Bar Splice Dayton Superior D250 SCA Bar Lock 4S/CA Coupler, each end (typ)

Bar Splice Dayton Superior D250 SCA Bar Lock 8S/CA Coupler, each end (typ)

carefully remove existing damaged #8 bar and provide new #8 Bars to match existing

conduit repairs worked out btw others (typ)

DETAIL 1

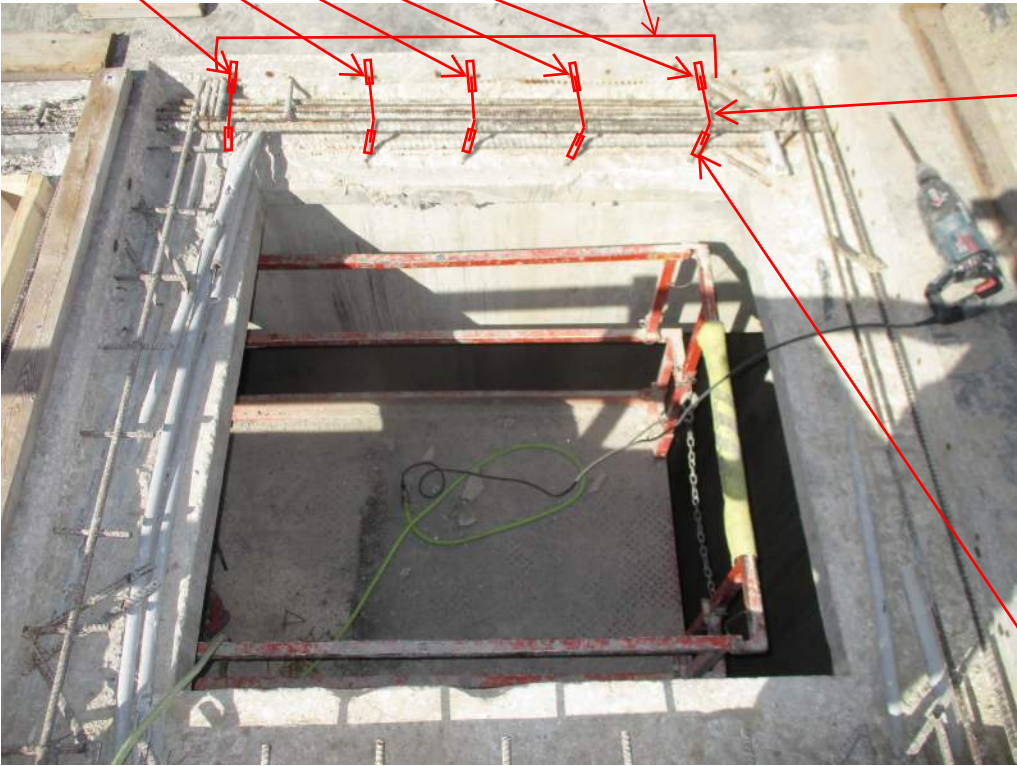

New #4 (w/ 90 deg bend) bars to match existing (typ)

N

Bar Splice Dayton Superior D250 SCA Bar Lock 4S/CA Coupler, each end (typ)

DETAIL 2



Before Repair



After Repair

PHOTO 7



Before Repair



After Repair

PHOTO 8



Before Repair



After Repair

PHOTO 9




Before Repair




After Repair


PHOTO 10

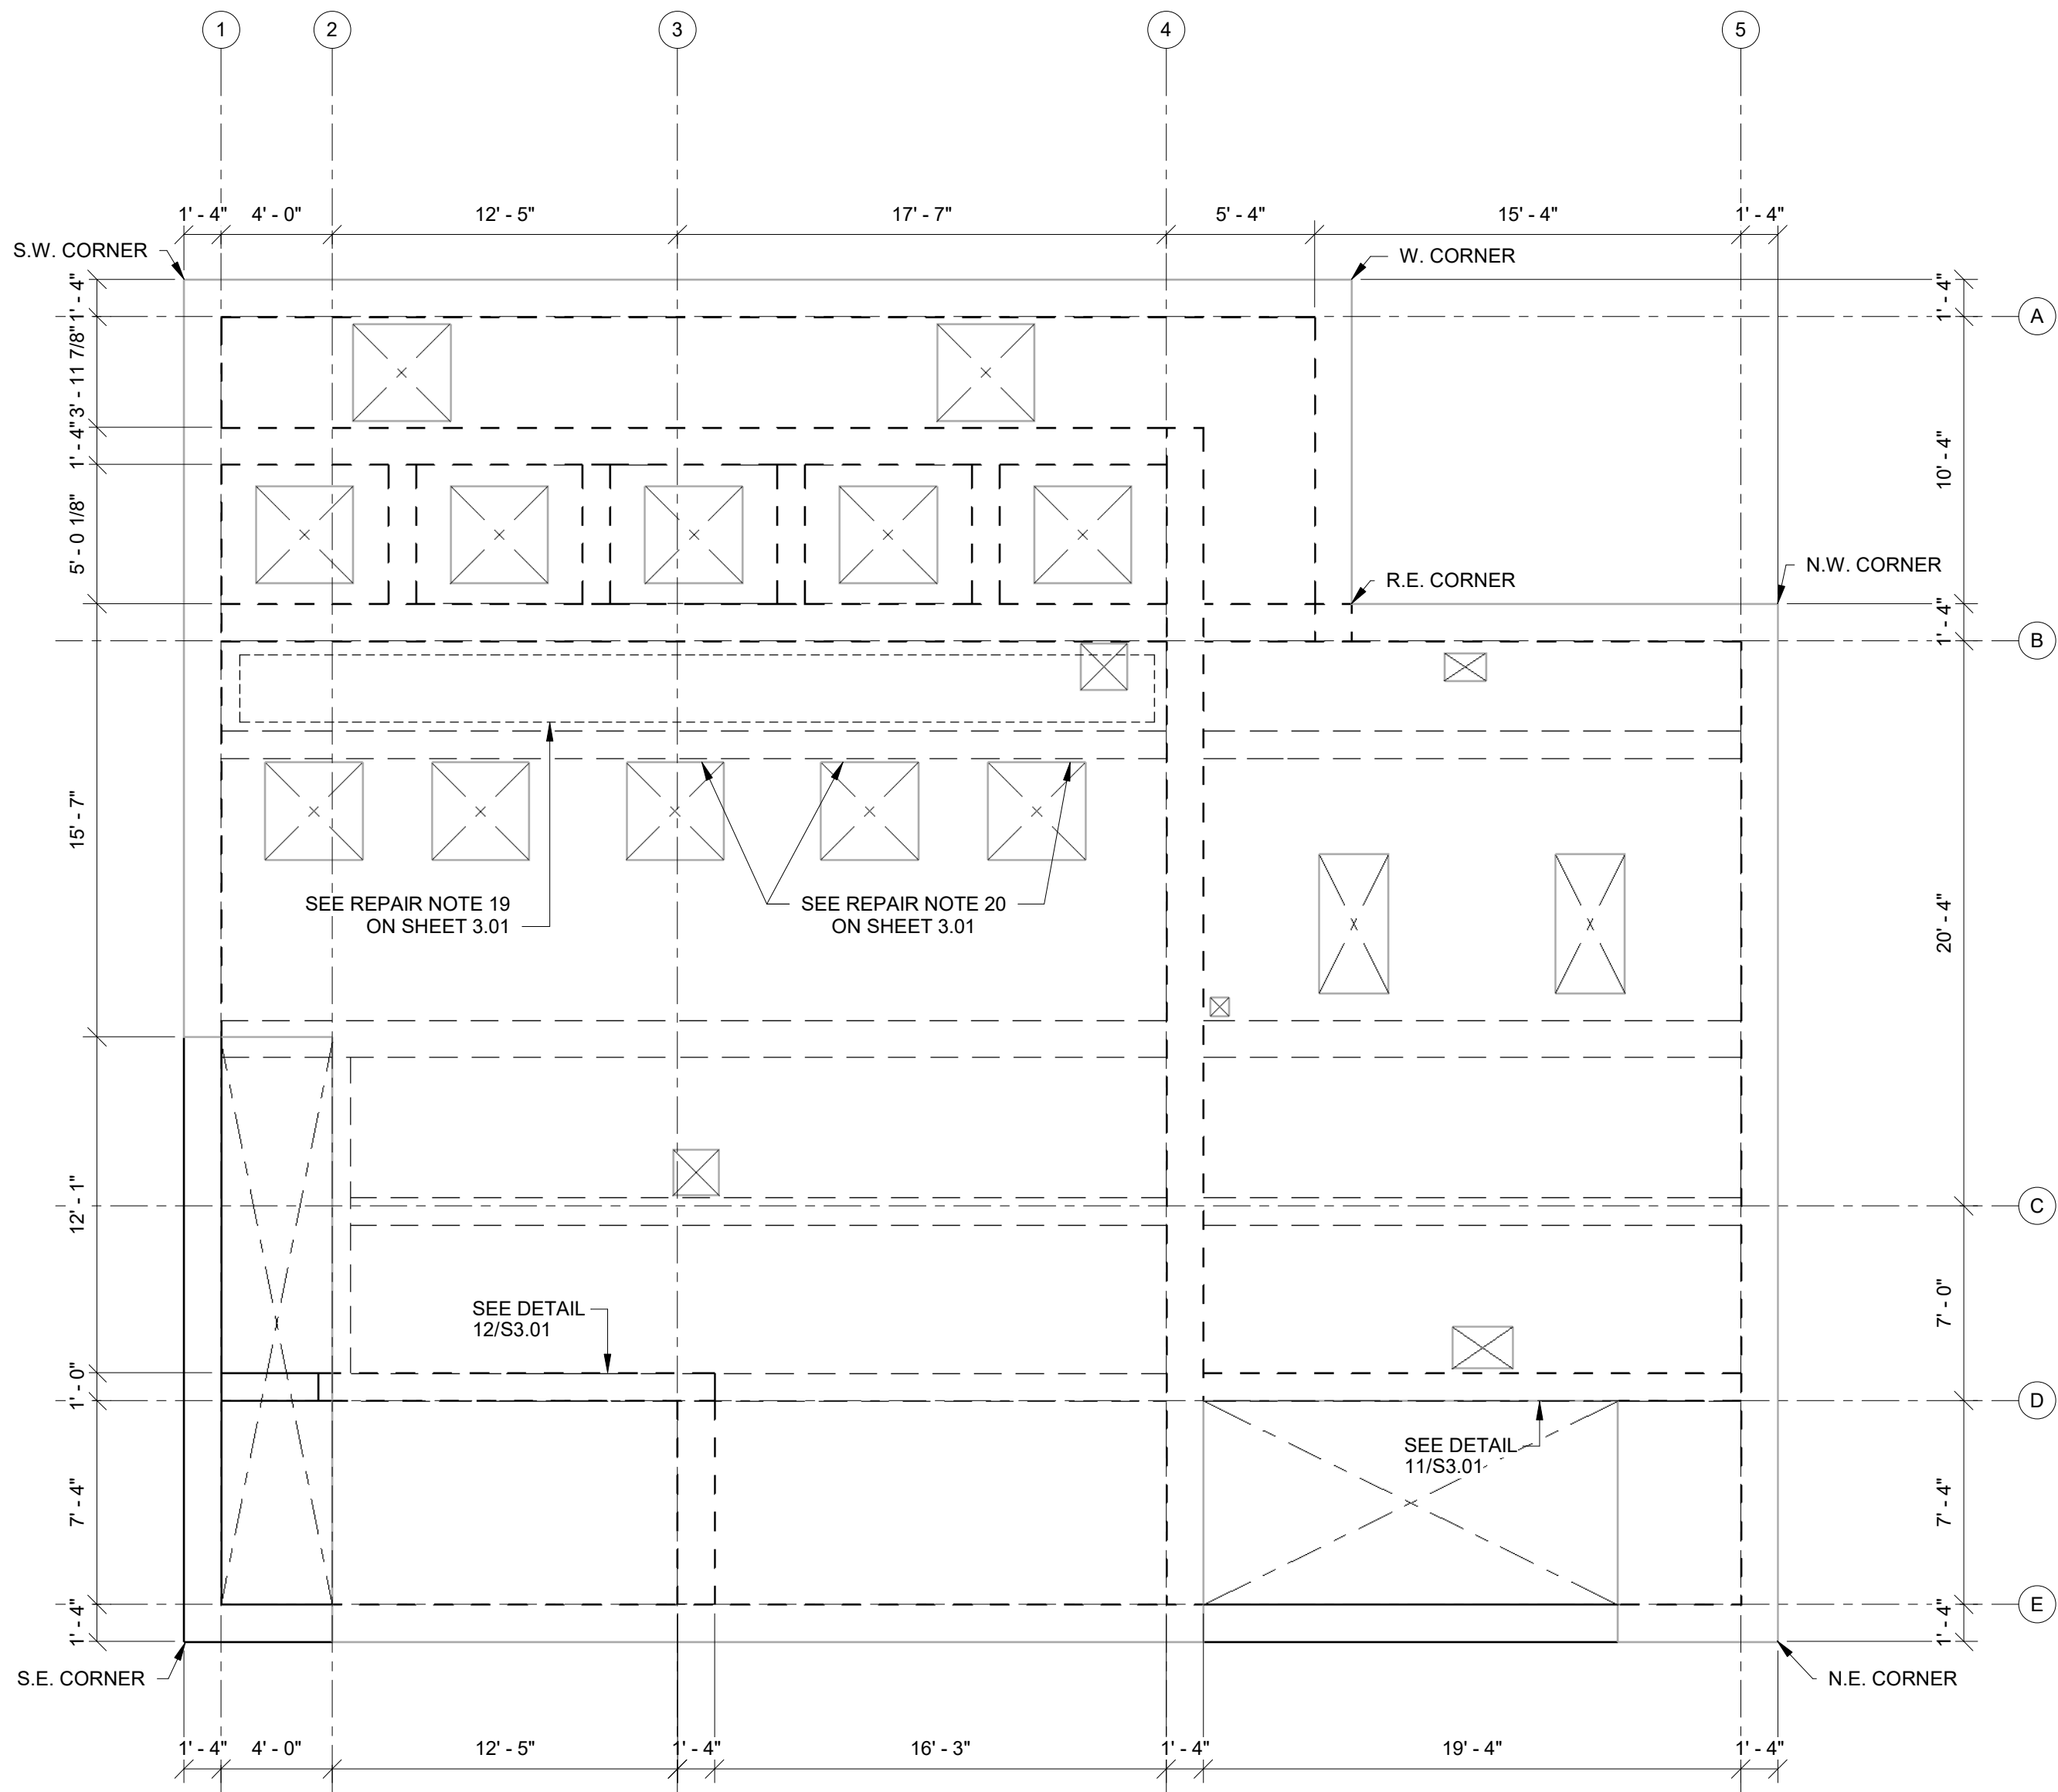


1 TOP OF SLAB PLAN @ EL. 952.50'
3/16" = 1'-0"

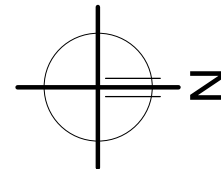


NOTE: REPAIR AREAS MARKED IN THE FIELD.

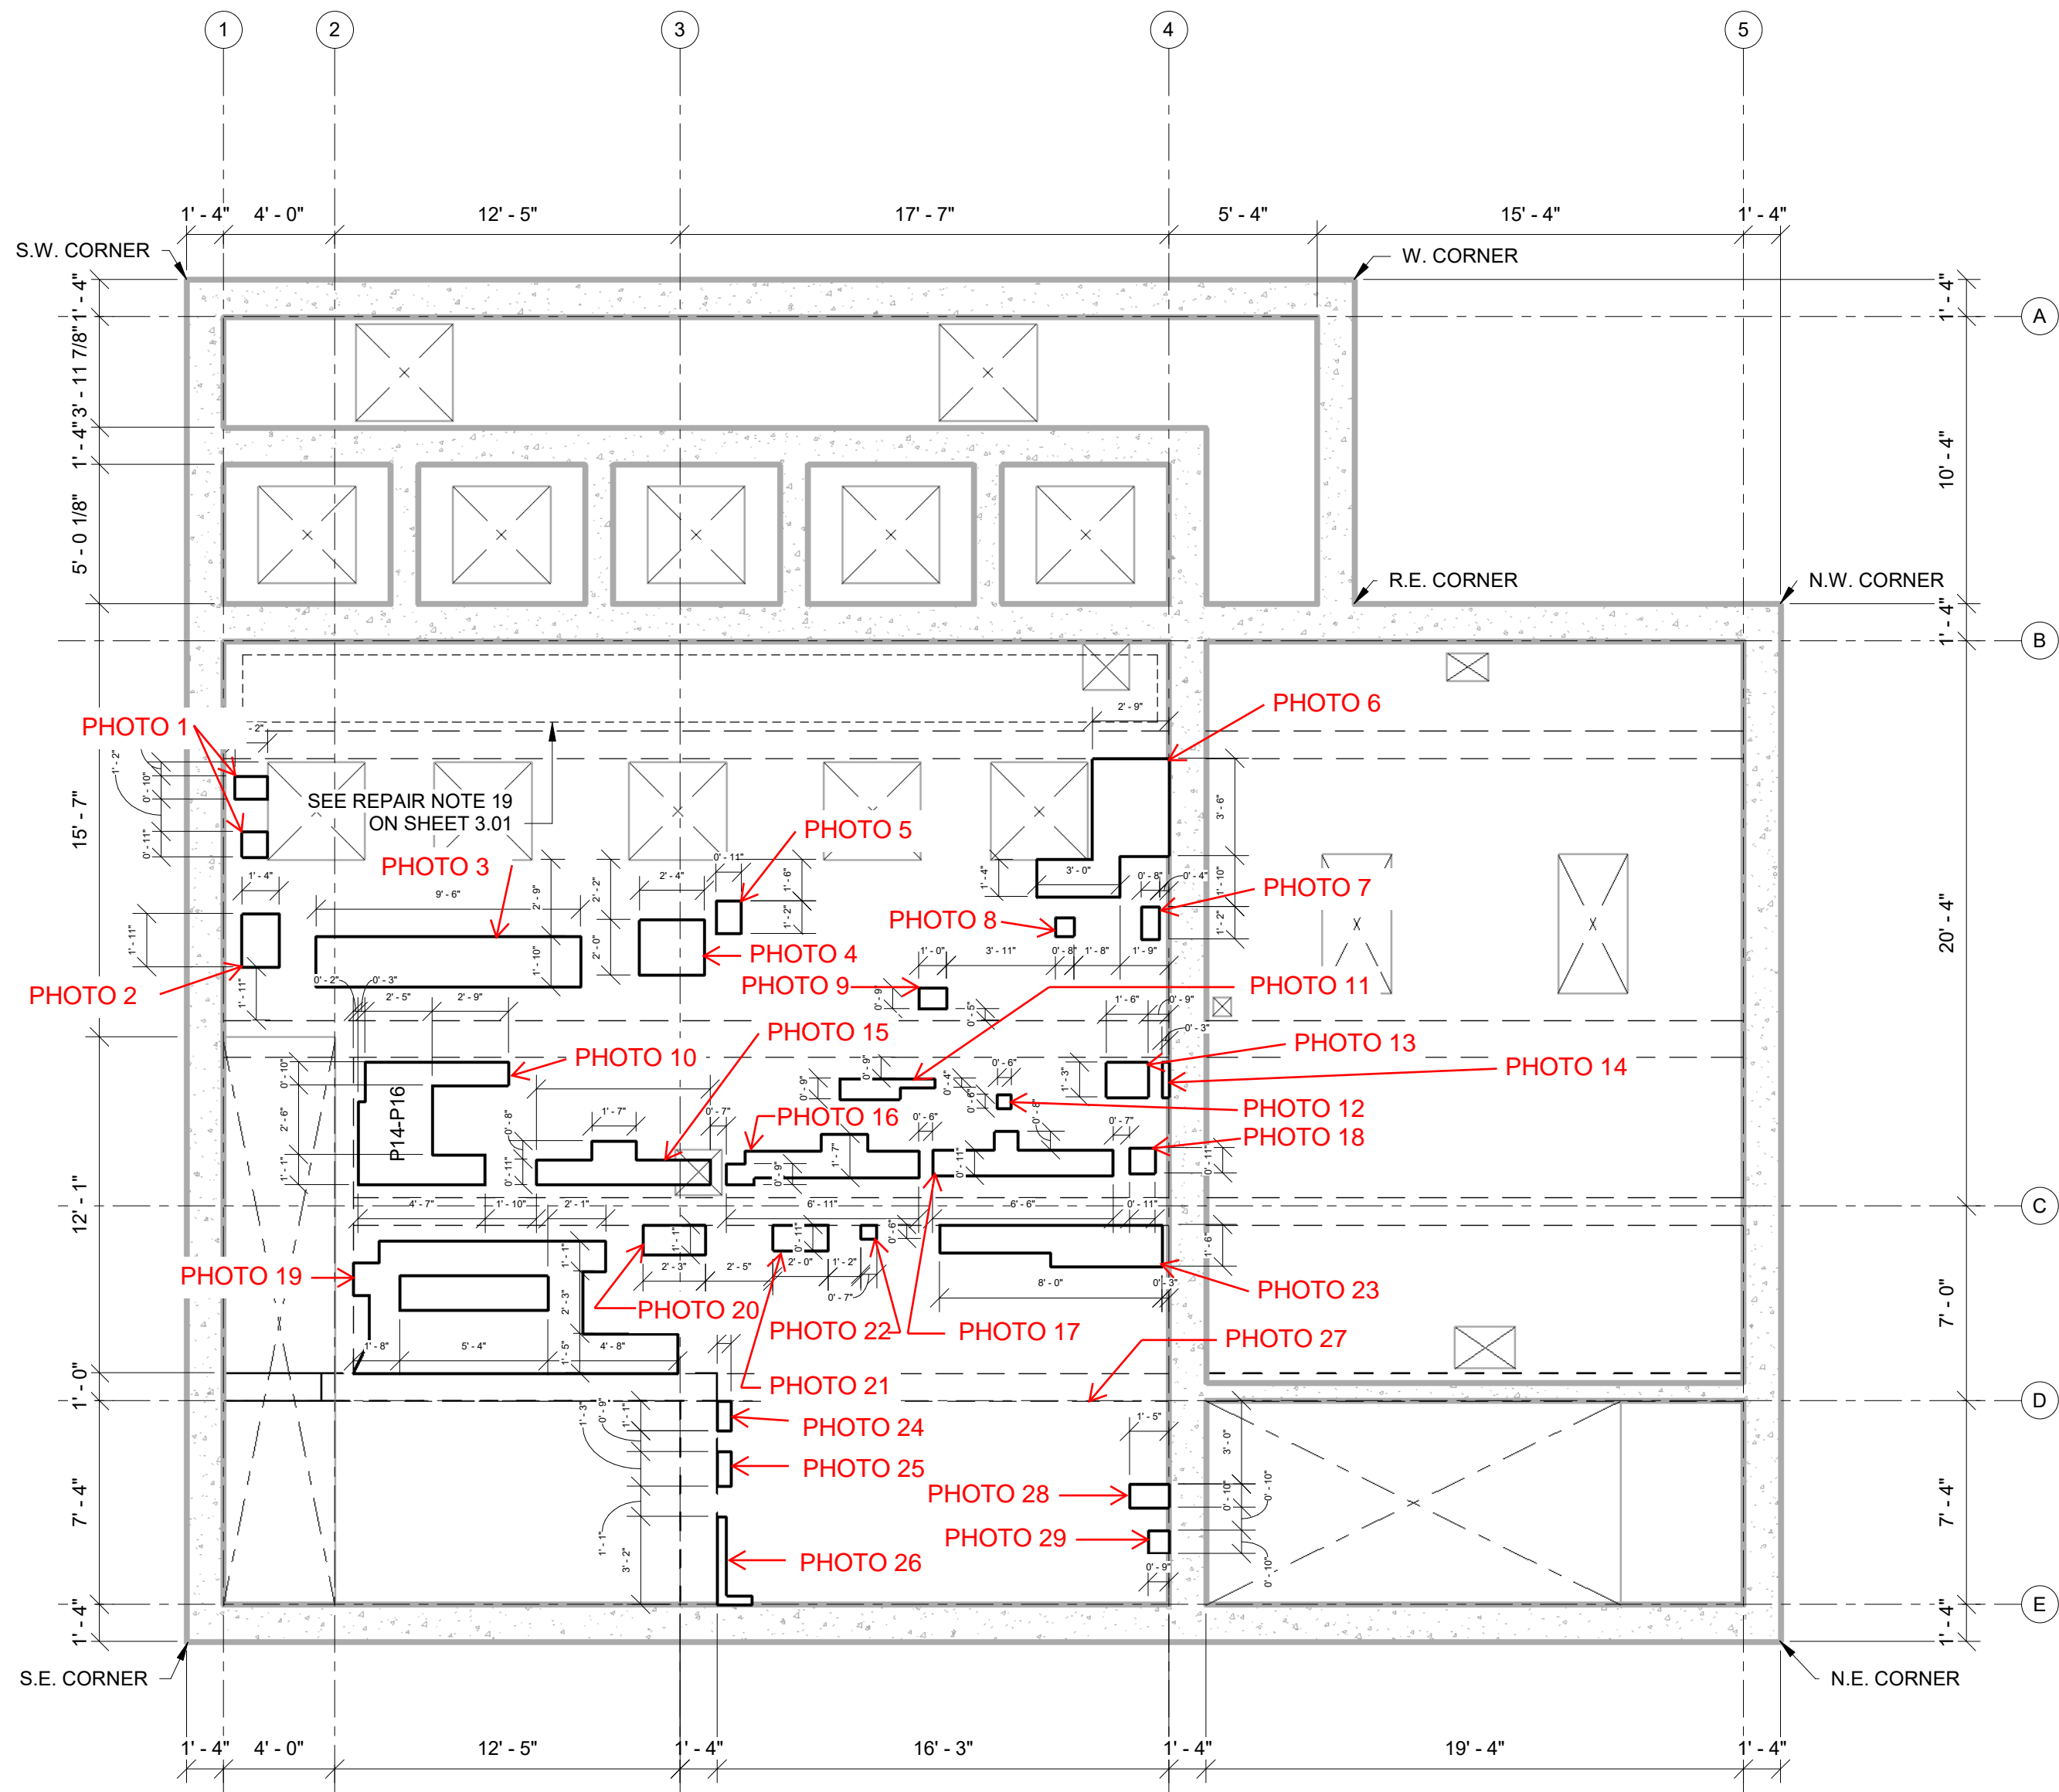

2 BOTTOM OF SLAB PLAN @ EL. 952.50'
3/16" = 1'-0"

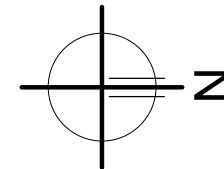

NOTE: REPAIR AREAS MARKED IN THE FIELD.

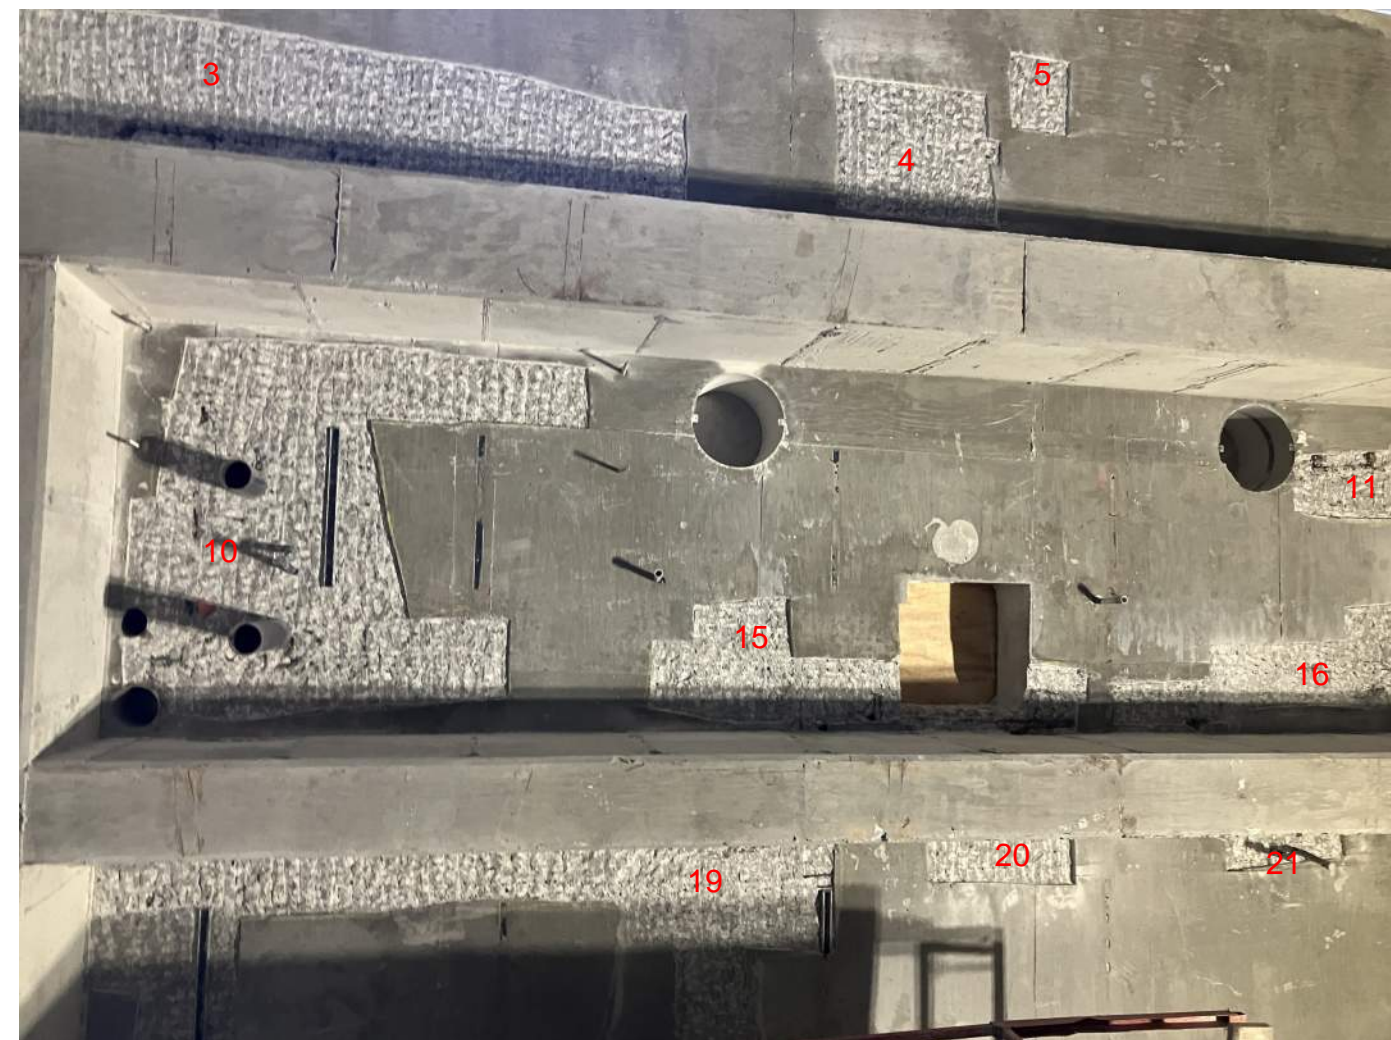

SHUCK BRITSON

400 E COURT AVE.
SUITE 140.
DES MOINES, IOWA 50309
515-243-4477
www.shuck-britson.com

NEVADA WWTP IMPROVEMENTS LIMITED
CONCRETE WALL REPAIR

BOOMERANG

457 S. 6th STREET NEVADA IOWA 50201

Project Status

PROJECT NUMBER 123.0172.03

DATE 10/27/2023

SHEET TITLE

TOP & BOTTOM OF SLAB EL. AT
952.5

SHEET NO.

S1.03



Before Repair



After Repair

PHOTO 1



Before Repair



After Repair

PHOTO 2



Before Repair



After Repair

PHOTO 3



Before Repair



After Repair

PHOTO 4



Before Repair




After Repair

PHOTO 5



Before Repair

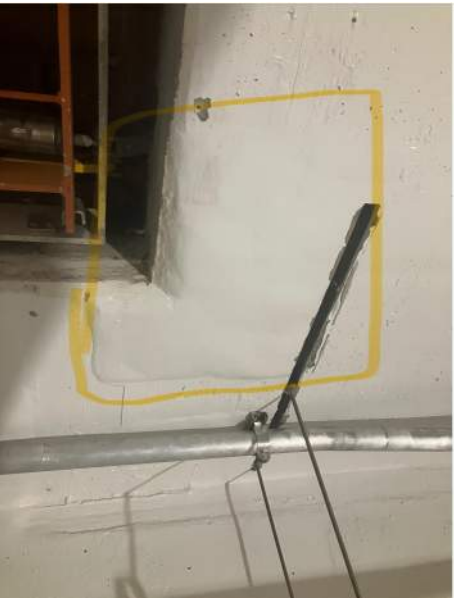

After Repair



After Repair

PHOTO 6



Before Repair



After Repair

PHOTO 7



Before Repair



After Repair

PHOTO 8



Before Repair



After Repair

PHOTO 9



Before Repair



After Repair

PHOTO 10



Before Repair



After Repair

PHOTO 11



Before Repair



After Repair

PHOTO 12



Before Repair



After Repair

PHOTO 13



Before Repair



After Repair

PHOTO 14



Before Repair



After Repair

PHOTO 15



Before Repair



After Repair

PHOTO 16



Before Repair



After Repair


PHOTO 17



Before Repair



Before Repair

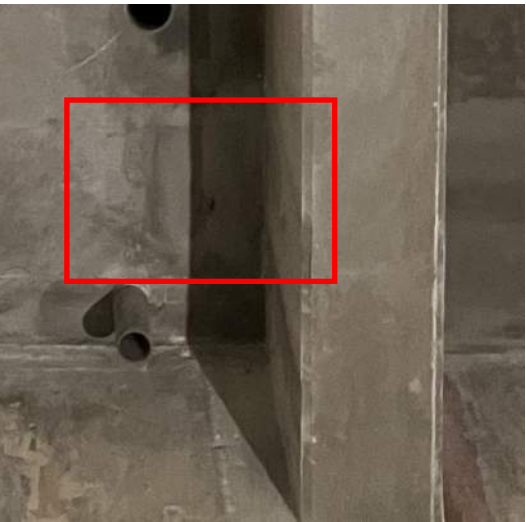

After Repair

PHOTO 18



Before Repair



After Repair

PHOTO 19



Before Repair



After Repair

PHOTO 20



Before Repair




After Repair

PHOTO 21



Before Repair

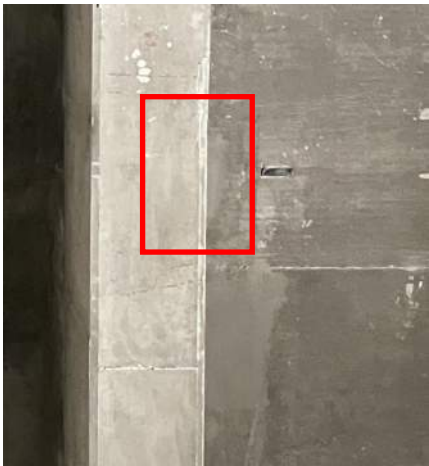

After Repair

PHOTO 22



Before Repair



Before Repair



After Repair

PHOTO 23



Before Repair



After Repair

PHOTO 24



Before Repair



After Repair

PHOTO 25



Before Repair



After Repair

PHOTO 26



Before Repair



After Repair

PHOTO 27



Before Repair



After Repair

PHOTO 28



Before Repair




After Repair

PHOTO 29

400 E COURT AVE.
SUITE 140.
S MOINES, IOWA 50309
515-243-4477
www.shuck-britson.com

457 S. 6th STREET | NEVADA IOWA 50201

S2.01

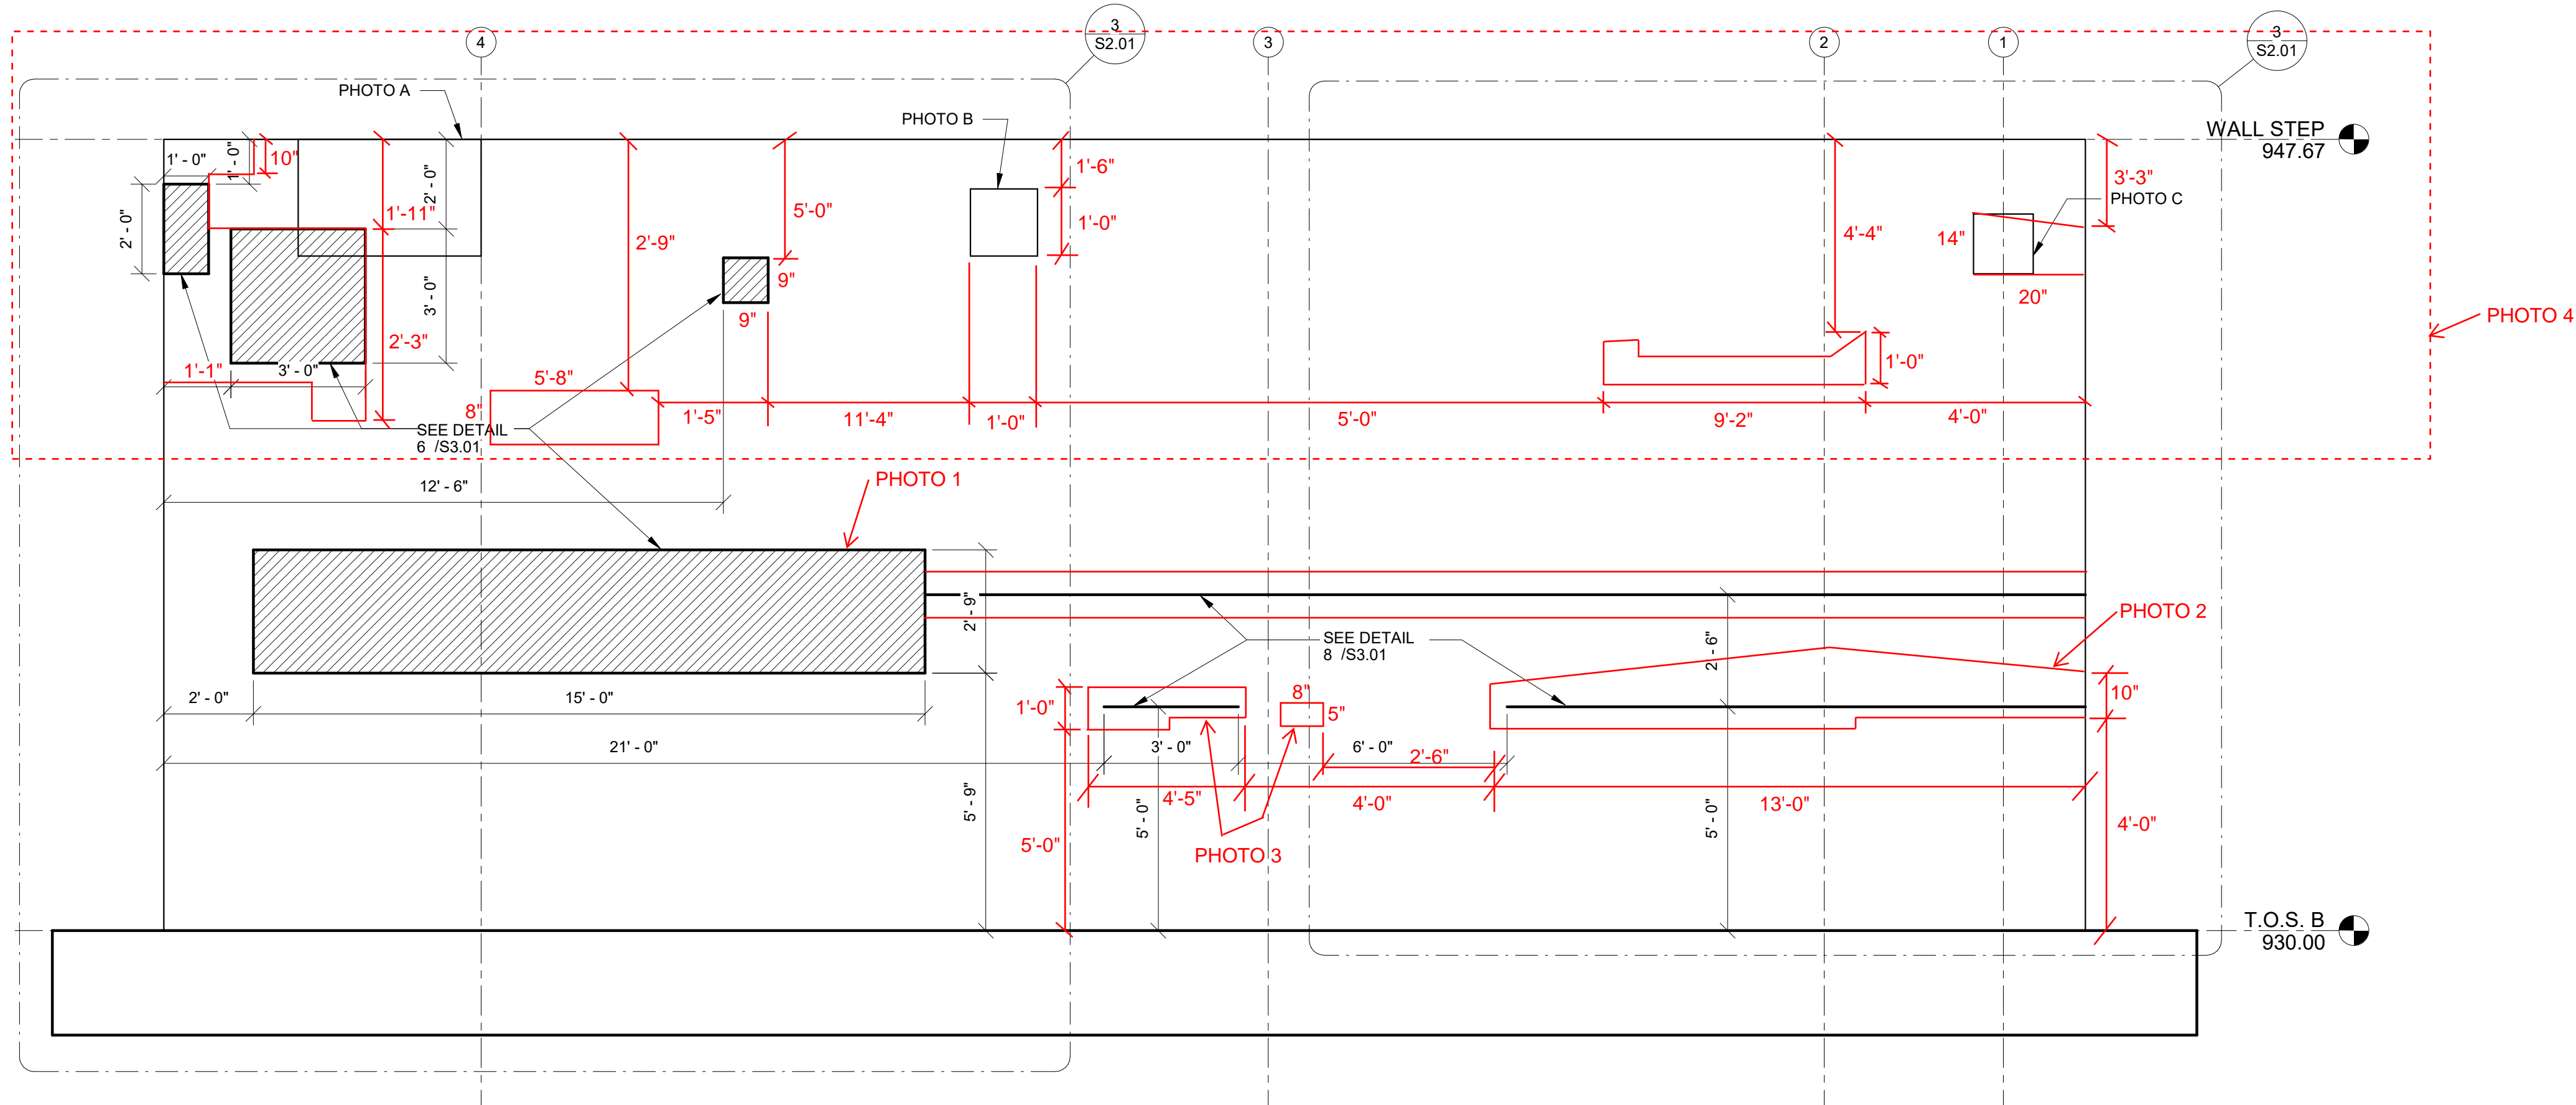

1 EXTERIOR ELEVATION

ORIGINAL REPAIRS



2 PHOTO A




3 PHOTO B



5 PHOTO C

3/24/2023 5:11:51 PM
C:\Users\shuckb\Documents\123.0172.03_STRUCT\R220_civil\S2.01.dwg

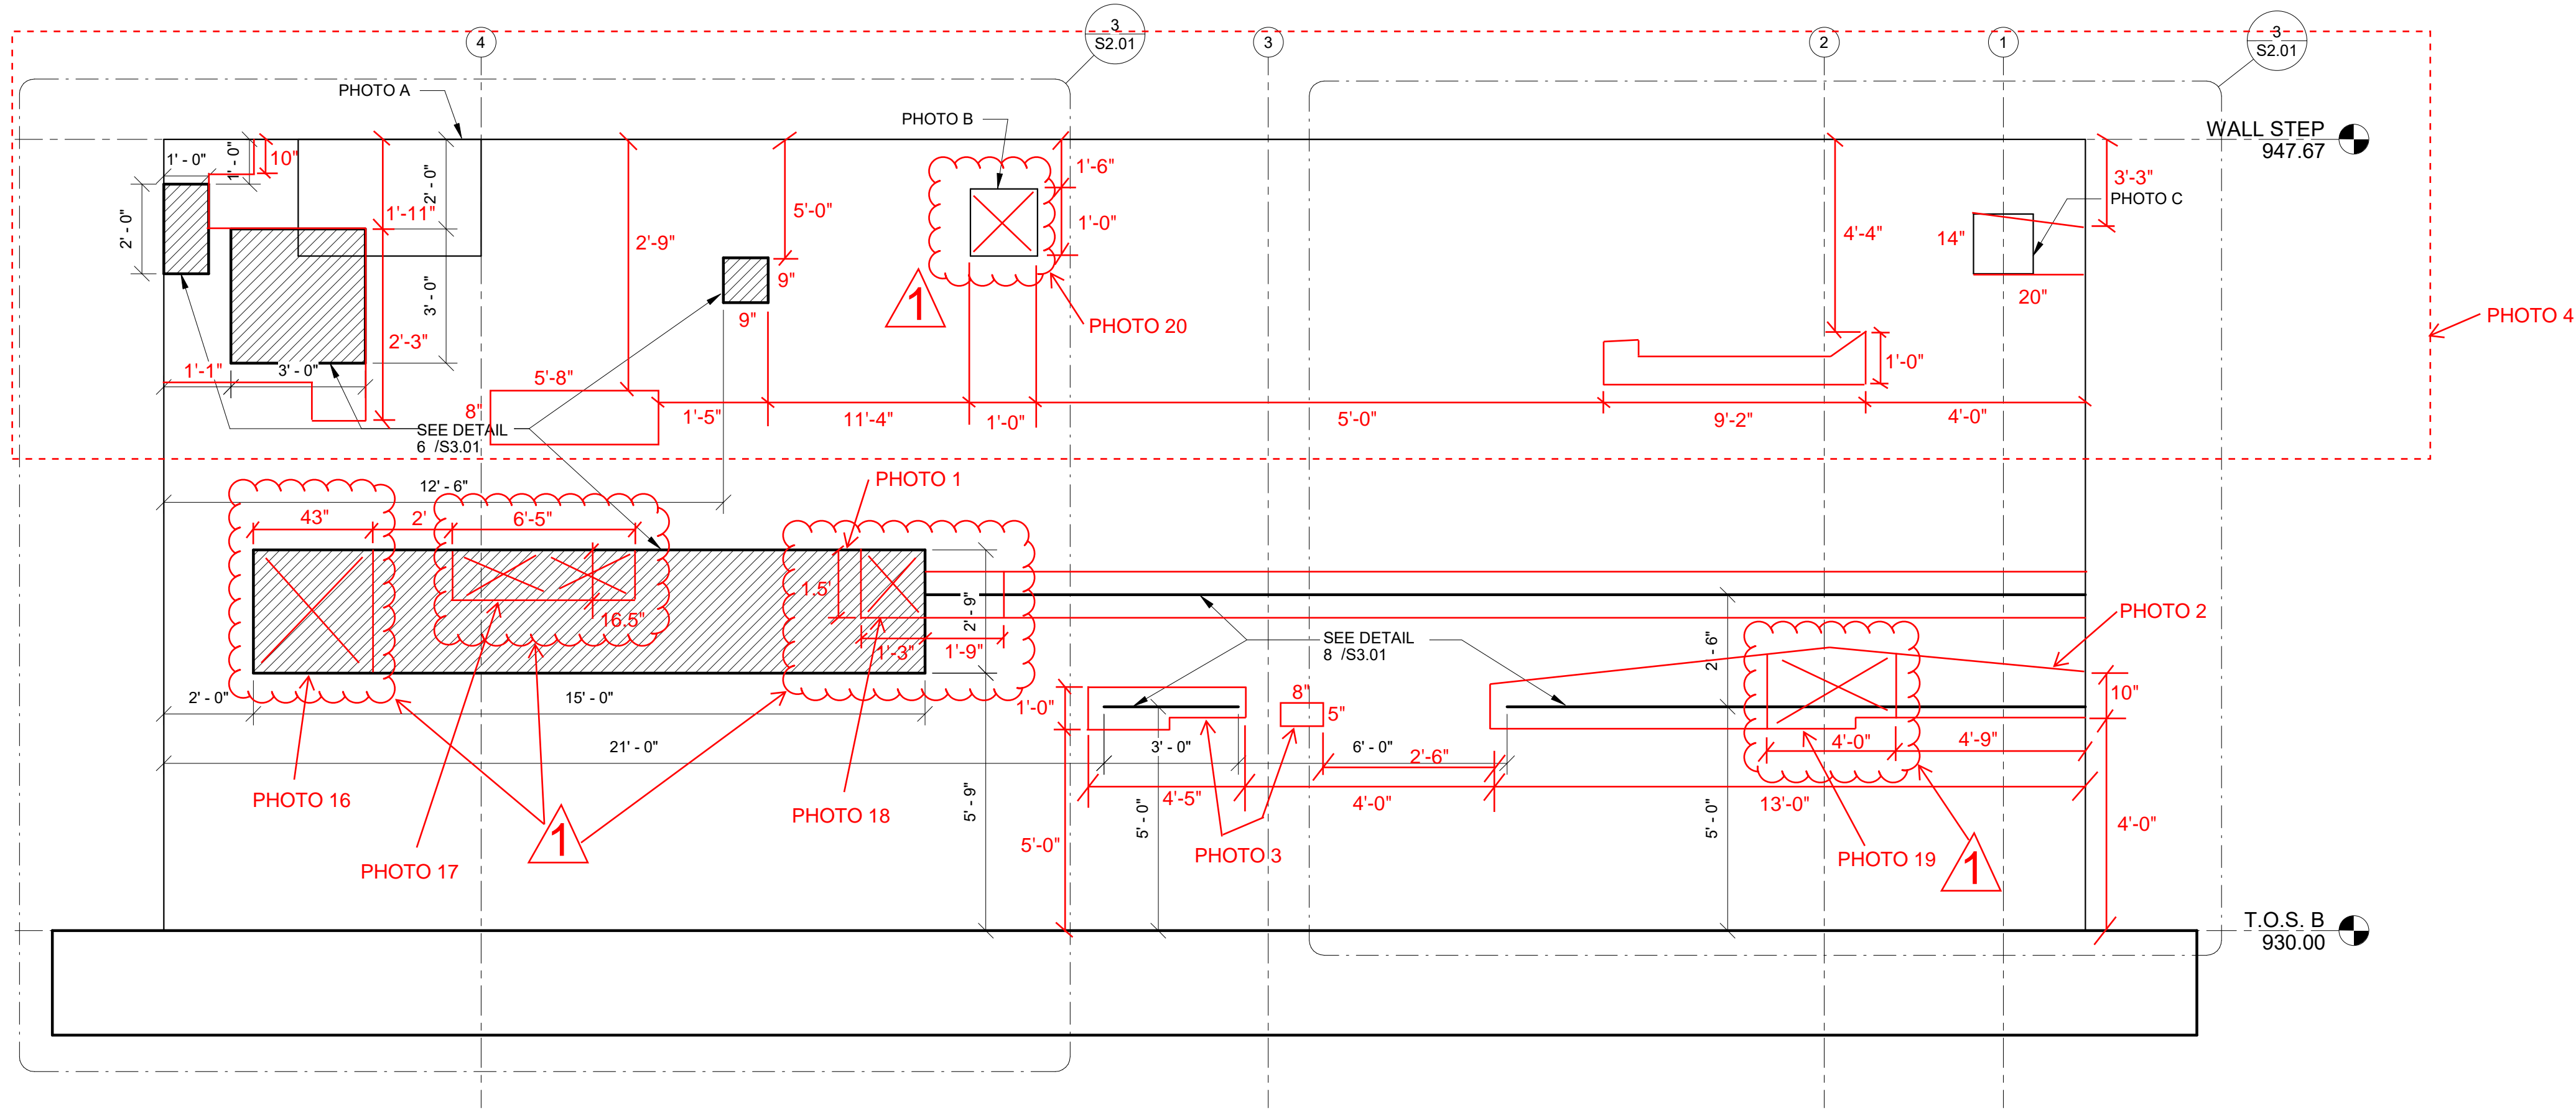

1 EXTERIOR ELEVATION
3/8" = 1'-0"

1 REVISION 1: REPAIRED EXISTING REPAIRS

LEGEND:

✕ DENOTES REMOVAL





2 PHOTO A



3 PHOTO B



5 PHOTO C

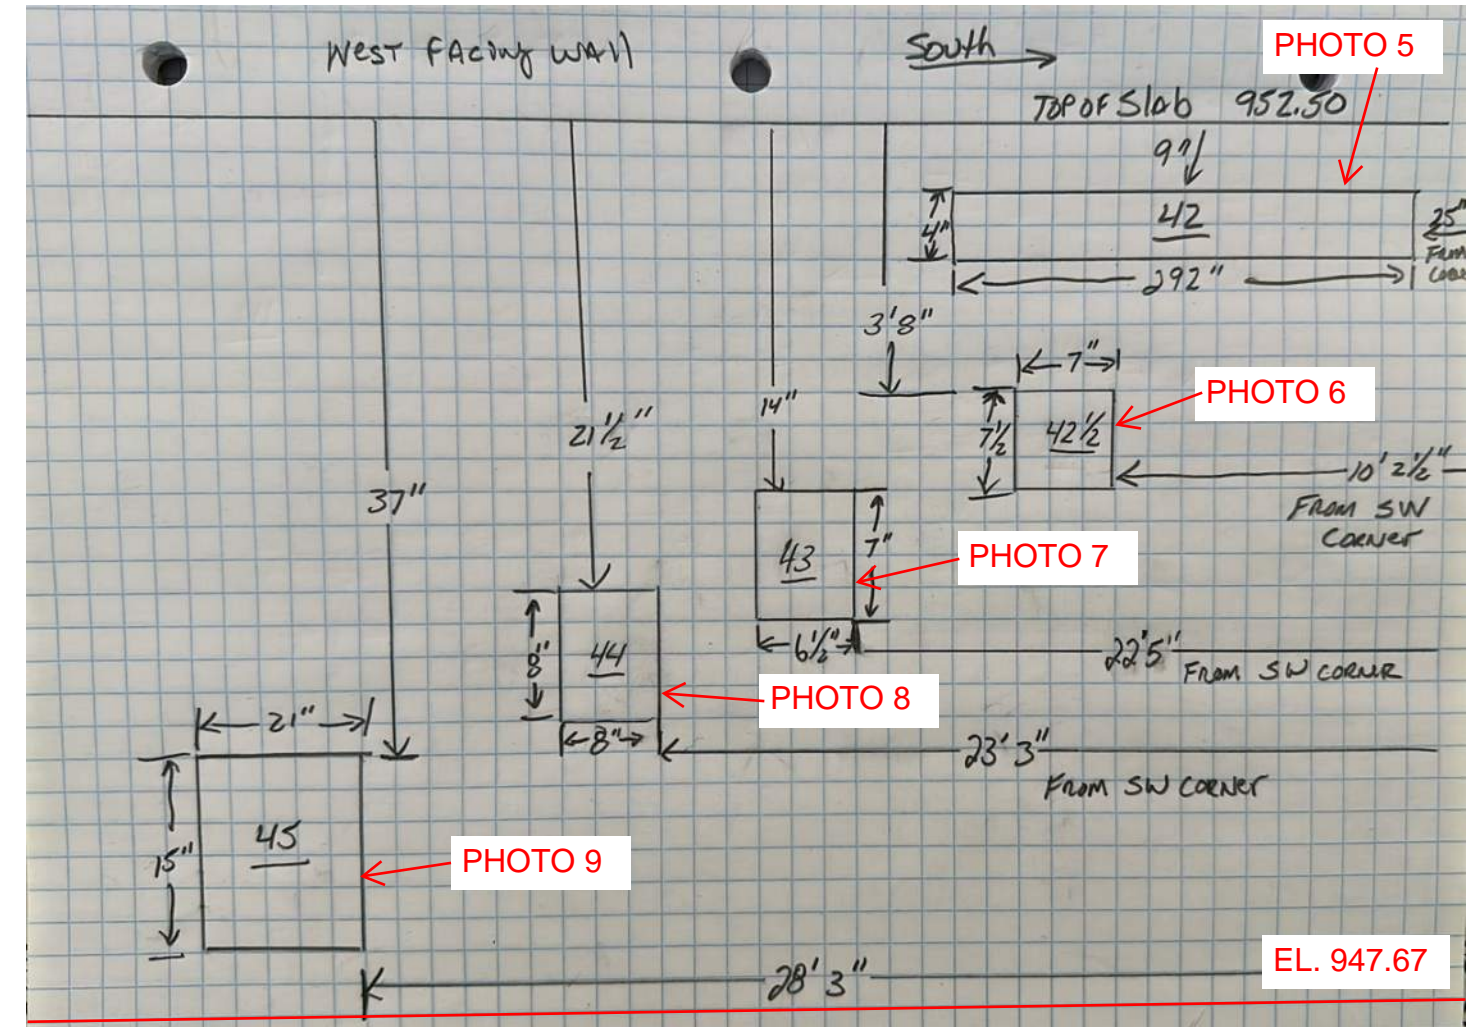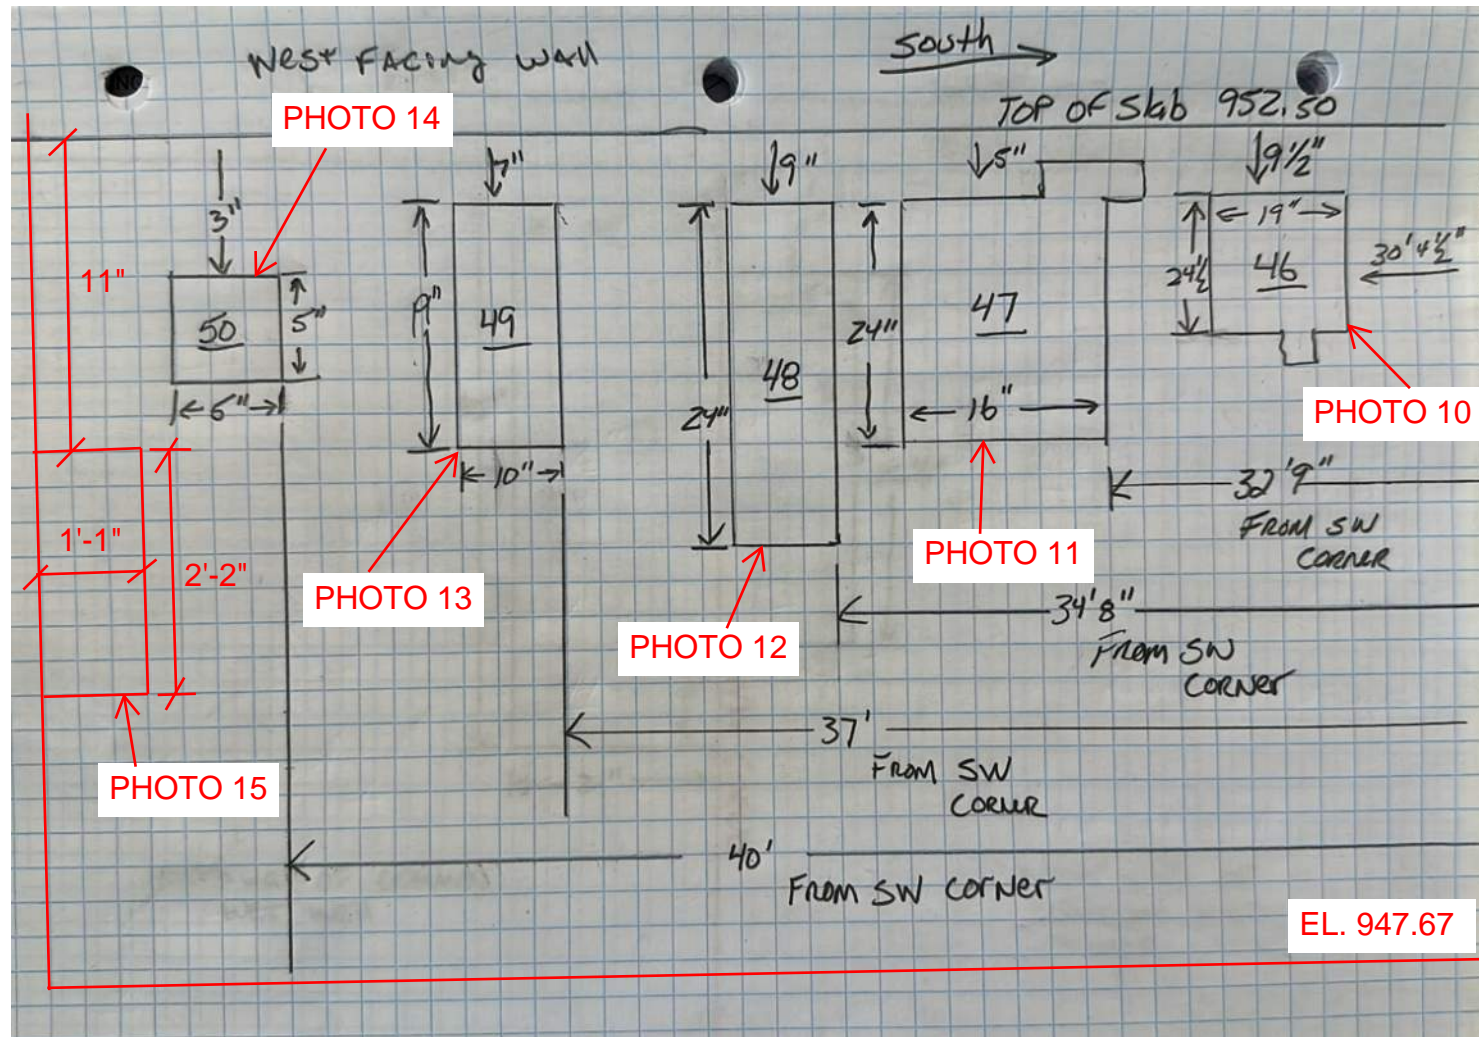



Before Repair



After Repair



After Repair



After Repair



After Repair

PHOTO 1



Before Repair



After Repair

PHOTO 2



Before Repair



After Repair

PHOTO 3



Before Repair



After Repair

PHOTO 4



After Repair



Before Repair



Before Repair



After Repair

PHOTO 5



Before Repair



After Repair

PHOTO 6



Before Repair




After Repair

PHOTO 7



Before Repair

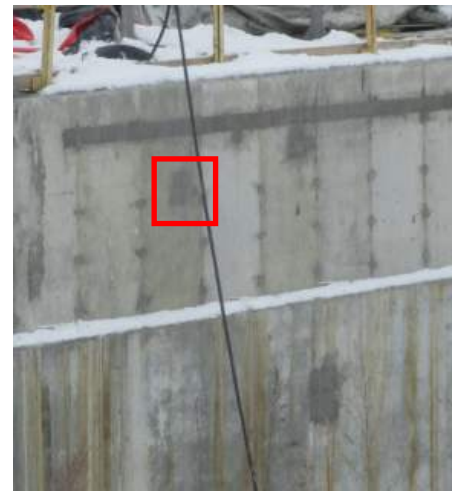


After Repair

PHOTO 8



Before Repair

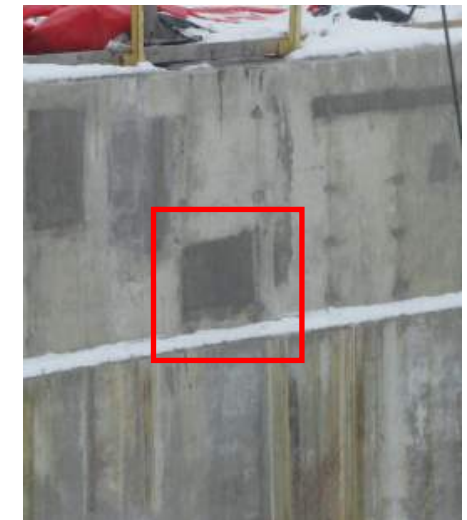


After Repair

PHOTO 9



Before Repair

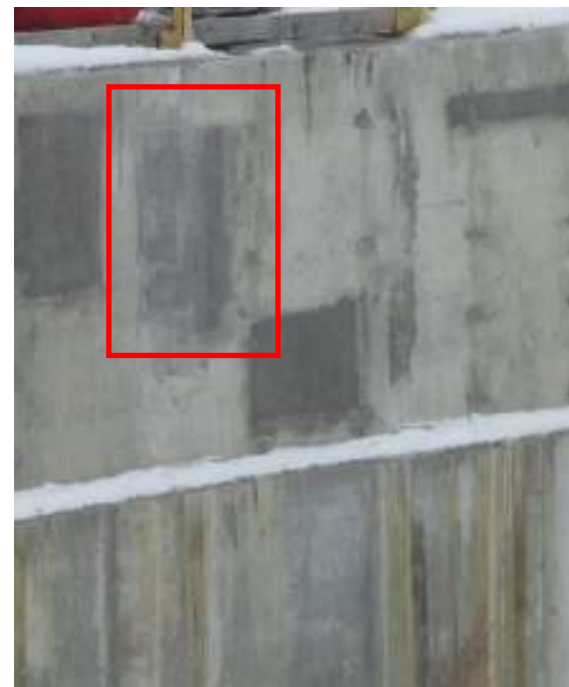

After Repair

PHOTO 10



Before Repair




After Repair

PHOTO 11



Before Repair

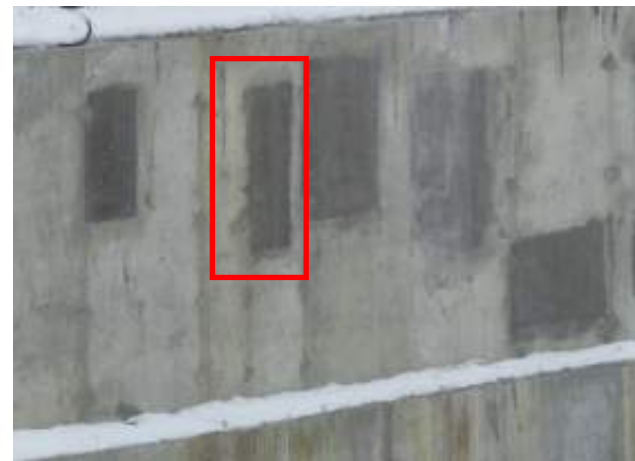


After Repair

PHOTO 12



Before Repair

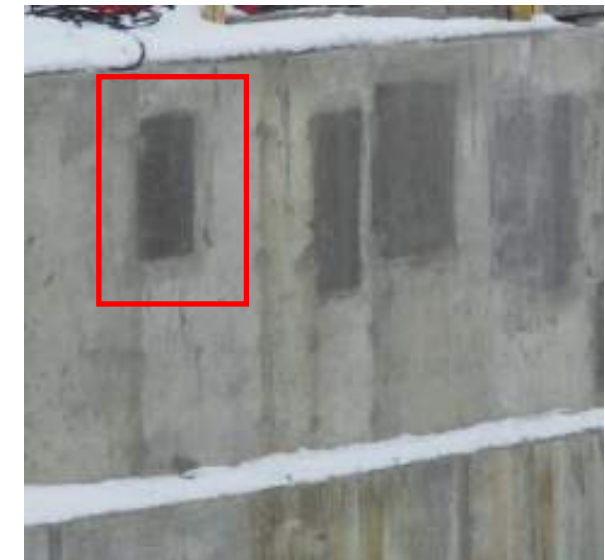

After Repair

PHOTO 13



Before Repair




After Repair

PHOTO 14



Before Repair

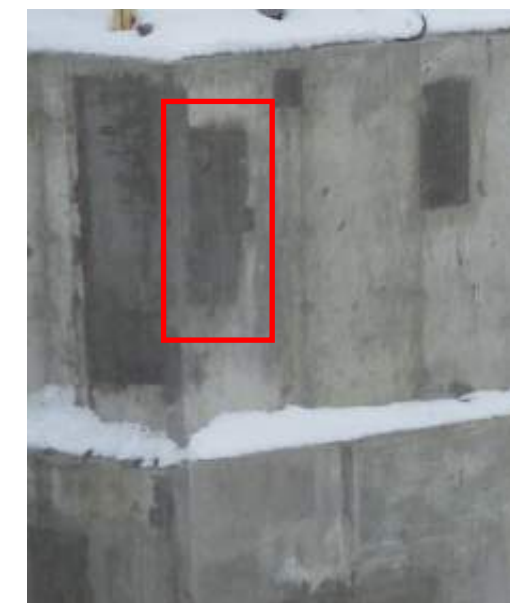

After Repair

PHOTO 15



Before Repair



After Repair

PHOTO 16



Before Repair



After Repair

PHOTO 17

1



Before Repair



After Repair

PHOTO 18



Before Repair




After Repair

PHOTO 19





Before Repair

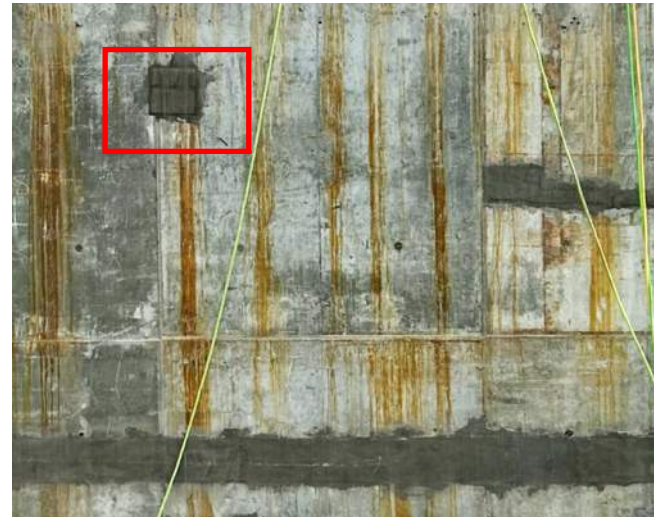

After Repair

PHOTO 20



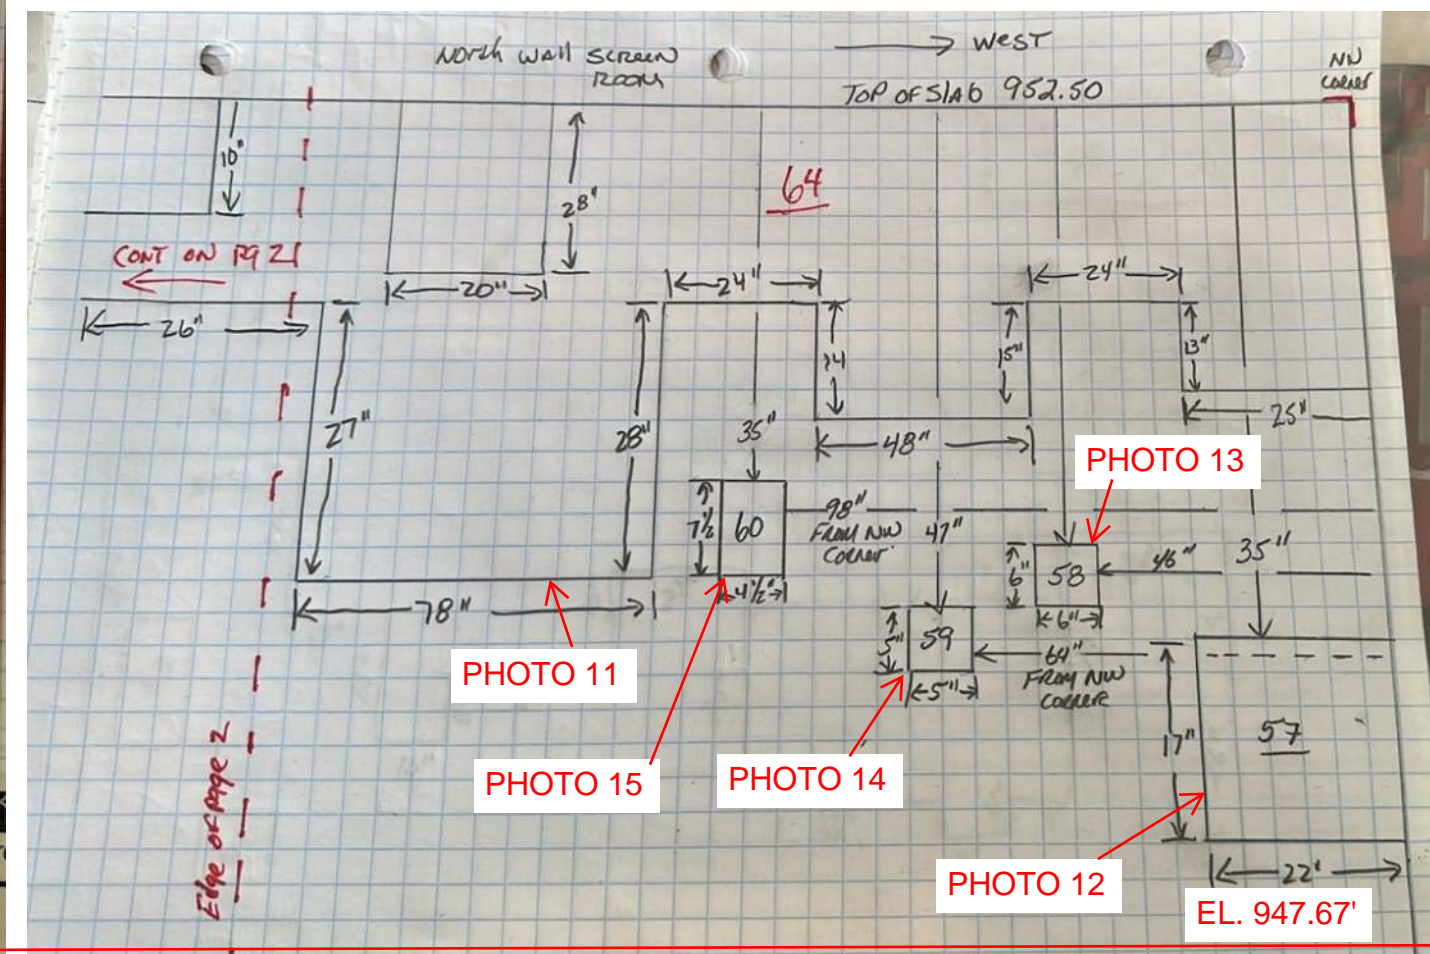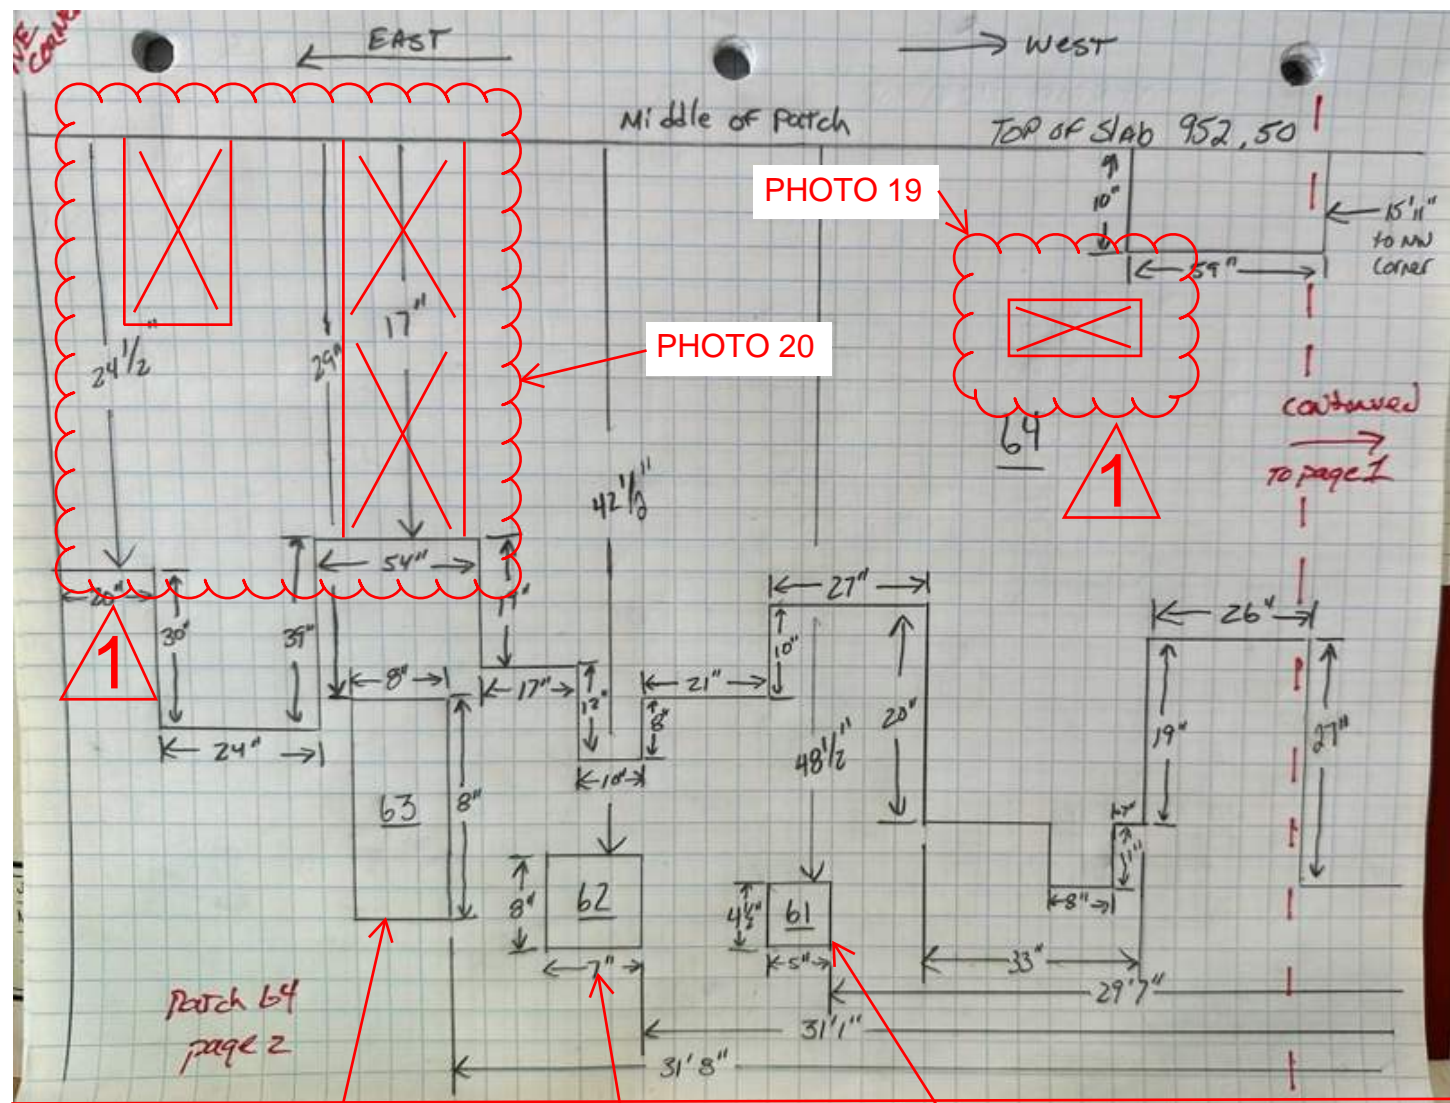

1 REVISION 1: REPAIRED EXISTING REPAIRS

LEGEND:

X DENOTES REMOVAL



Before Repair



After Repair

PHOTO 1



Before Repair



After Repair

PHOTO 3



Before Repair



After Repair

PHOTO 2



Before Repair



After Repair

PHOTO 4



Before Repair



After Repair

PHOTO 6



Before Repair



Before Repair

PHOTO 7



Before Repair



Before Repair


PHOTO 7



Before Repair



Before Repair

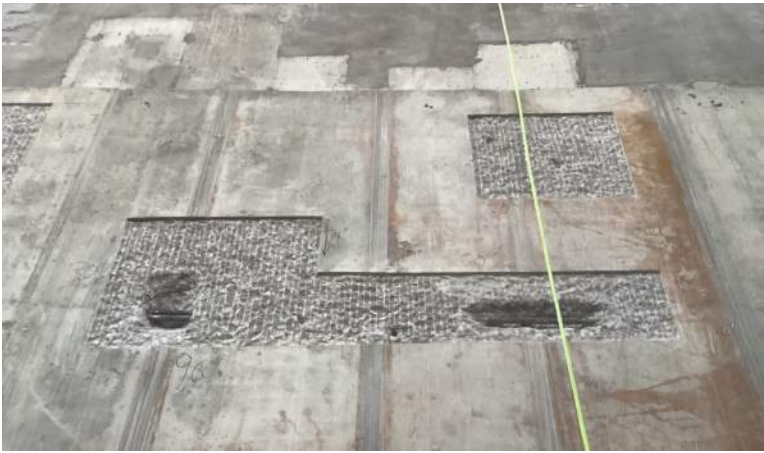

Before Repair



After Repair



After Repair

PHOTO 10



After Repair

PHOTO 10



Before Repair



Before Repair



Before Repair



Before Repair

PHOTO 11



Before Repair



Before Repair



After Repair



After Repair

PHOTO 11



After Repair



After Repair



After Repair



After Repair

PHOTO 11



Before Repair



After Repair

PHOTO 12



Before Repair



After Repair

PHOTO 13



Before Repair



After Repair

PHOTO 14



Before Repair




After Repair

PHOTO 15



Before Repair

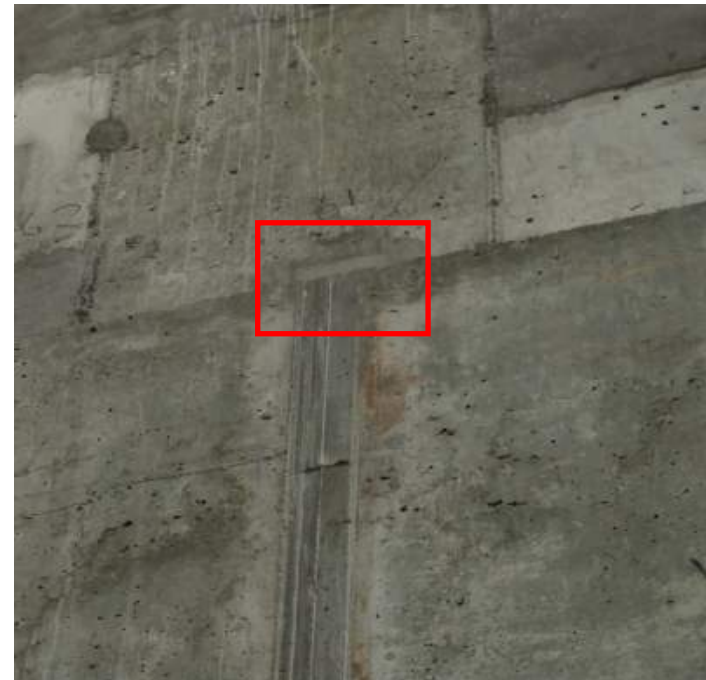

After Repair

PHOTO 16



Before Repair



After Repair

PHOTO 17



Before Repair



After Repair

PHOTO 18



Before Repair



After Repair

PHOTO 19

1





Before Repair




After Repair


PHOTO 20

1

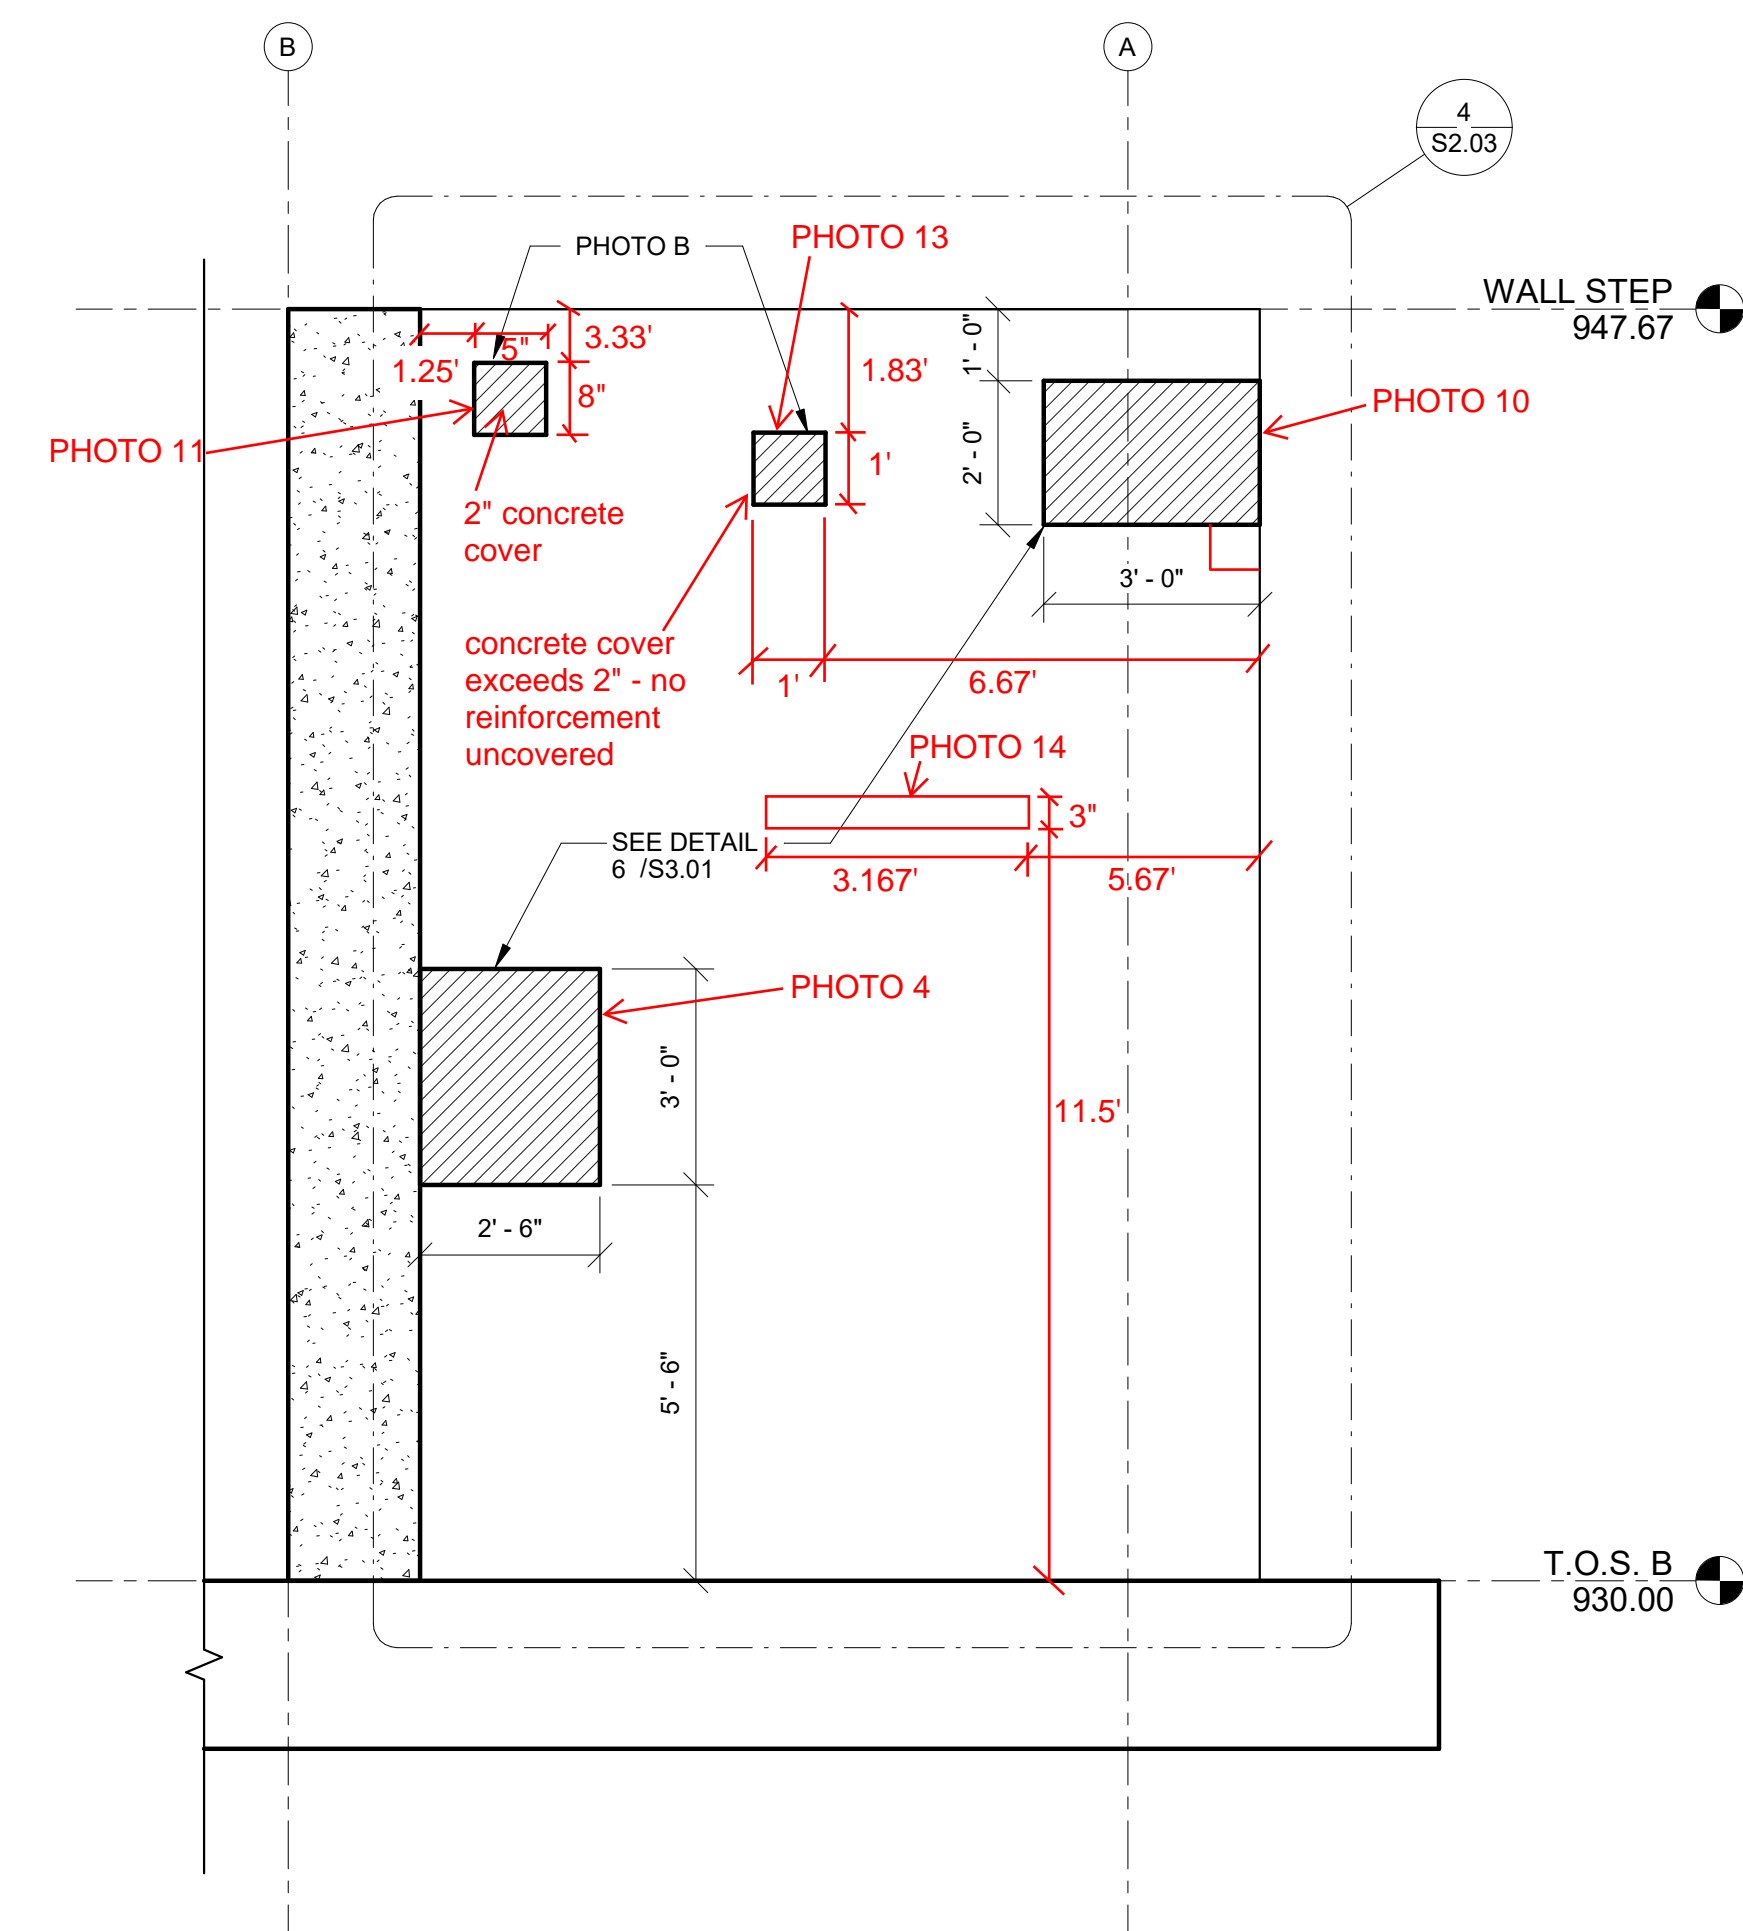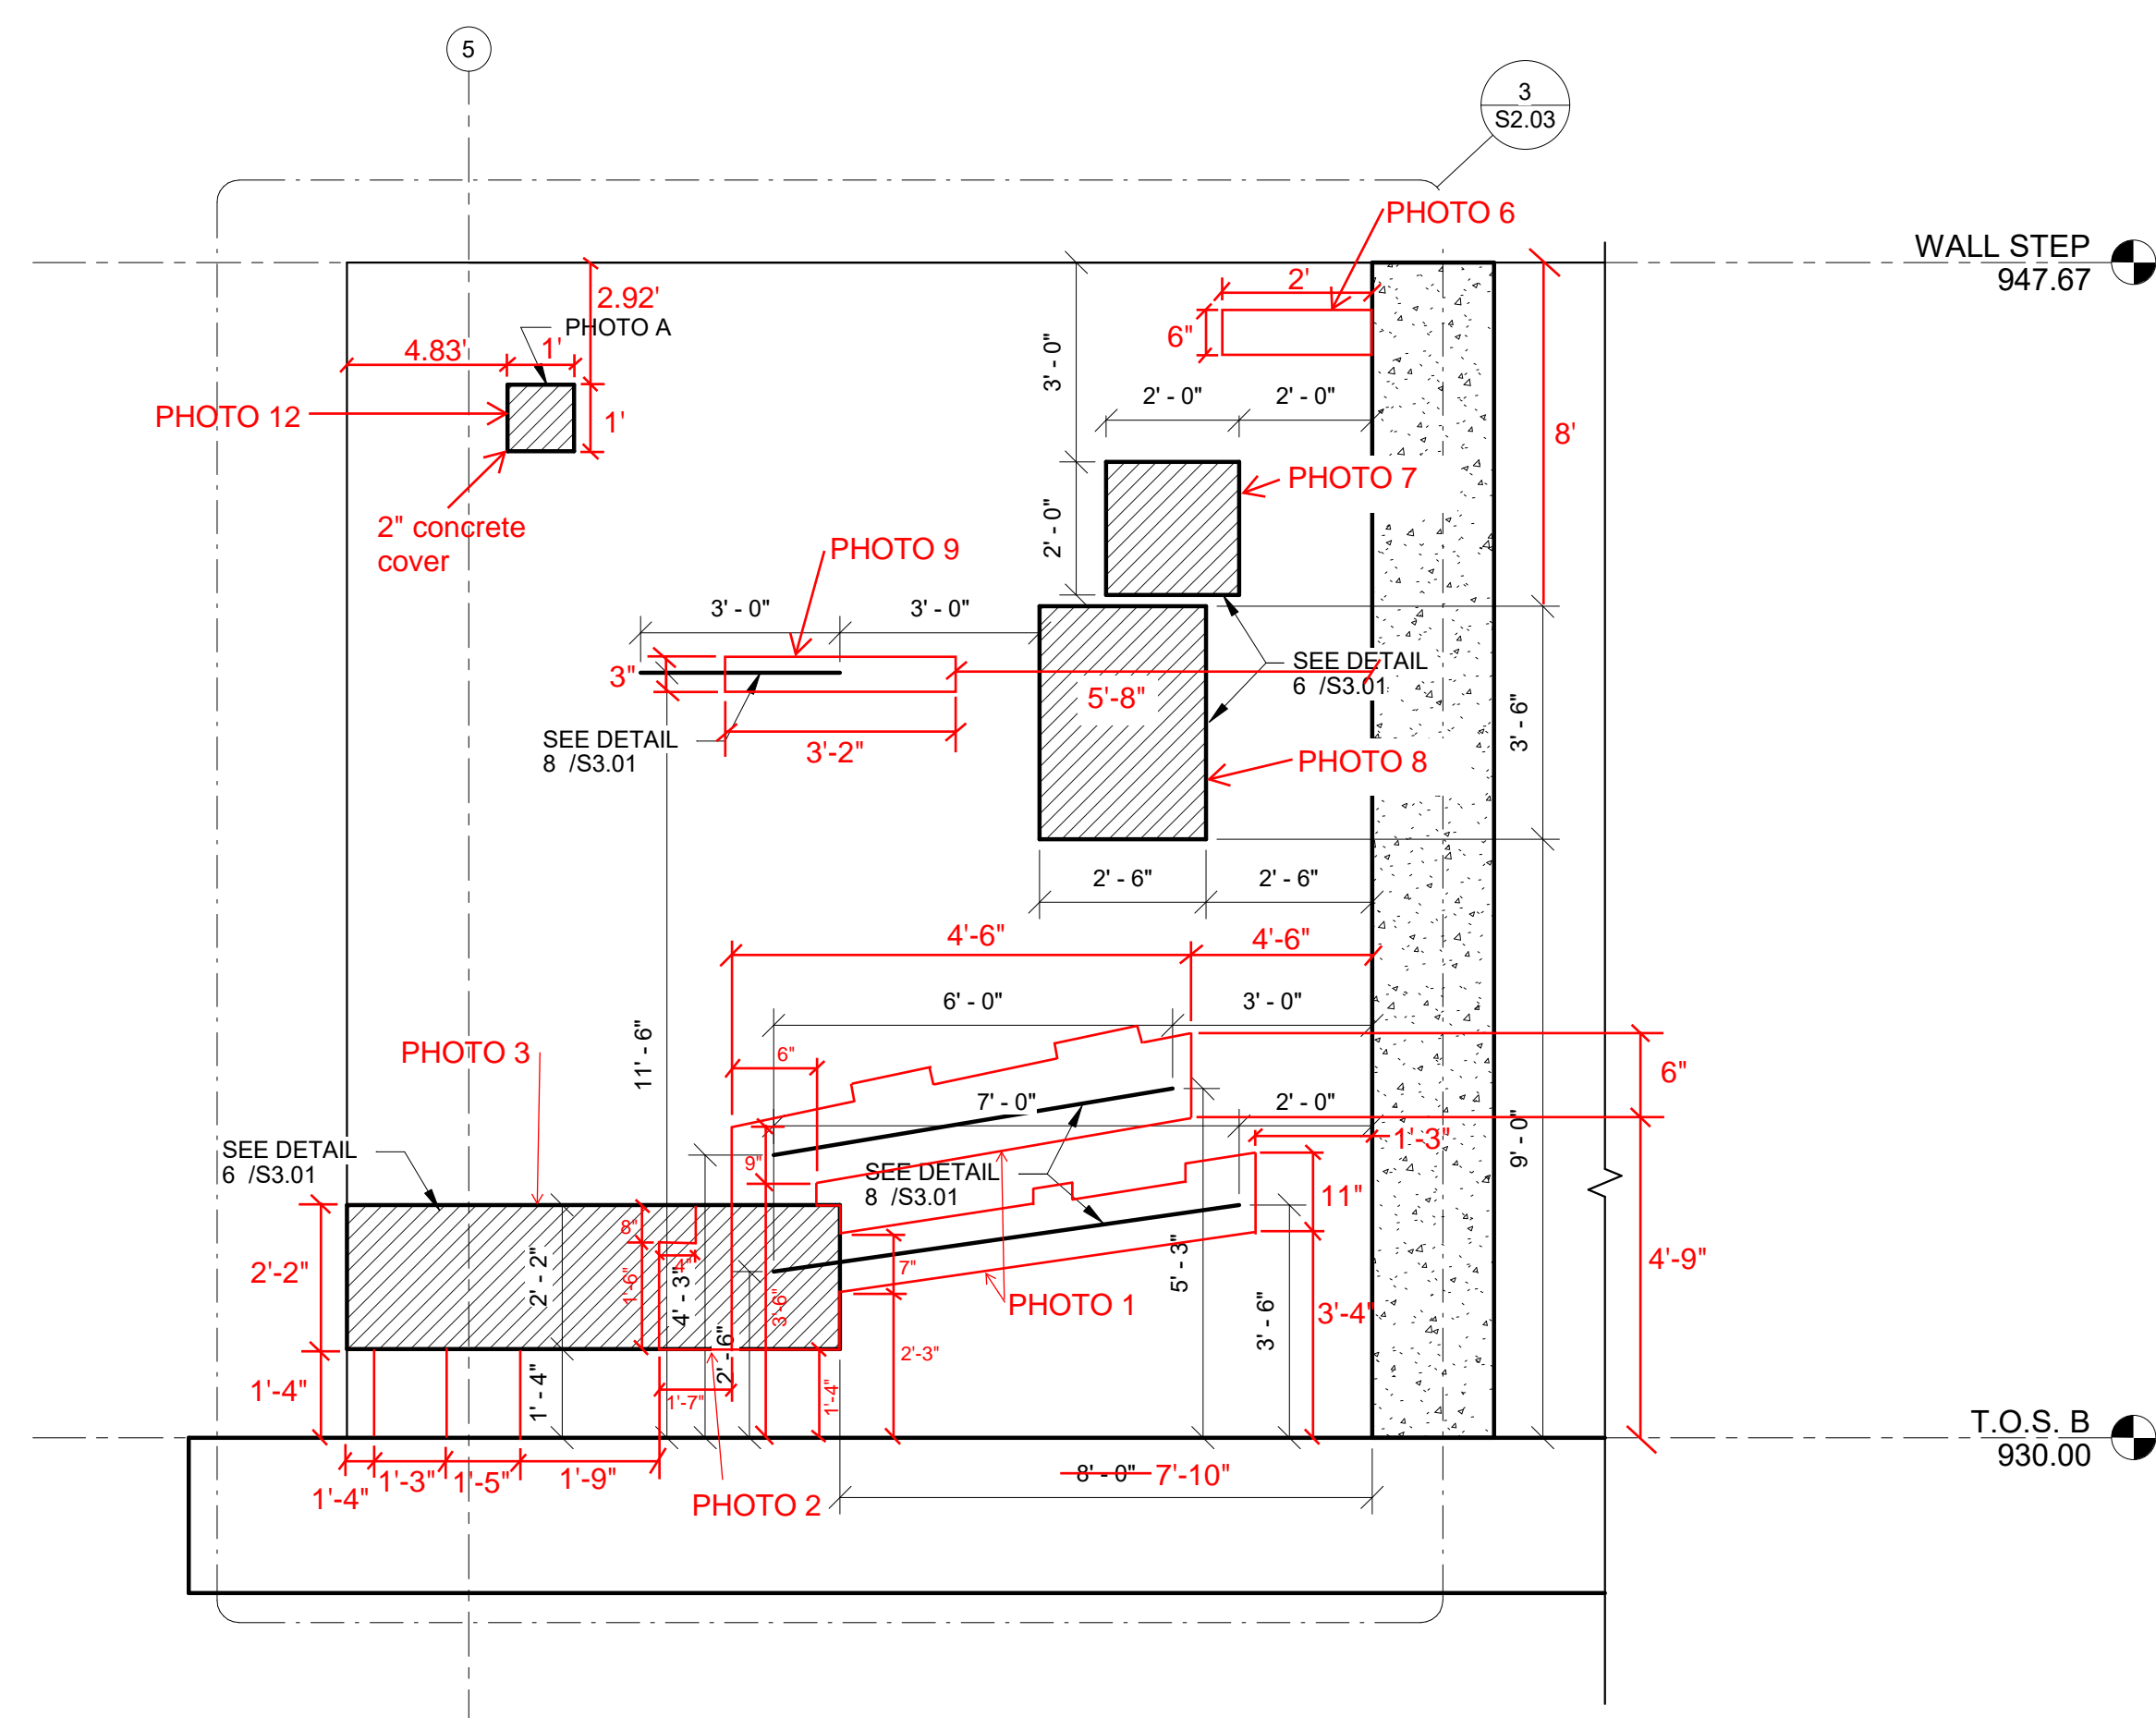

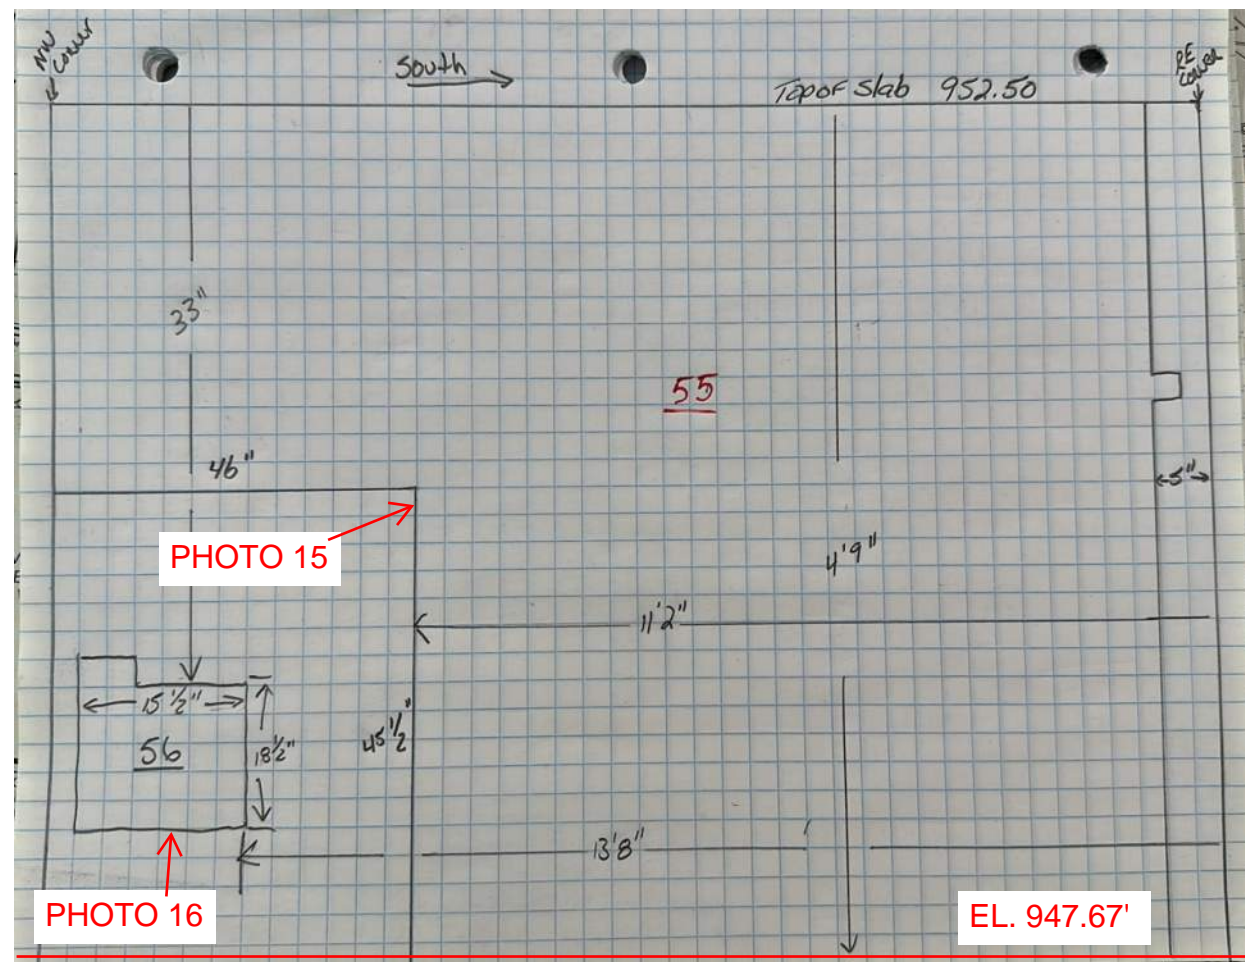



1 / S2.03

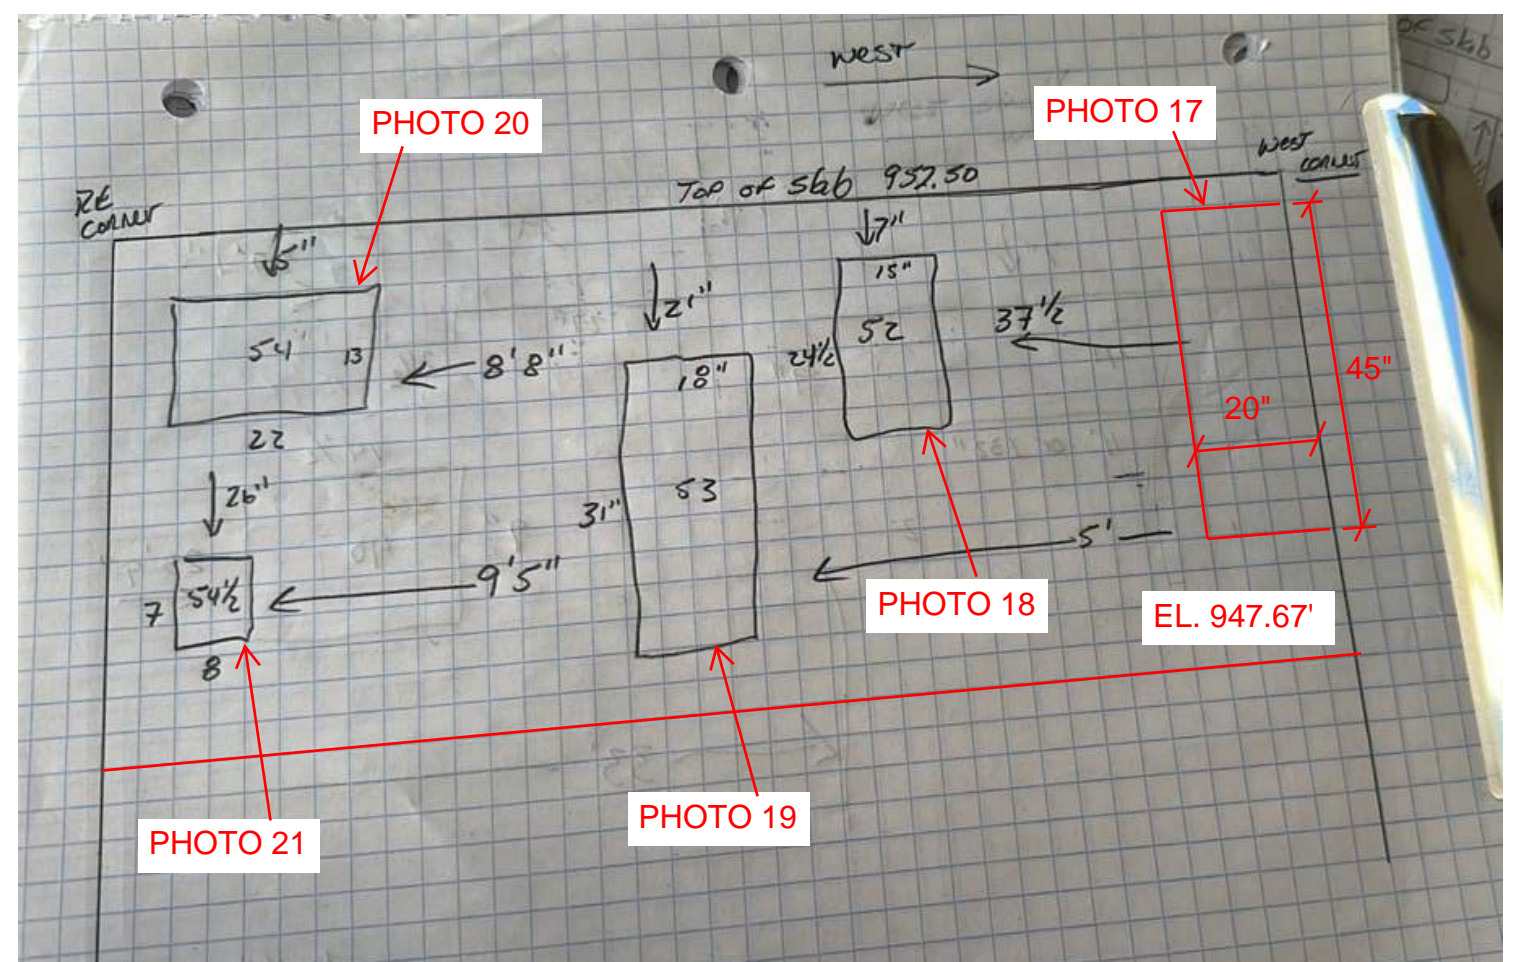

2 / S2.03

ORIGINAL REPAIRS

1

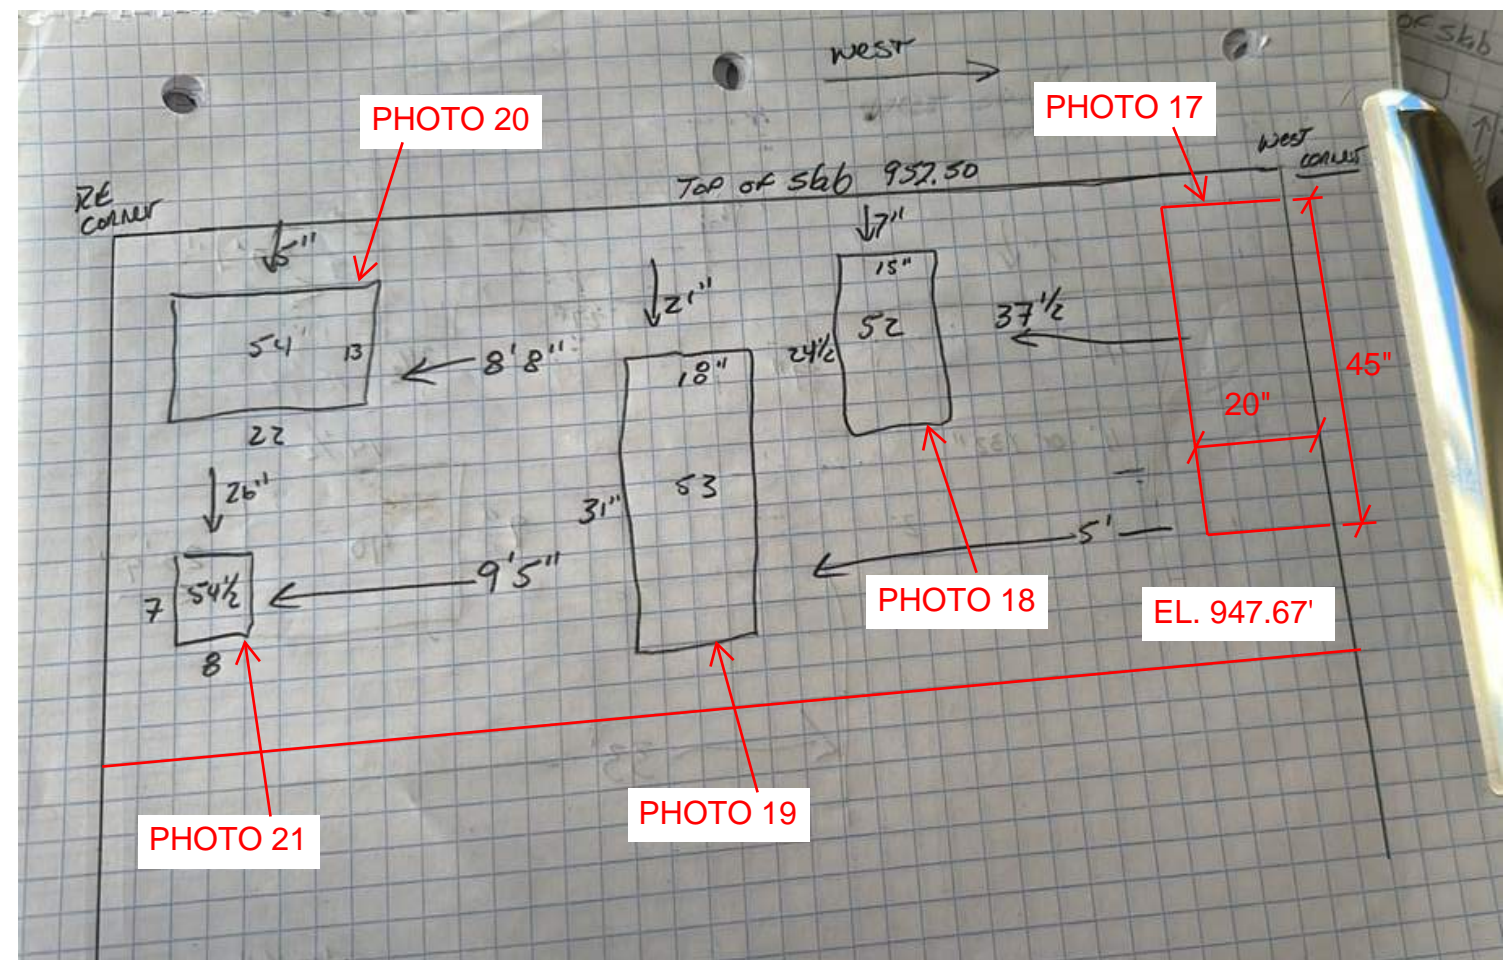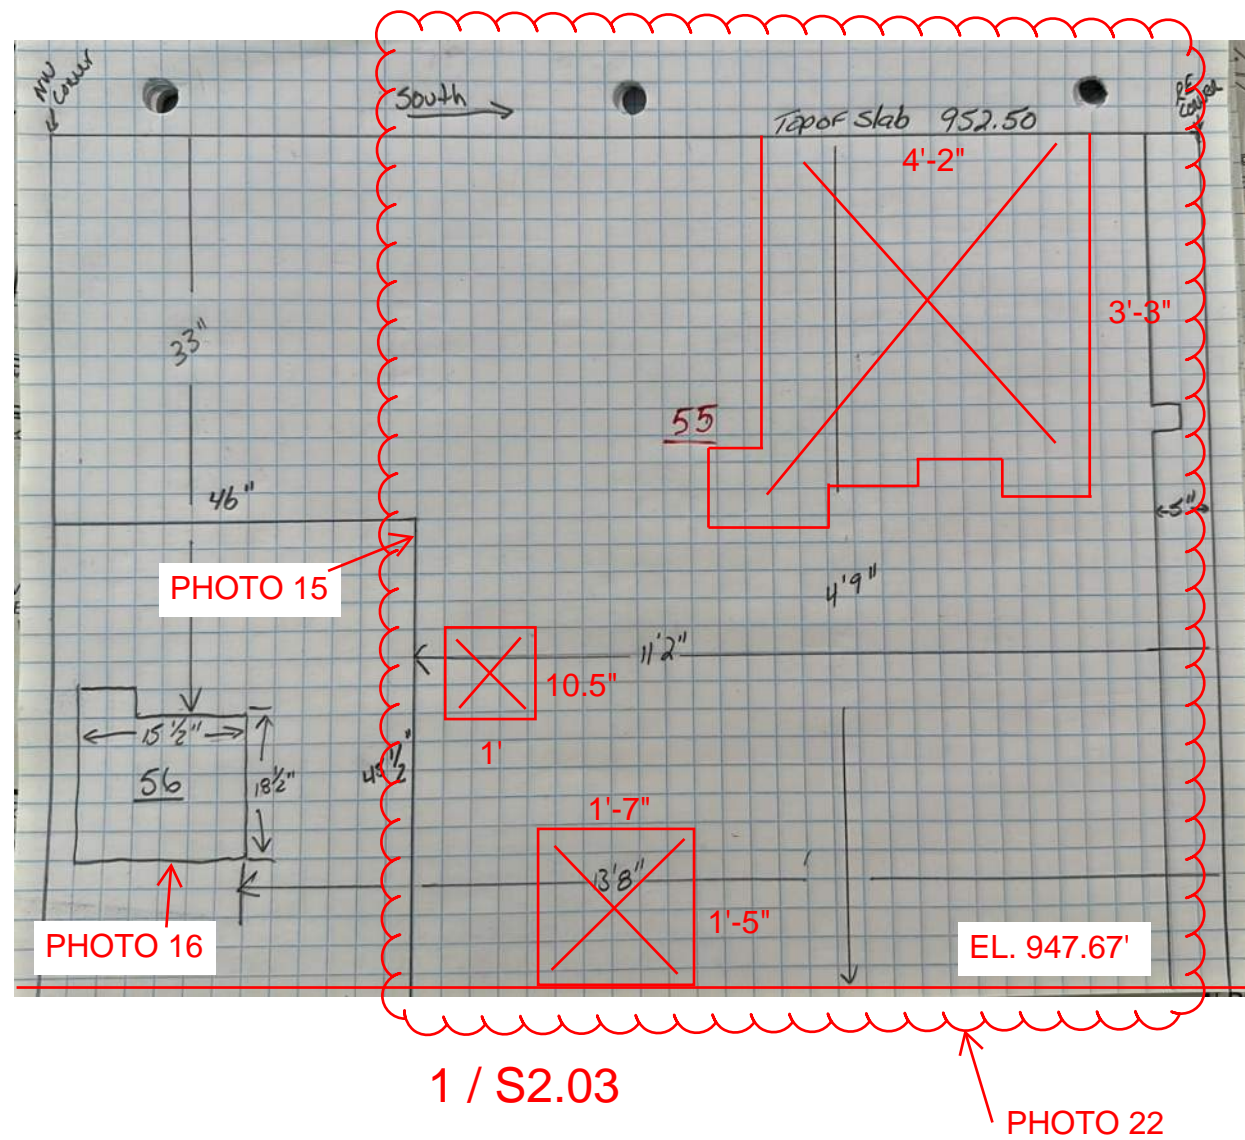

2 / S2.03

1 REVISION 1: REPAIRED EXISTING REPAIRS

LEGEND:

X DENOTES REMOVAL



Before Repair



After Repair

PHOTO 1



Before Repair



After Repair

PHOTO 2



Before Repair



After Repair

PHOTO 3



Before Repair



After Repair

PHOTO 4



Before Repair



After Repair

PHOTO 6



Before Repair



After Repair

PHOTO 7



Before Repair



After Repair

PHOTO 8



Before Repair



After Repair

PHOTO 9



Before Repair



After Repair

PHOTO 10




Before Repair



After Repair

PHOTO 11

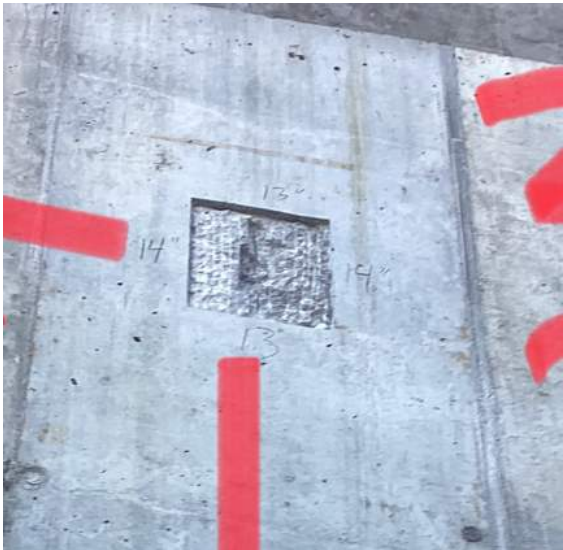

Before Repair



After Repair

PHOTO 12



Before Repair




After Repair

PHOTO 13



Before Repair

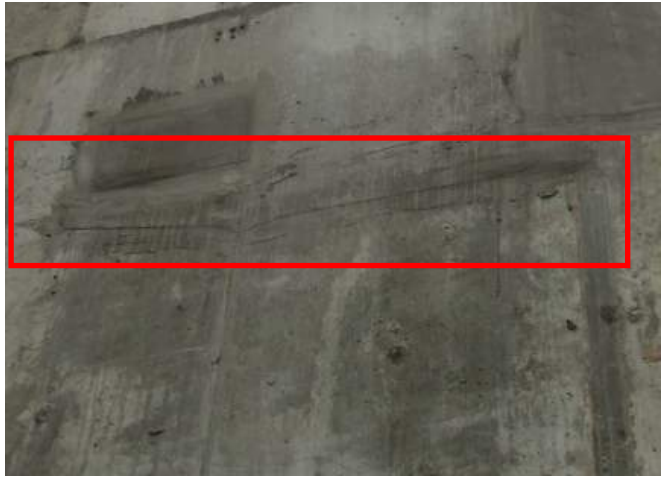

After Repair

PHOTO 14



Before Repair



After Repair

PHOTO 15



Before Repair



After Repair

PHOTO 16



Before Repair



After Repair

PHOTO 17



Before Repair



After Repair

PHOTO 18



Before Repair



After Repair

PHOTO 19



Before Repair



After Repair

PHOTO 20



Before Repair



After Repair

PHOTO 21




Before Repair





After Repair

PHOTO 22


1

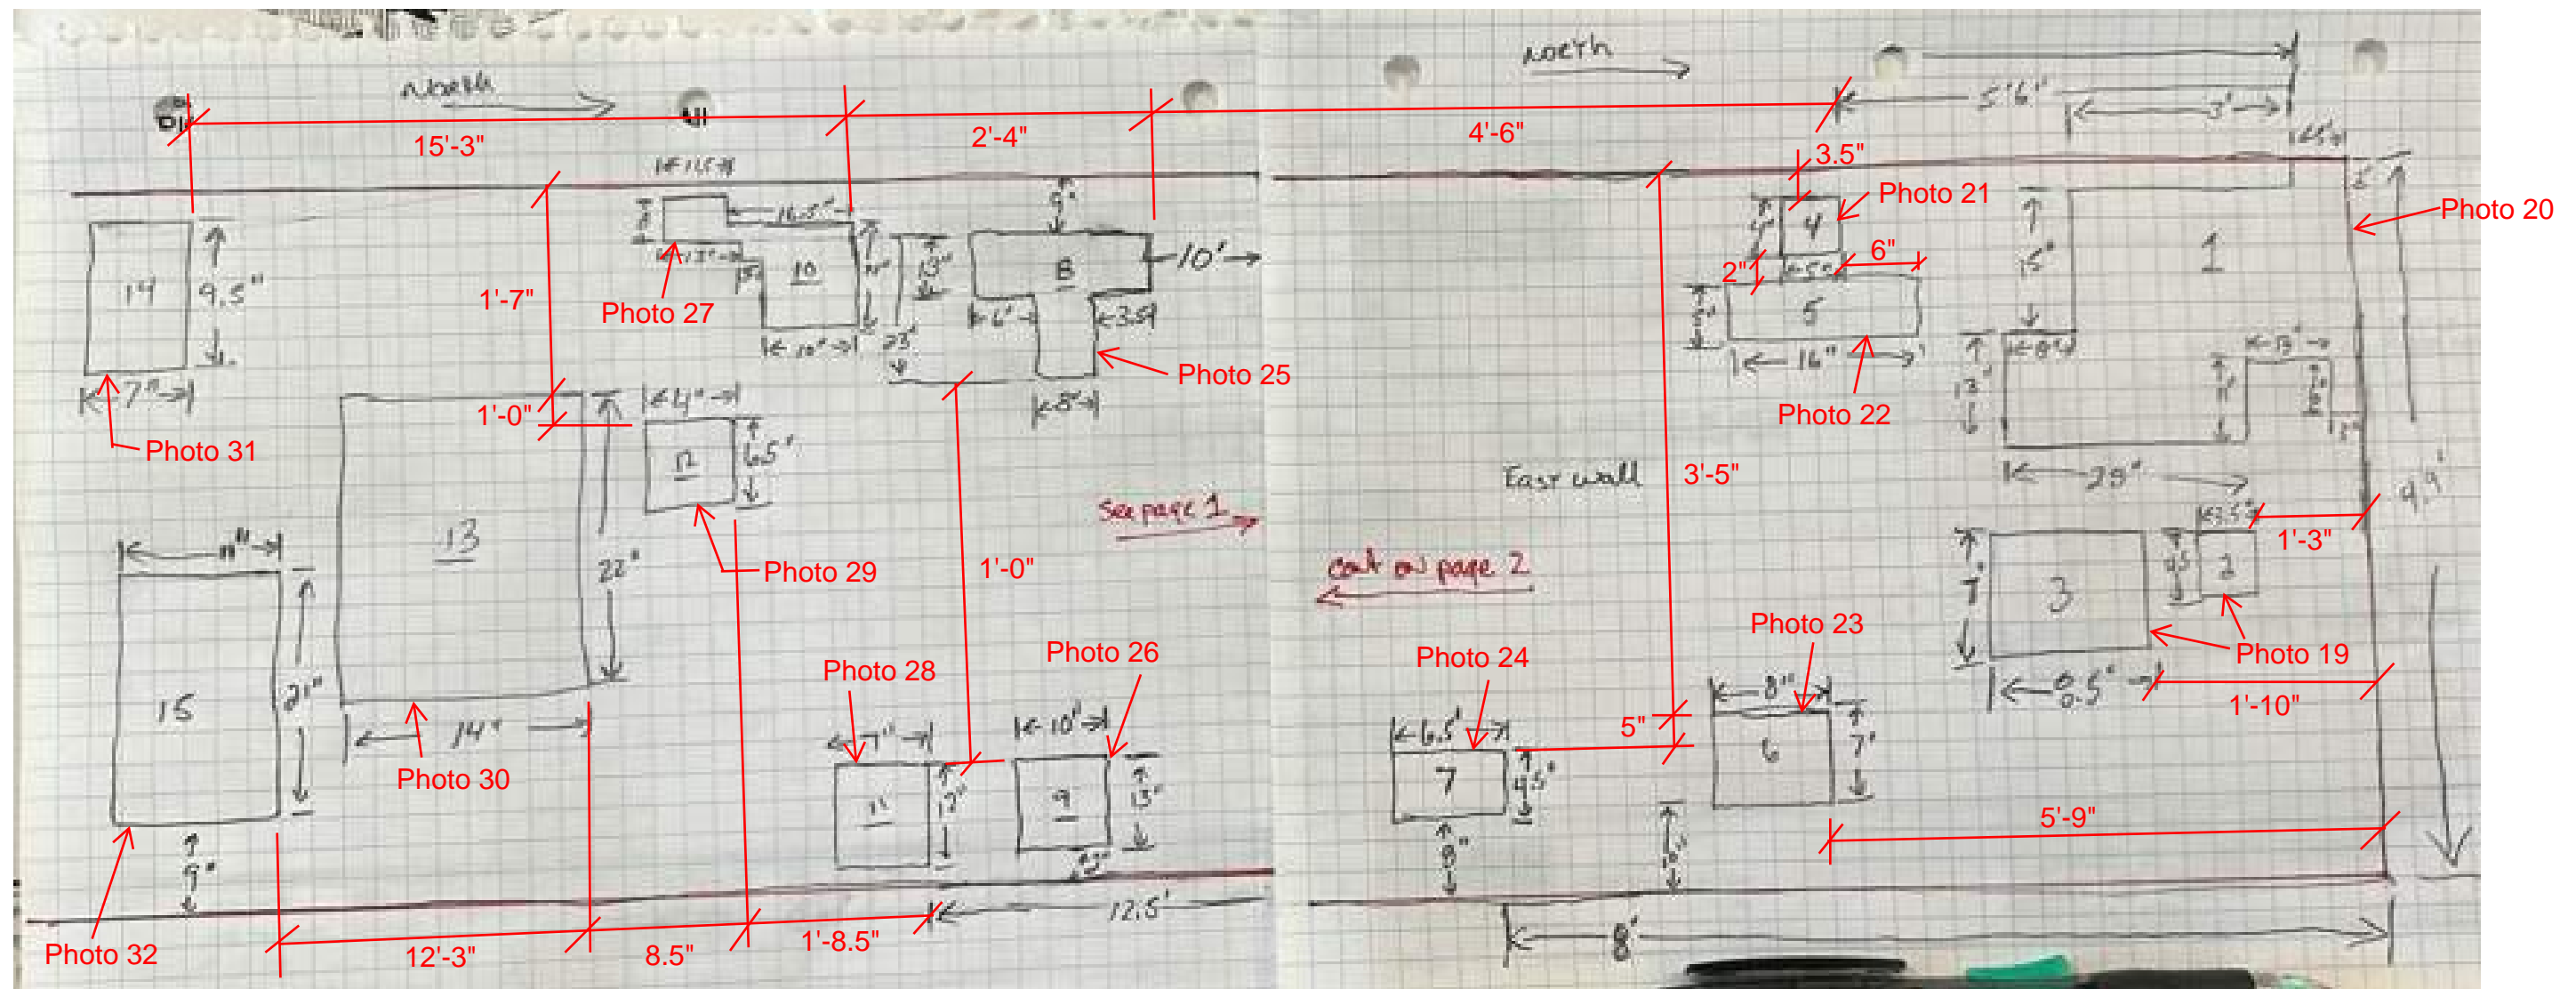

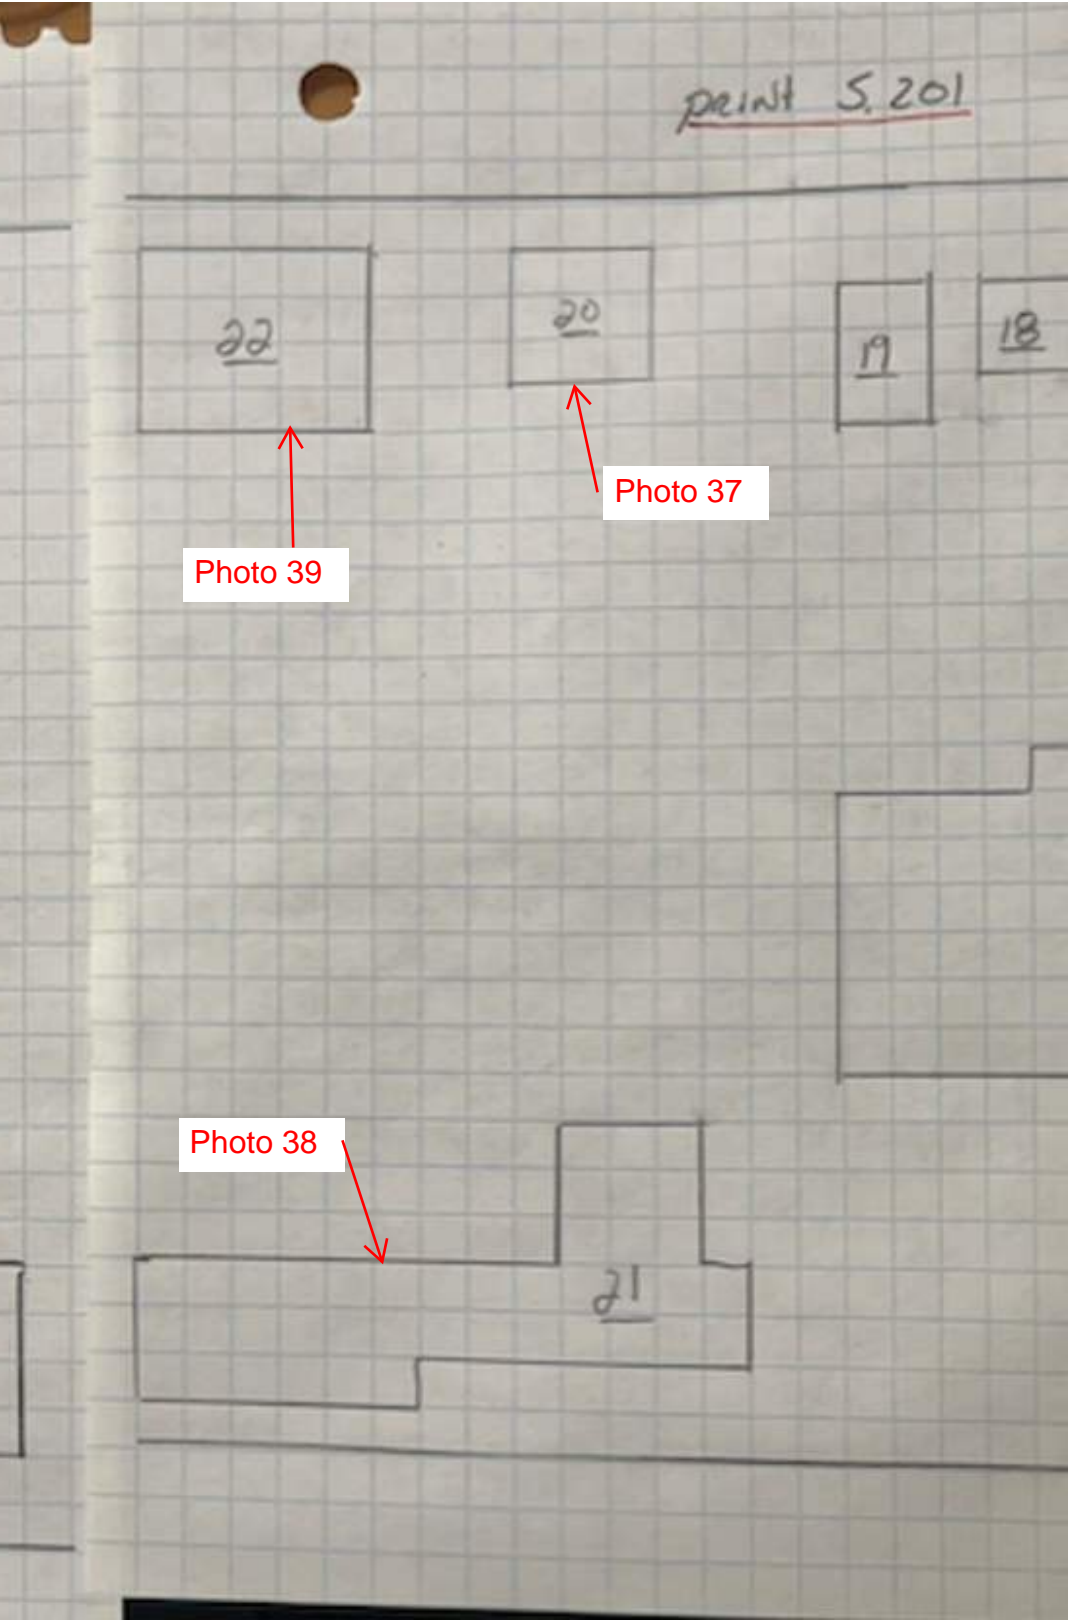

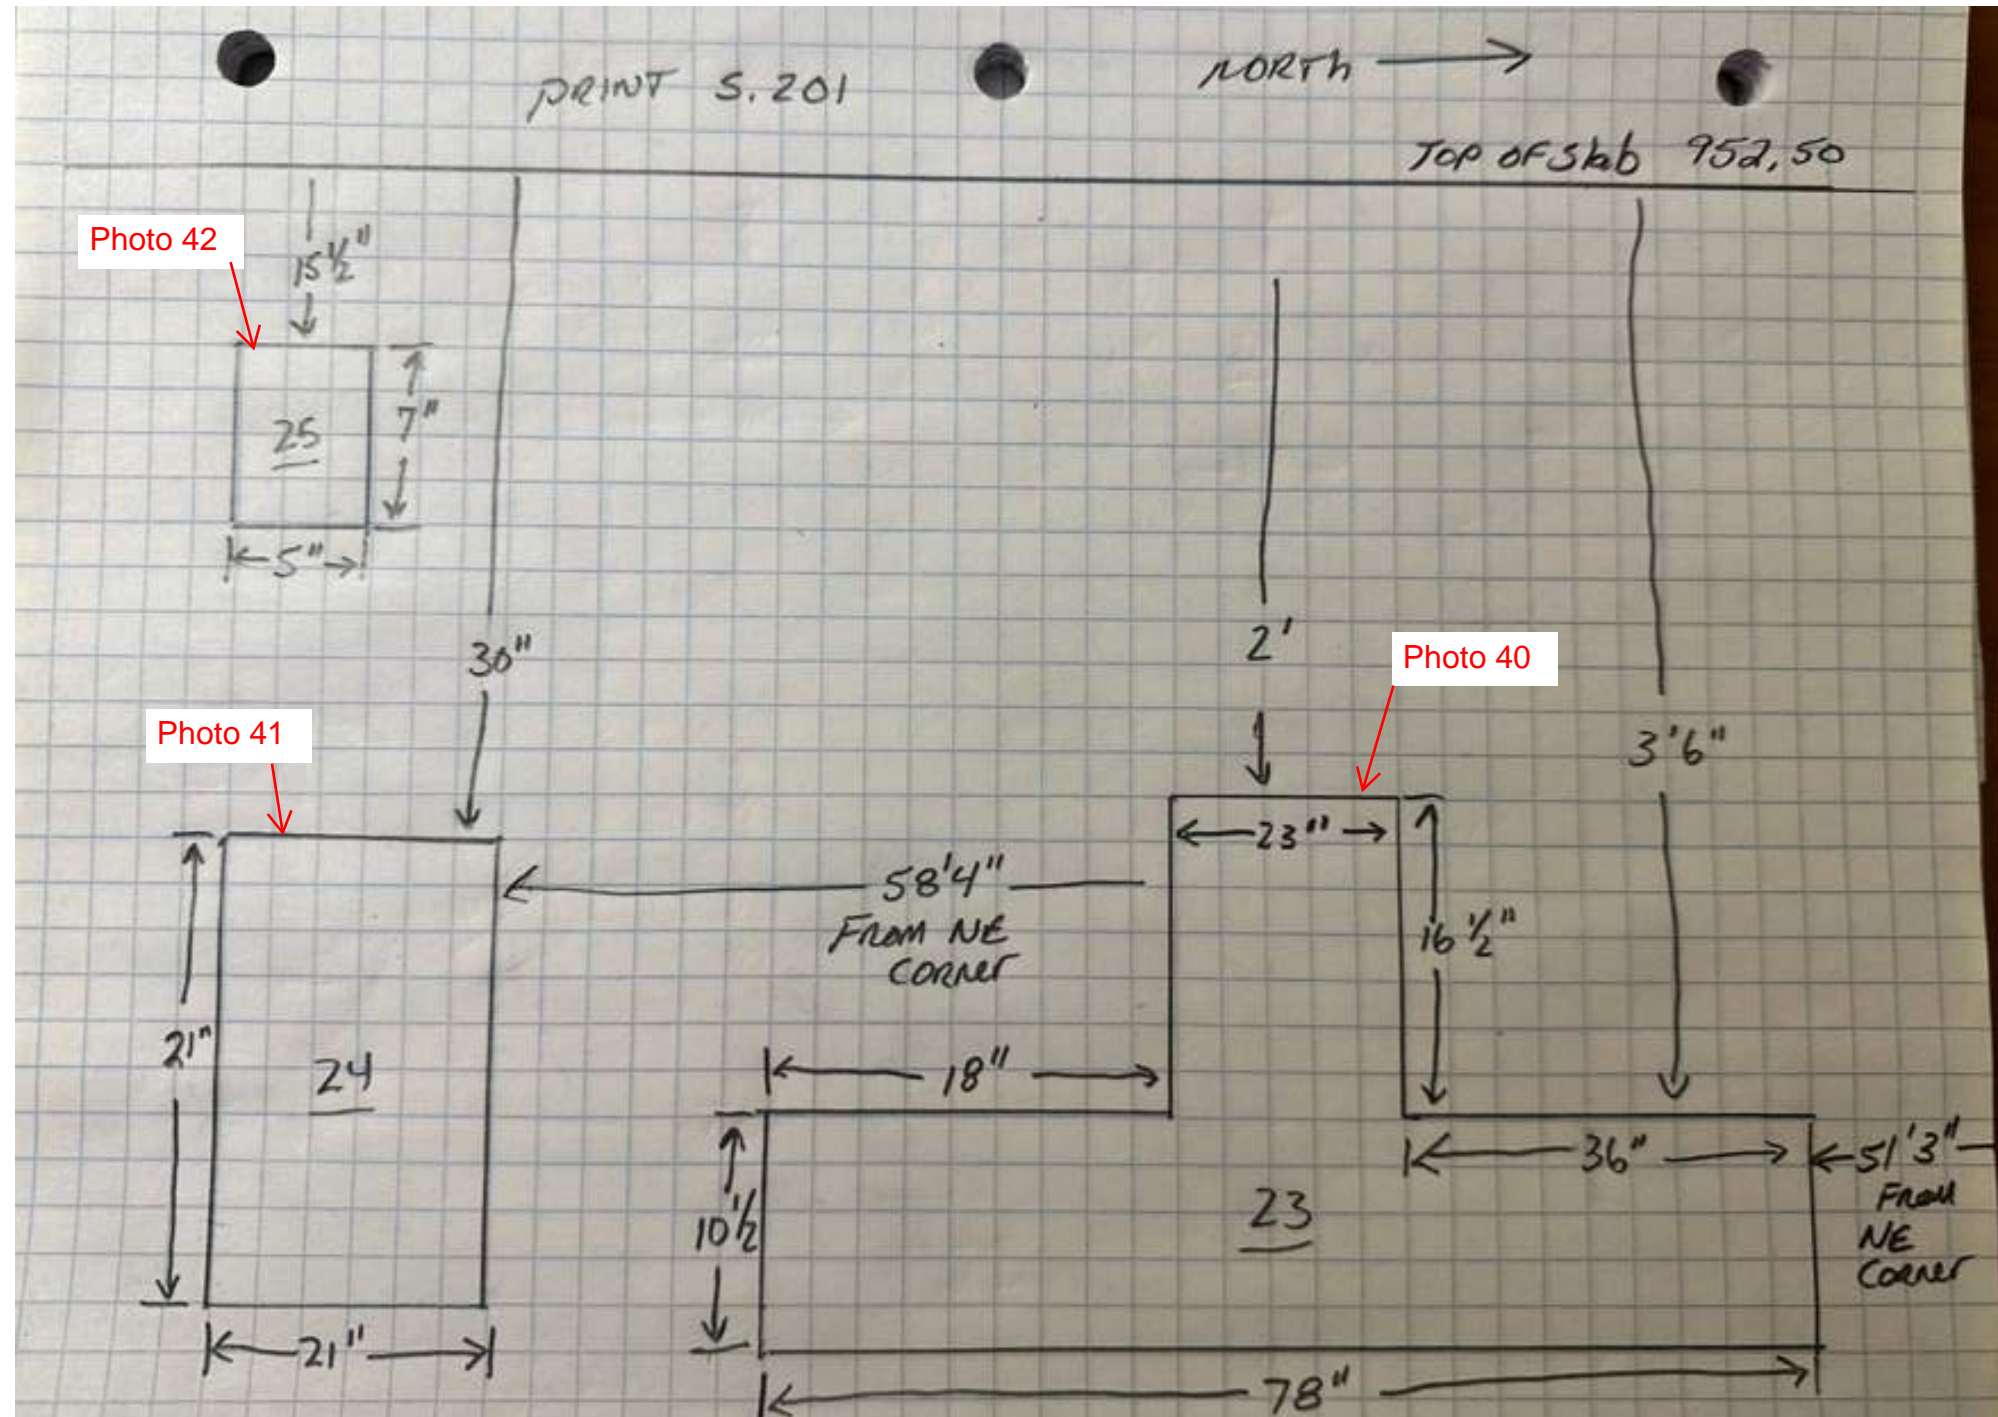


ORIGINAL REPAIRS

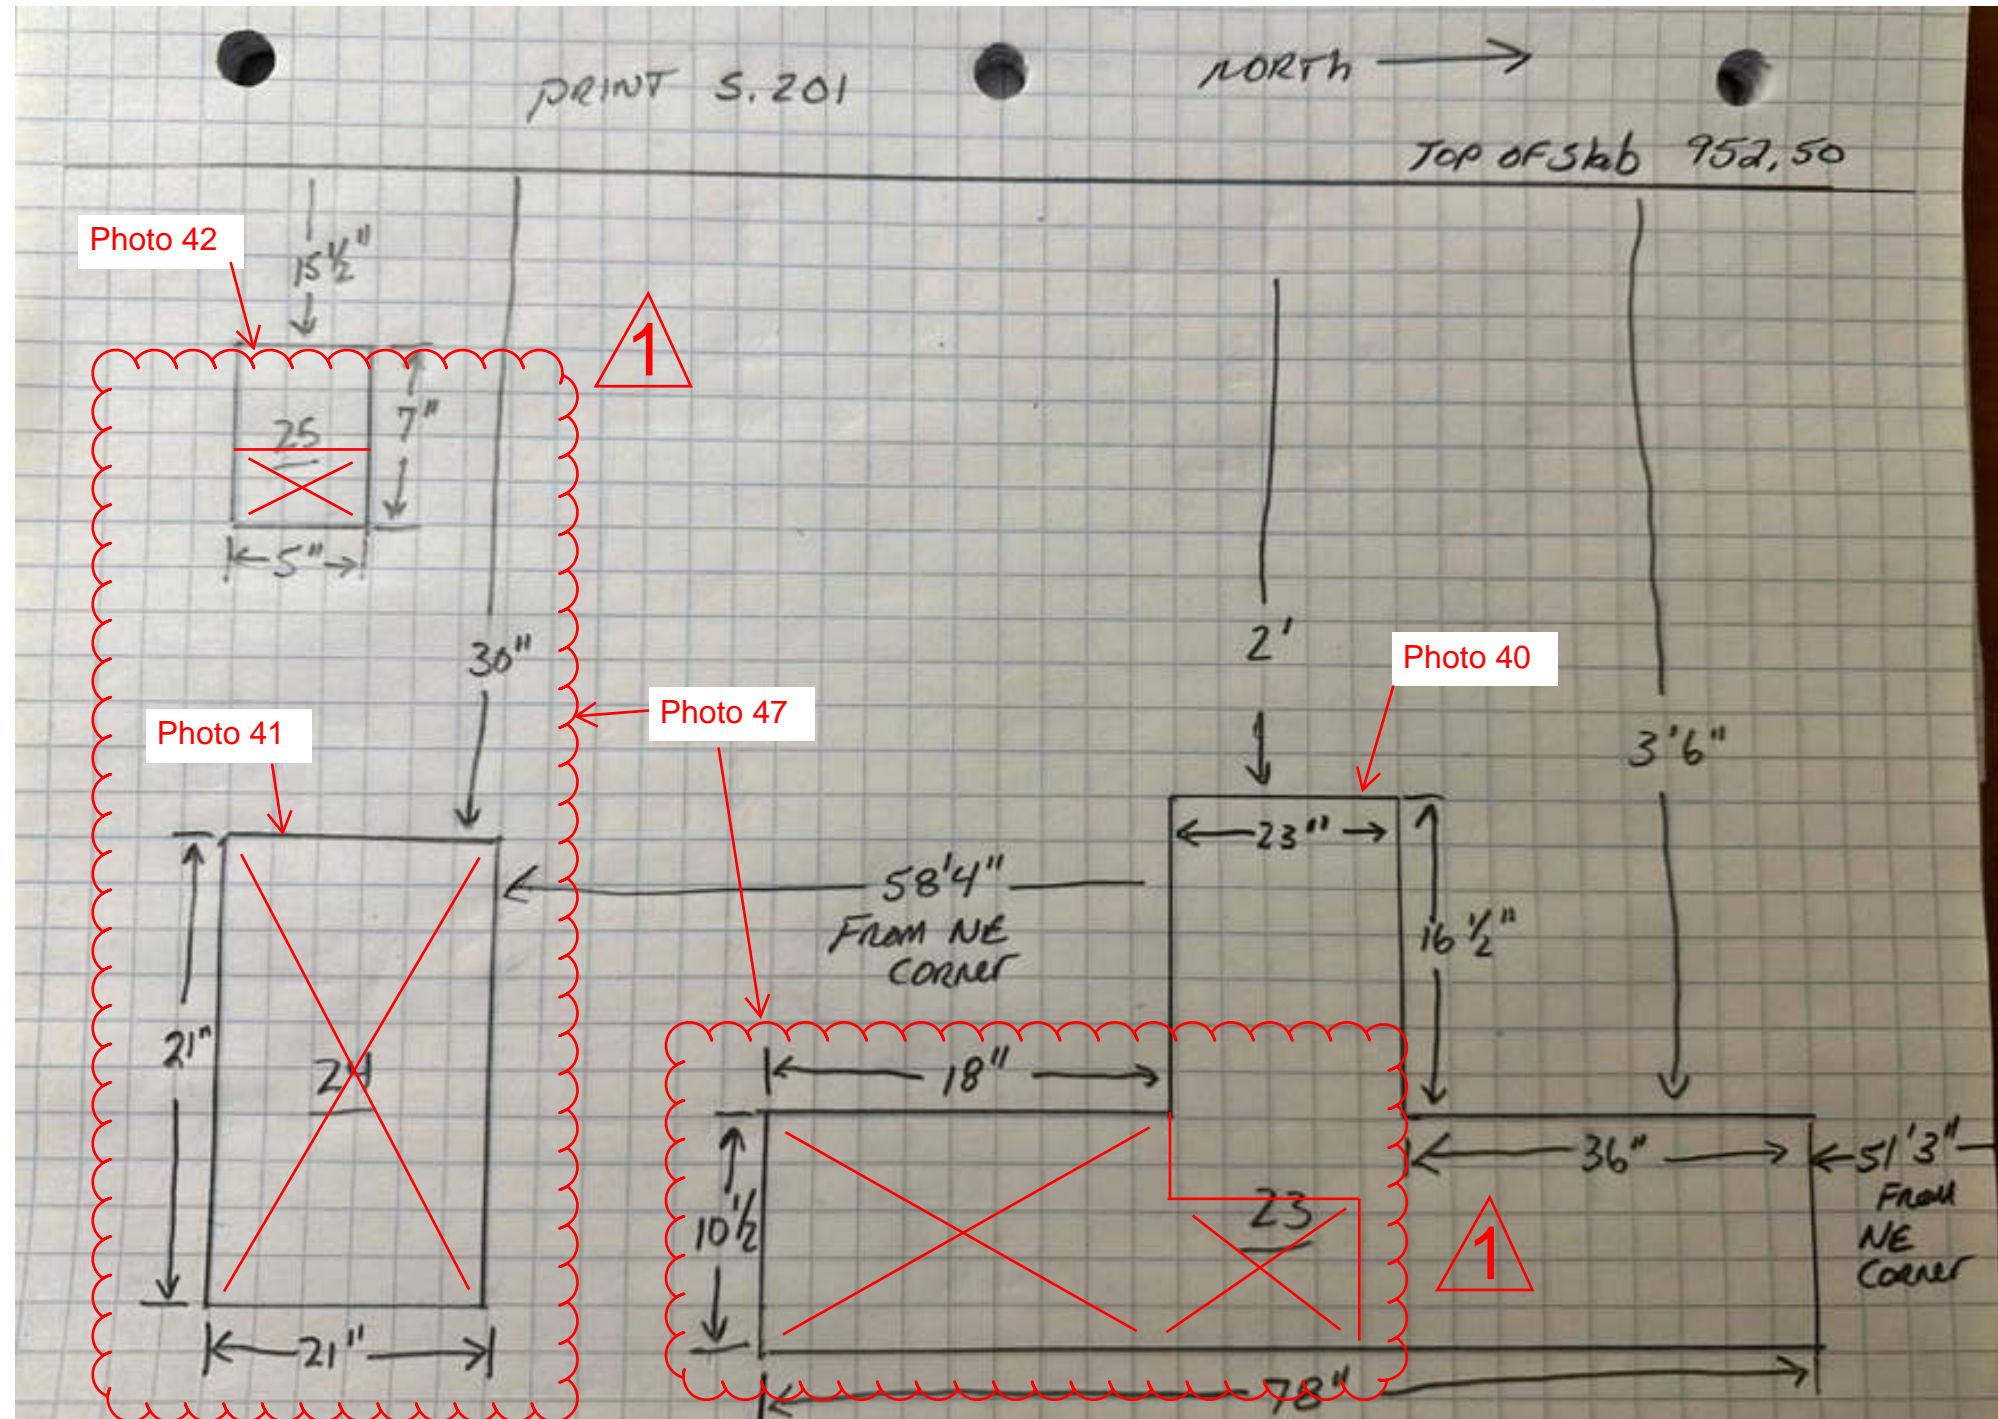


1 REVISION 1: REPAIRED EXISTING REPAIRS

LEGEND:

X DENOTES REMOVAL

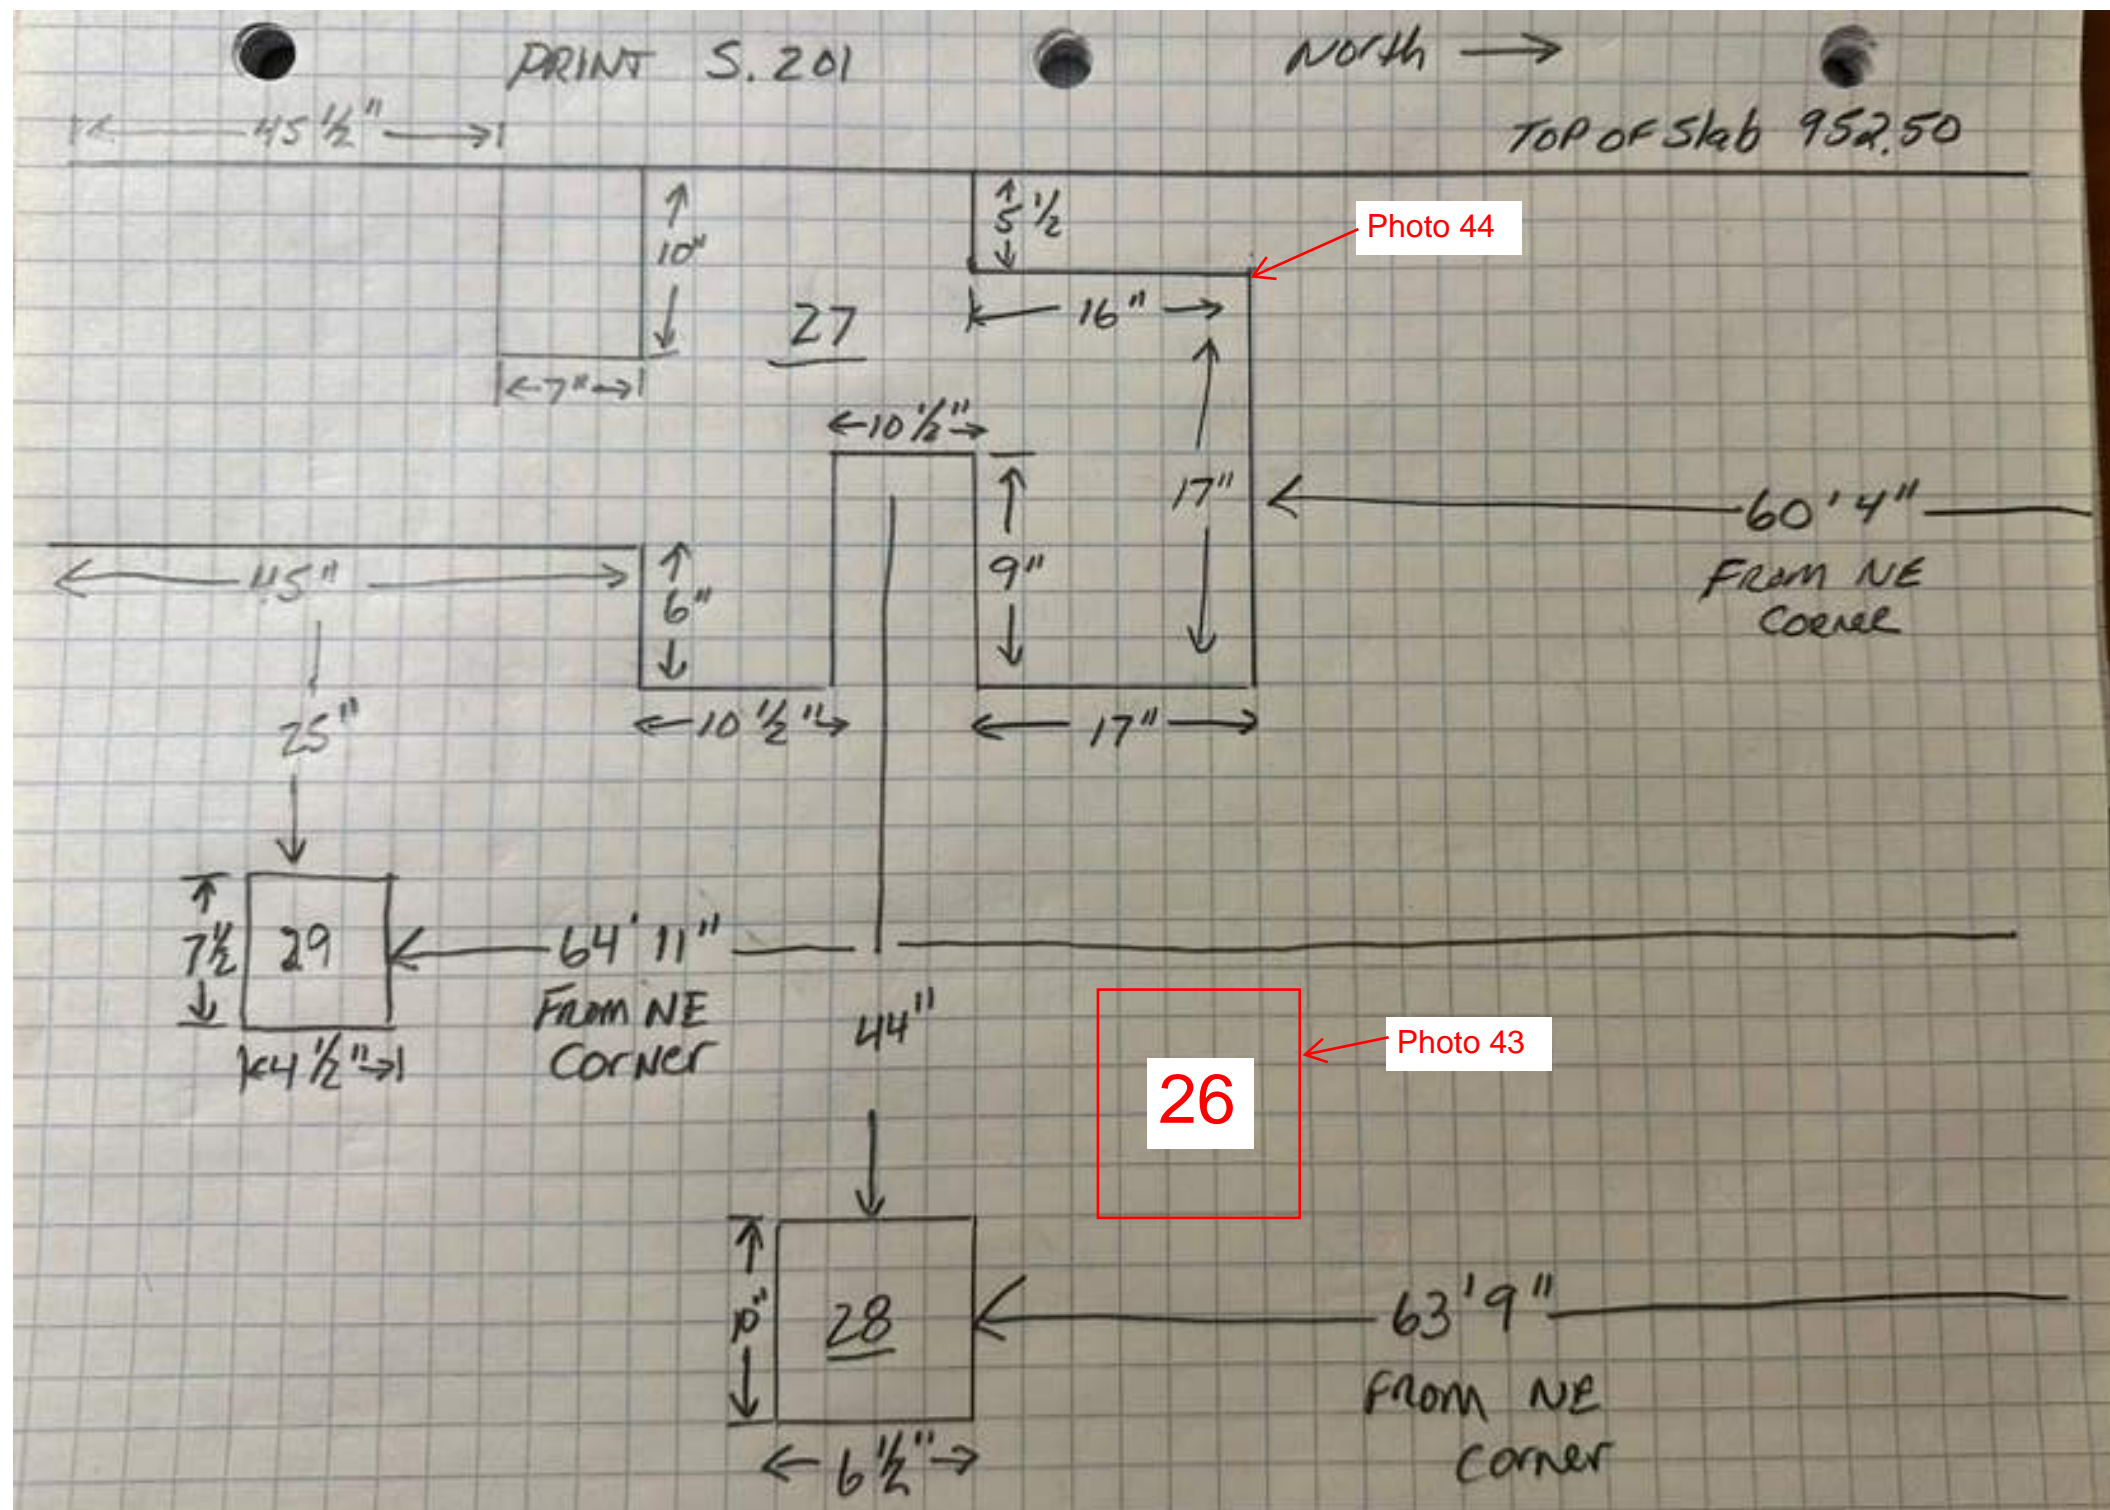

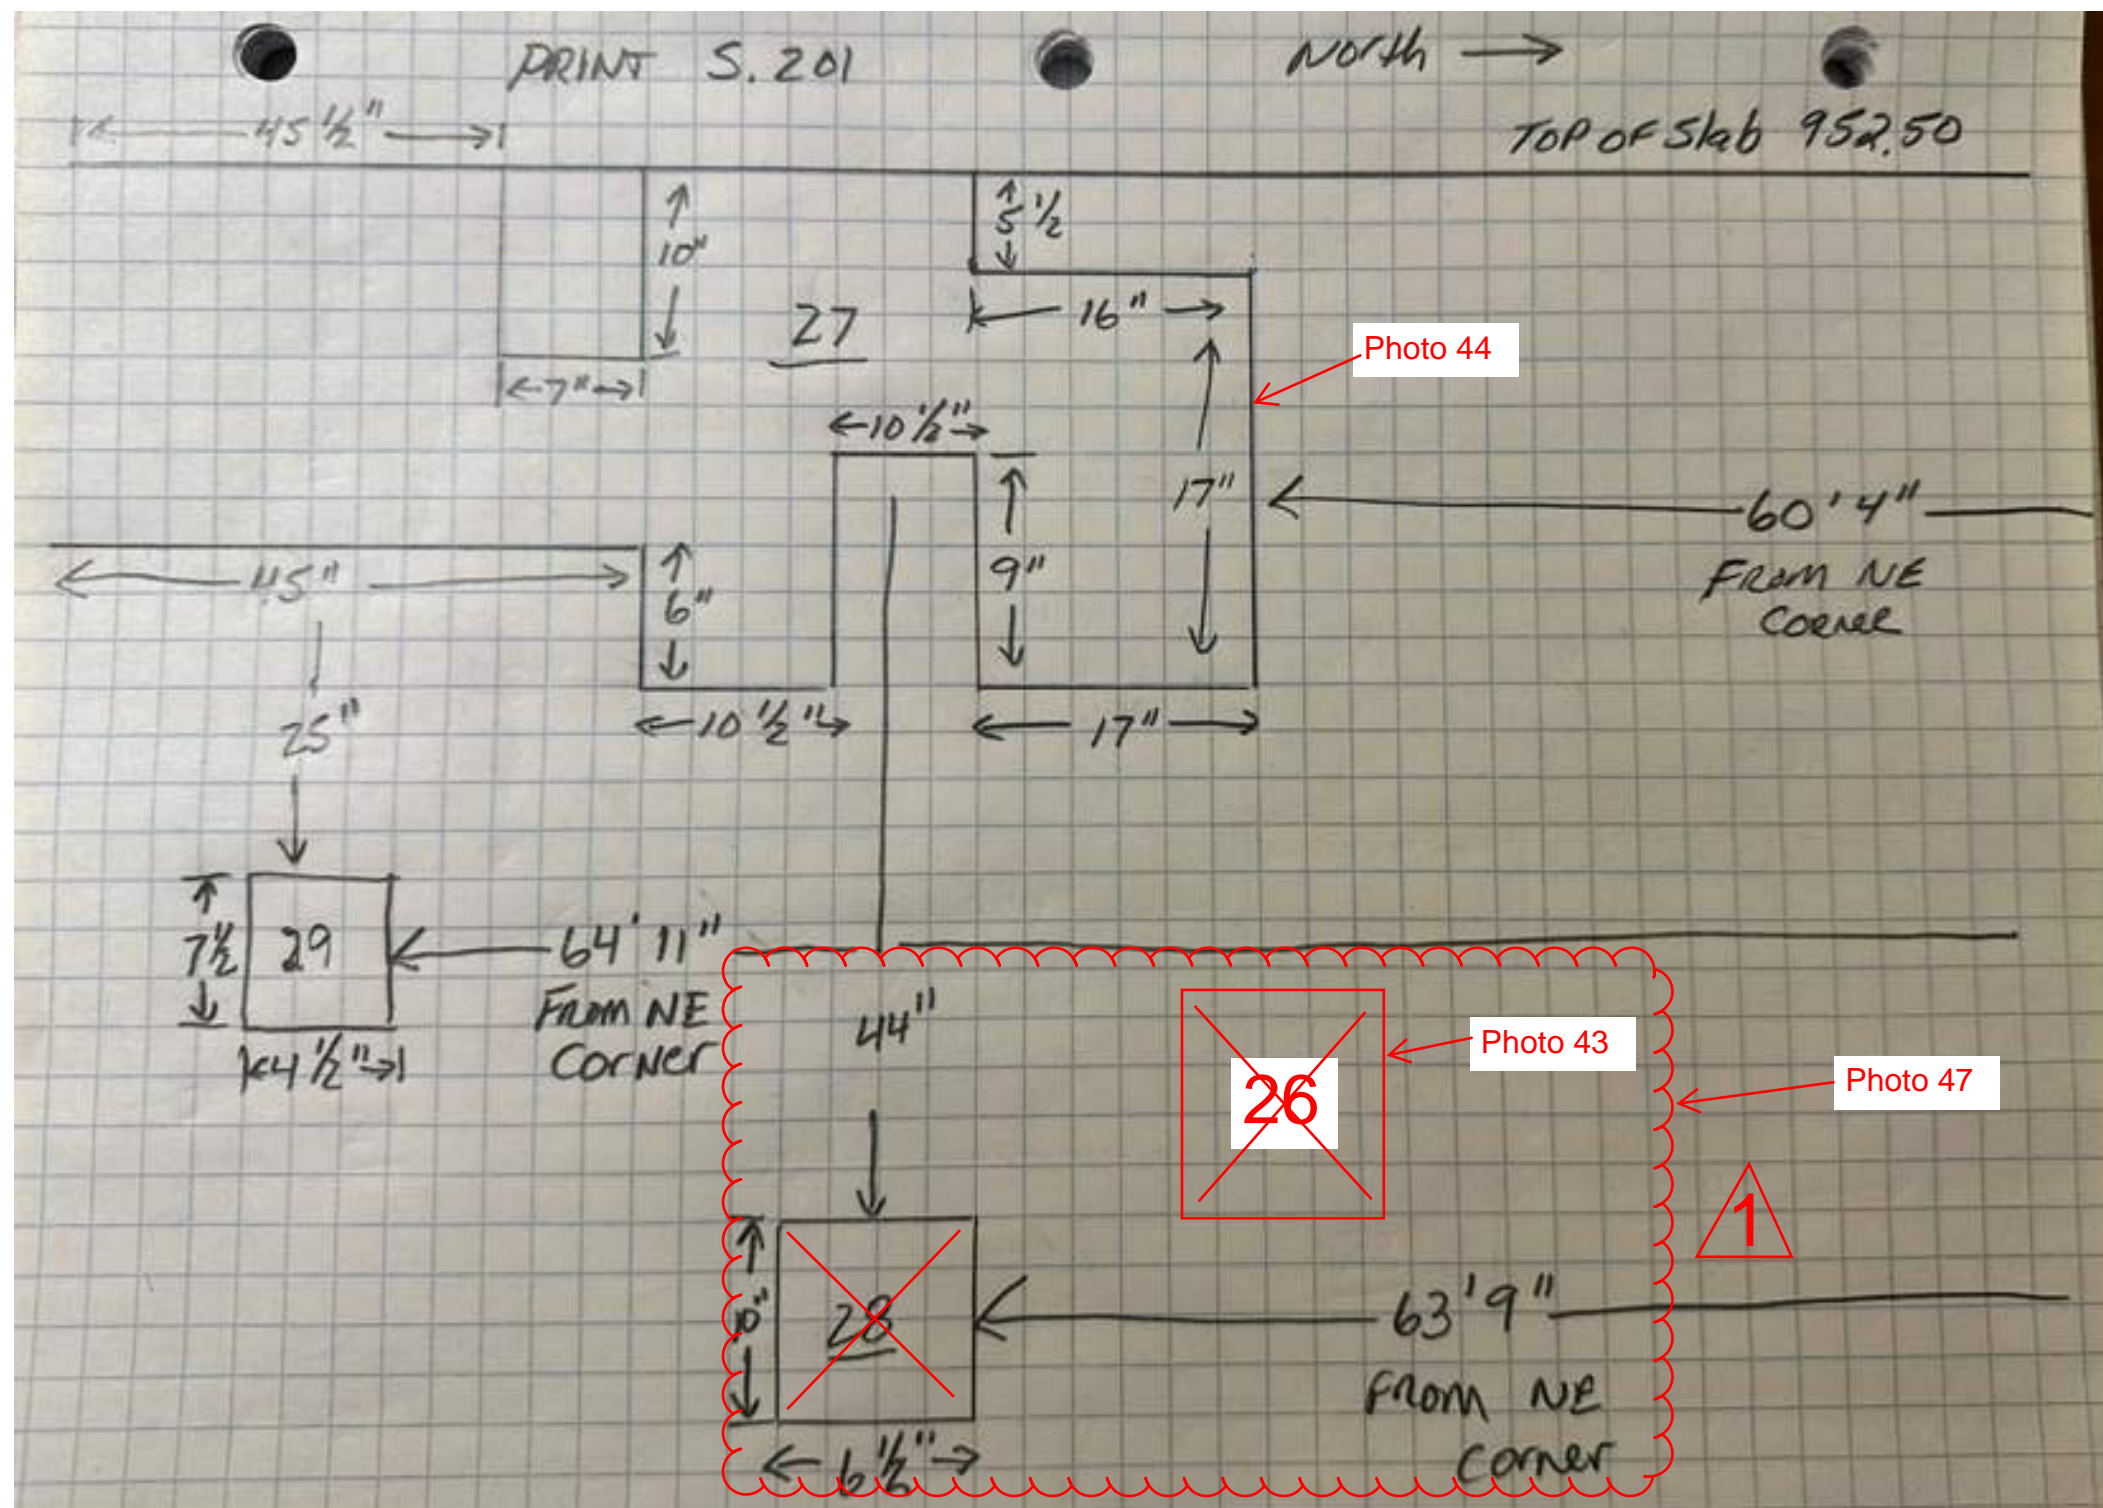

1 REVISION 1: REPAIRED EXISTING REPAIRS

LEGEND:

X DENOTES REMOVAL



Before Repair



After Repair



After Repair

PHOTO 1



Before Repair



After Repair

PHOTO 3



Before Repair



After Repair

PHOTO 4



Before Repair



Before Repair



Before Repair



Before Repair

PHOTO 6



After Repair

PHOTO 6



Before Repair



After Repair

PHOTO 7



Before Repair



After Repair

PHOTO 8



Before Repair



After Repair


PHOTO 9



Before Repair



Before Repair

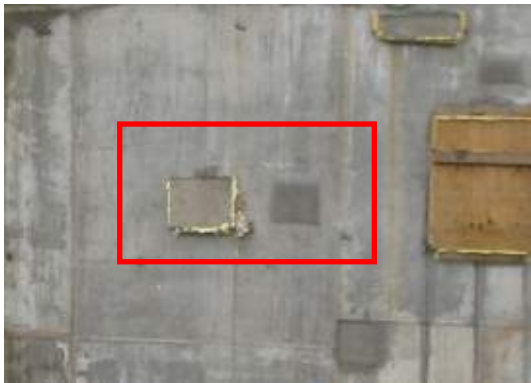

After Repair

PHOTO 10



Before Repair



After Repair

PHOTO 11



Before Repair




After Repair

PHOTO 12



Before Repair

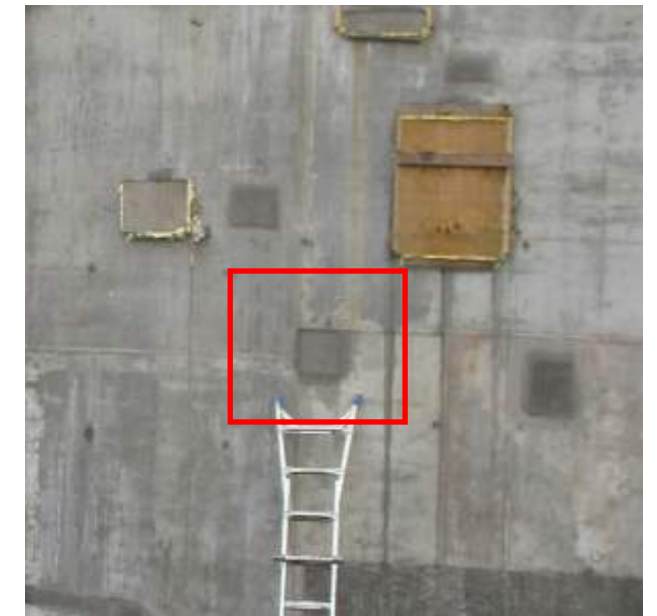

After Repair

PHOTO 13



Before Repair




After Repair

PHOTO 14



Before Repair

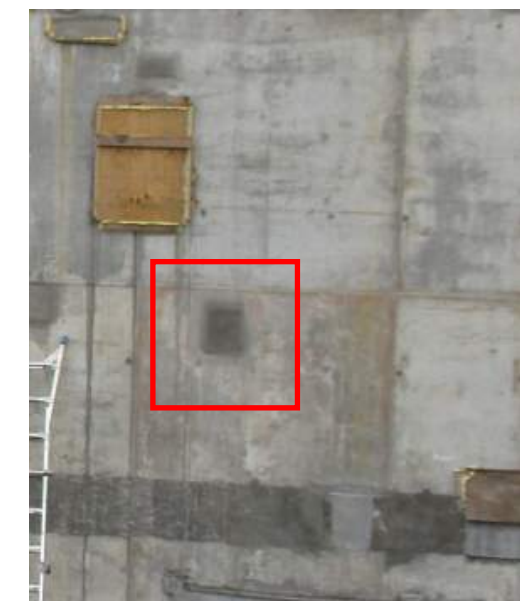

After Repair

PHOTO 15



Before Repair




After Repair

PHOTO 16



Before Repair

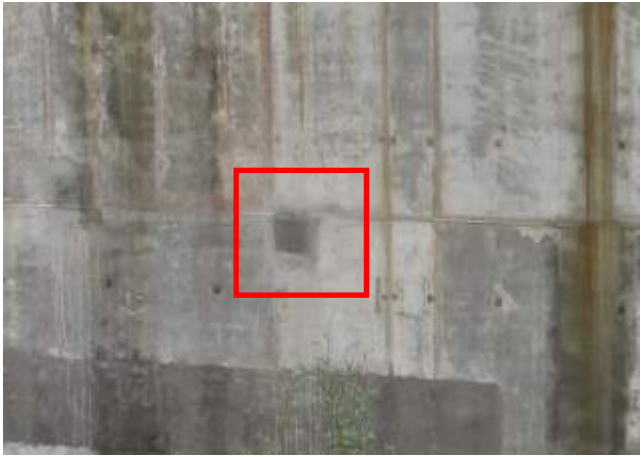

After Repair

PHOTO 17



Before Repair



After Repair

PHOTO 18



Before Repair



After Repair

PHOTO 19



Before Repair



Before Repair



After Repair

PHOTO 20



Before Repair



After Repair

PHOTO 21



Before Repair



After Repair

PHOTO 22



Before Repair



After Repair

PHOTO 23



Before Repair



After Repair

PHOTO 24



Before Repair



After Repair

PHOTO 25



Before Repair



After Repair

PHOTO 26



Before Repair



After Repair

PHOTO 27



Before Repair



After Repair

PHOTO 28



Before Repair



After Repair

PHOTO 29



Before Repair



After Repair

PHOTO 30



Before Repair



After Repair

PHOTO 31




Before Repair




After Repair

PHOTO 32

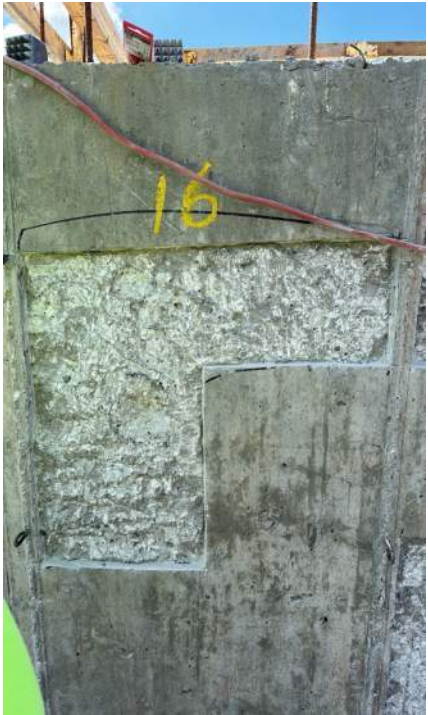

Before Repair

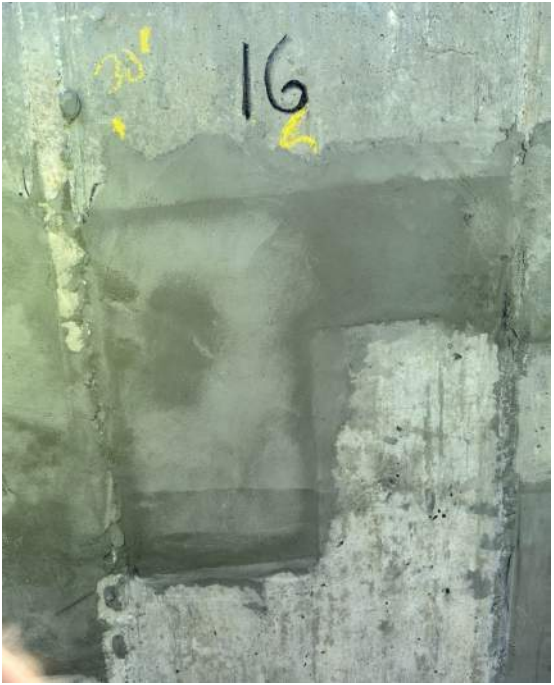

After Repair

PHOTO 33




Before Repair



Before Repair



Before Repair

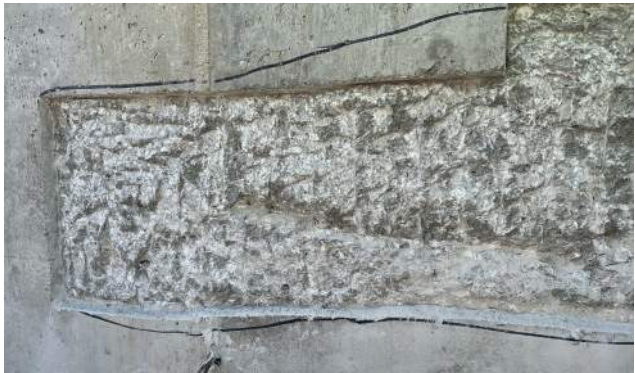

Before Repair



After Repair

PHOTO 34



Before Repair



After Repair

PHOTO 35



Before Repair



After Repair

PHOTO 36



Before Repair



After Repair

PHOTO 37



Before Repair



Before Repair



Before Repair



After Repair

PHOTO 38



Before Repair



After Repair

PHOTO 39



Before Repair



Before Repair



Before Repair



After Repair

PHOTO 40



Before Repair



After Repair

PHOTO 41



Before Repair



After Repair

PHOTO 42



Before Repair



After Repair

PHOTO 43



Before Repair



Before Repair



Before Repair



After Repair

PHOTO 44



Before Repair



Before Repair



Before Repair



After Repair

PHOTO 45



After Repair



After Repair



After Repair

PHOTO 45





Before Repair



After Repair

PHOTO 46




Before Repair




After Repair

PHOTO 47

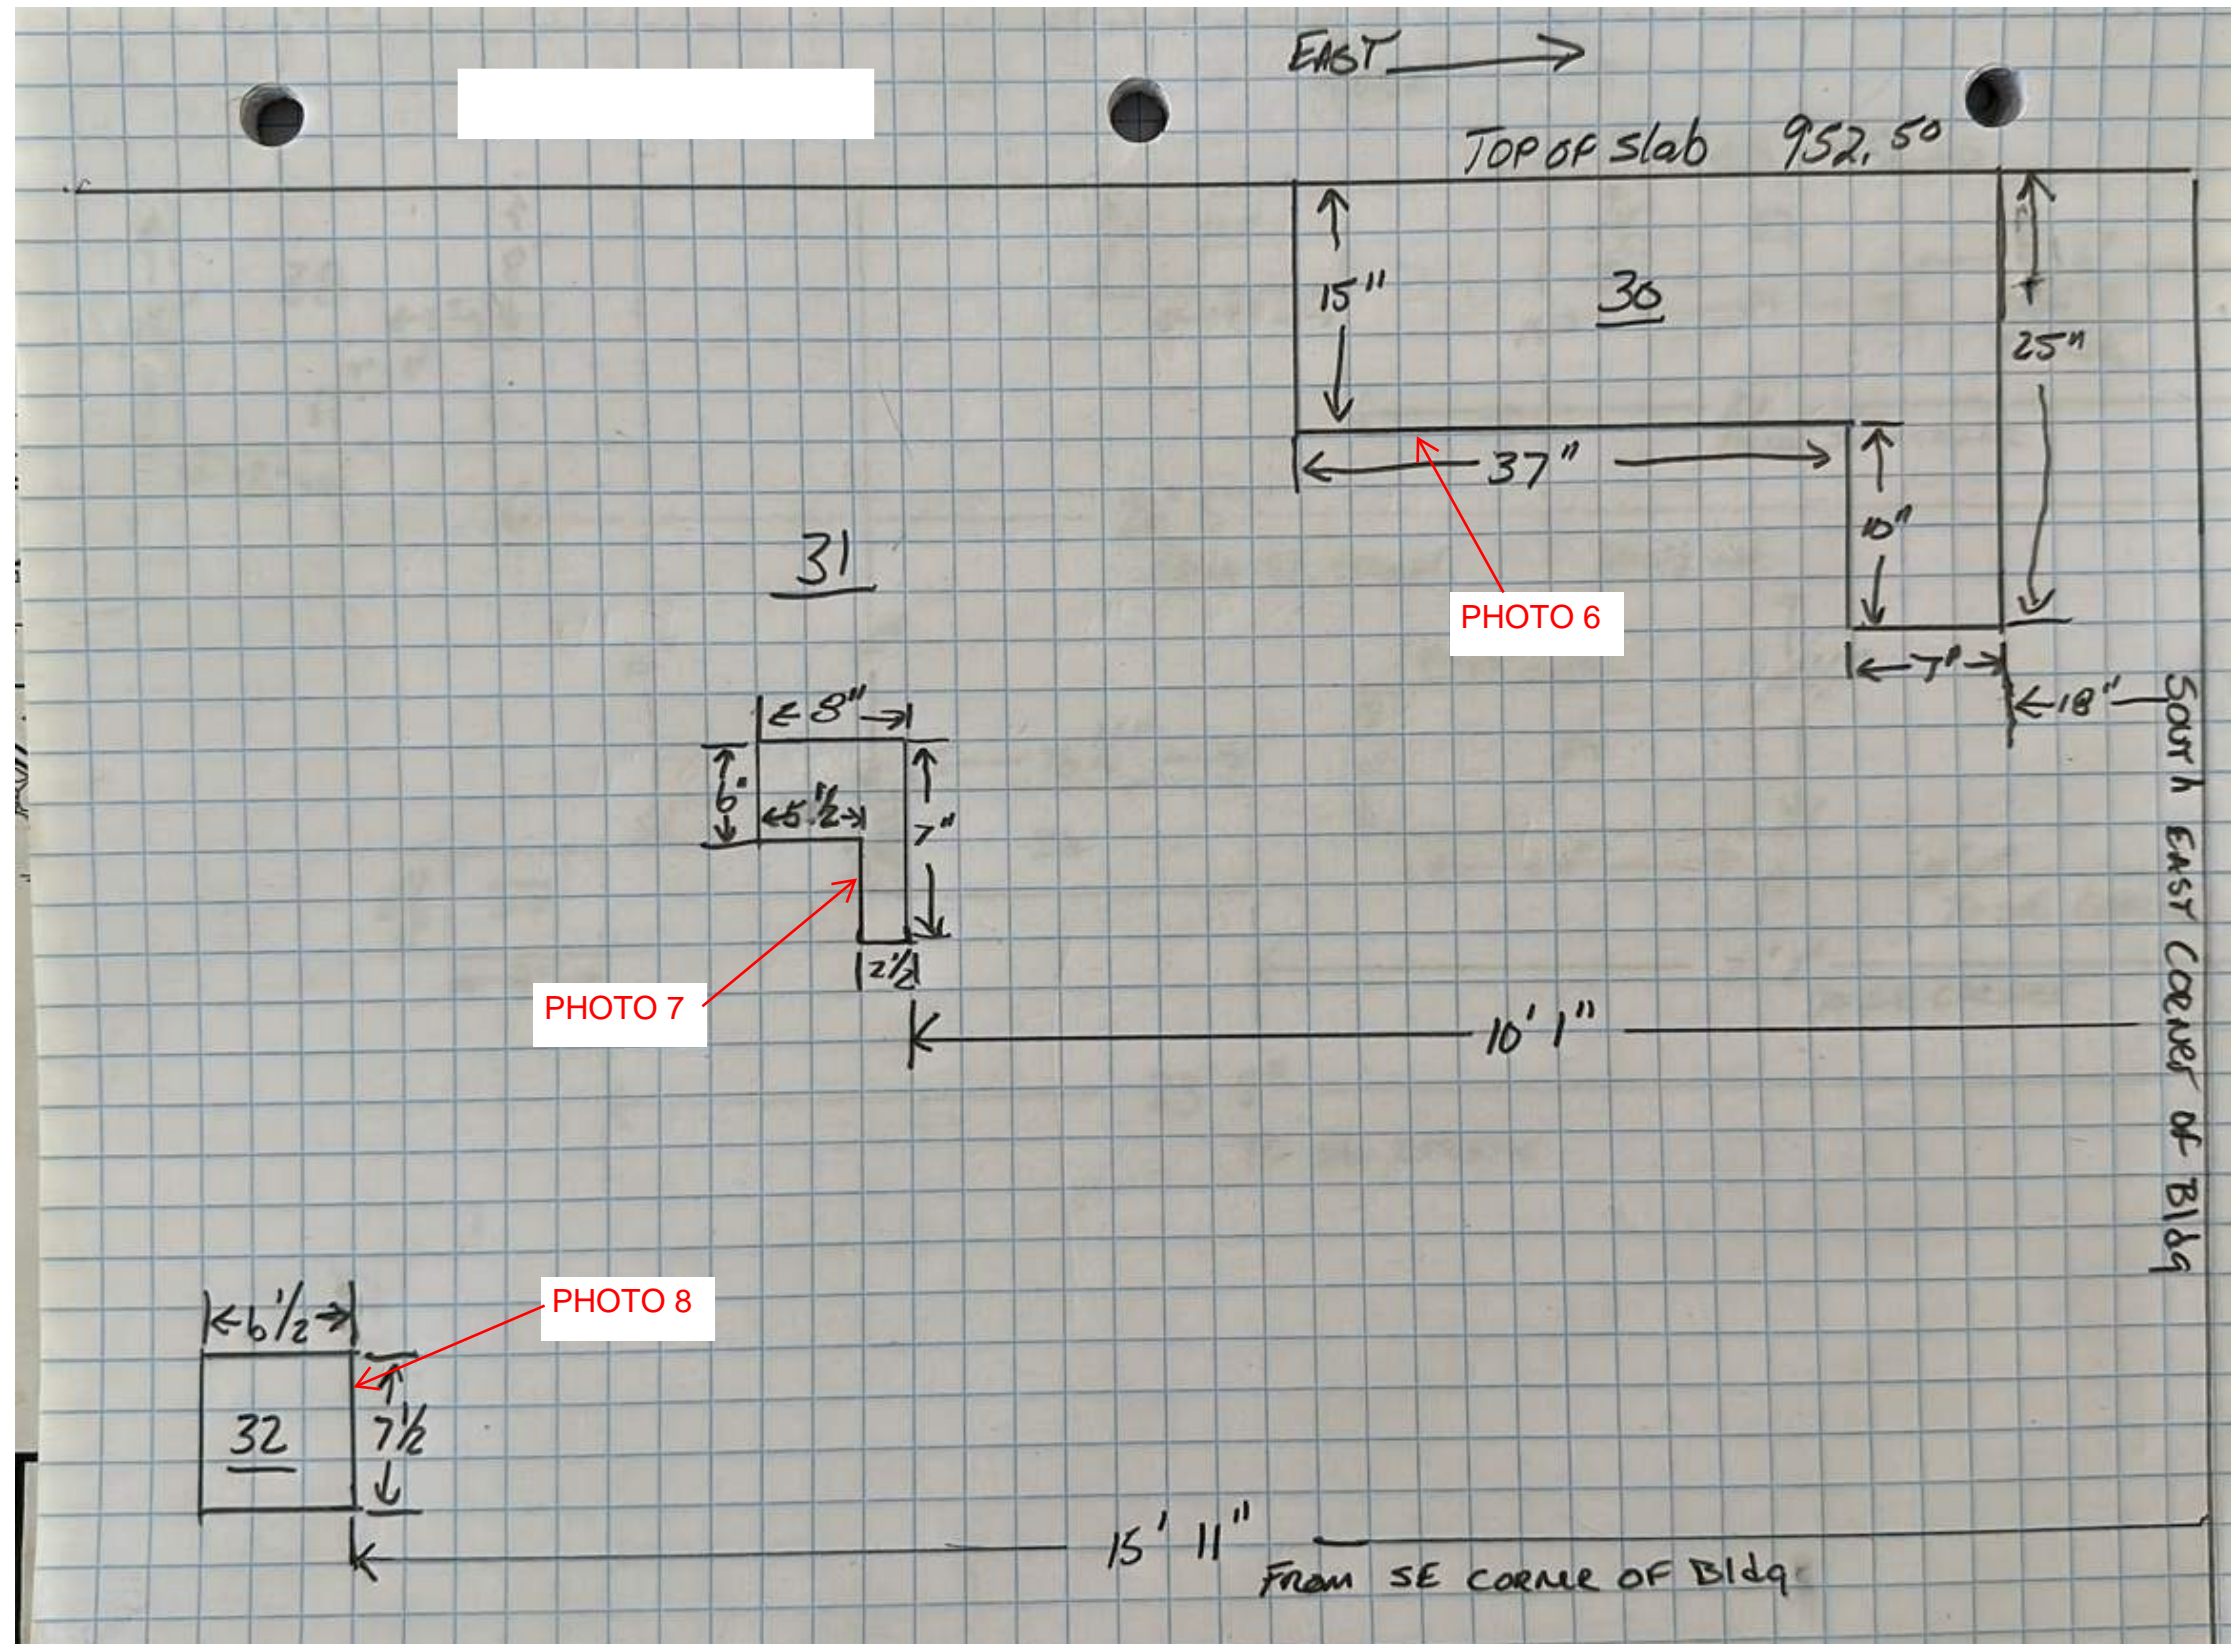


ORIGINAL REPAIRS

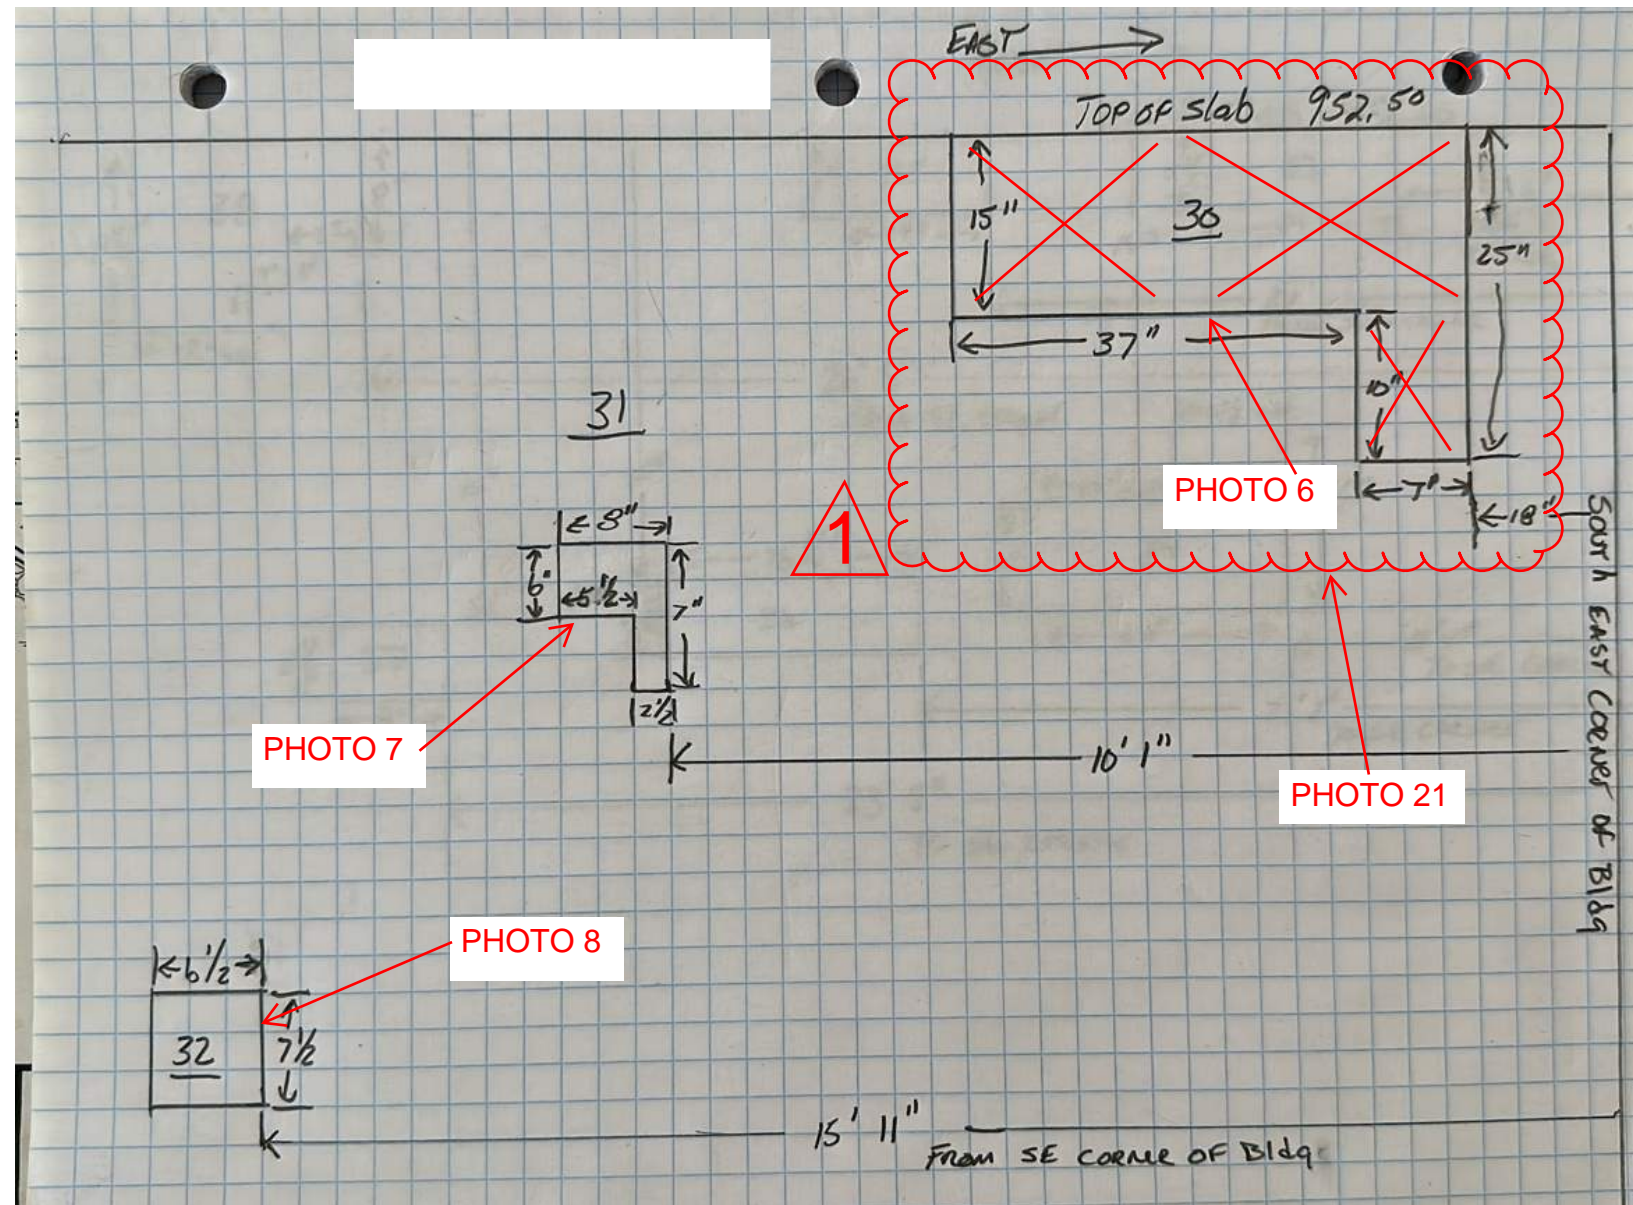


1 REVISION 1: REPAIRED EXISTING REPAIRS

LEGEND:

X DENOTES REMOVAL

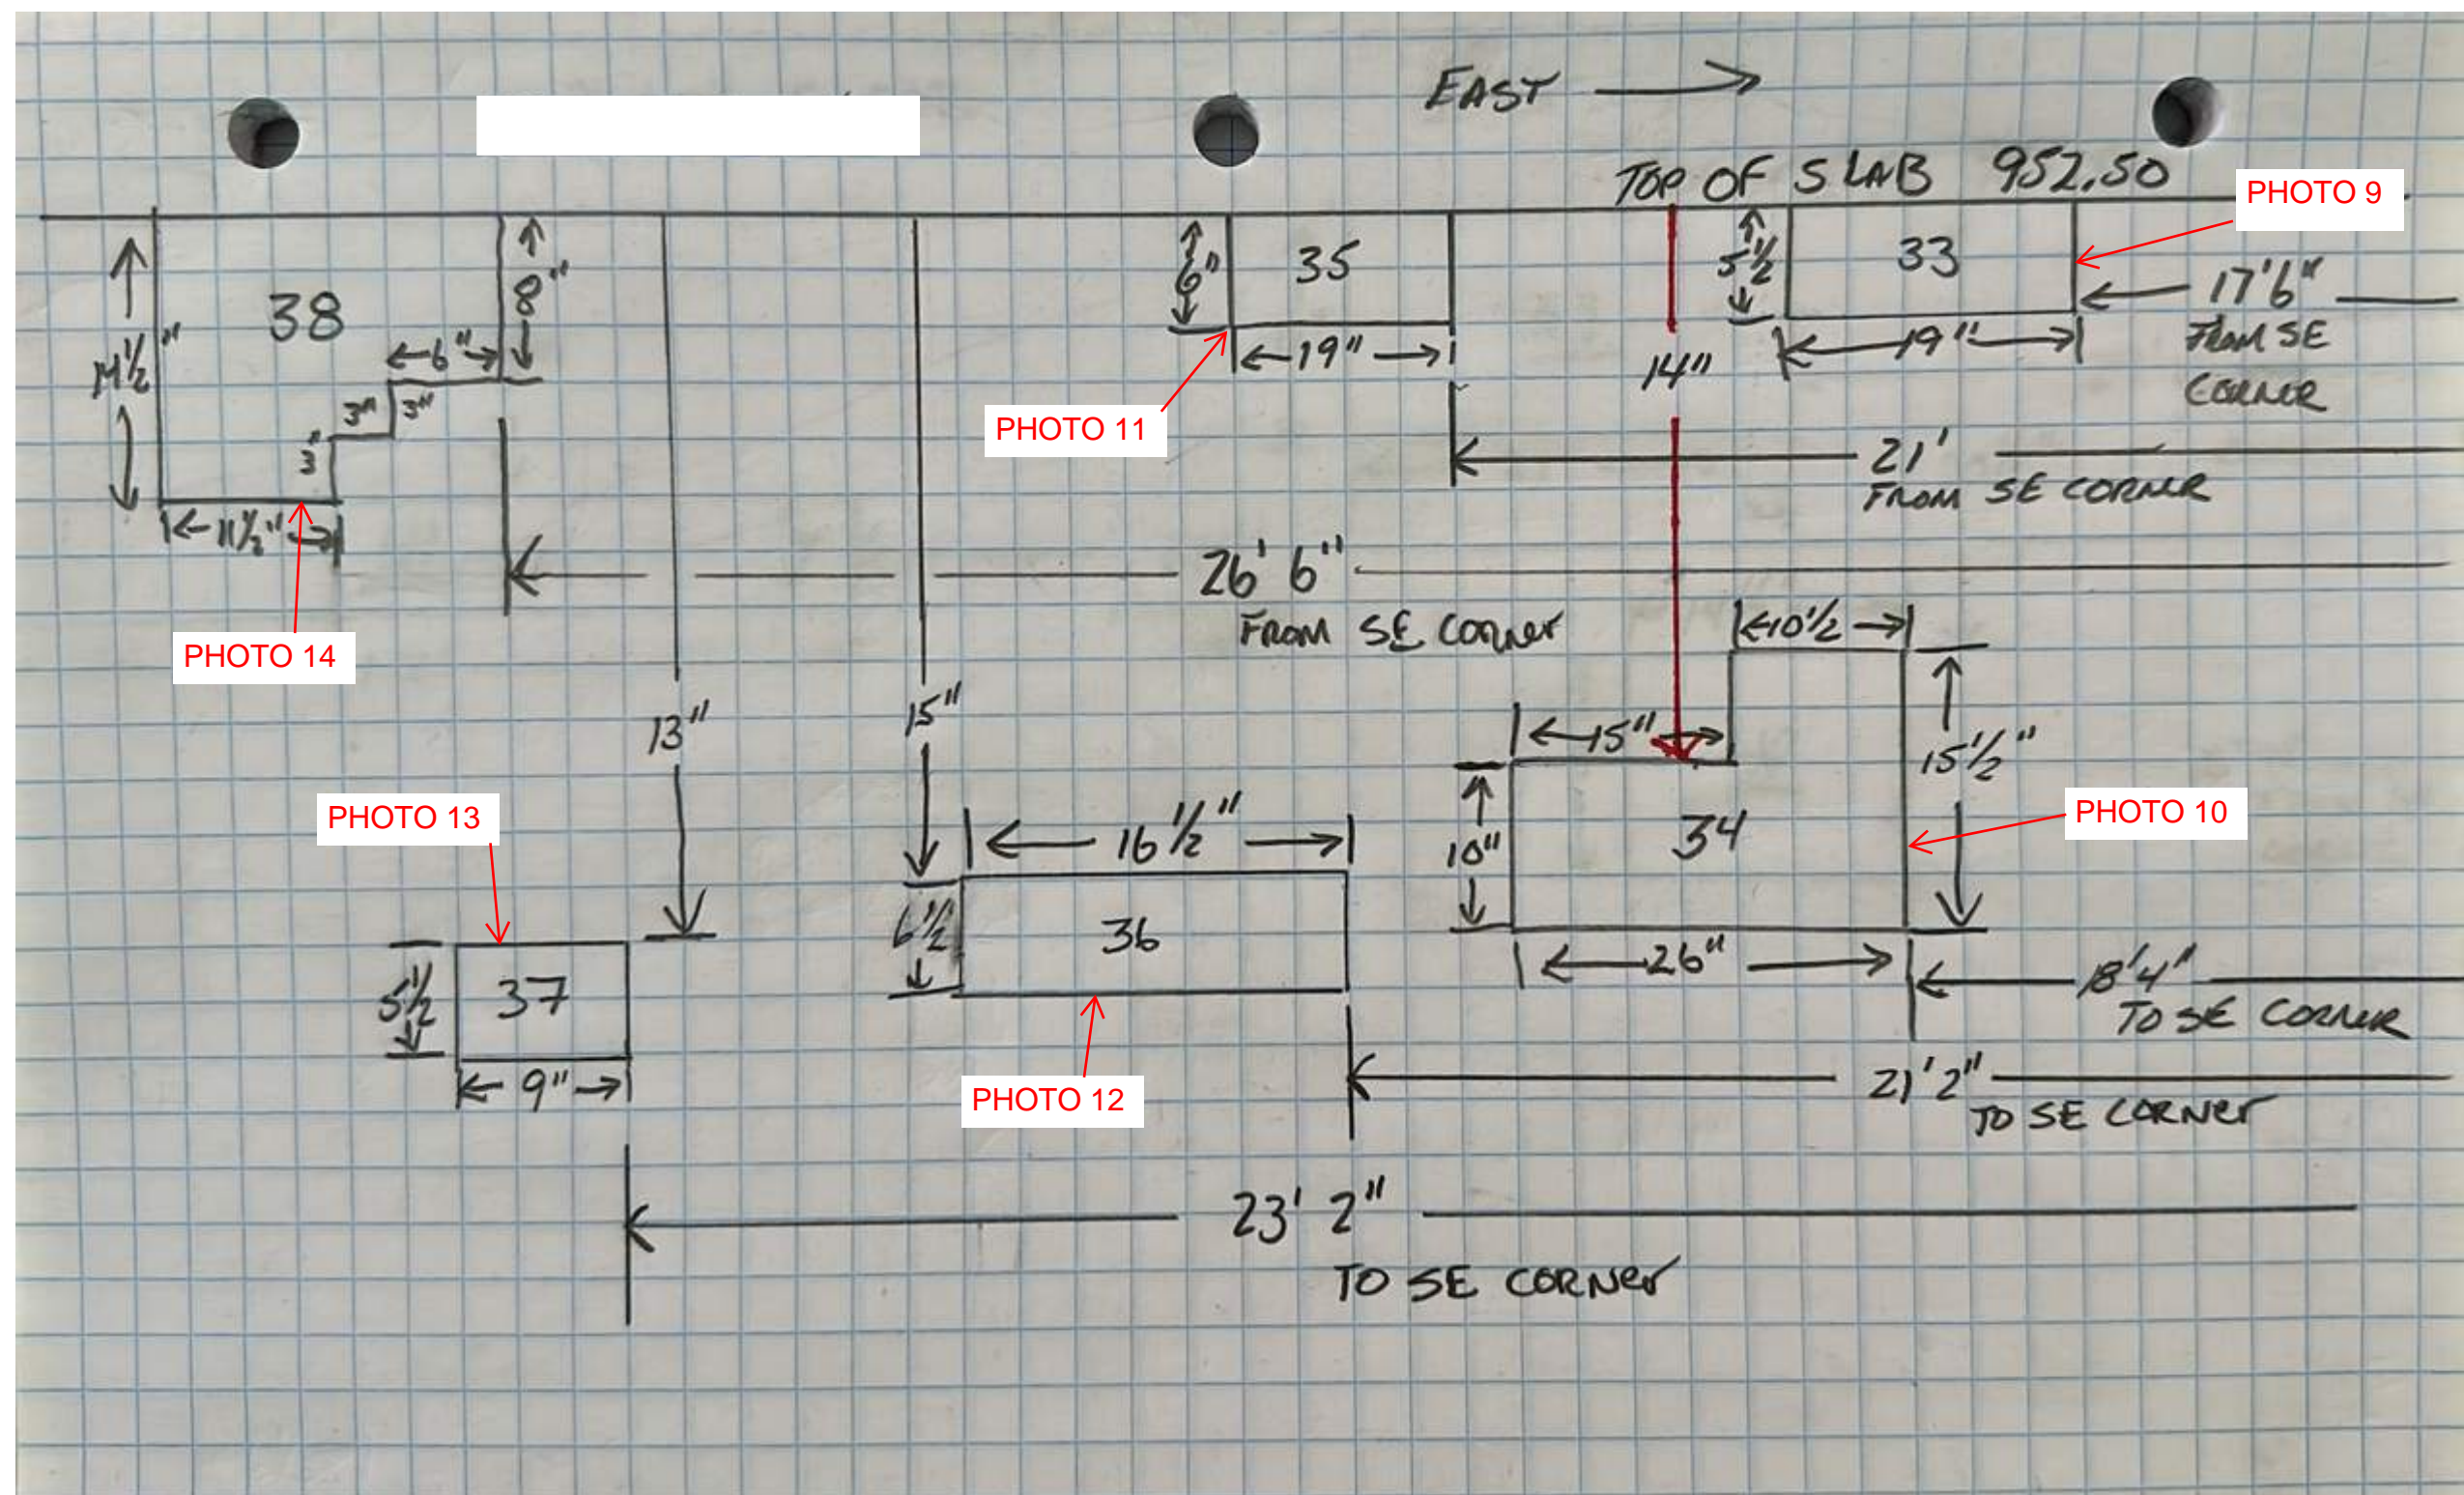


ORIGINAL REPAIRS

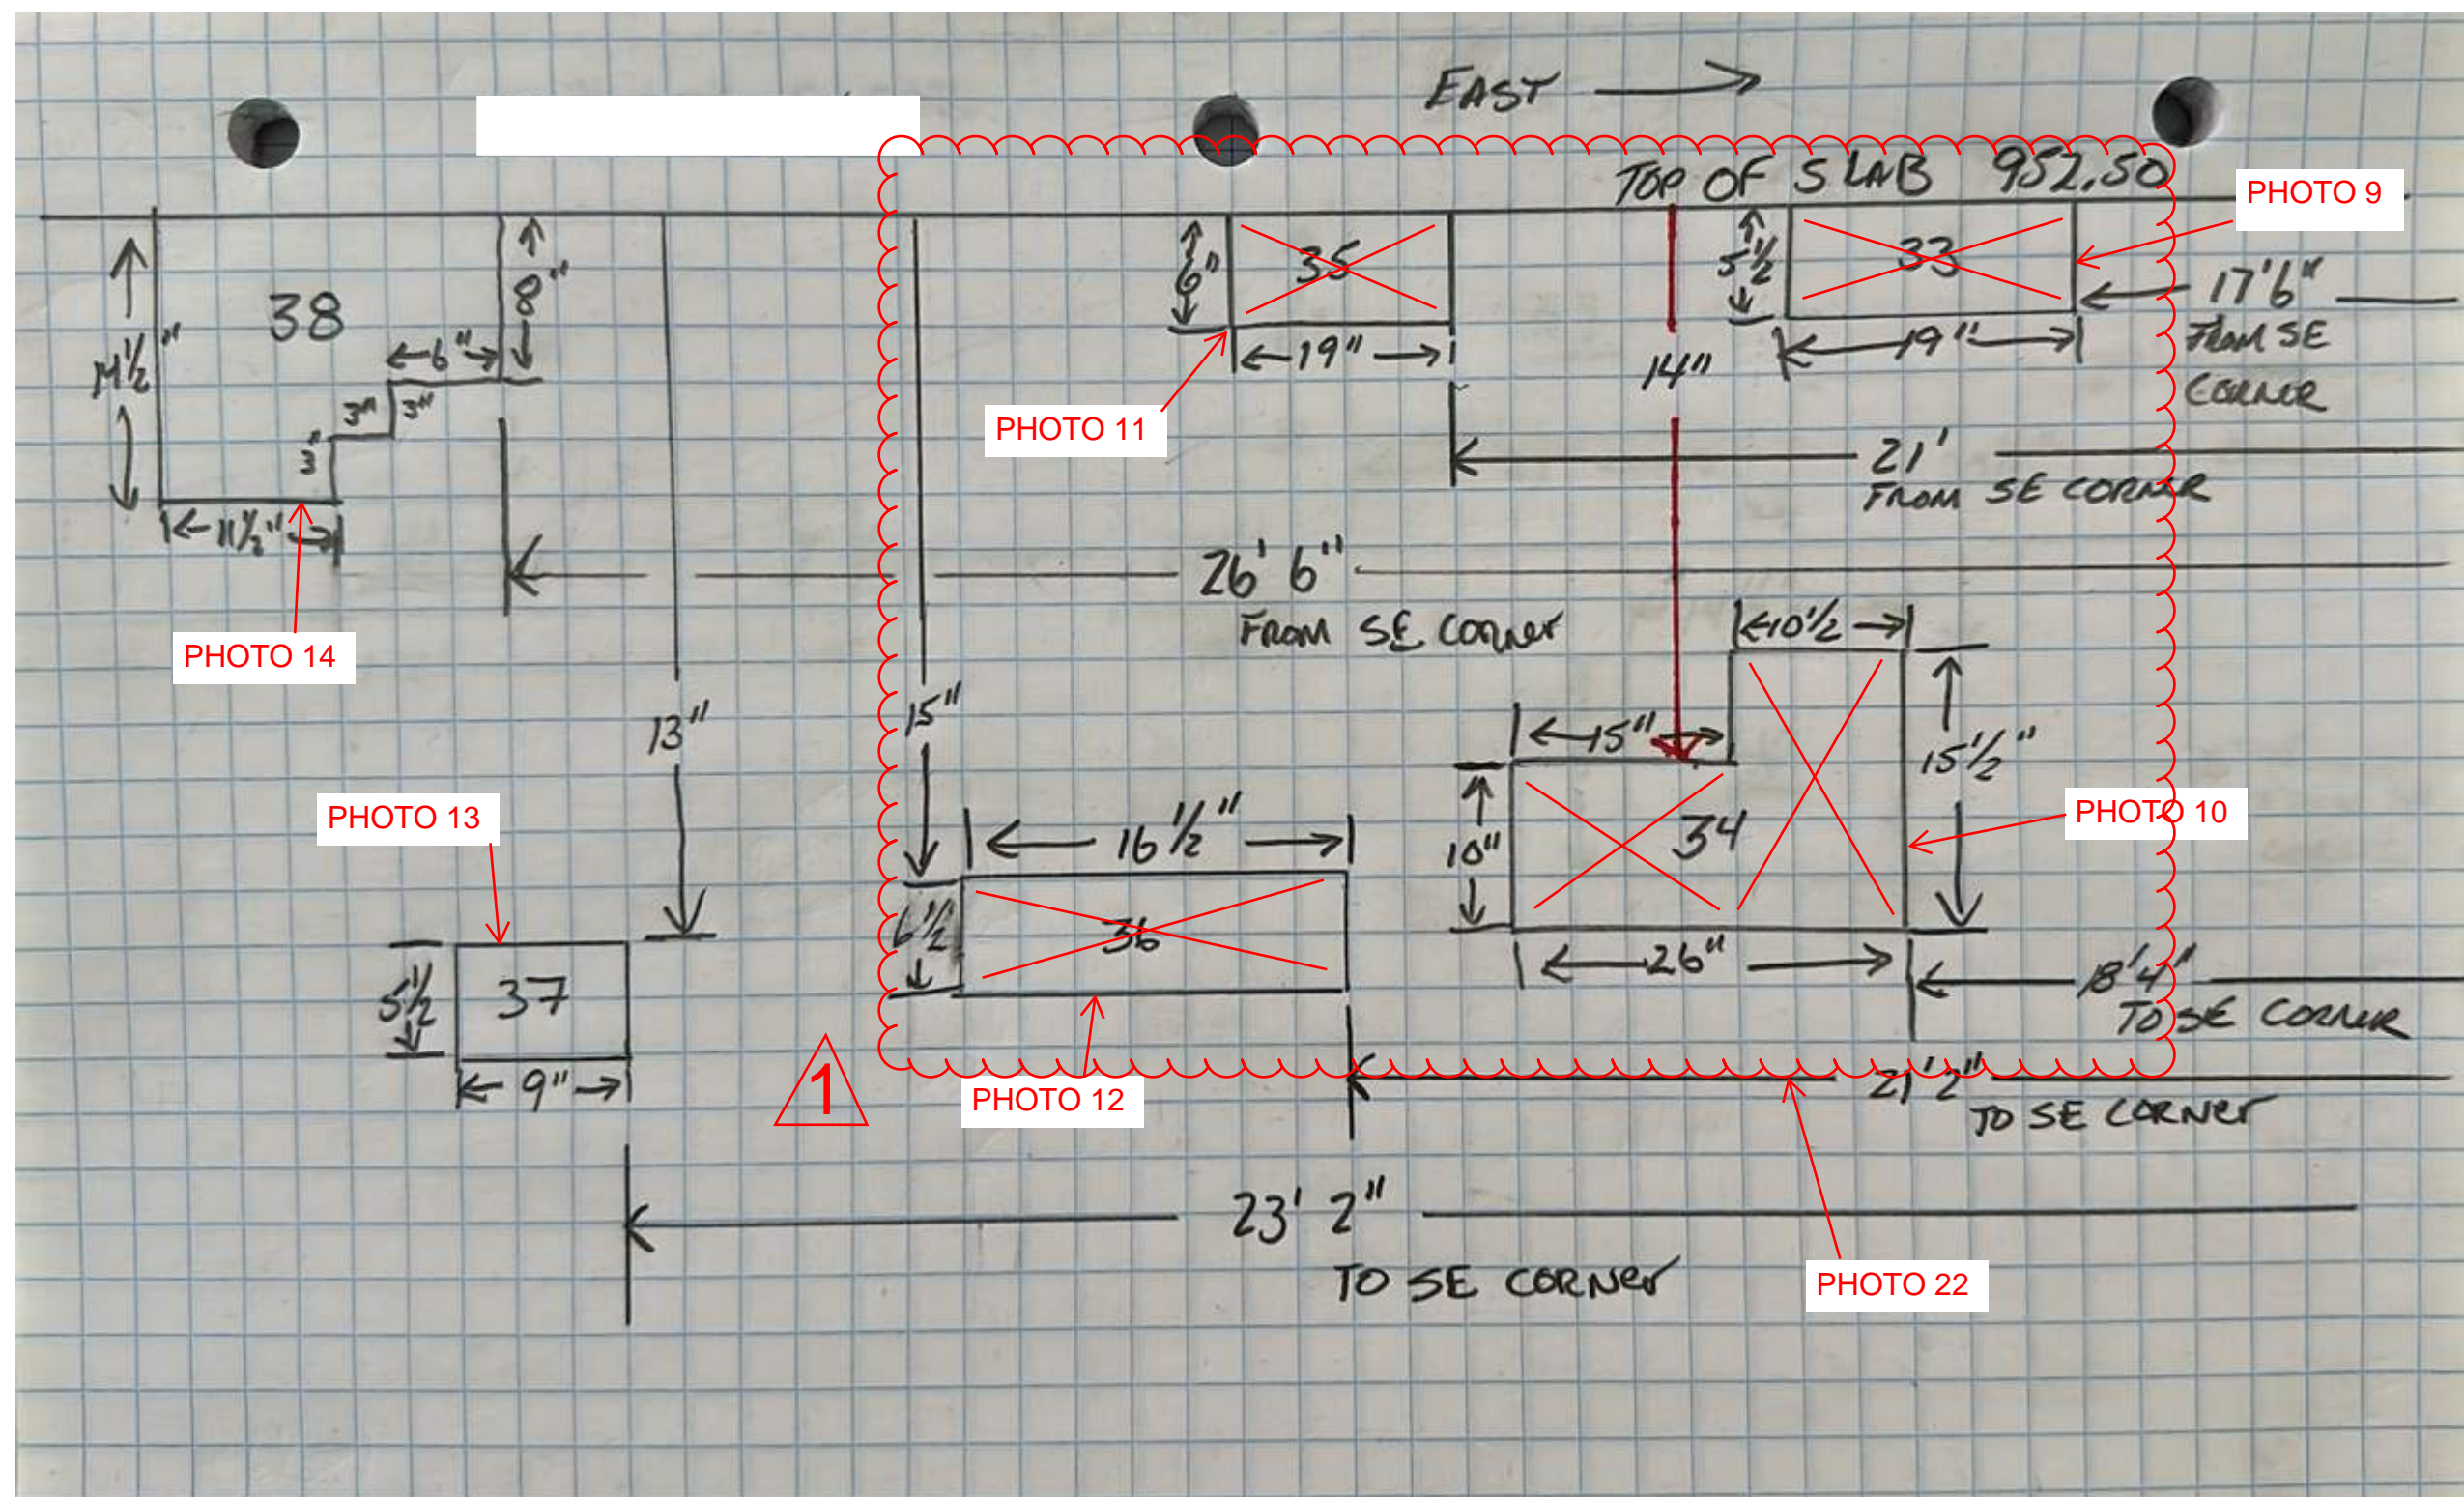


1 REVISION 1: REPAIRED EXISTING REPAIRS

LEGEND:

X DENOTES REMOVAL S2.05

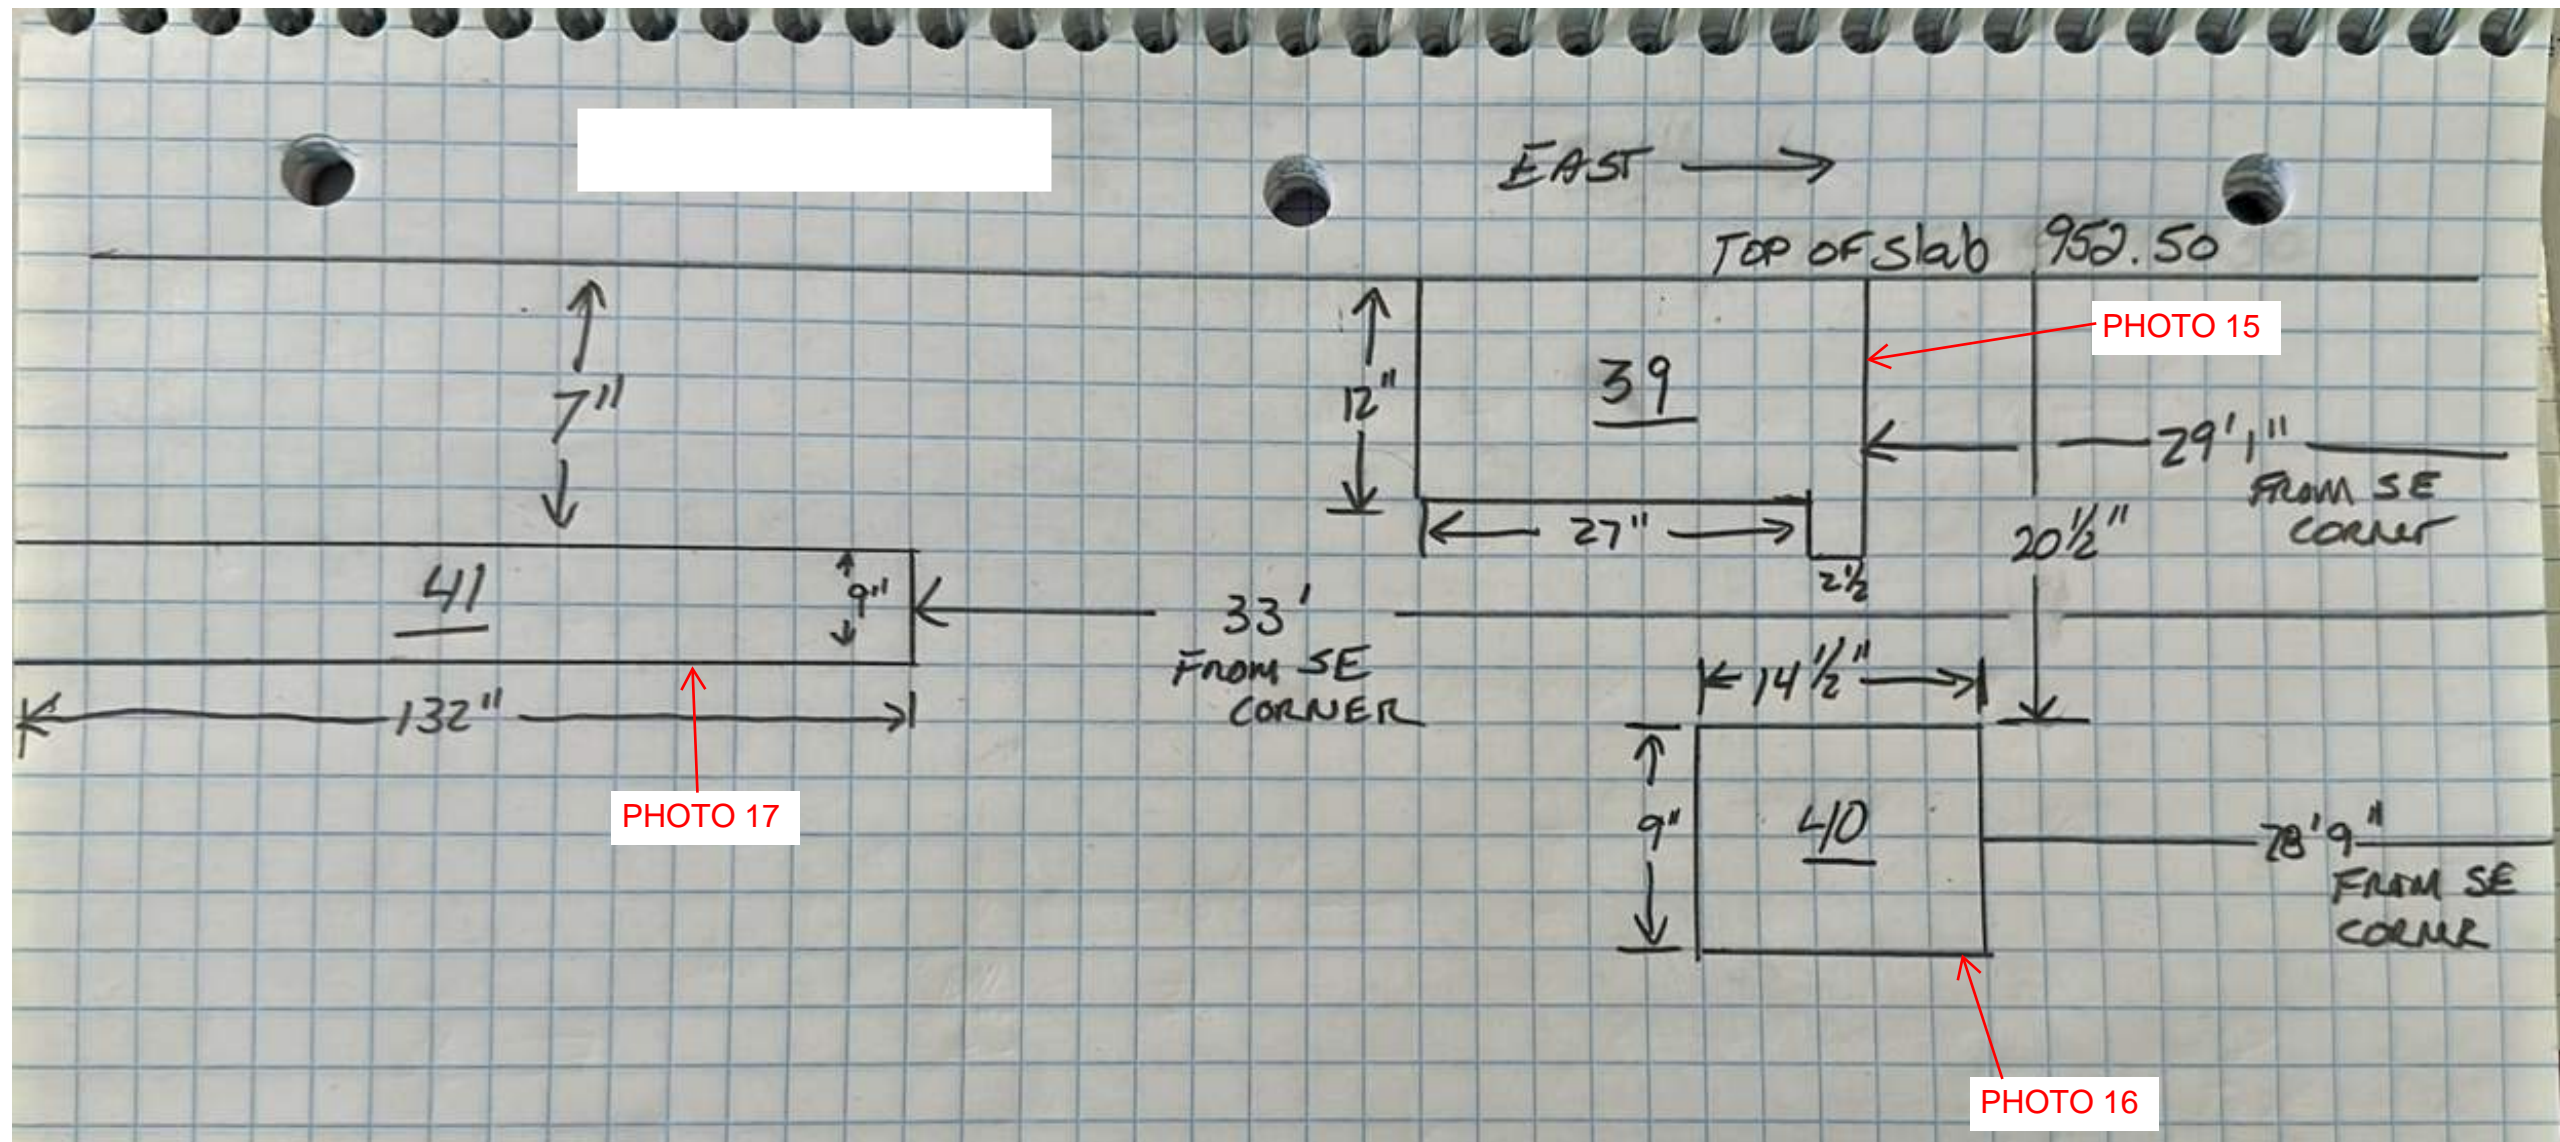

ORIGINAL REPAIRS

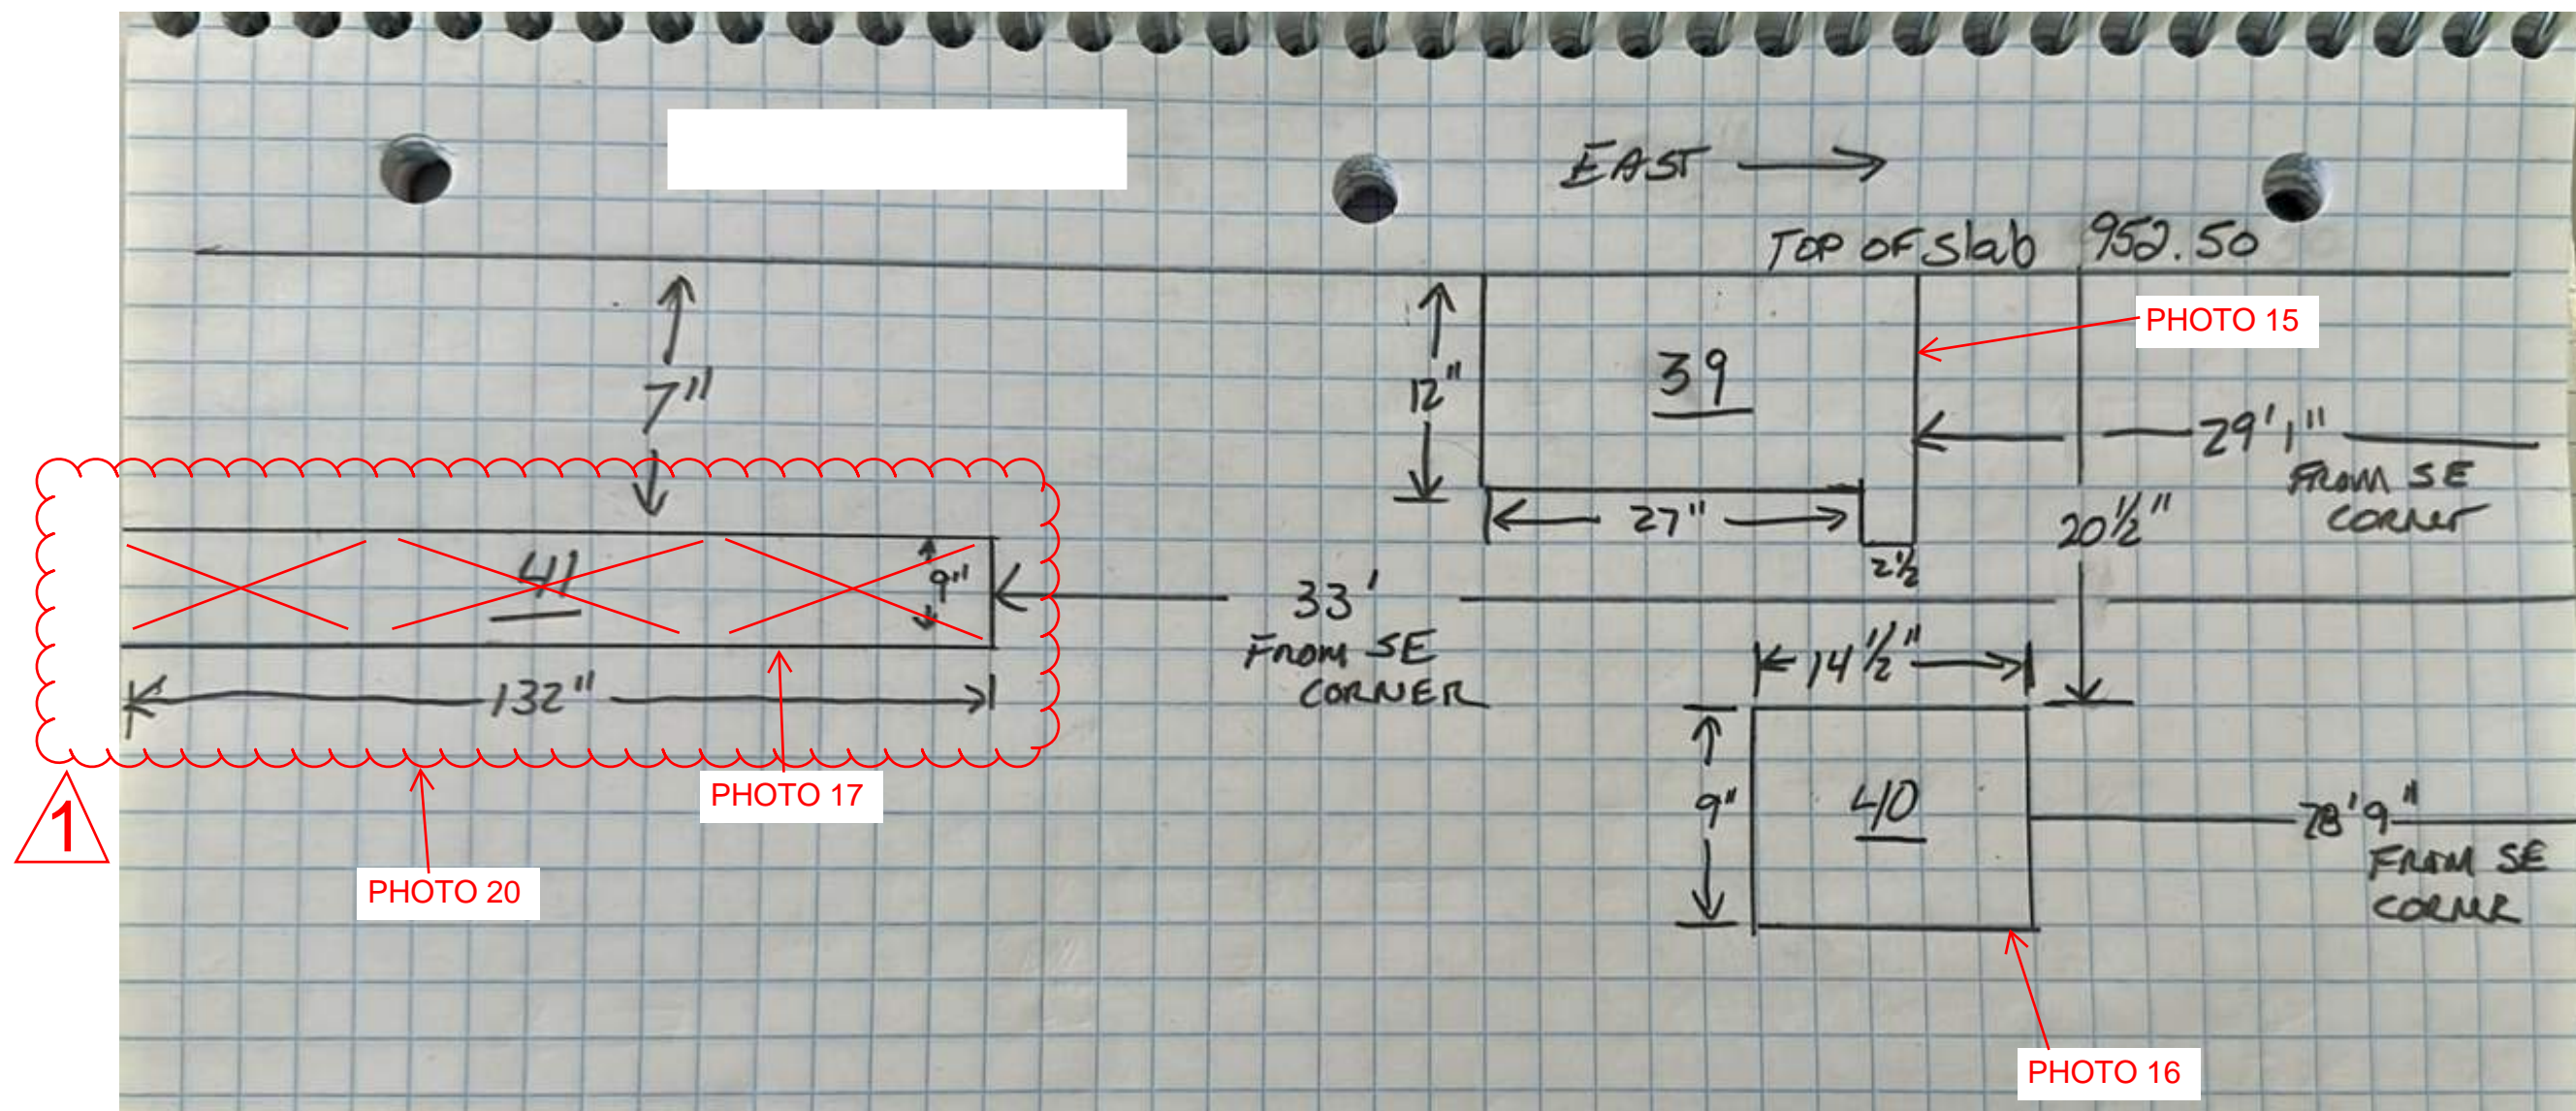

1 REVISION 1: REPAIRED EXISTING REPAIRS

LEGEND:

X DENOTES REMOVAL



Before Repair



Before Repair



After Repair

PHOTO 1



Before Repair



After Repair

PHOTO 2



Before Repair



After Repair

PHOTO 3



Before Repair



After Repair

PHOTO 4



Before Repair



After Repair



After Repair

PHOTO 5



Before Repair



After Repair

PHOTO 6



Before Repair



After Repair

PHOTO 7



Before Repair



After Repair

PHOTO 8



Before Repair



After Repair

PHOTO 9



Before Repair



After Repair

PHOTO 10



Before Repair



After Repair

PHOTO 11



Before Repair



After Repair

PHOTO 12



Before Repair



After Repair

PHOTO 13



Before Repair



After Repair

PHOTO 14




Before Repair



After Repair

PHOTO 15

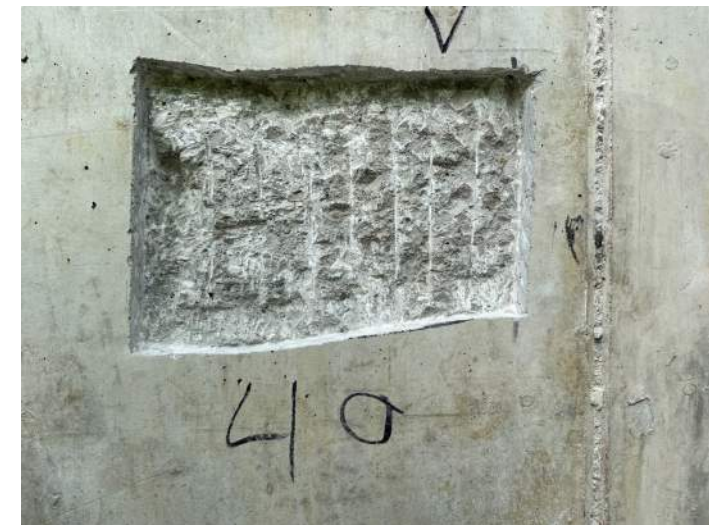

Before Repair



After Repair

PHOTO 16



Before Repair



Before Repair



After Repair

PHOTO 17



Before Repair



After Repair

PHOTO 18



Before Repair



After Repair

PHOTO 20



Before Repair



After Repair

PHOTO 19



Before Repair



After Repair

PHOTO 21



Before Repair



After Repair



PHOTO 22

1

3/24/2023 5:11:53 PM

C:\Users\chris\Documents\123.0172.03_STRUC_R220_chris\16BDR.vst

1 INTERIOR ELEVATION
3/8" = 1'-0"

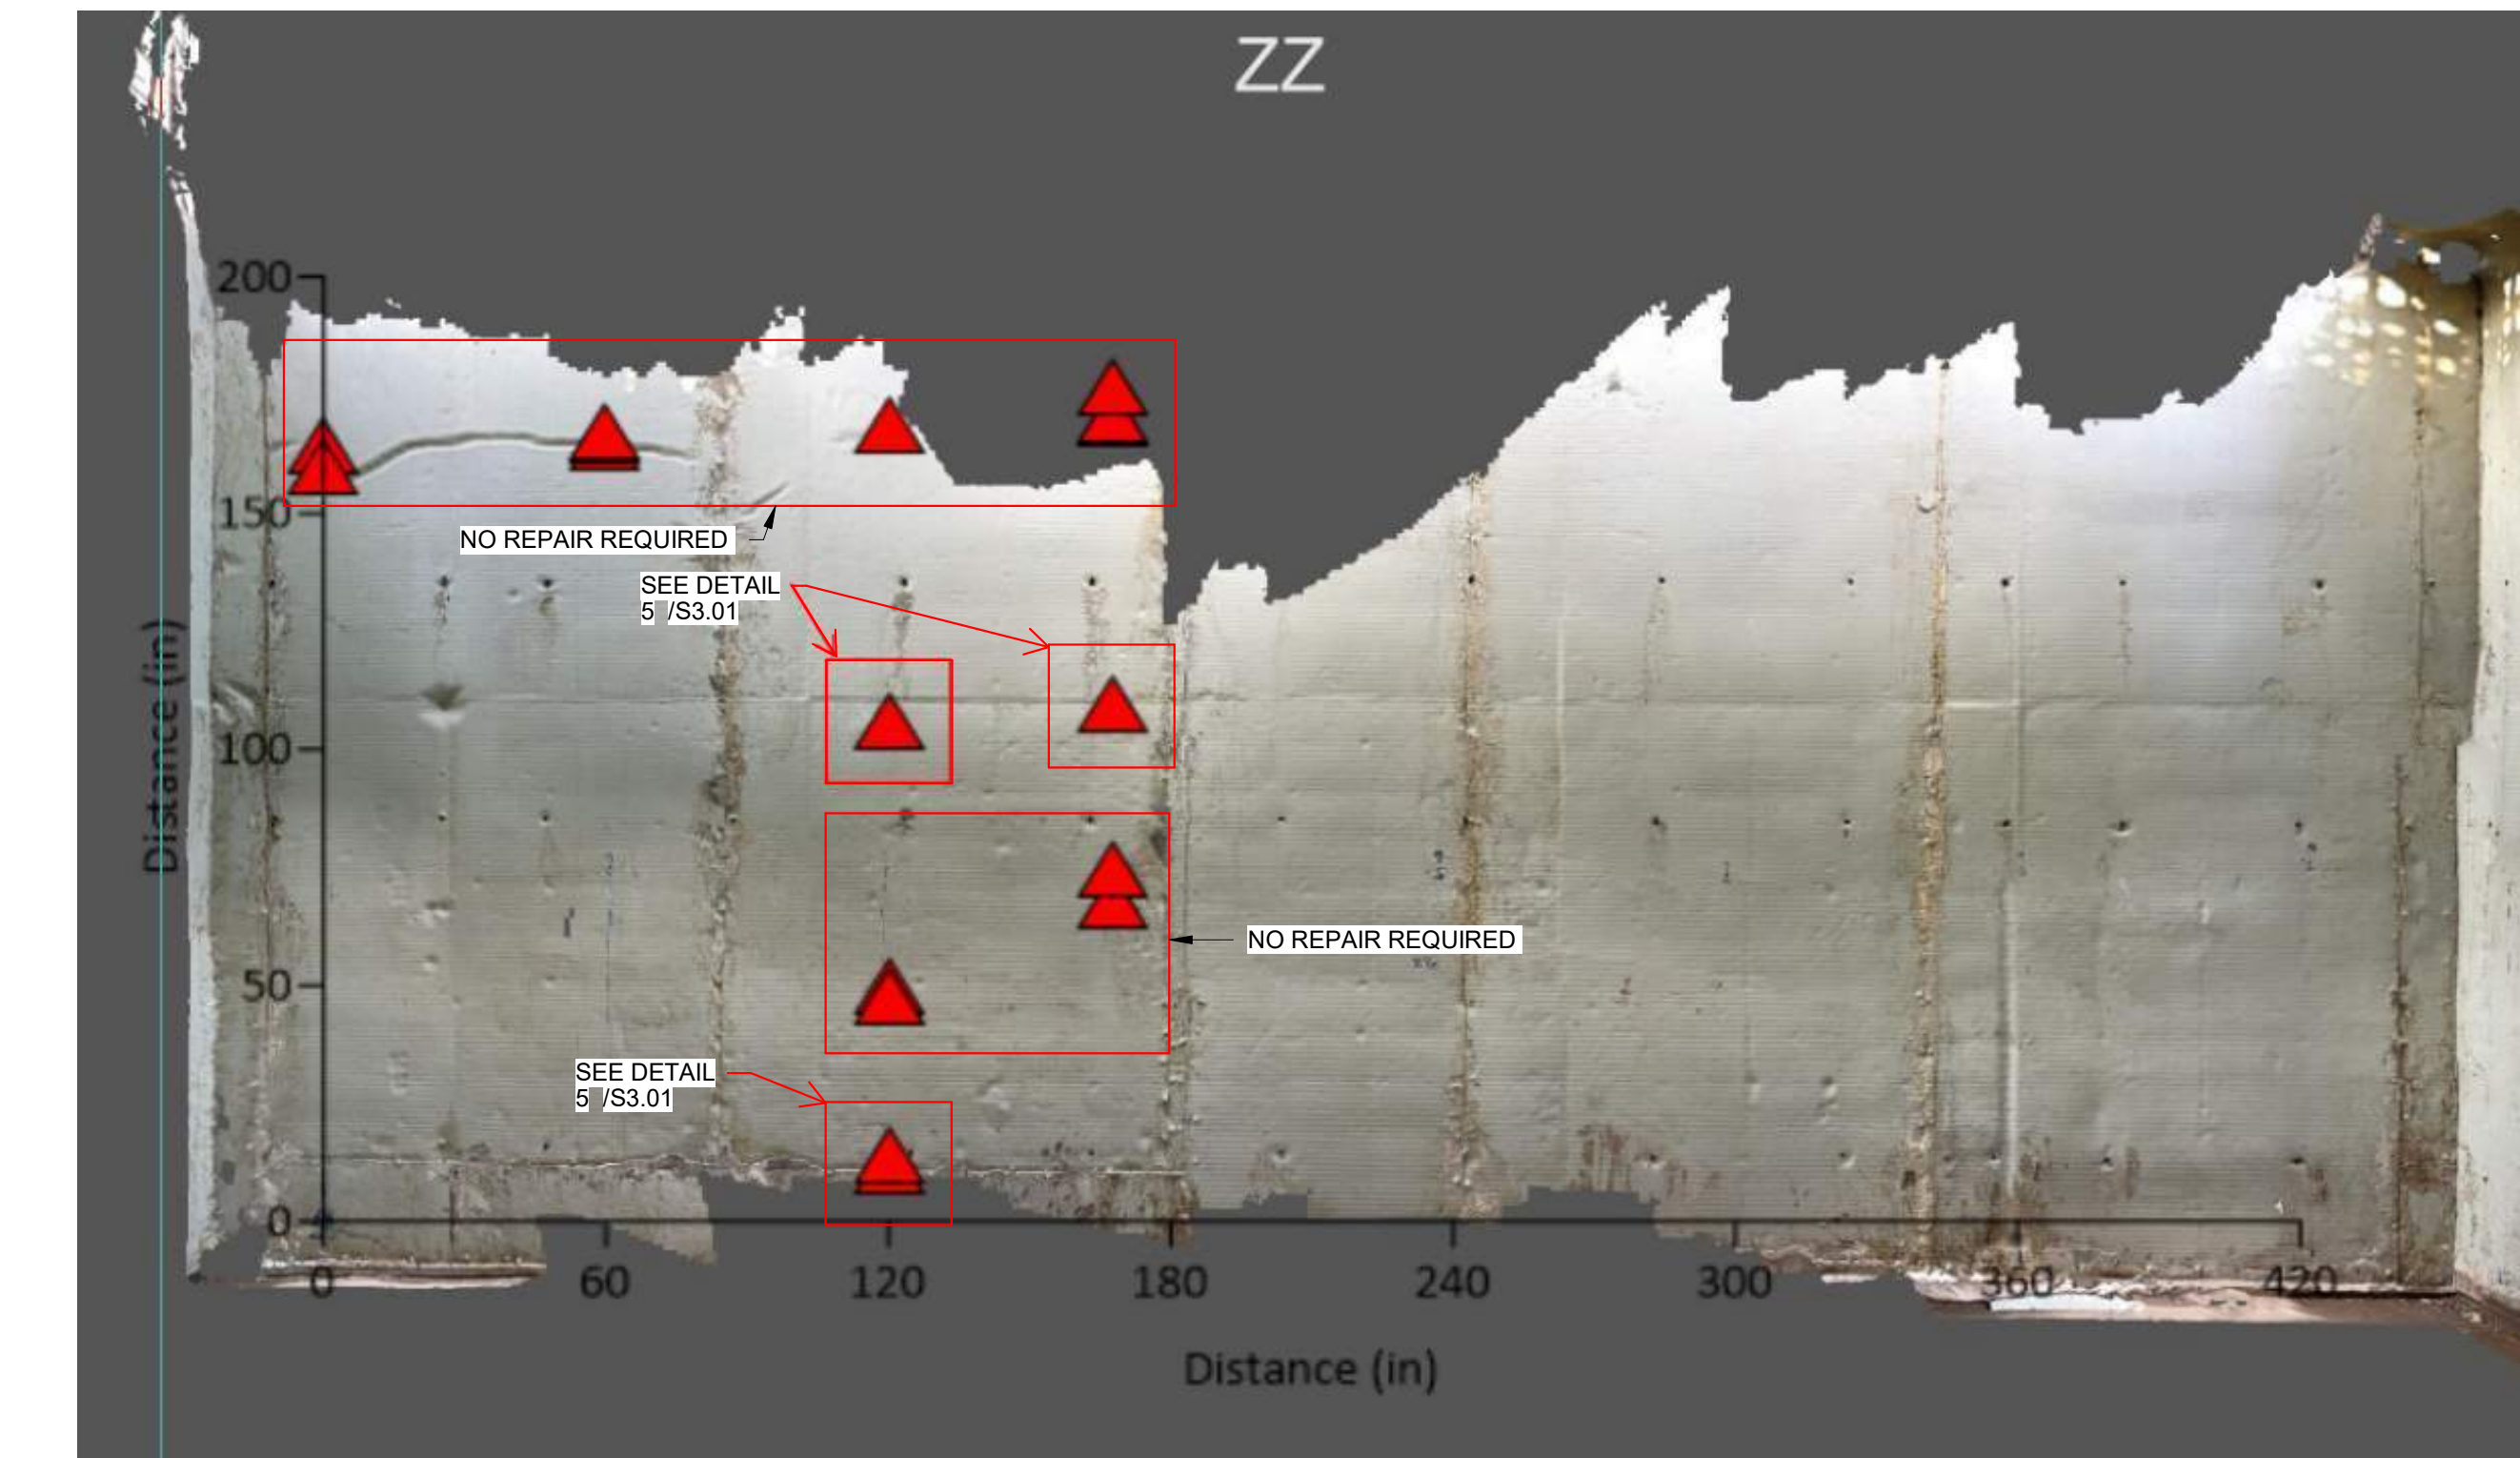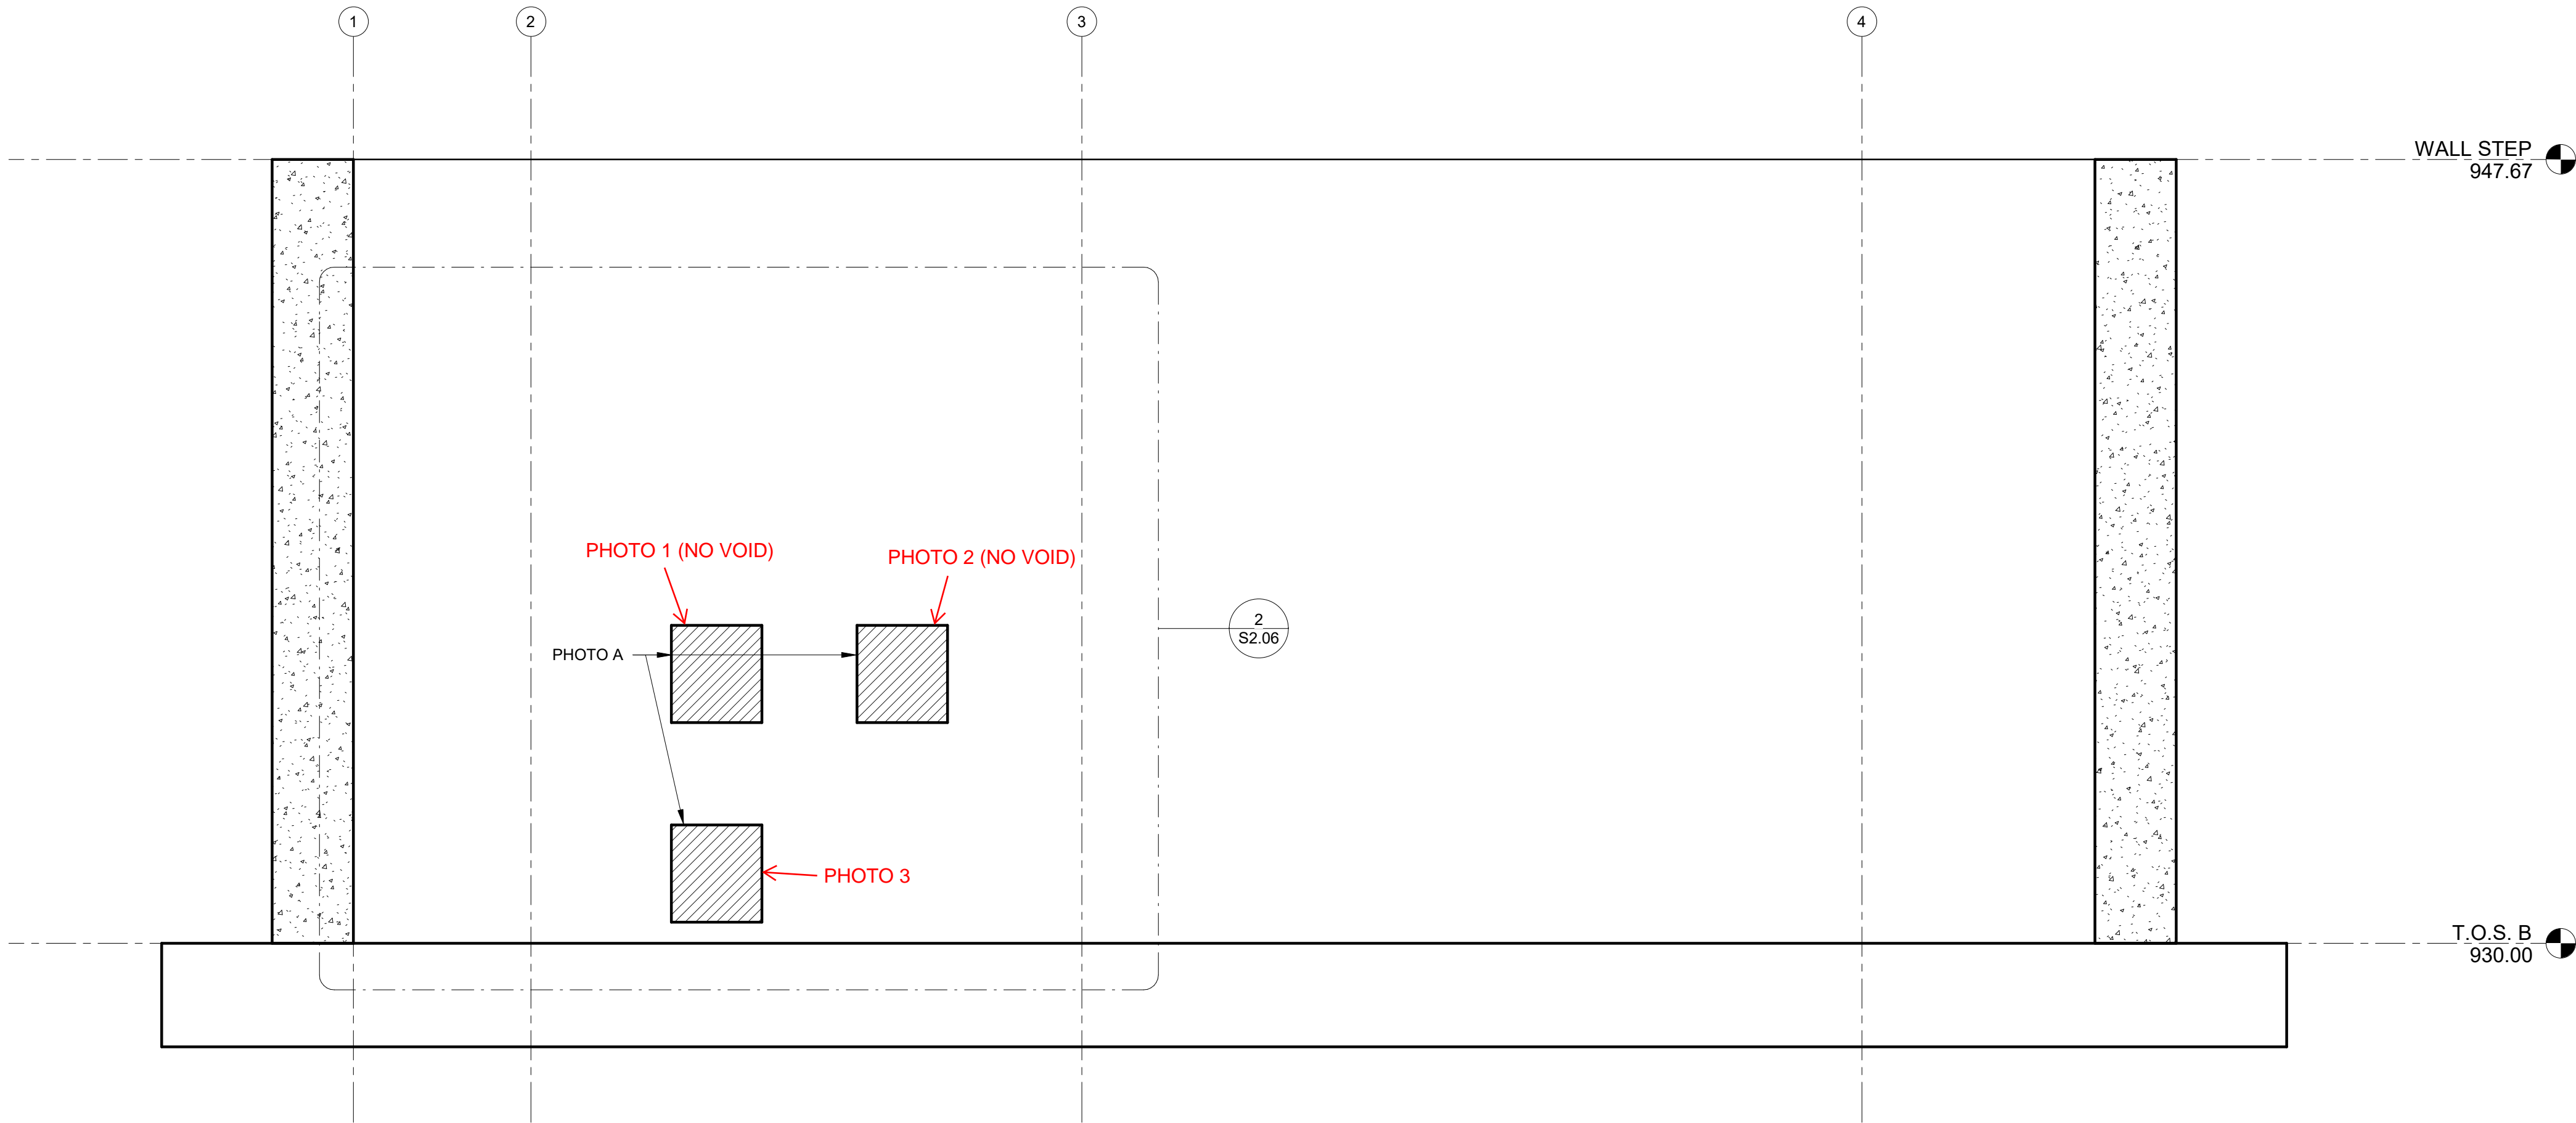

2 PHOTO A
3/8" = 1'-0"



Before Repair



After Repair

PHOTO 1



Before Repair



After Repair

PHOTO 2




Before Repair



After Repair

PHOTO 3

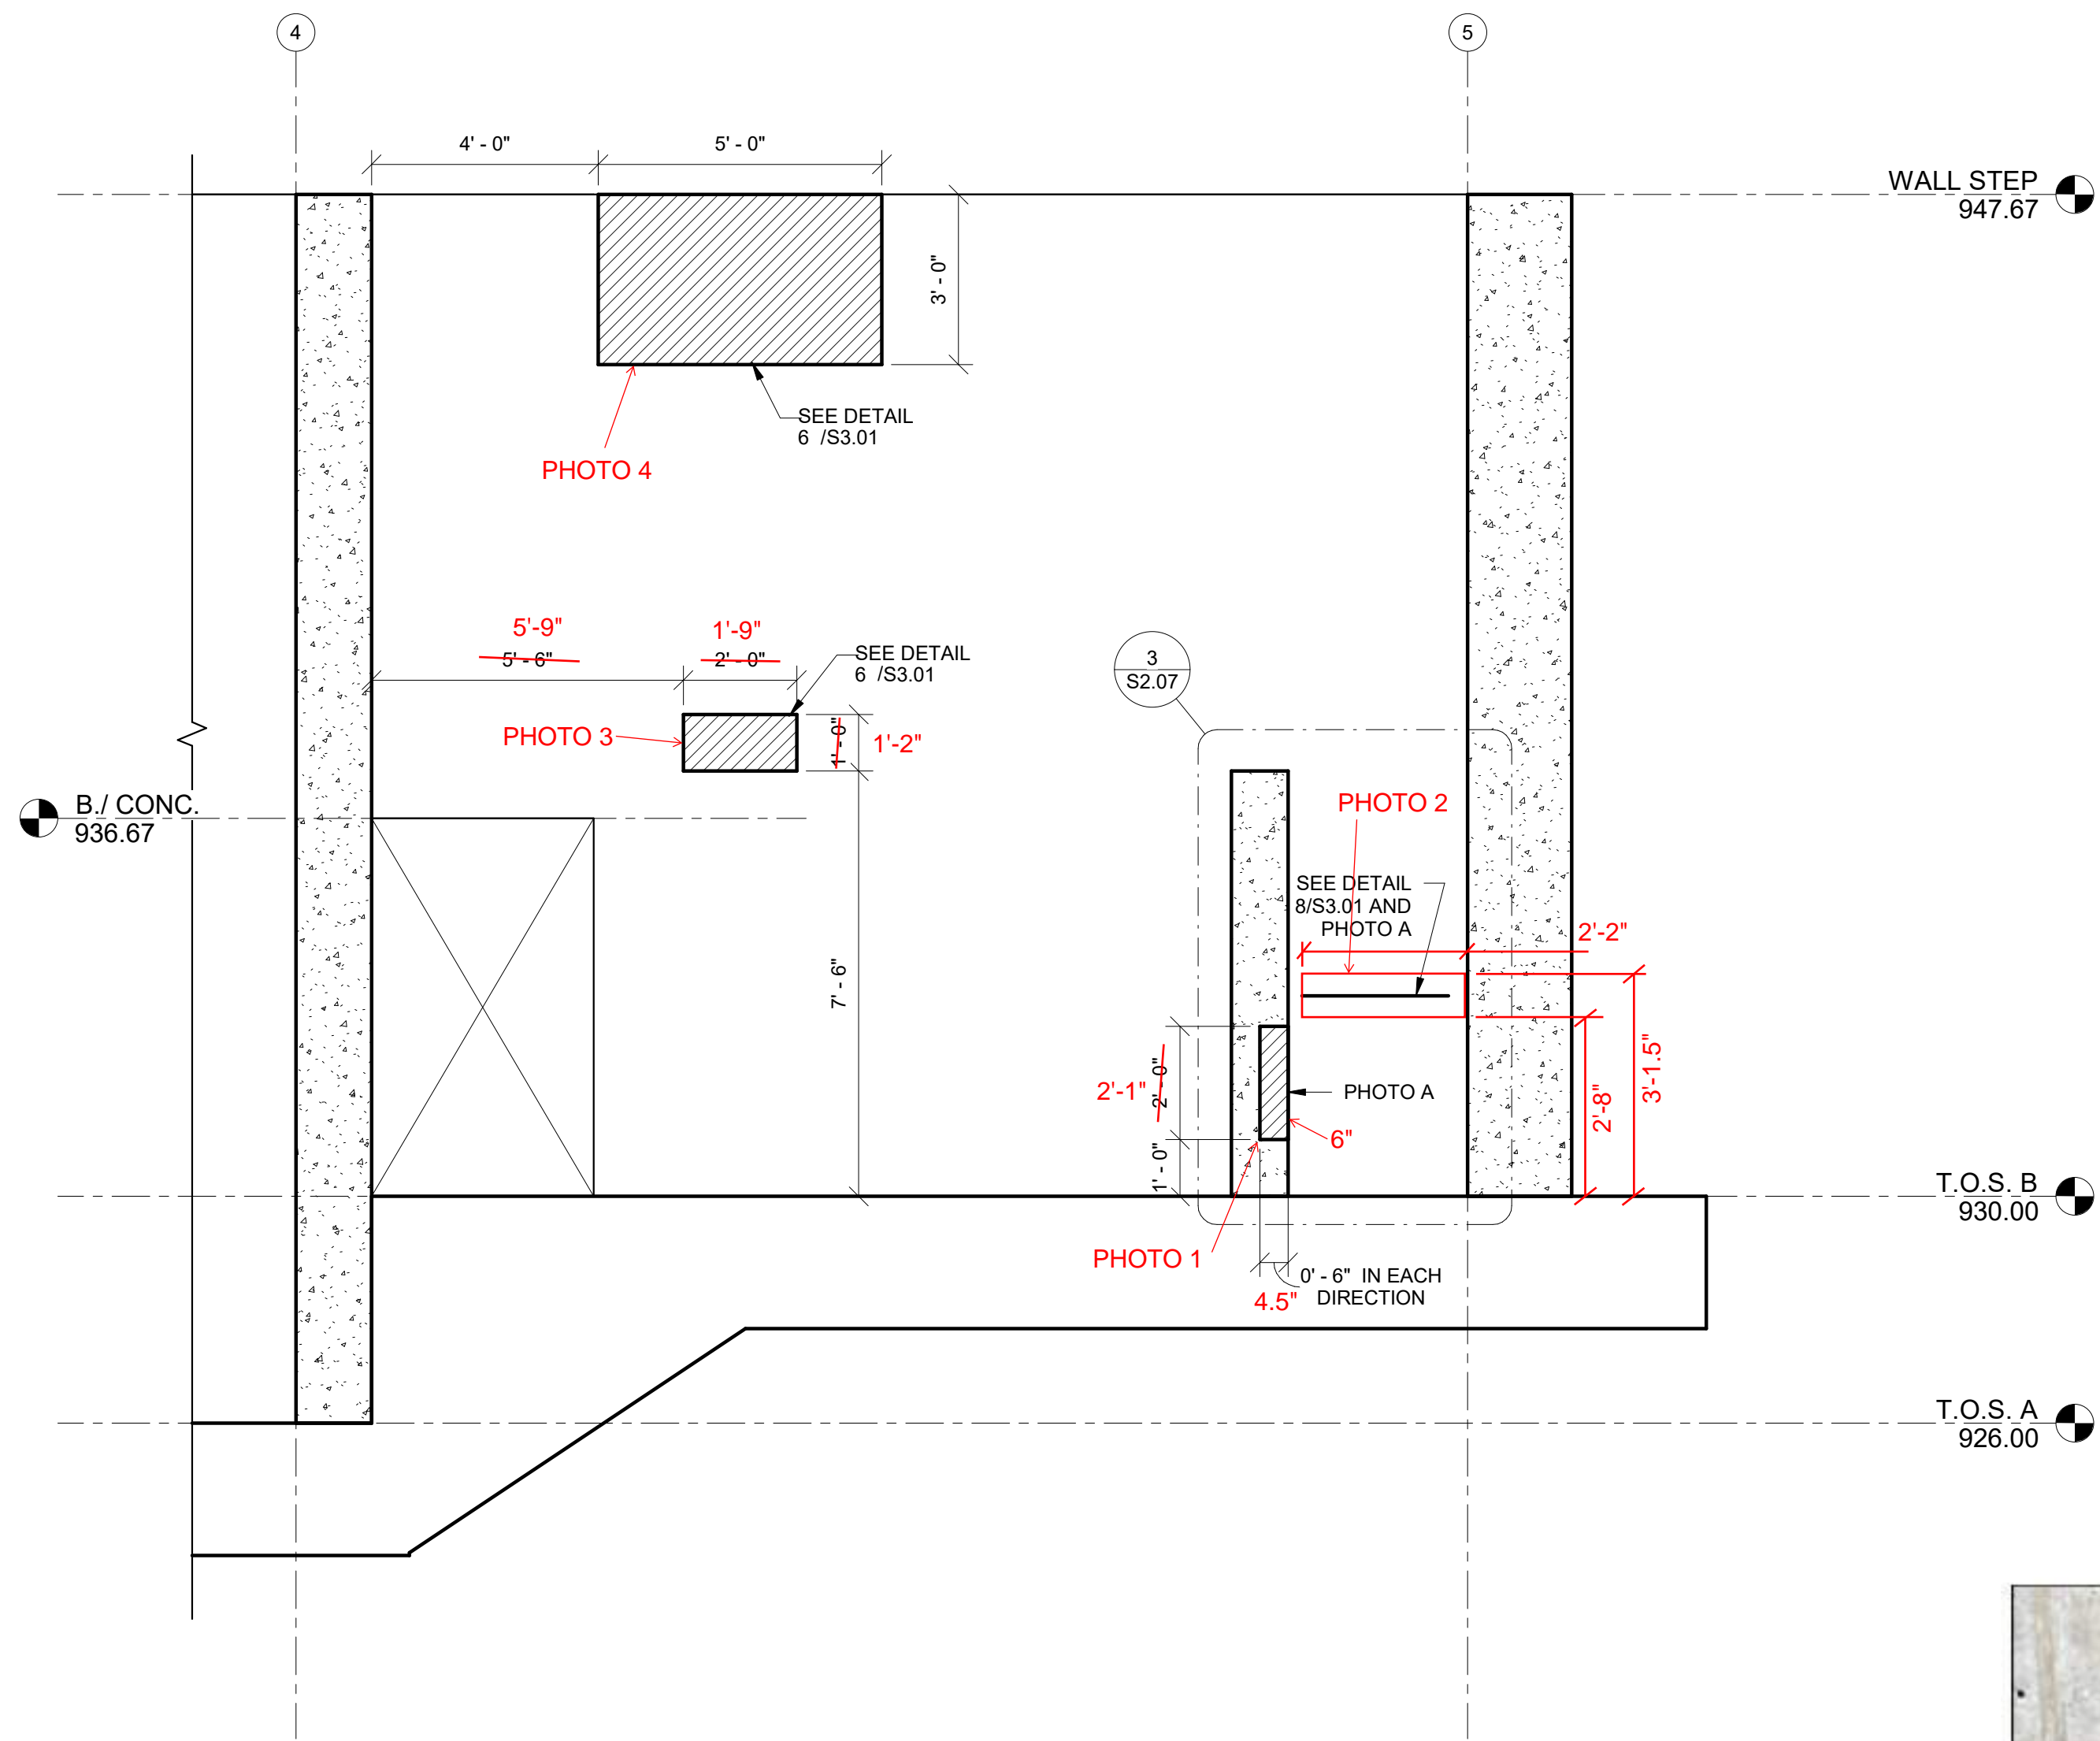

1 INTERIOR ELEVATION
3/8" = 1'-0"



3 PHOTO B



2 PHOTO A



SHUCK BRITSON

400 E COURT AVE.
SUITE 140.
DES MOINES, IOWA 50309
515-243-4477
www.shuck-britson.com

NEVADA WWTP IMPROVEMENTS LIMITED

CONCRETE WALL REPAIR

BOOMERANG

457 S. 6th STREET NEVADA IOWA 50201

Project Status

PROJECT NUMBER 123.0172.03

DATE 03/24/2023

WALL ELEVATIONS

SHEET NO.

S2.07



Before Repair



After Repair

PHOTO 1



Before Repair



After Repair

PHOTO 2



Before Repair



After Repair

PHOTO 3



Before Repair



After Repair

PHOTO 4

CHUCK BRITSON

400 E COURT AVE.
SUITE 140.
DES MOINES, IOWA 50309
515-243-4477
www.shuck-britson.com

NEVADA WWTP IMPROVEMENTS LIMITED
CONCRETE WALL REPAIR
BOOMERANG

45/ S. 6th S IREE I NEVADA IOWA 50201

Project Status

PROJECT NUMBER

0172

TE


SHEET TITLE

24/2

ALL ELEVATIONS

SHEET NO.

S2.08

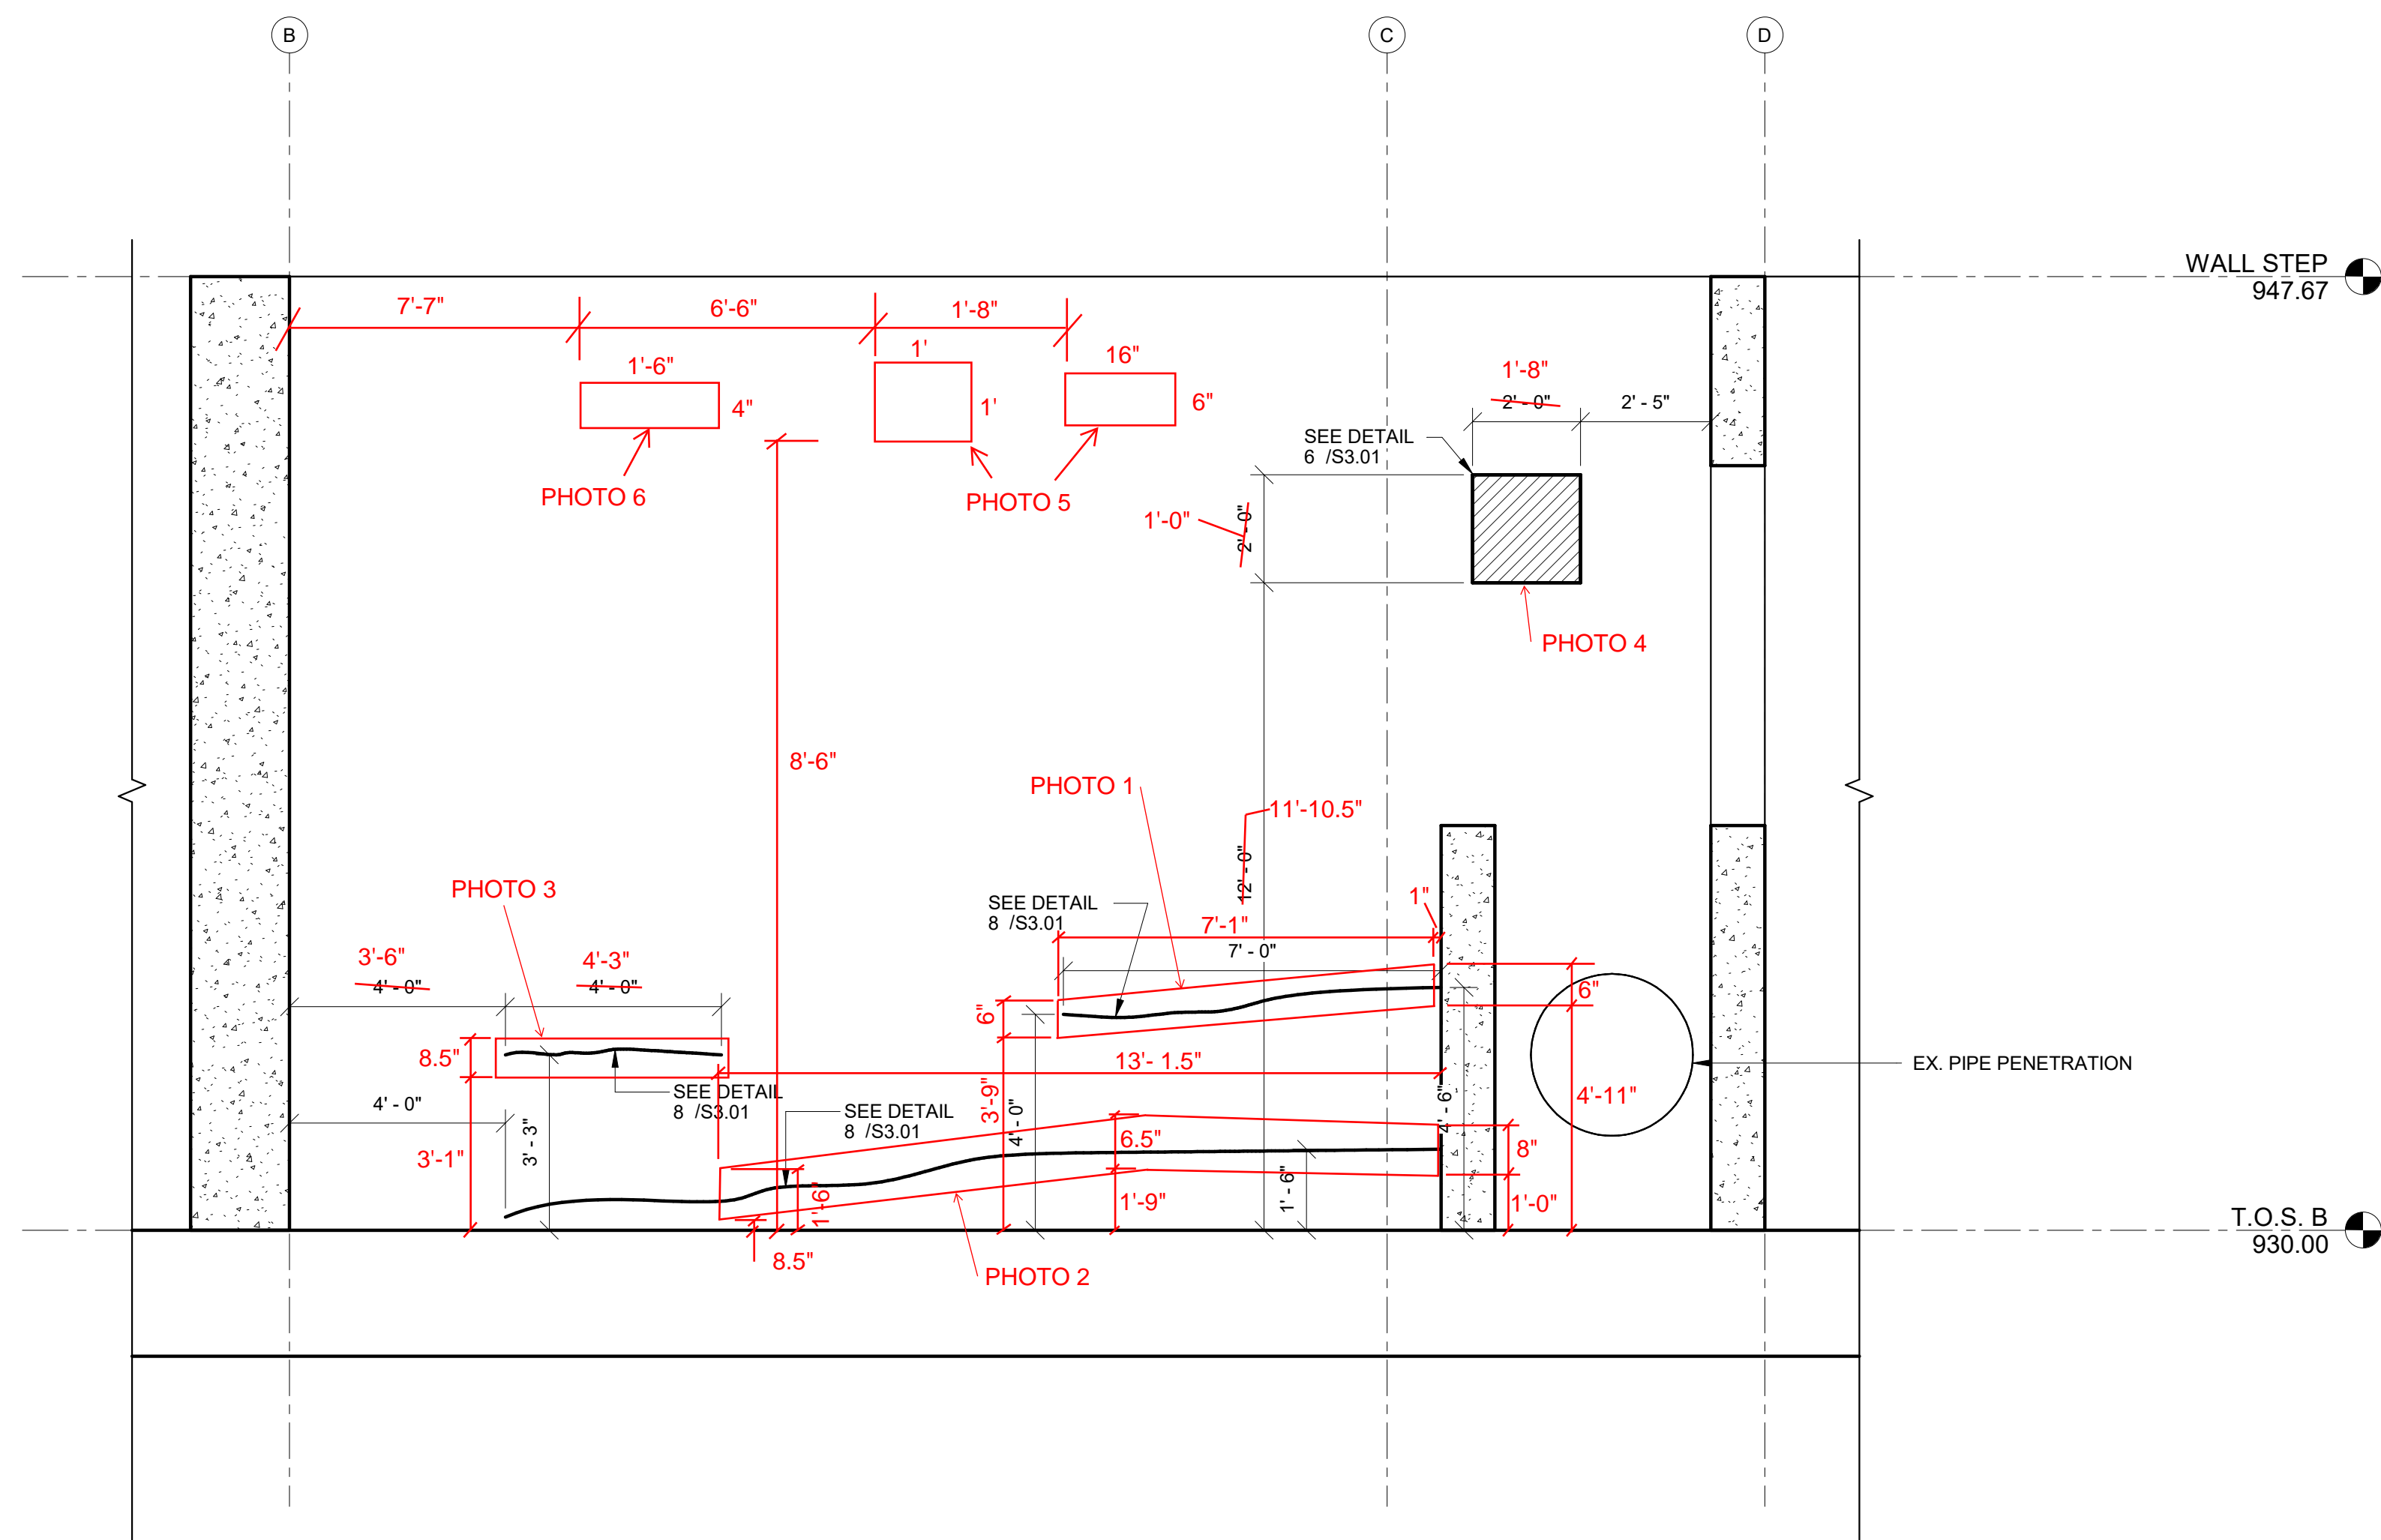

1 INTERIOR ELEVATION
3/8" = 1'-0"



Before Repair



Before Repair



Before Repair



After Repair



After Repair

PHOTO 1



Before Repair



Before Repair



PHOTO 2



After Repair



After Repair



After Repair



After Repair

PHOTO 2



Before Repair



Before Repair



After Repair

PHOTO 3



Before Repair



After Repair

PHOTO 4



Before Repair



After Repair

PHOTO 5



Before Repair



After Repair

PHOTO 6

CHUCK BRITSON

400 E COURT AVE.
SUITE 140.
DES MOINES, IOWA 50309
515-243-4477
www.shuck-britson.com

NEVADA WWTP IMPROVEMENTS LIMITED
CONCRETE WALL REPAIR

BOOMERANG
457 S. 6th STREET NEVADA IOWA 50201

Project Status


PROJECT NUMBER	123.0172.03
----------------	-------------

DATE 03/24/2023


ALL ELEVATIONS

SHEET NO. _____

S2.09

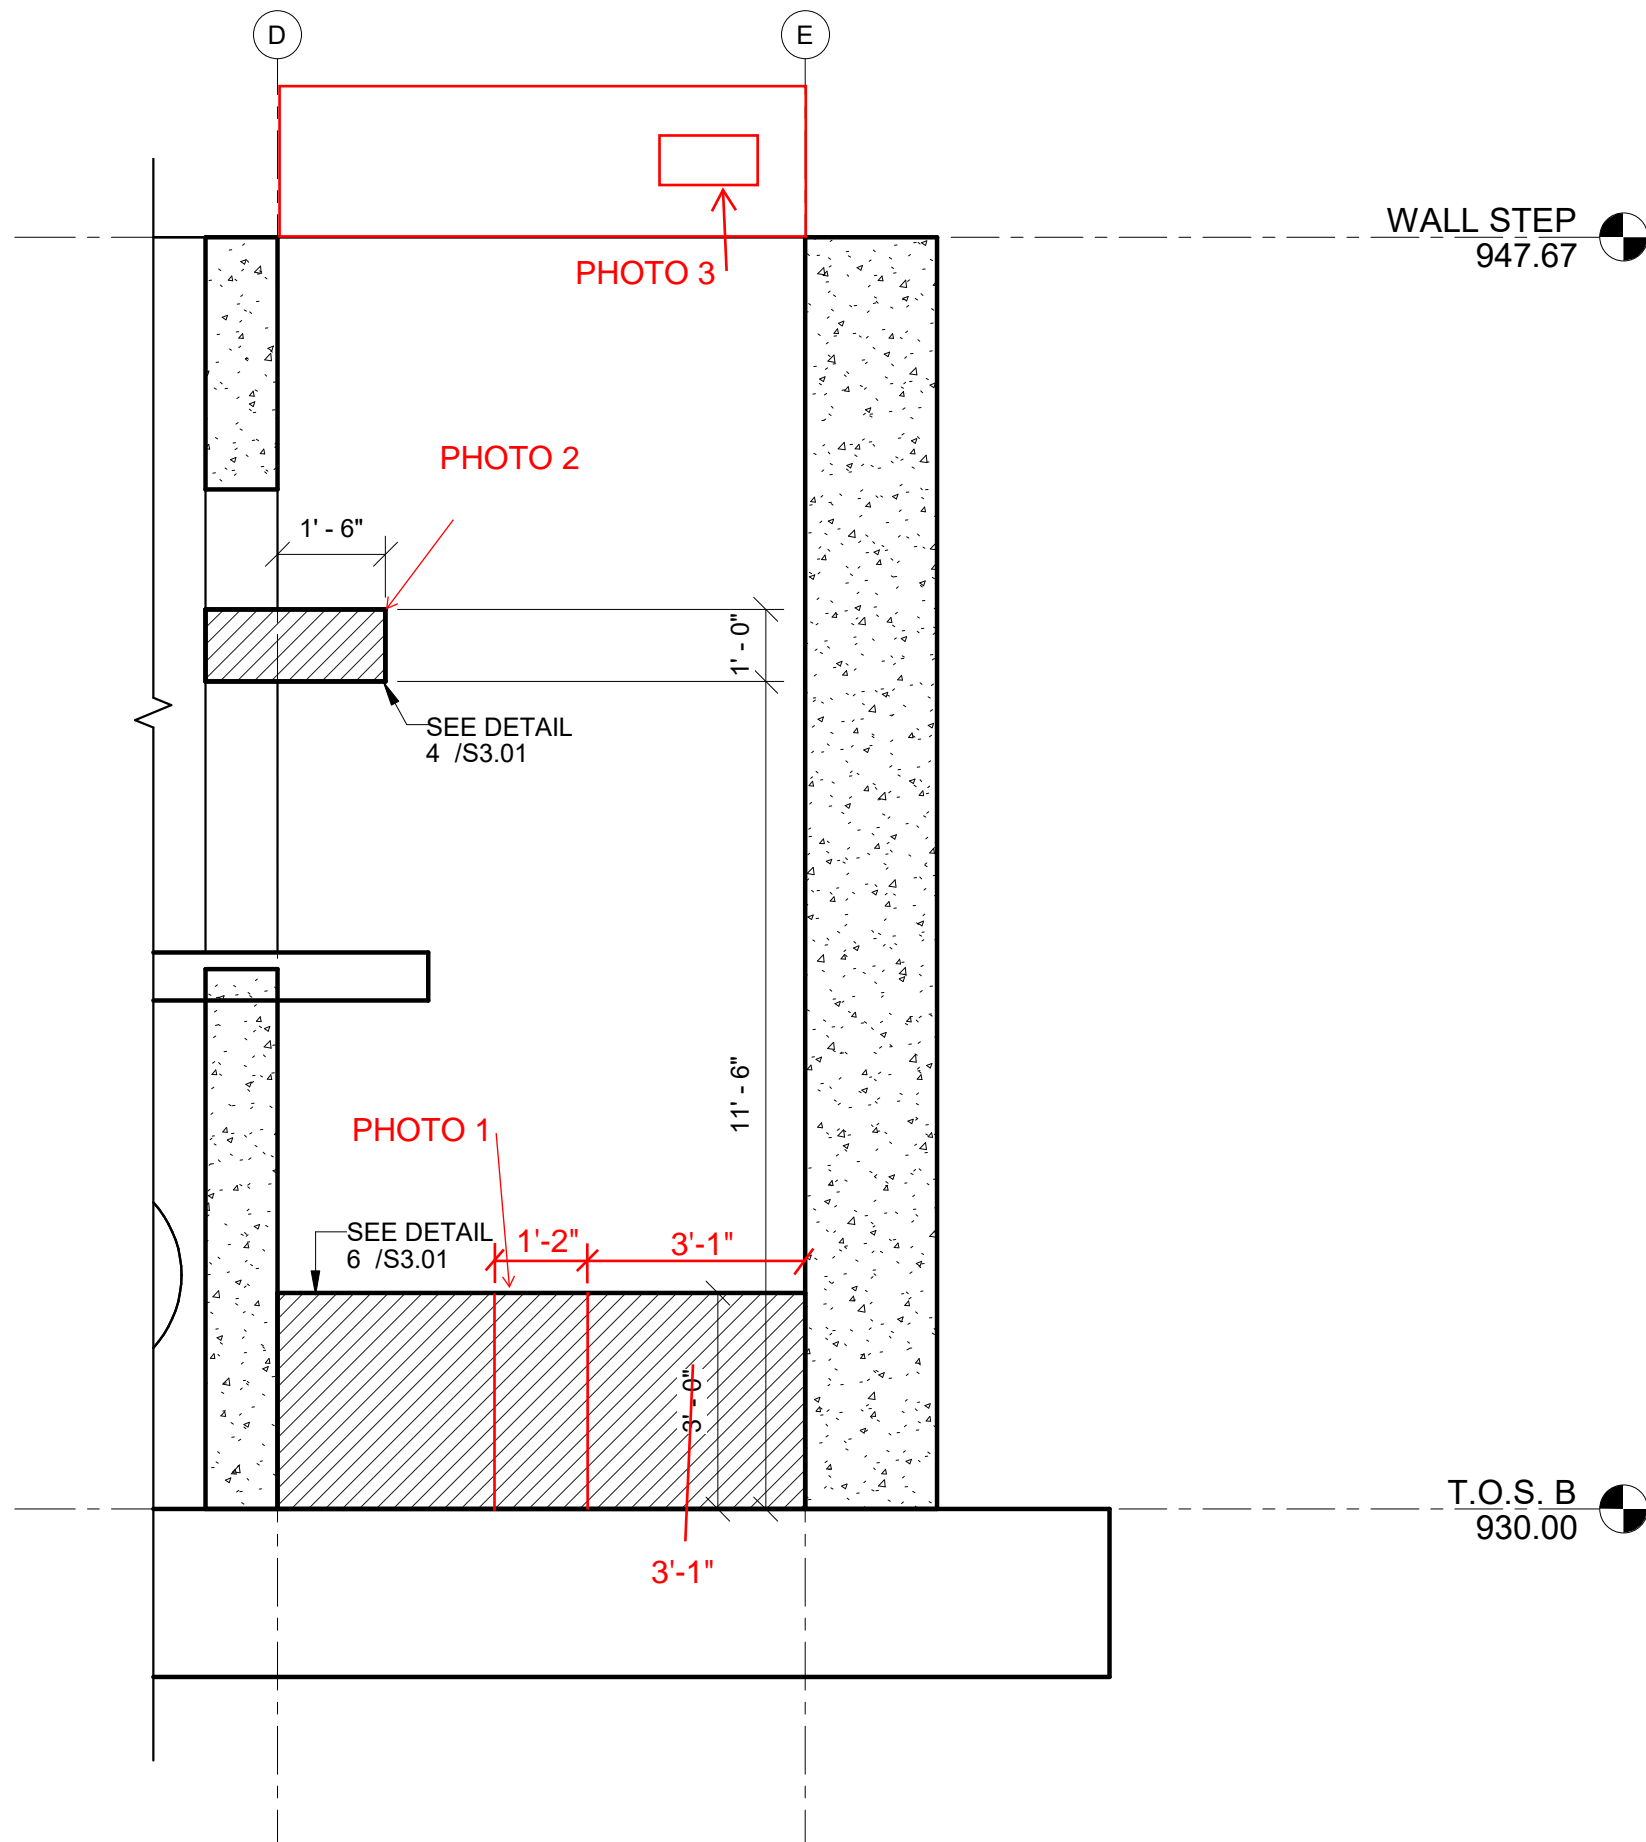

1 INTERIOR ELEVATION
3/8" = 1'-0"

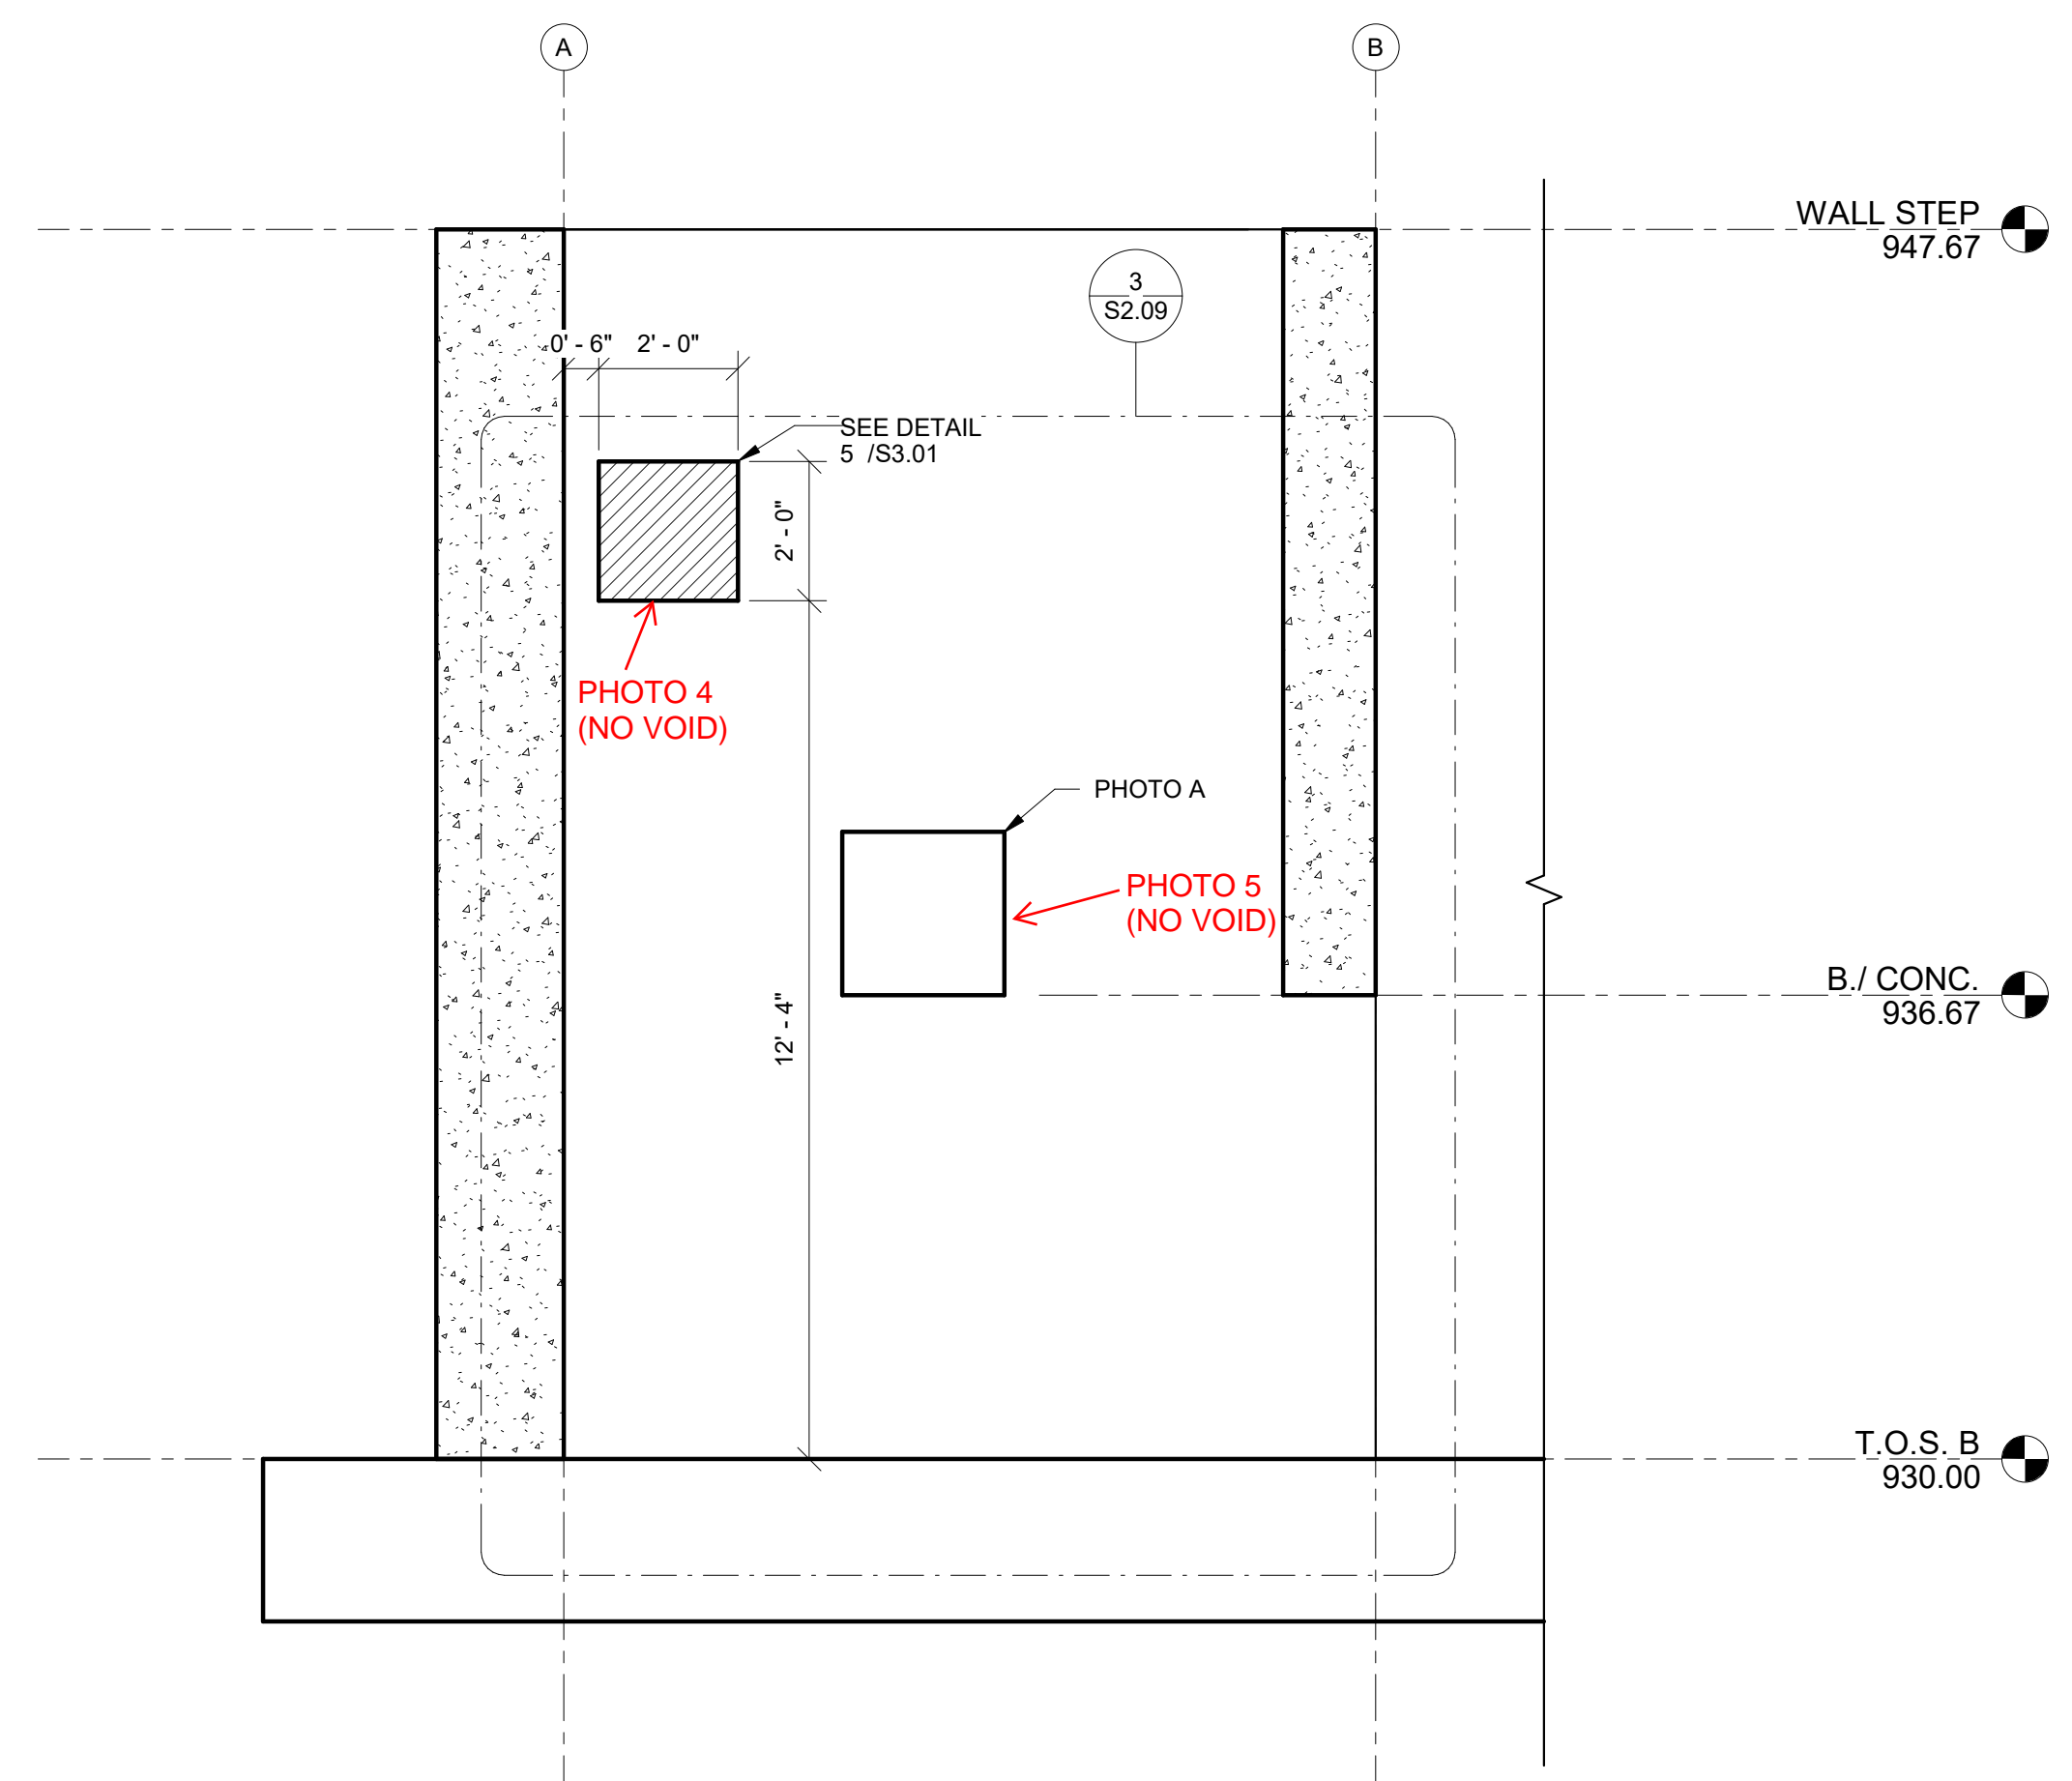

2 INTERIOR ELEVATION
3/8" = 1'-0"



3 PHOTO A
 $\frac{3}{8}'' = 1'-0''$



Before Repair



After Repair

PHOTO 1



Before Repair



After Repair

PHOTO 3



Before Repair



Before Repair




After Repair

PHOTO 2



Before Repair

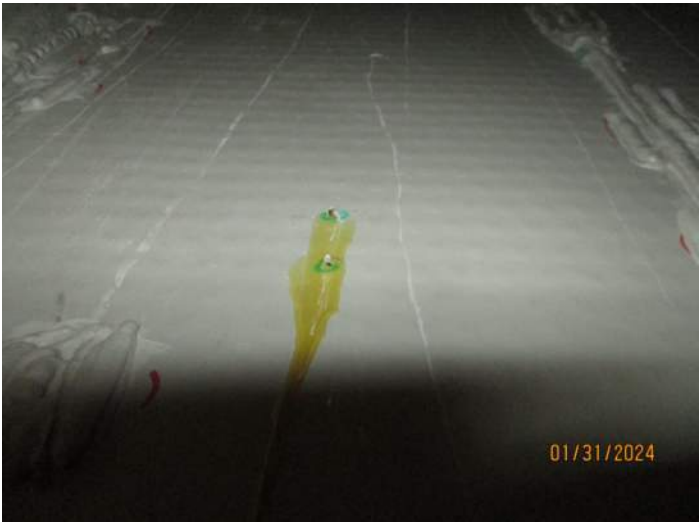

After Repair

PHOTO 4




Before Repair



After Repair

PHOTO 5

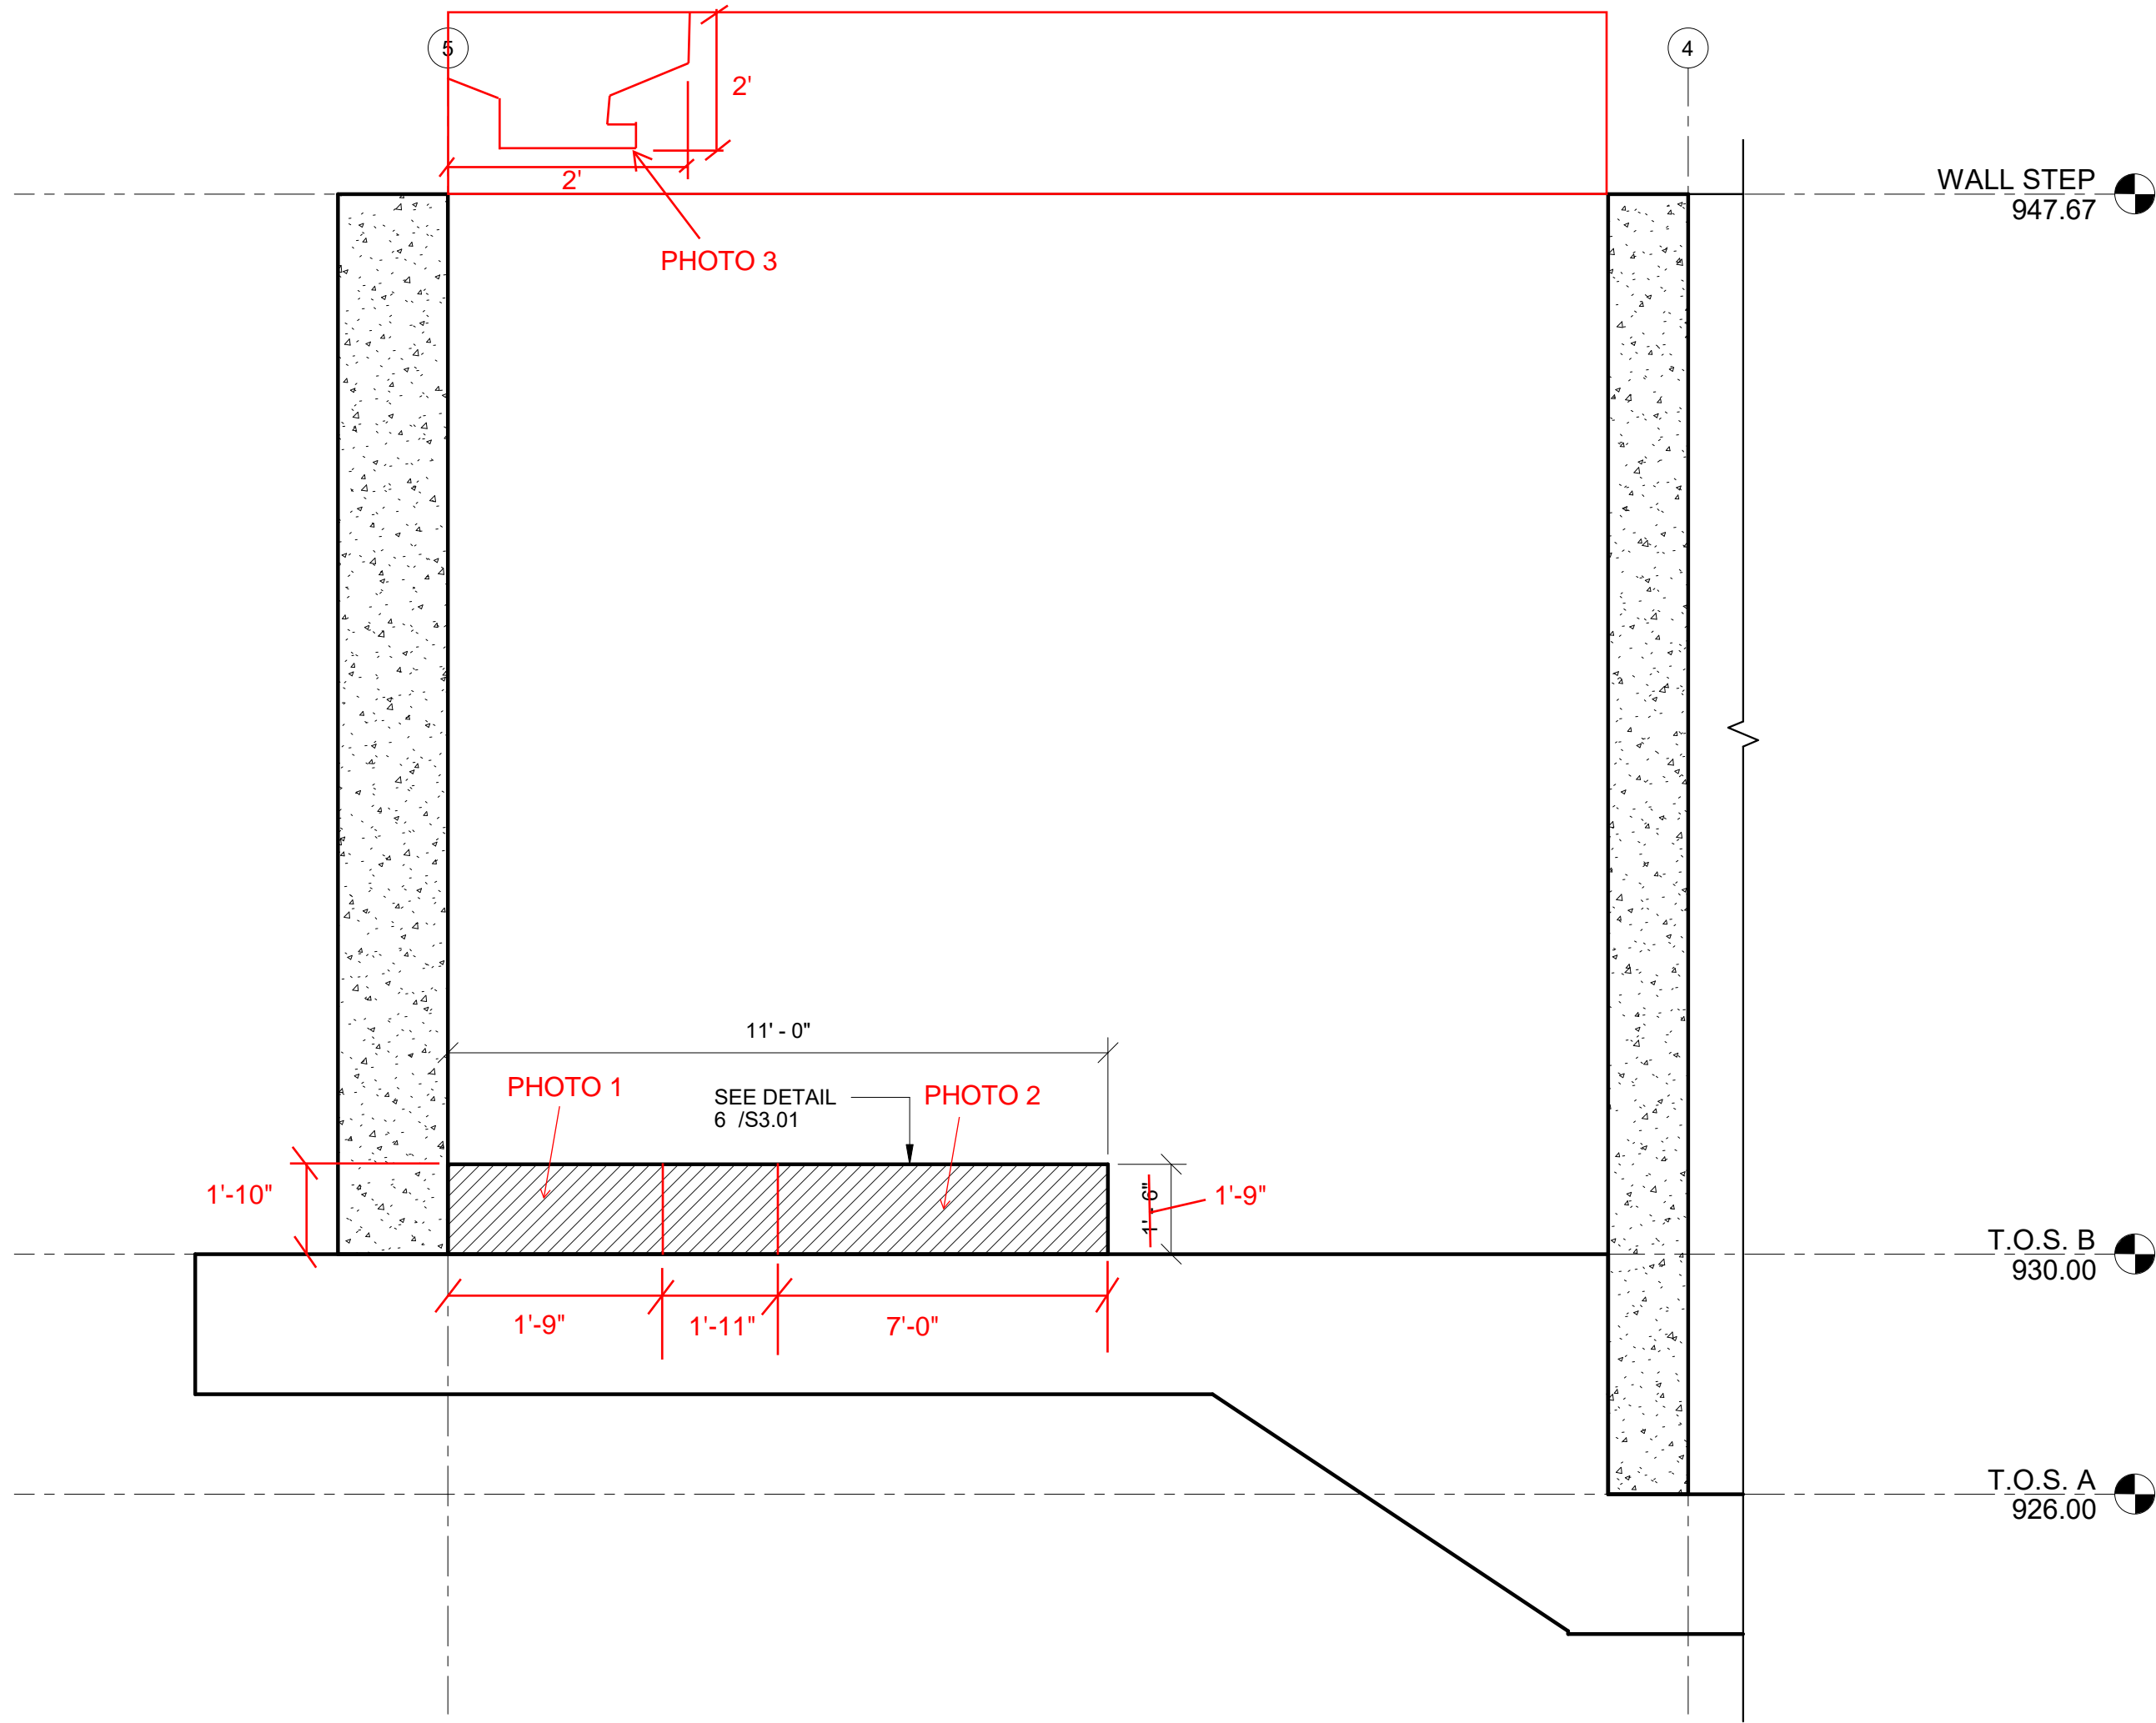

1 INTERIOR ELEVATION
3/8" = 1'-0"



Before Repair



After Repair

PHOTO 1



Before Repair



After Repair

PHOTO 2




Before Repair




After Repair

PHOTO 3

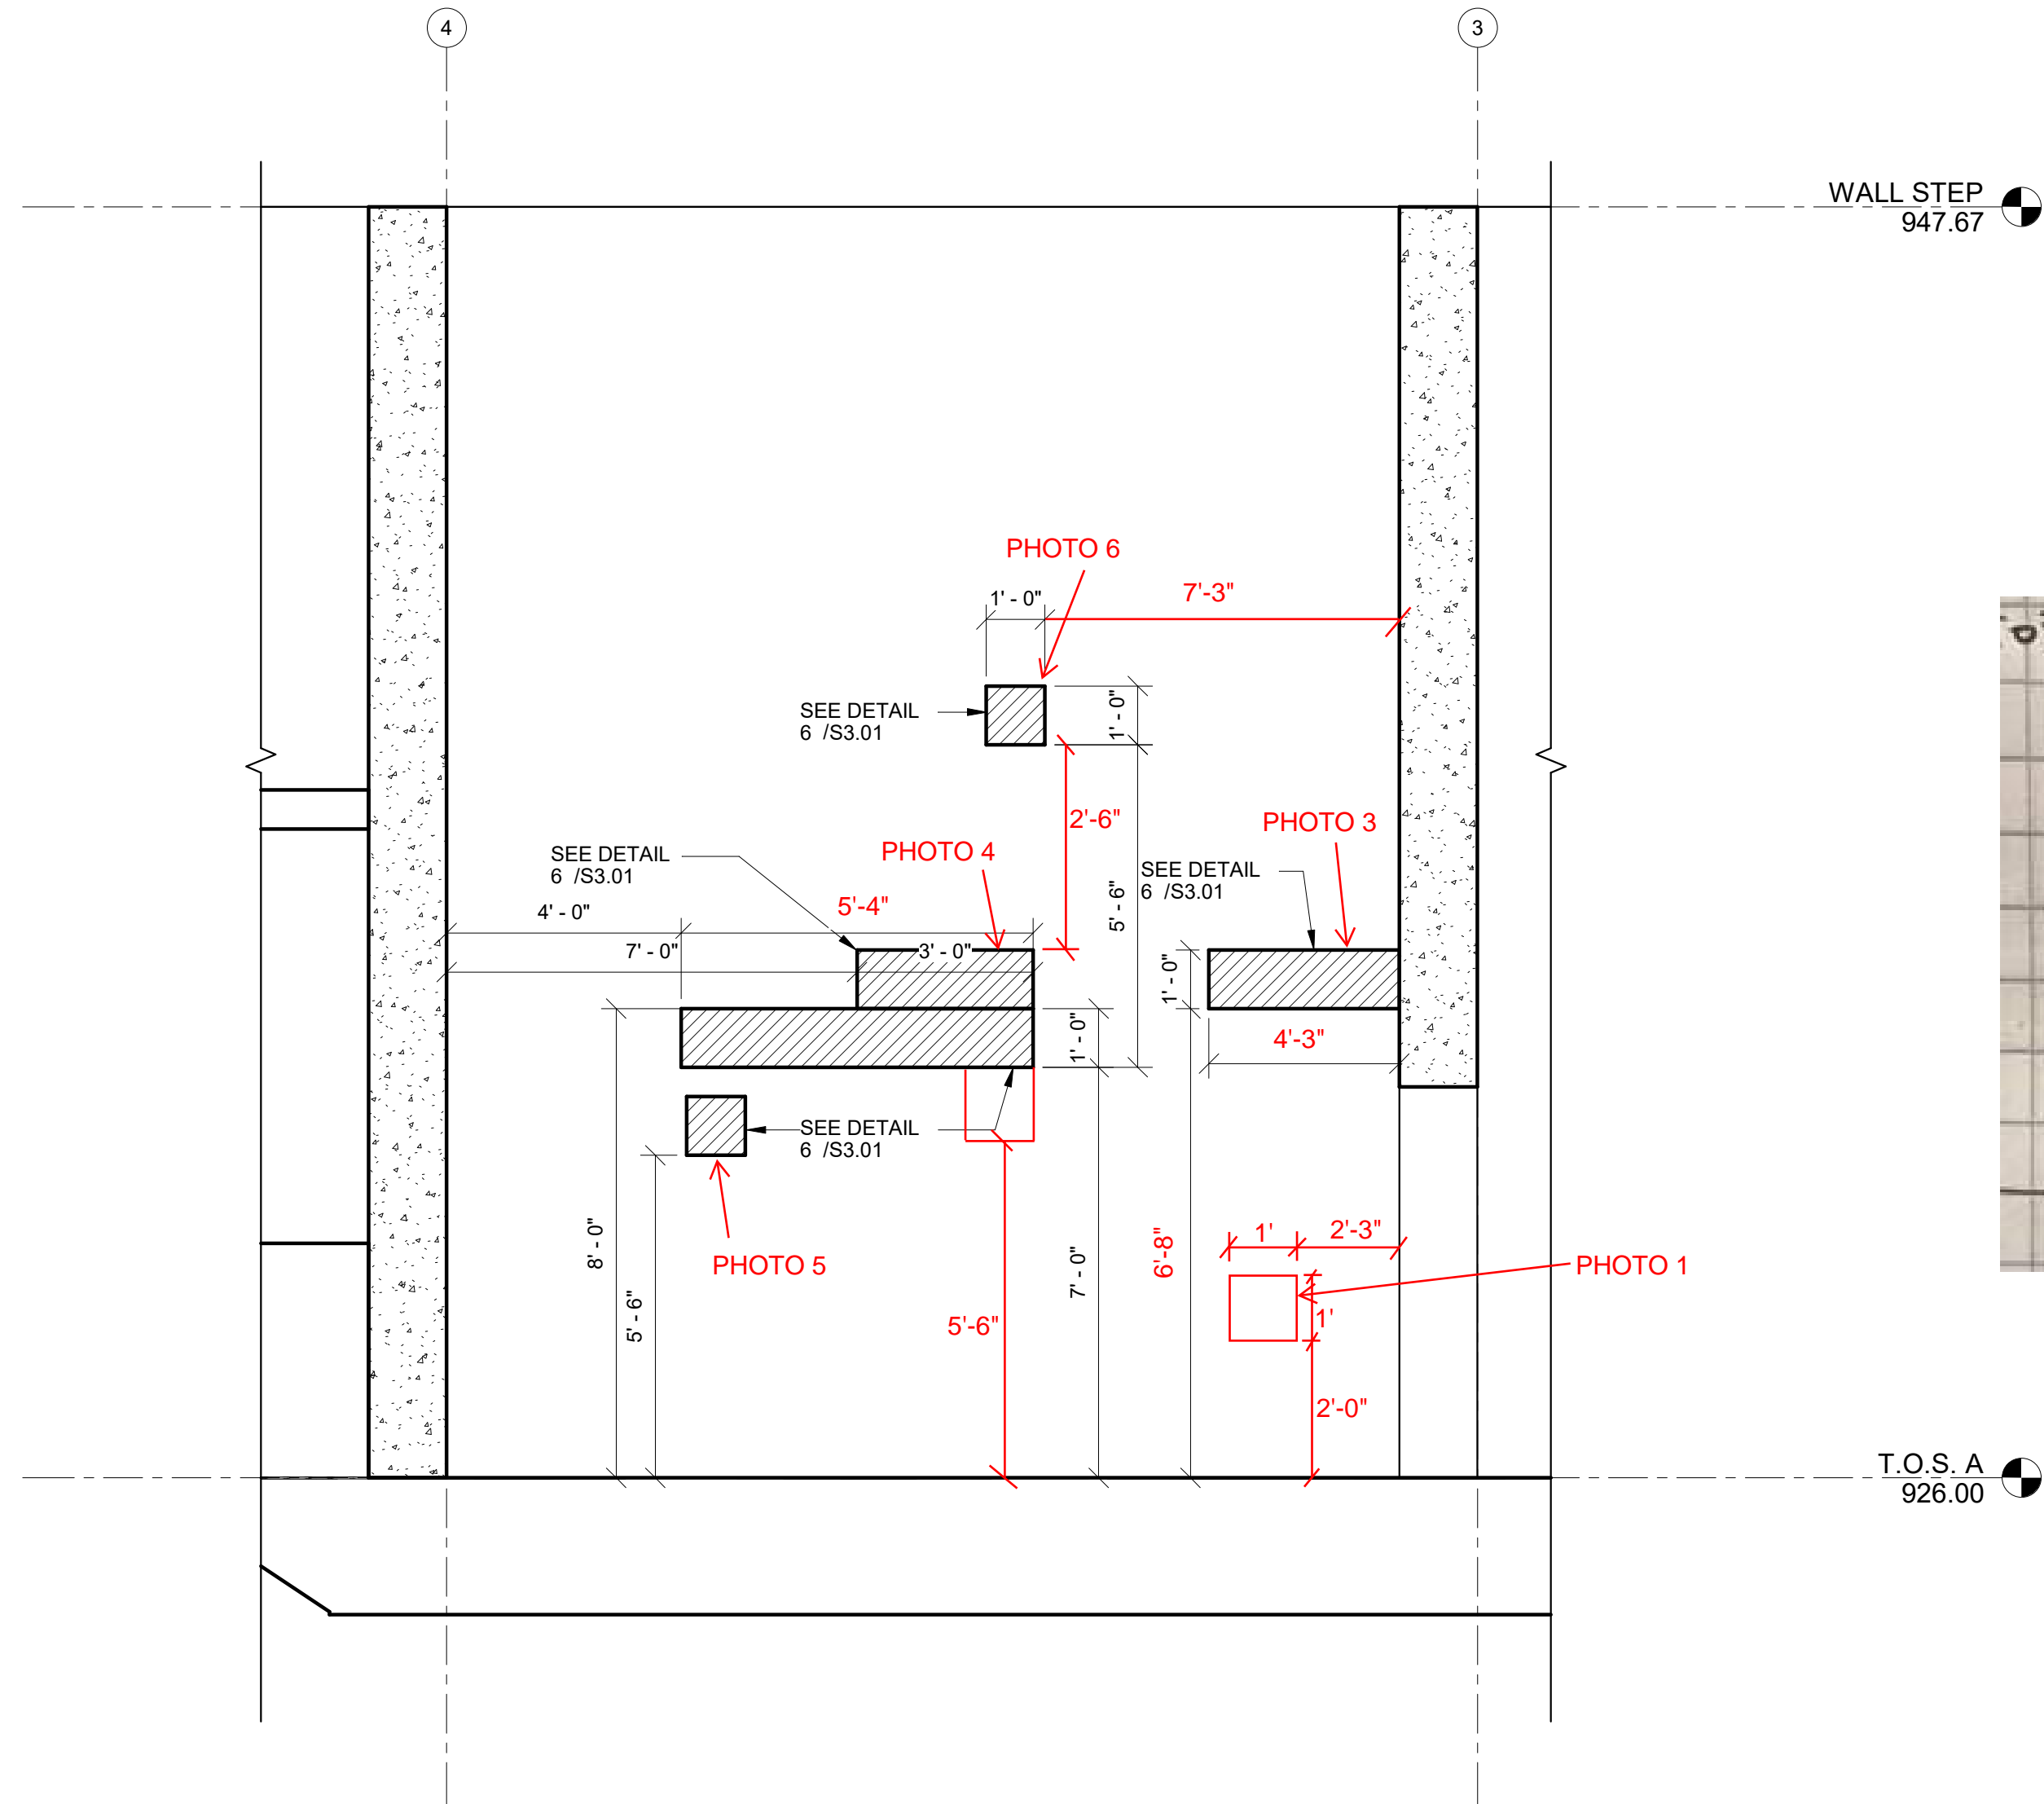

1 INTERIOR ELEVATION
3/8" = 1'-0"

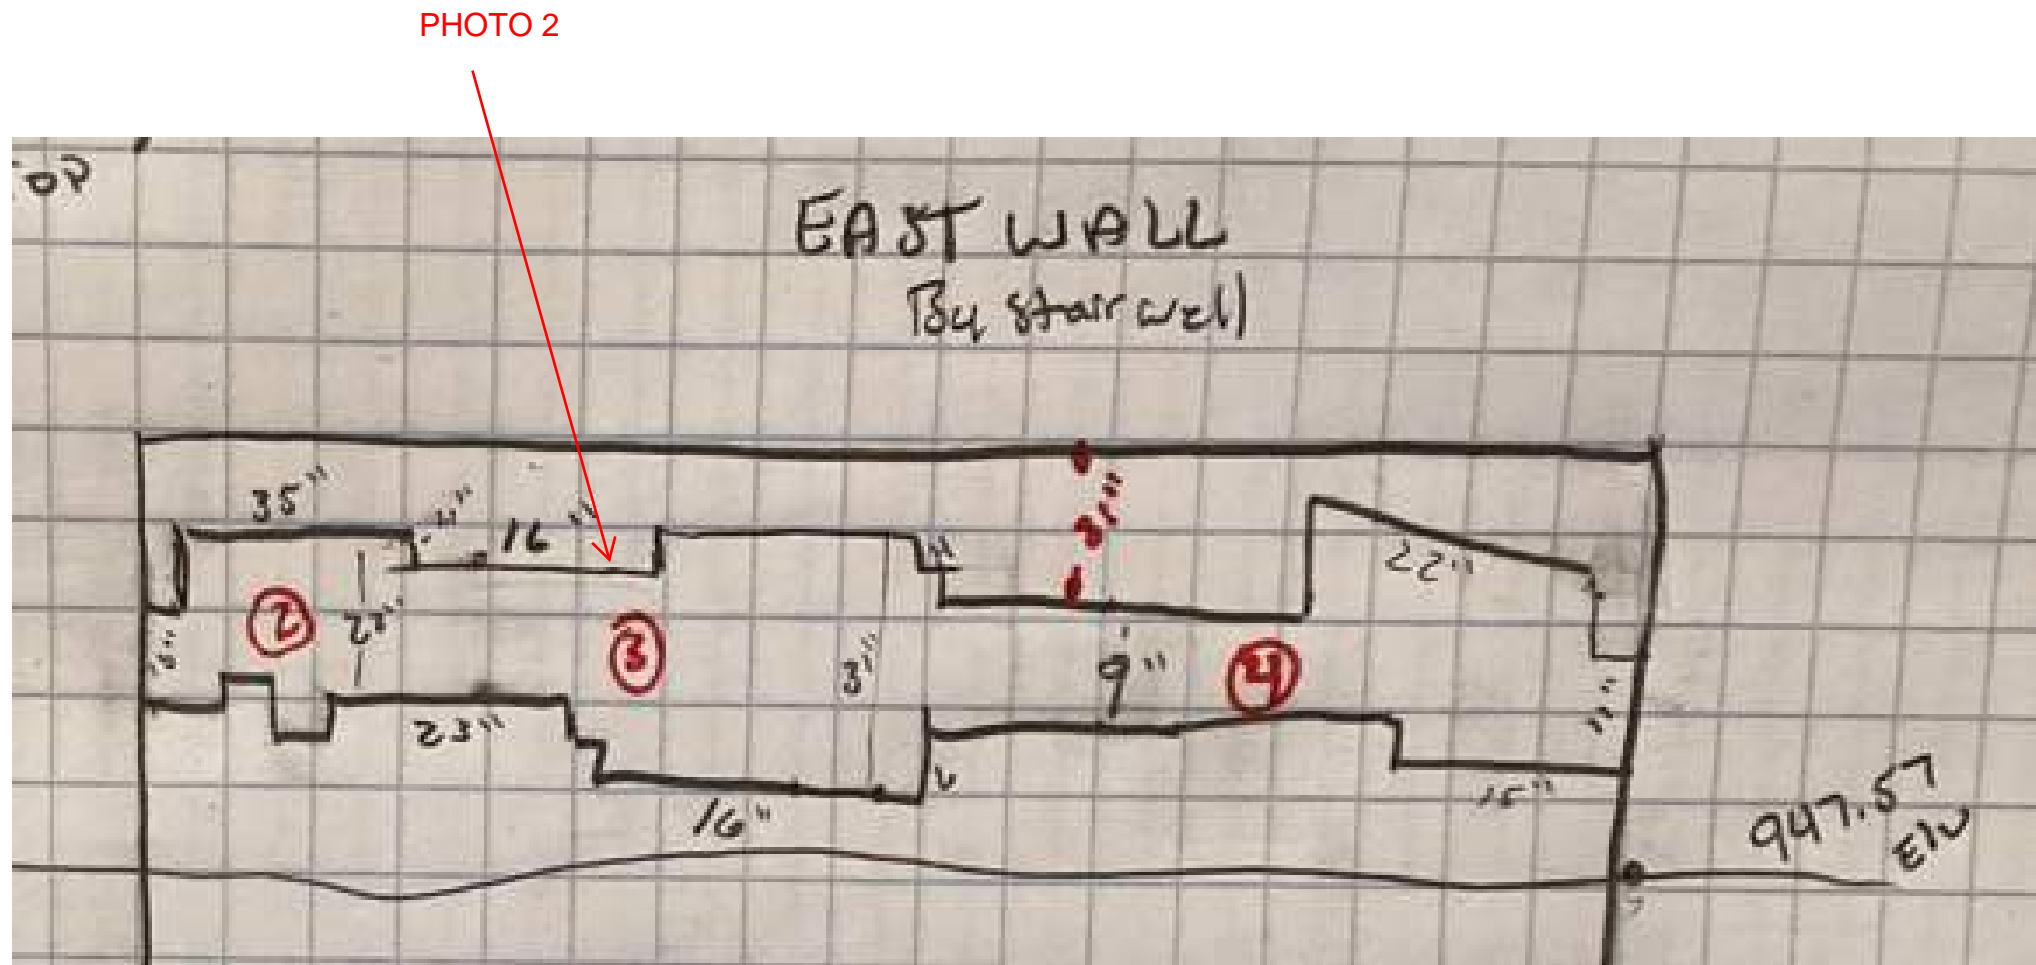



Before Repair



After Repair

PHOTO 1



Before Repair



Before Repair




Before Repair



After Repair

PHOTO 2

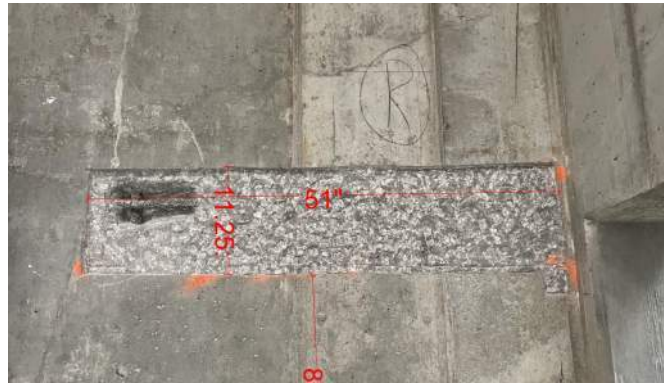


Before Repair



After Repair

PHOTO 3

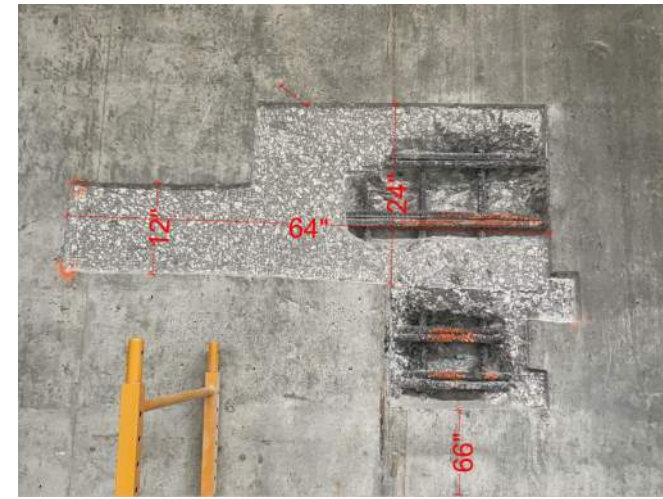


Before Repair



After Repair

PHOTO 4

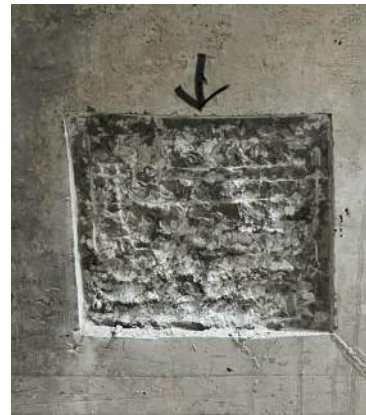

Before Repair



After Repair

PHOTO 6



Before Repair




After Repair

PHOTO 5

3/24/2023 5:11:55 PM

C:\Users\chris\Documents\123.0172.03_STRUCT\R220_chris\S2.12.dwg

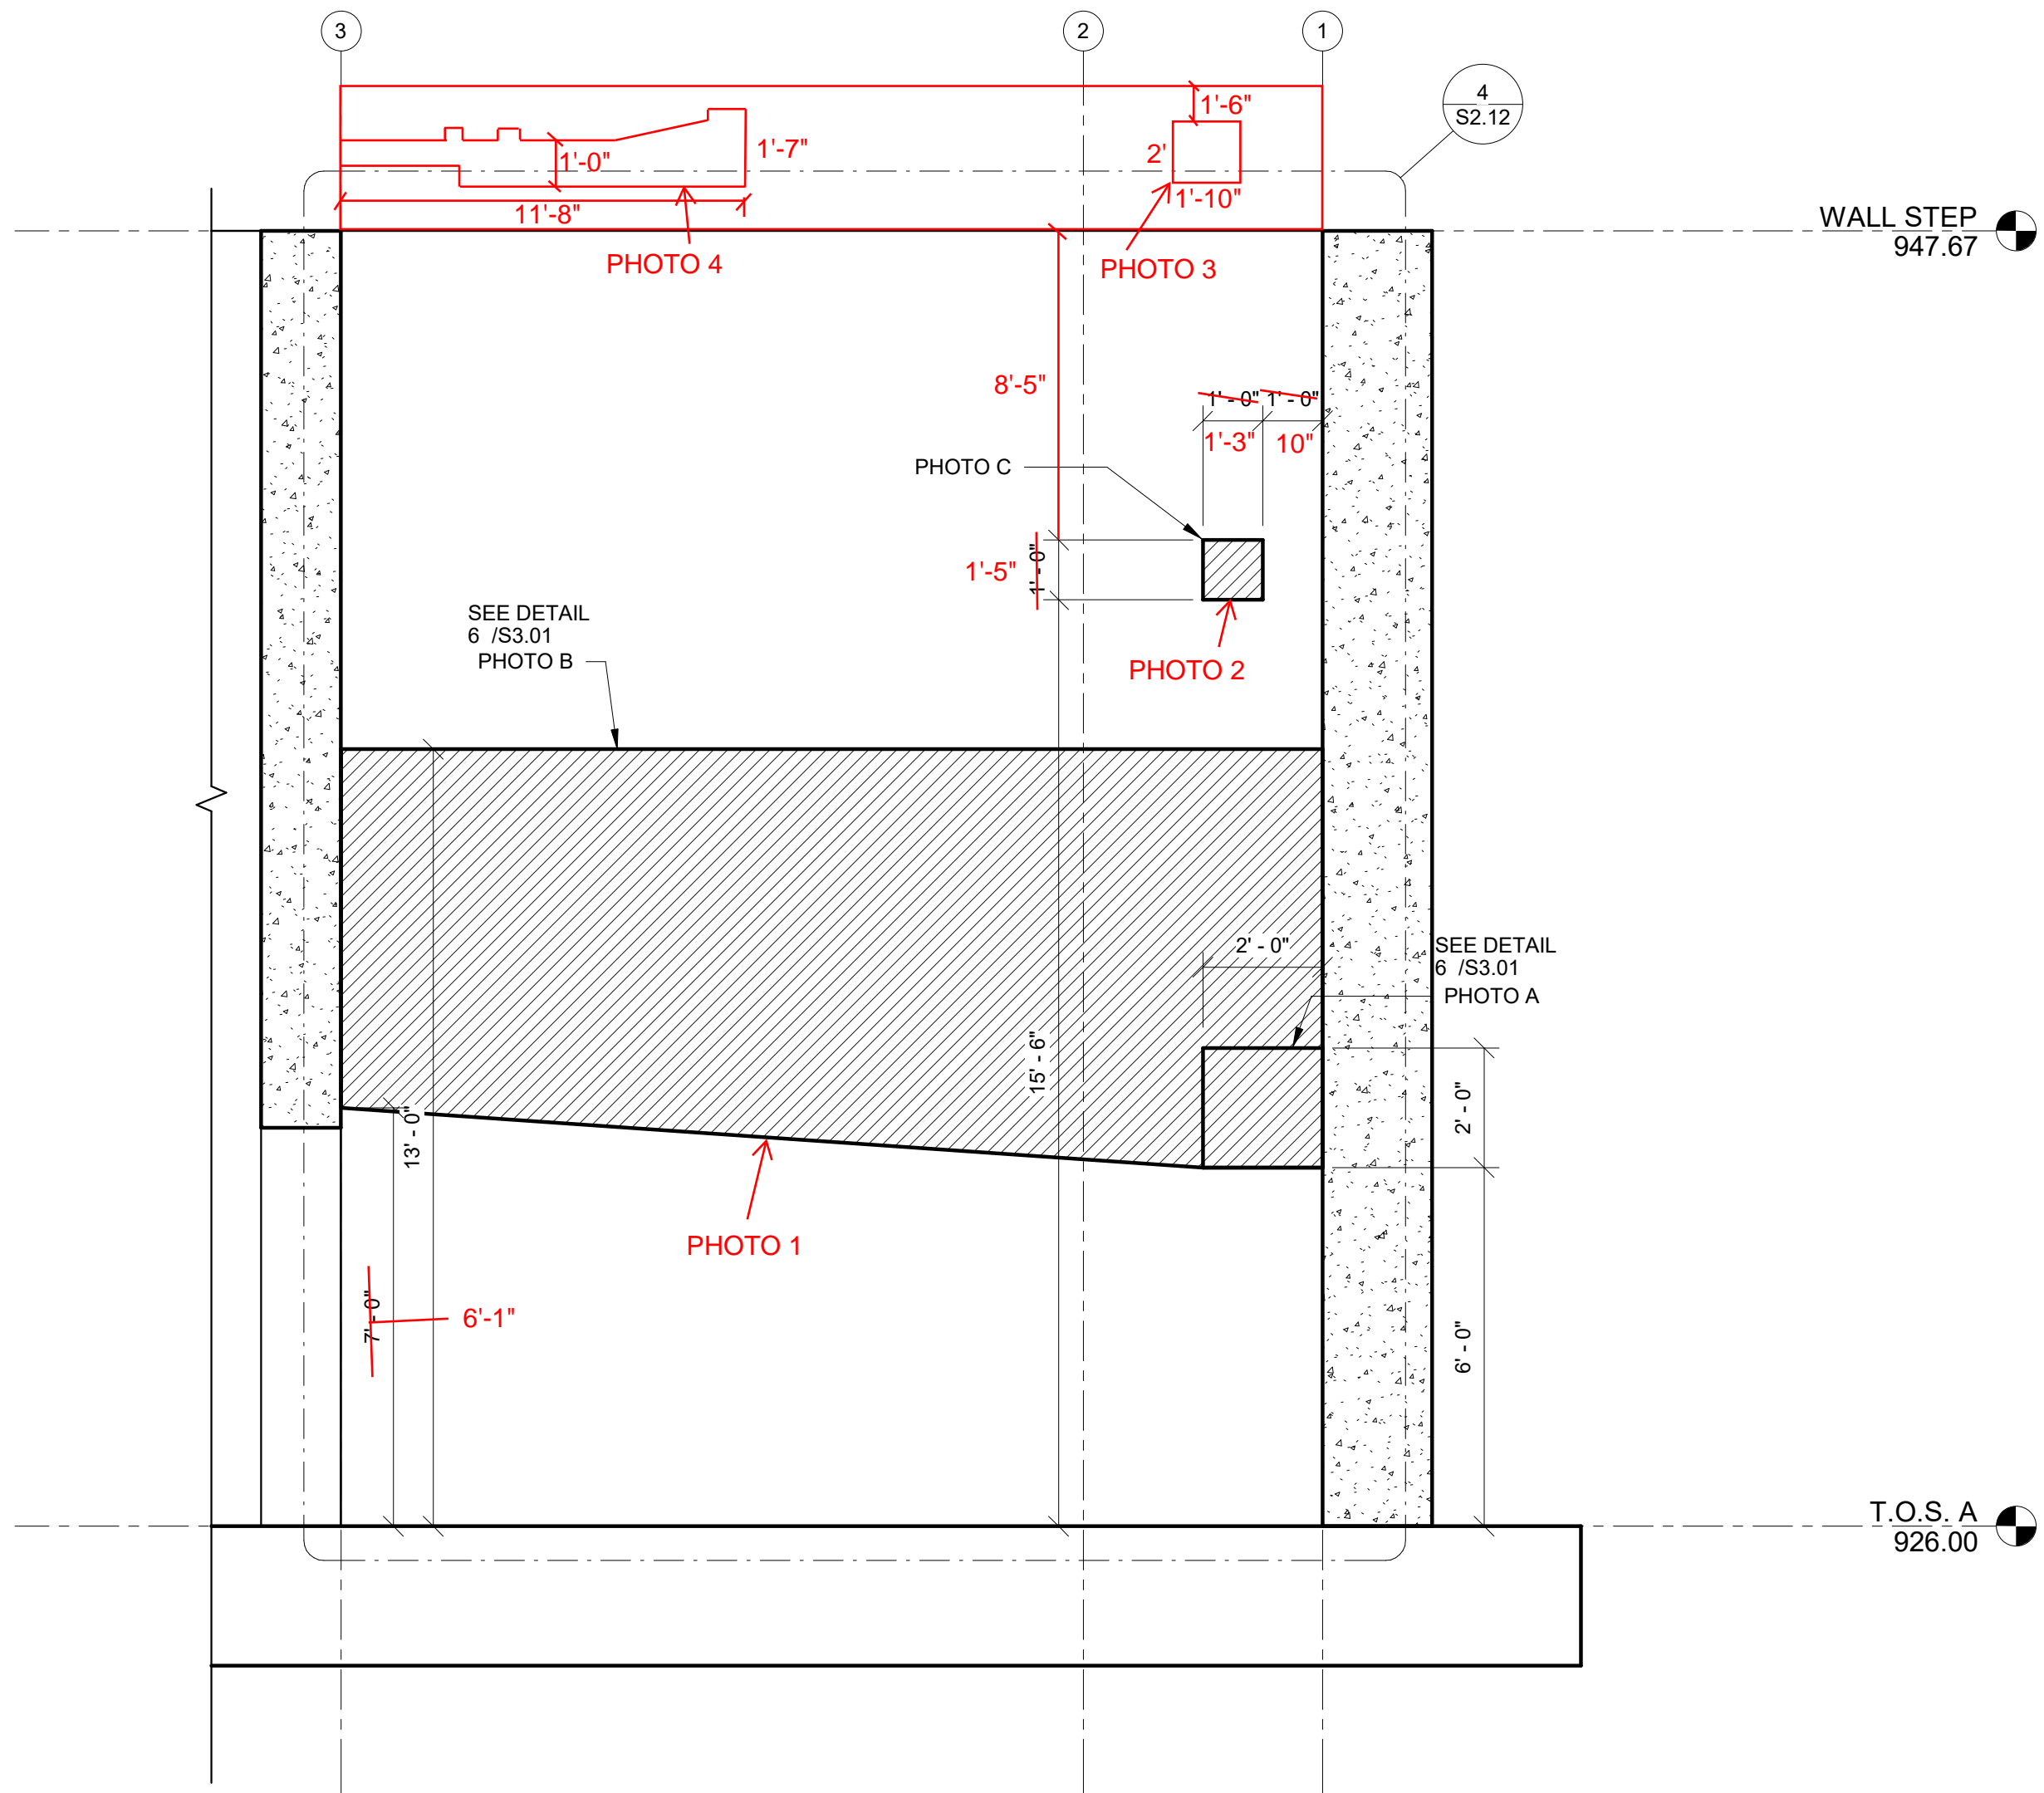


1 INTERIOR ELEVATION
3/8" = 1'-0"


ORIGINAL REPAIRS



3 PHOTO B

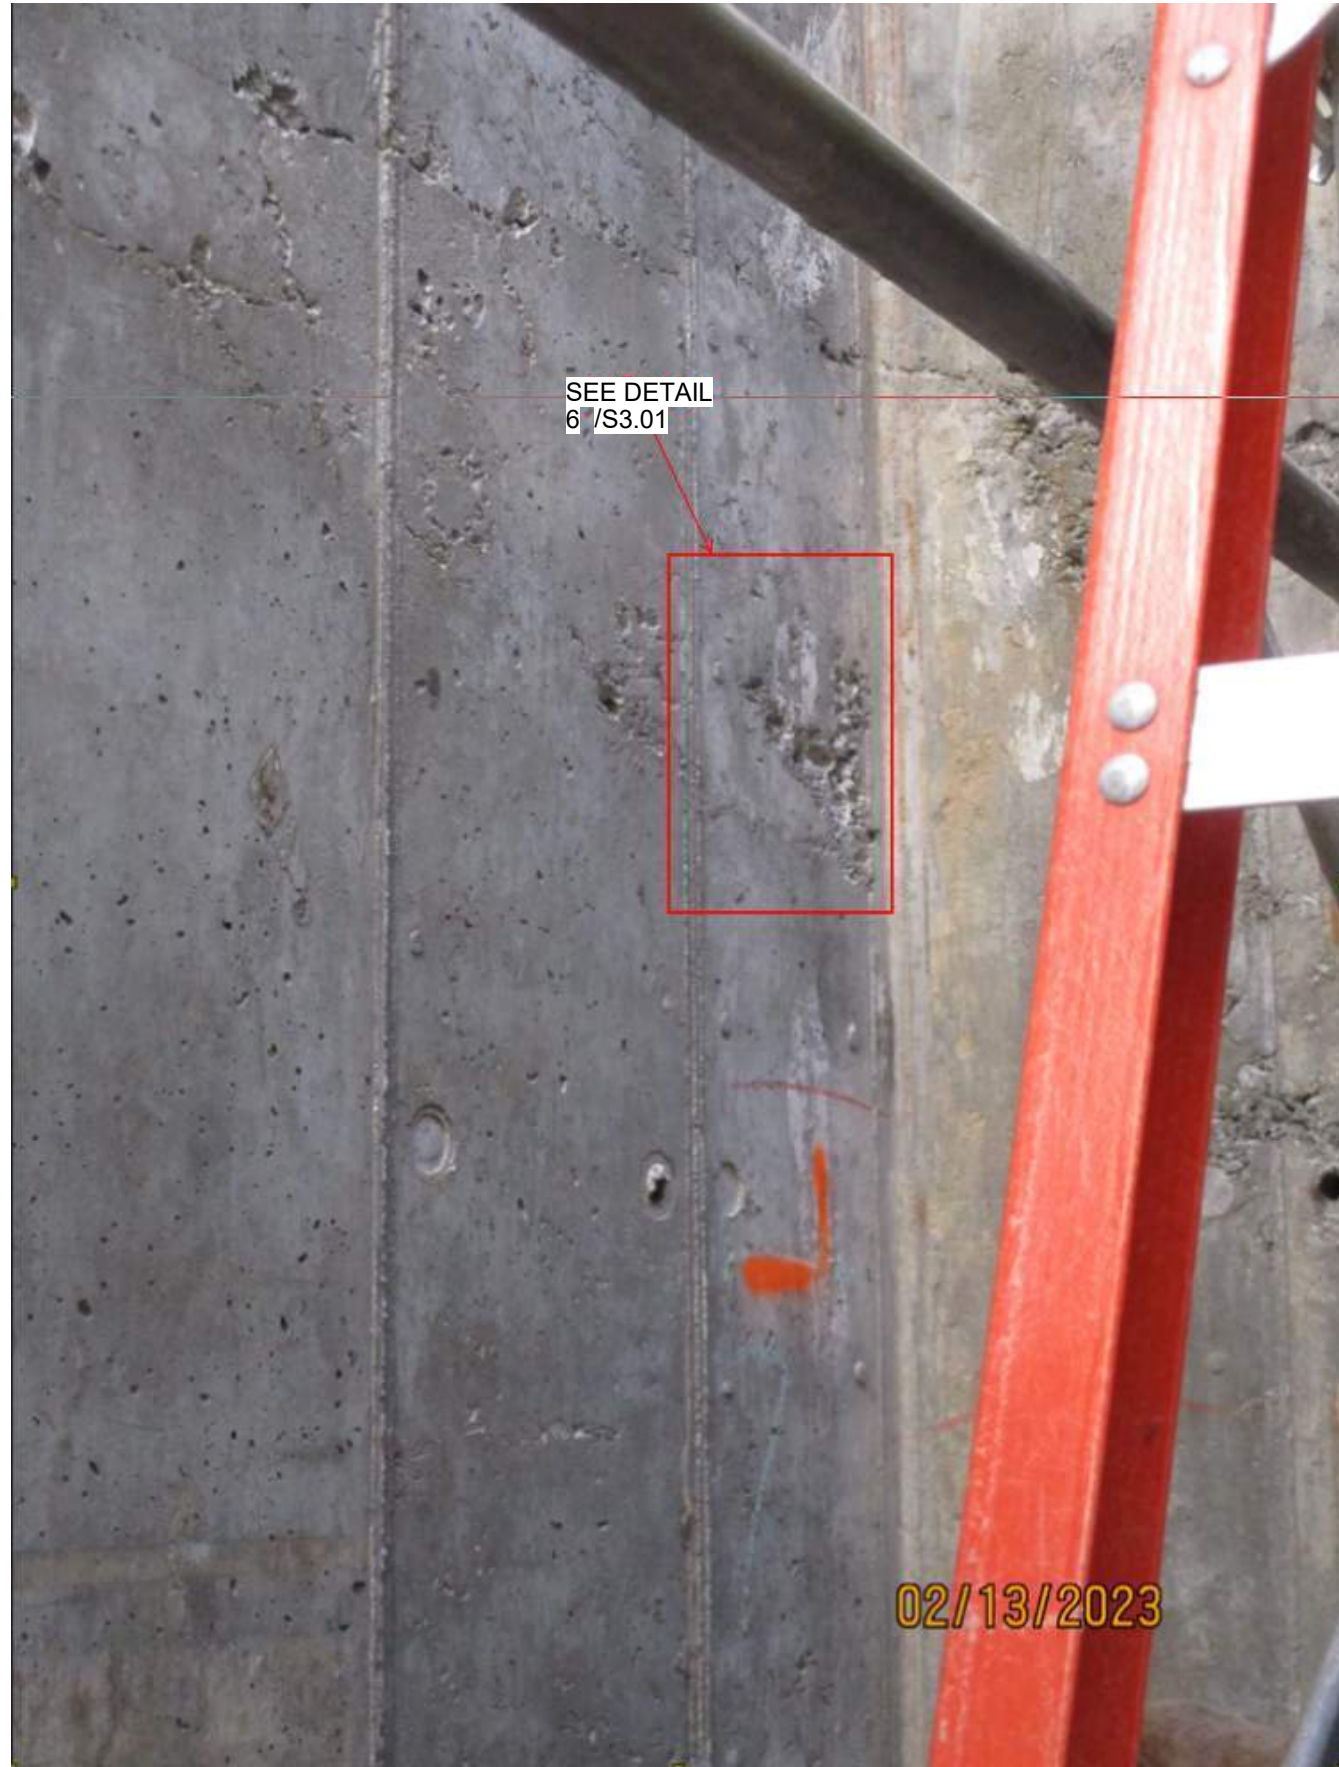

2 PHOTO A

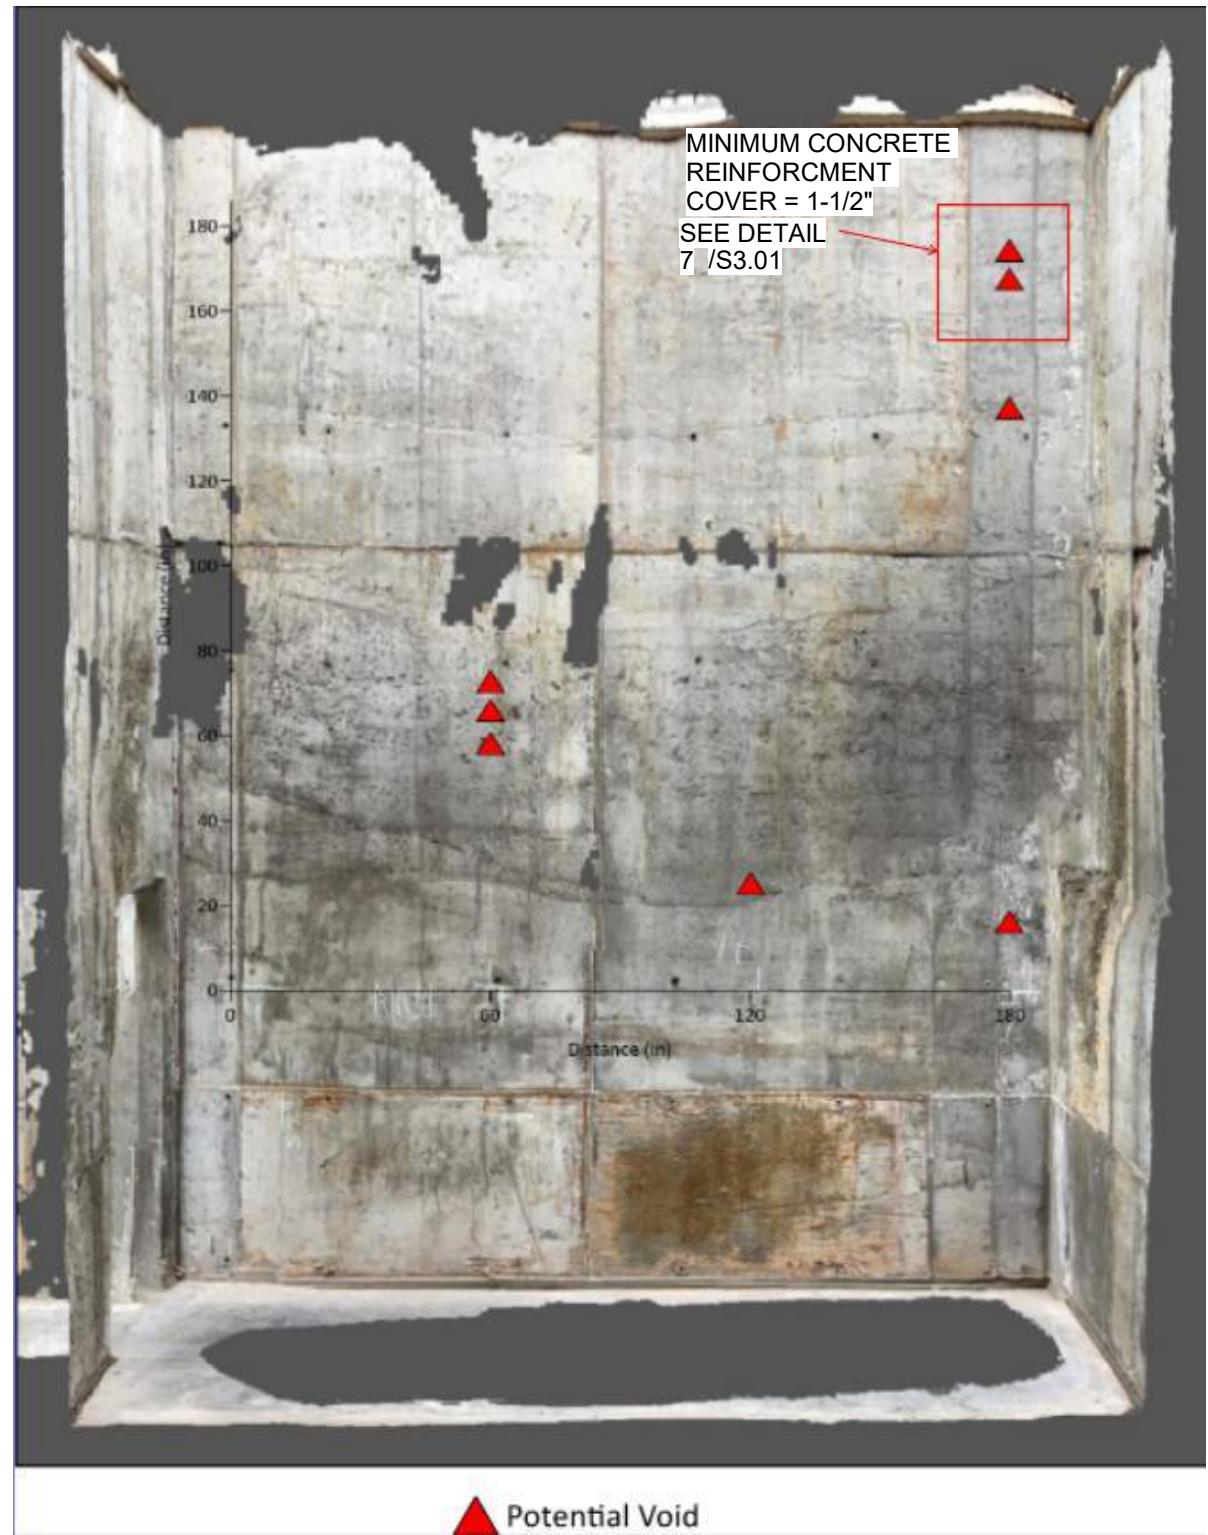

4 PHOTO C
1" = 1'-0"



SHUCK BRITSON

400 E COURT AVE.
SUITE 140.
DES MOINES, IOWA 50309
515-243-4477
www.shuck-britson.com

NEVADA WWTP IMPROVEMENTS LIMITED
CONCRETE WALL REPAIR

BOOMERANG

457 S. 6th STREET NEVADA IOWA 50201

Project Status

PROJECT NUMBER 123.0172.03

DATE 03/24/2023



WALL ELEVATIONS

SHEET NO.

S2.12

3/24/2023 5:11:55 PM

C:\Users\chris\Documents\123.0172.03_STRUCT\R22_chris\S2.12.dwg

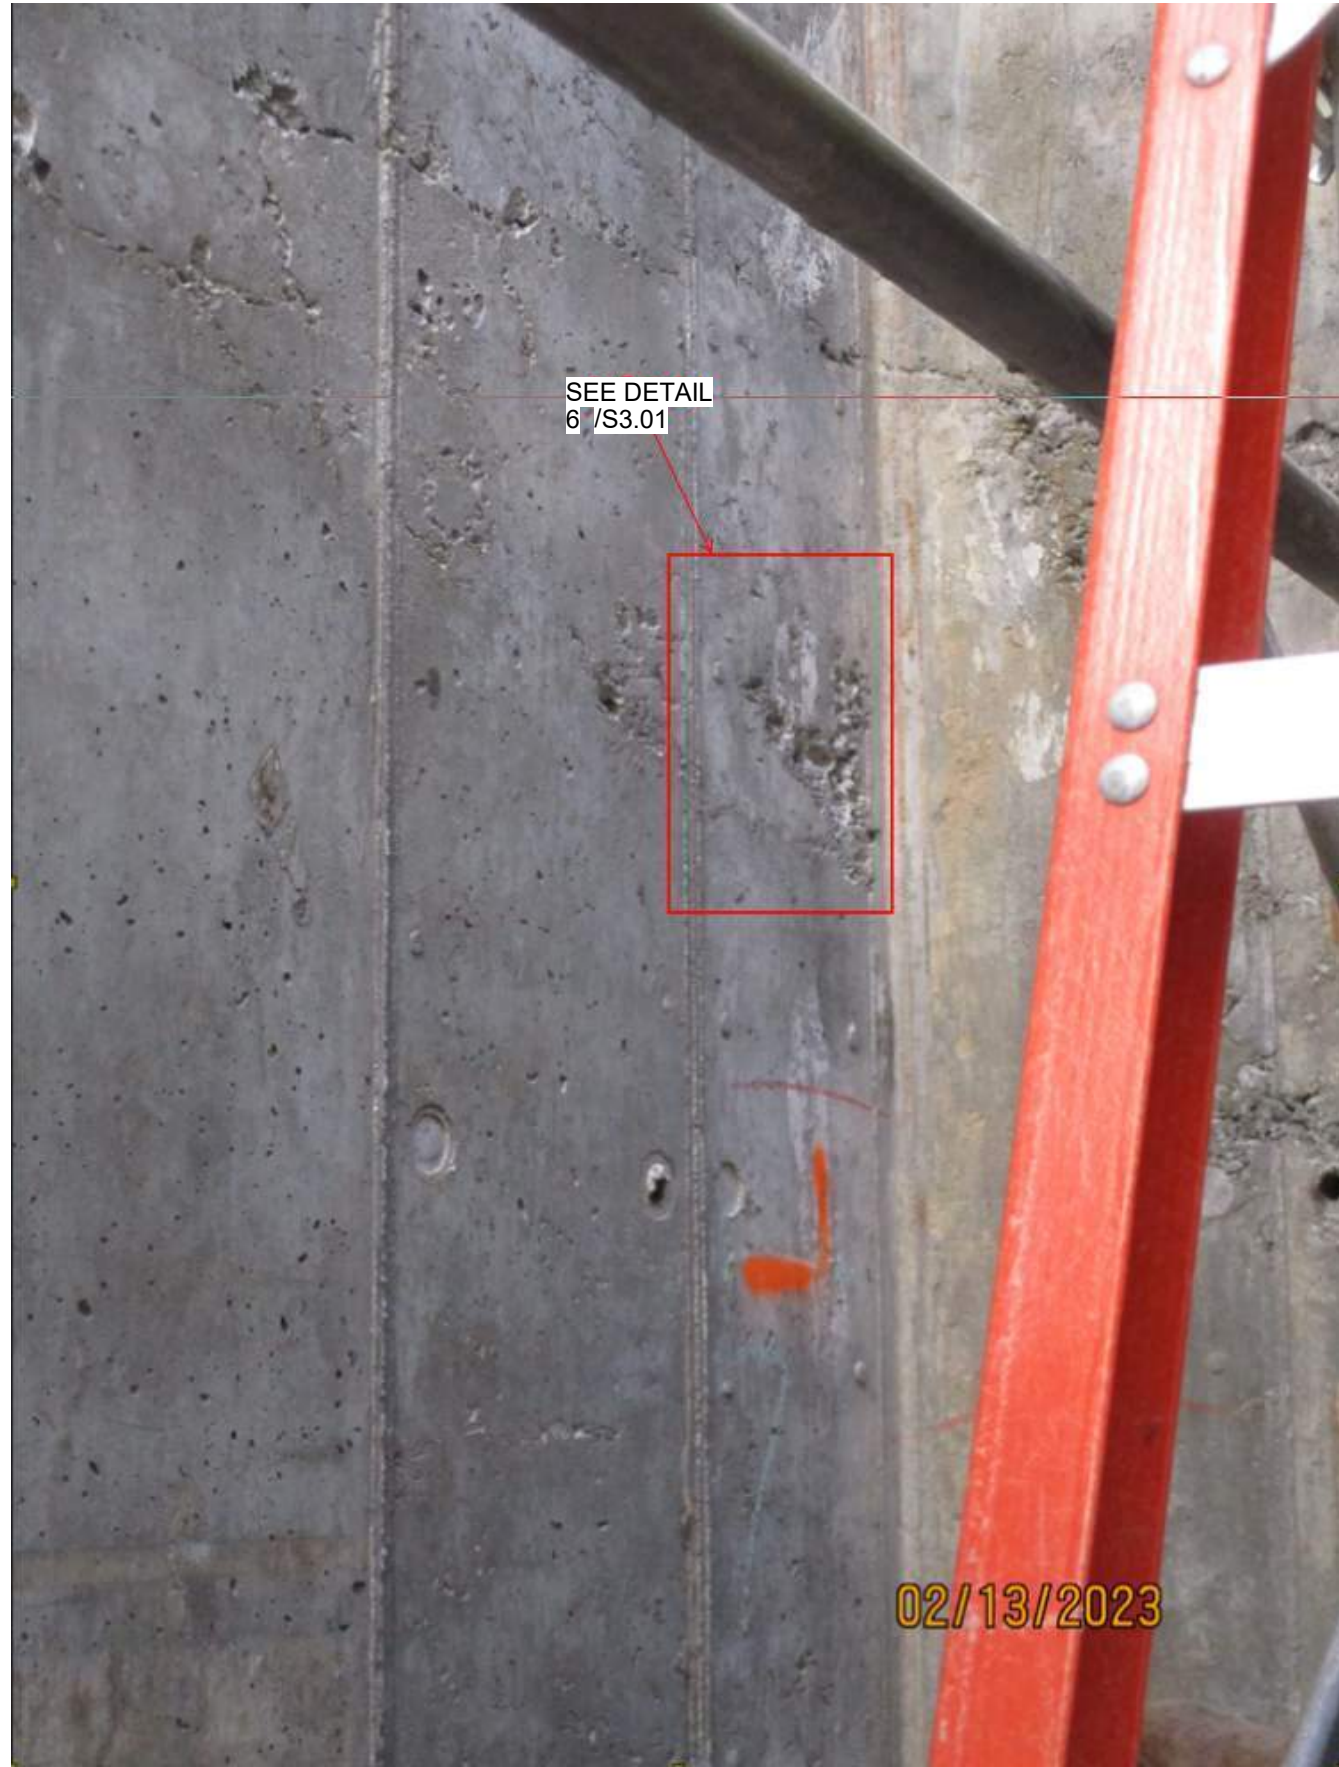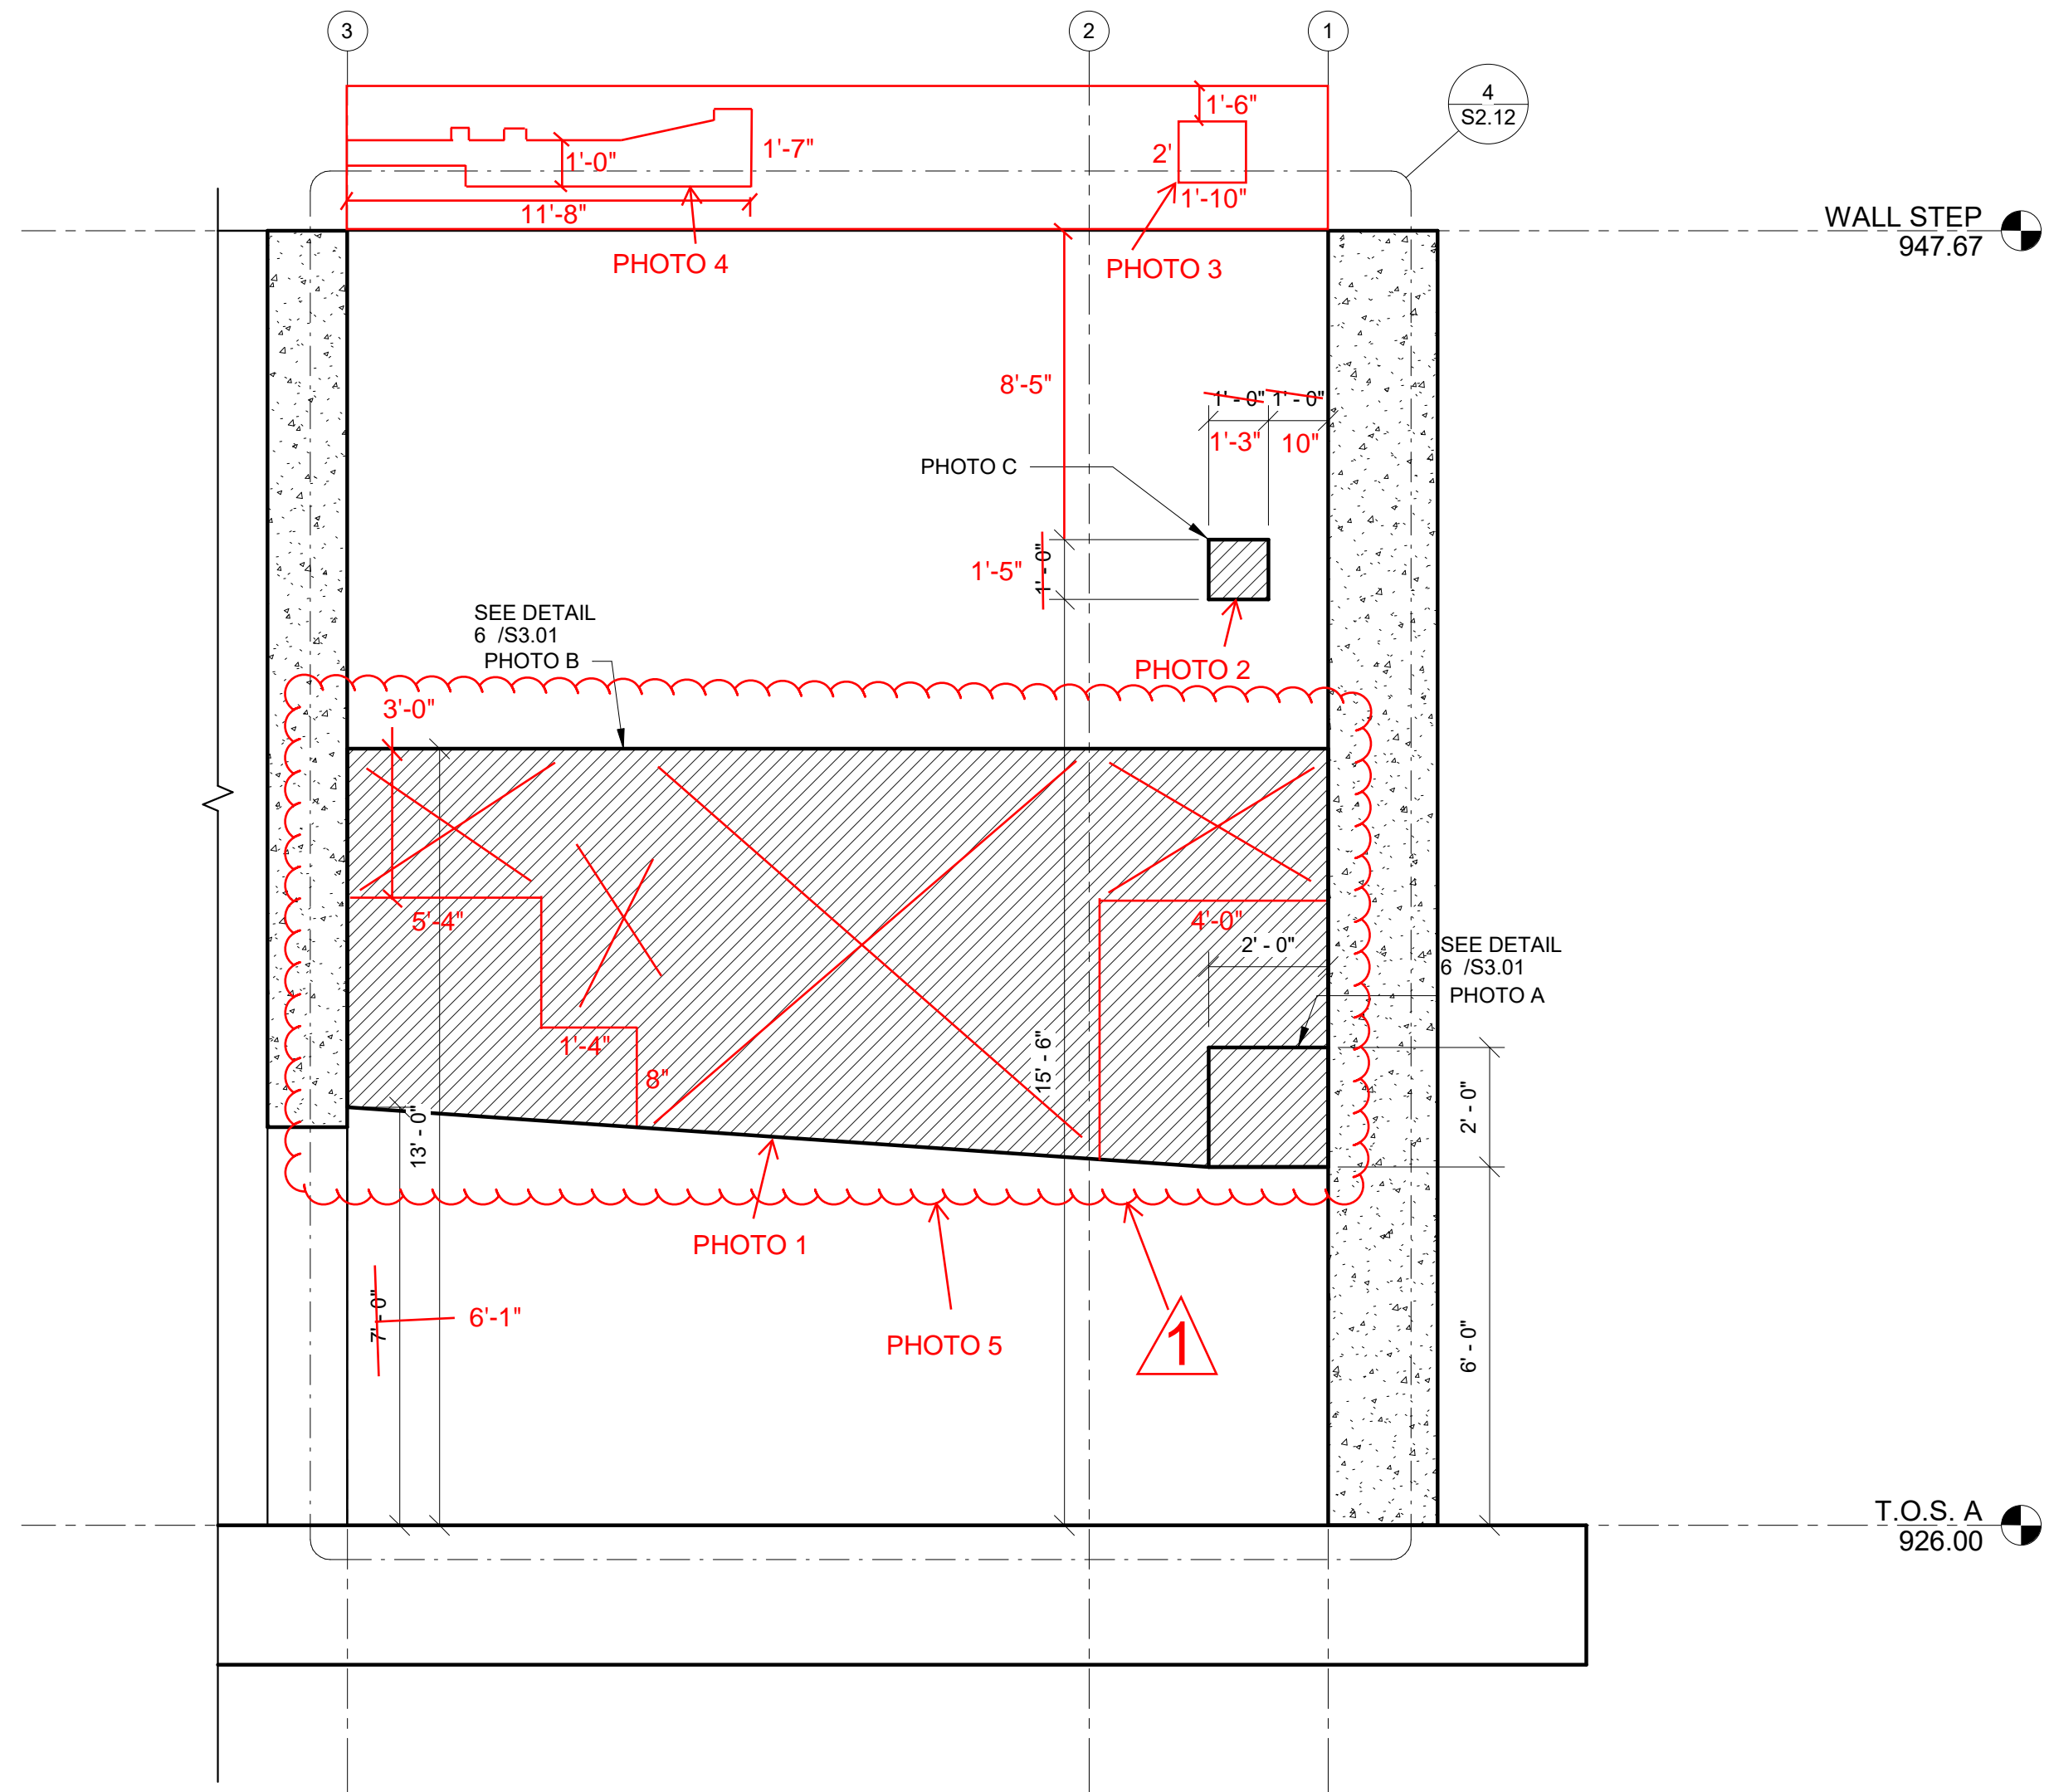

2 PHOTO A

1 REVISION 1: REPAIRED EXISTING REPAIRS


1 INTERIOR ELEVATION
3/8" = 1'-0"

LEGEND:

✗ DENOTES REMOVAL



3 PHOTO B

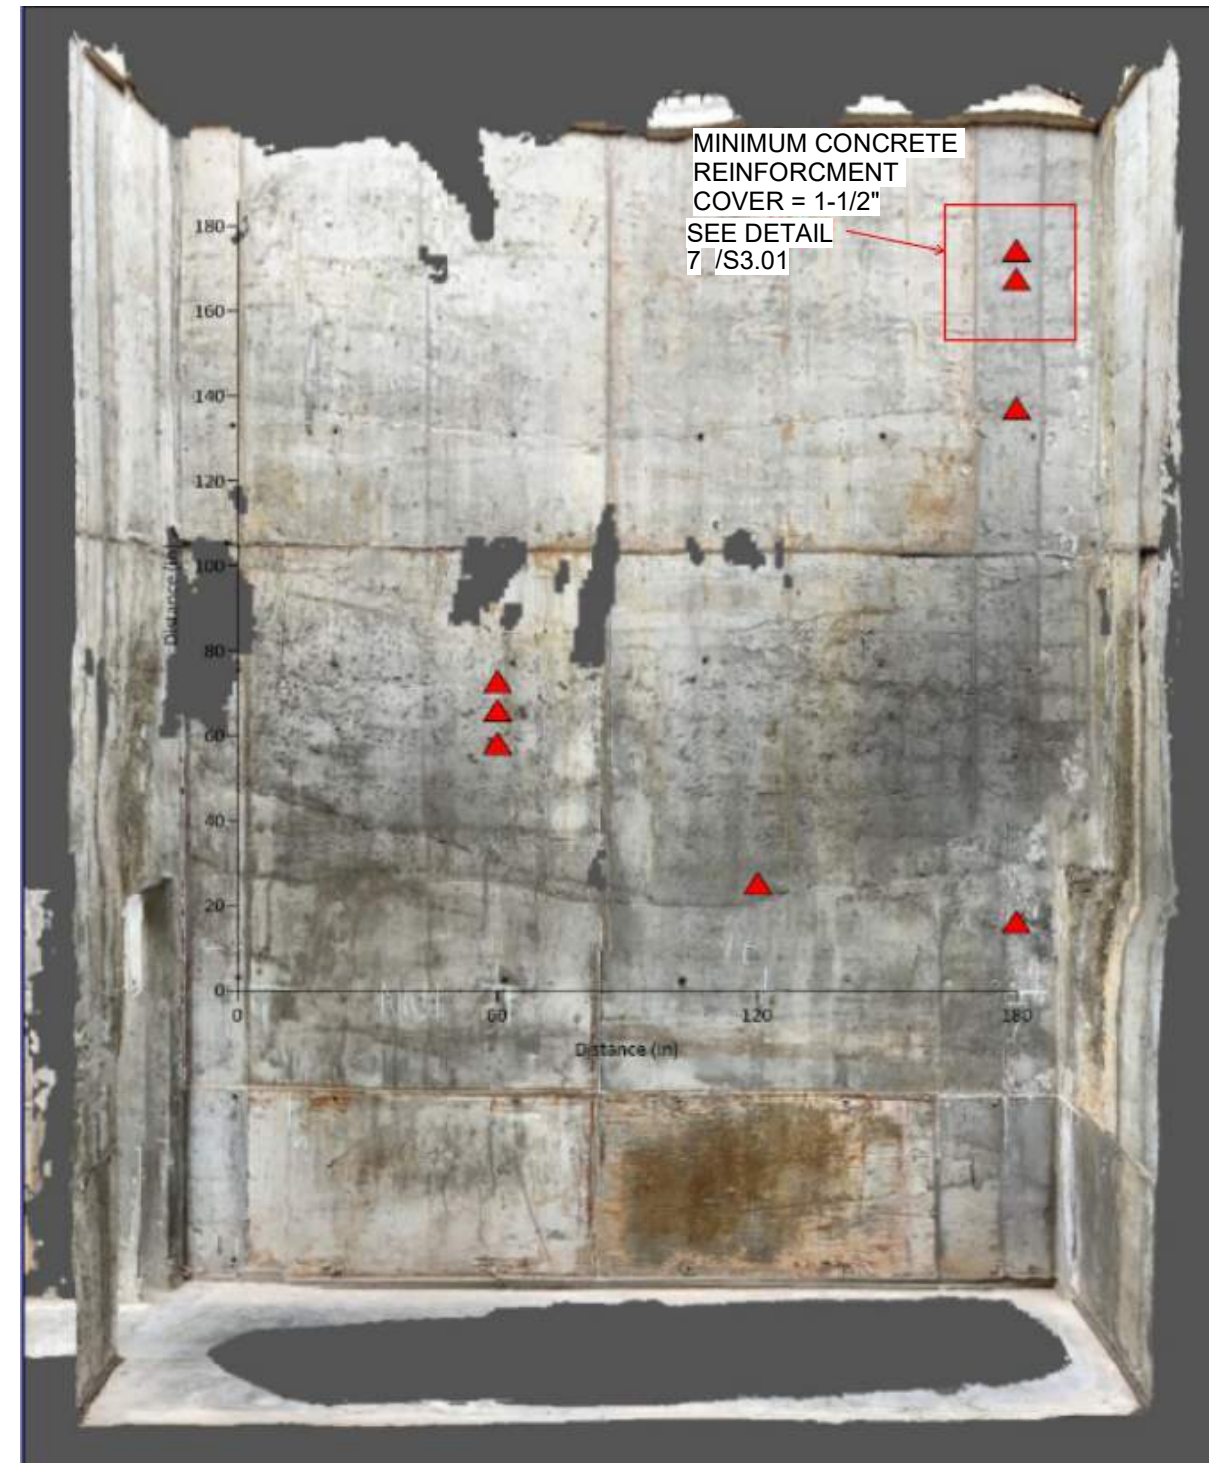

▲ Potential Void

4 PHOTO C
1" = 1'-0"



400 E COURT AVE.
SUITE 140.
DES MOINES, IOWA 50309
515-243-4477
www.shuck-britson.com

NEVADA WWTP IMPROVEMENTS LIMITED
CONCRETE WALL REPAIR

BOOMERANG

457 S. 6th STREET NEVADA IOWA 50201

Project Status

PROJECT NUMBER

123.0172.03

DATE

SHEET TITLE

03/24/2023

WALL ELEVATIONS

SHEET NO.

S2.12



Before Repair



Before Repair



After Repair

PHOTO 1



Before Repair



After Repair

PHOTO 2



Before Repair



After Repair

PHOTO 3



Before Repair



Before Repair



Before Repair

PHOTO 4



After Repair



After Repair

PHOTO 4



Before Repair




Before Repair




After Repair

PHOTO 5

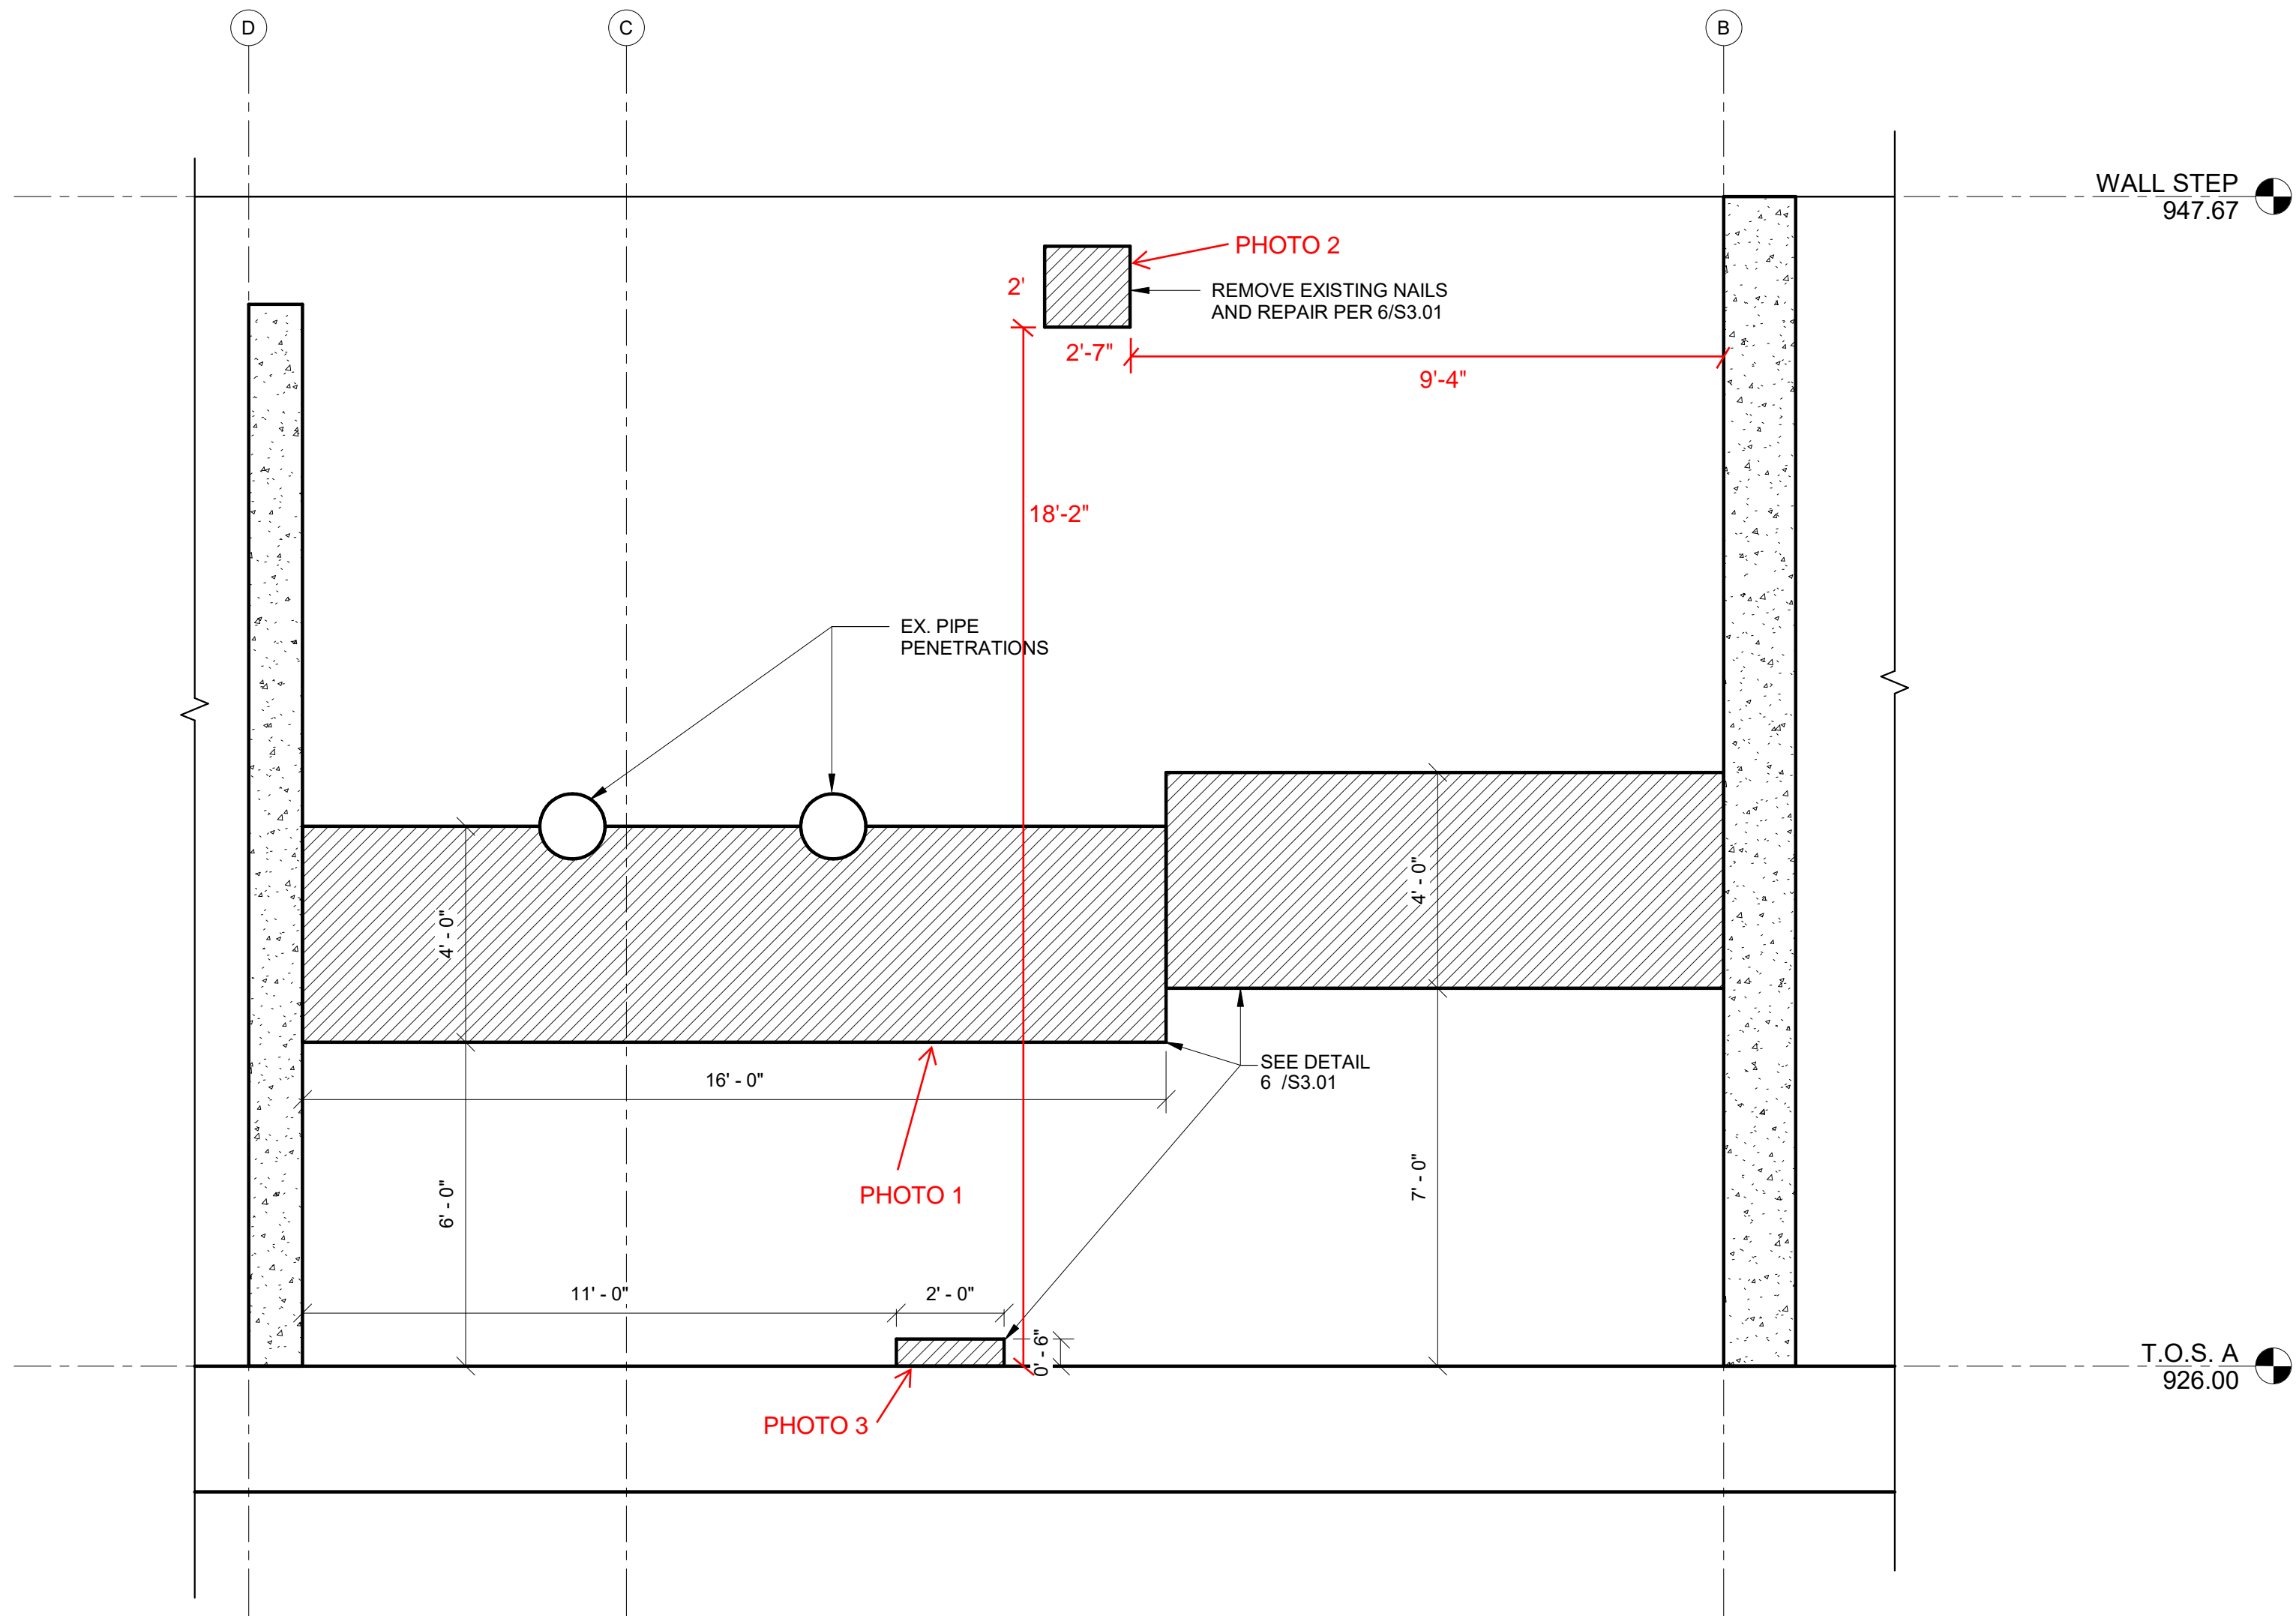

1 INTERIOR ELEVATION
3/8" = 1'-0"

ORIGINAL REPAIRS

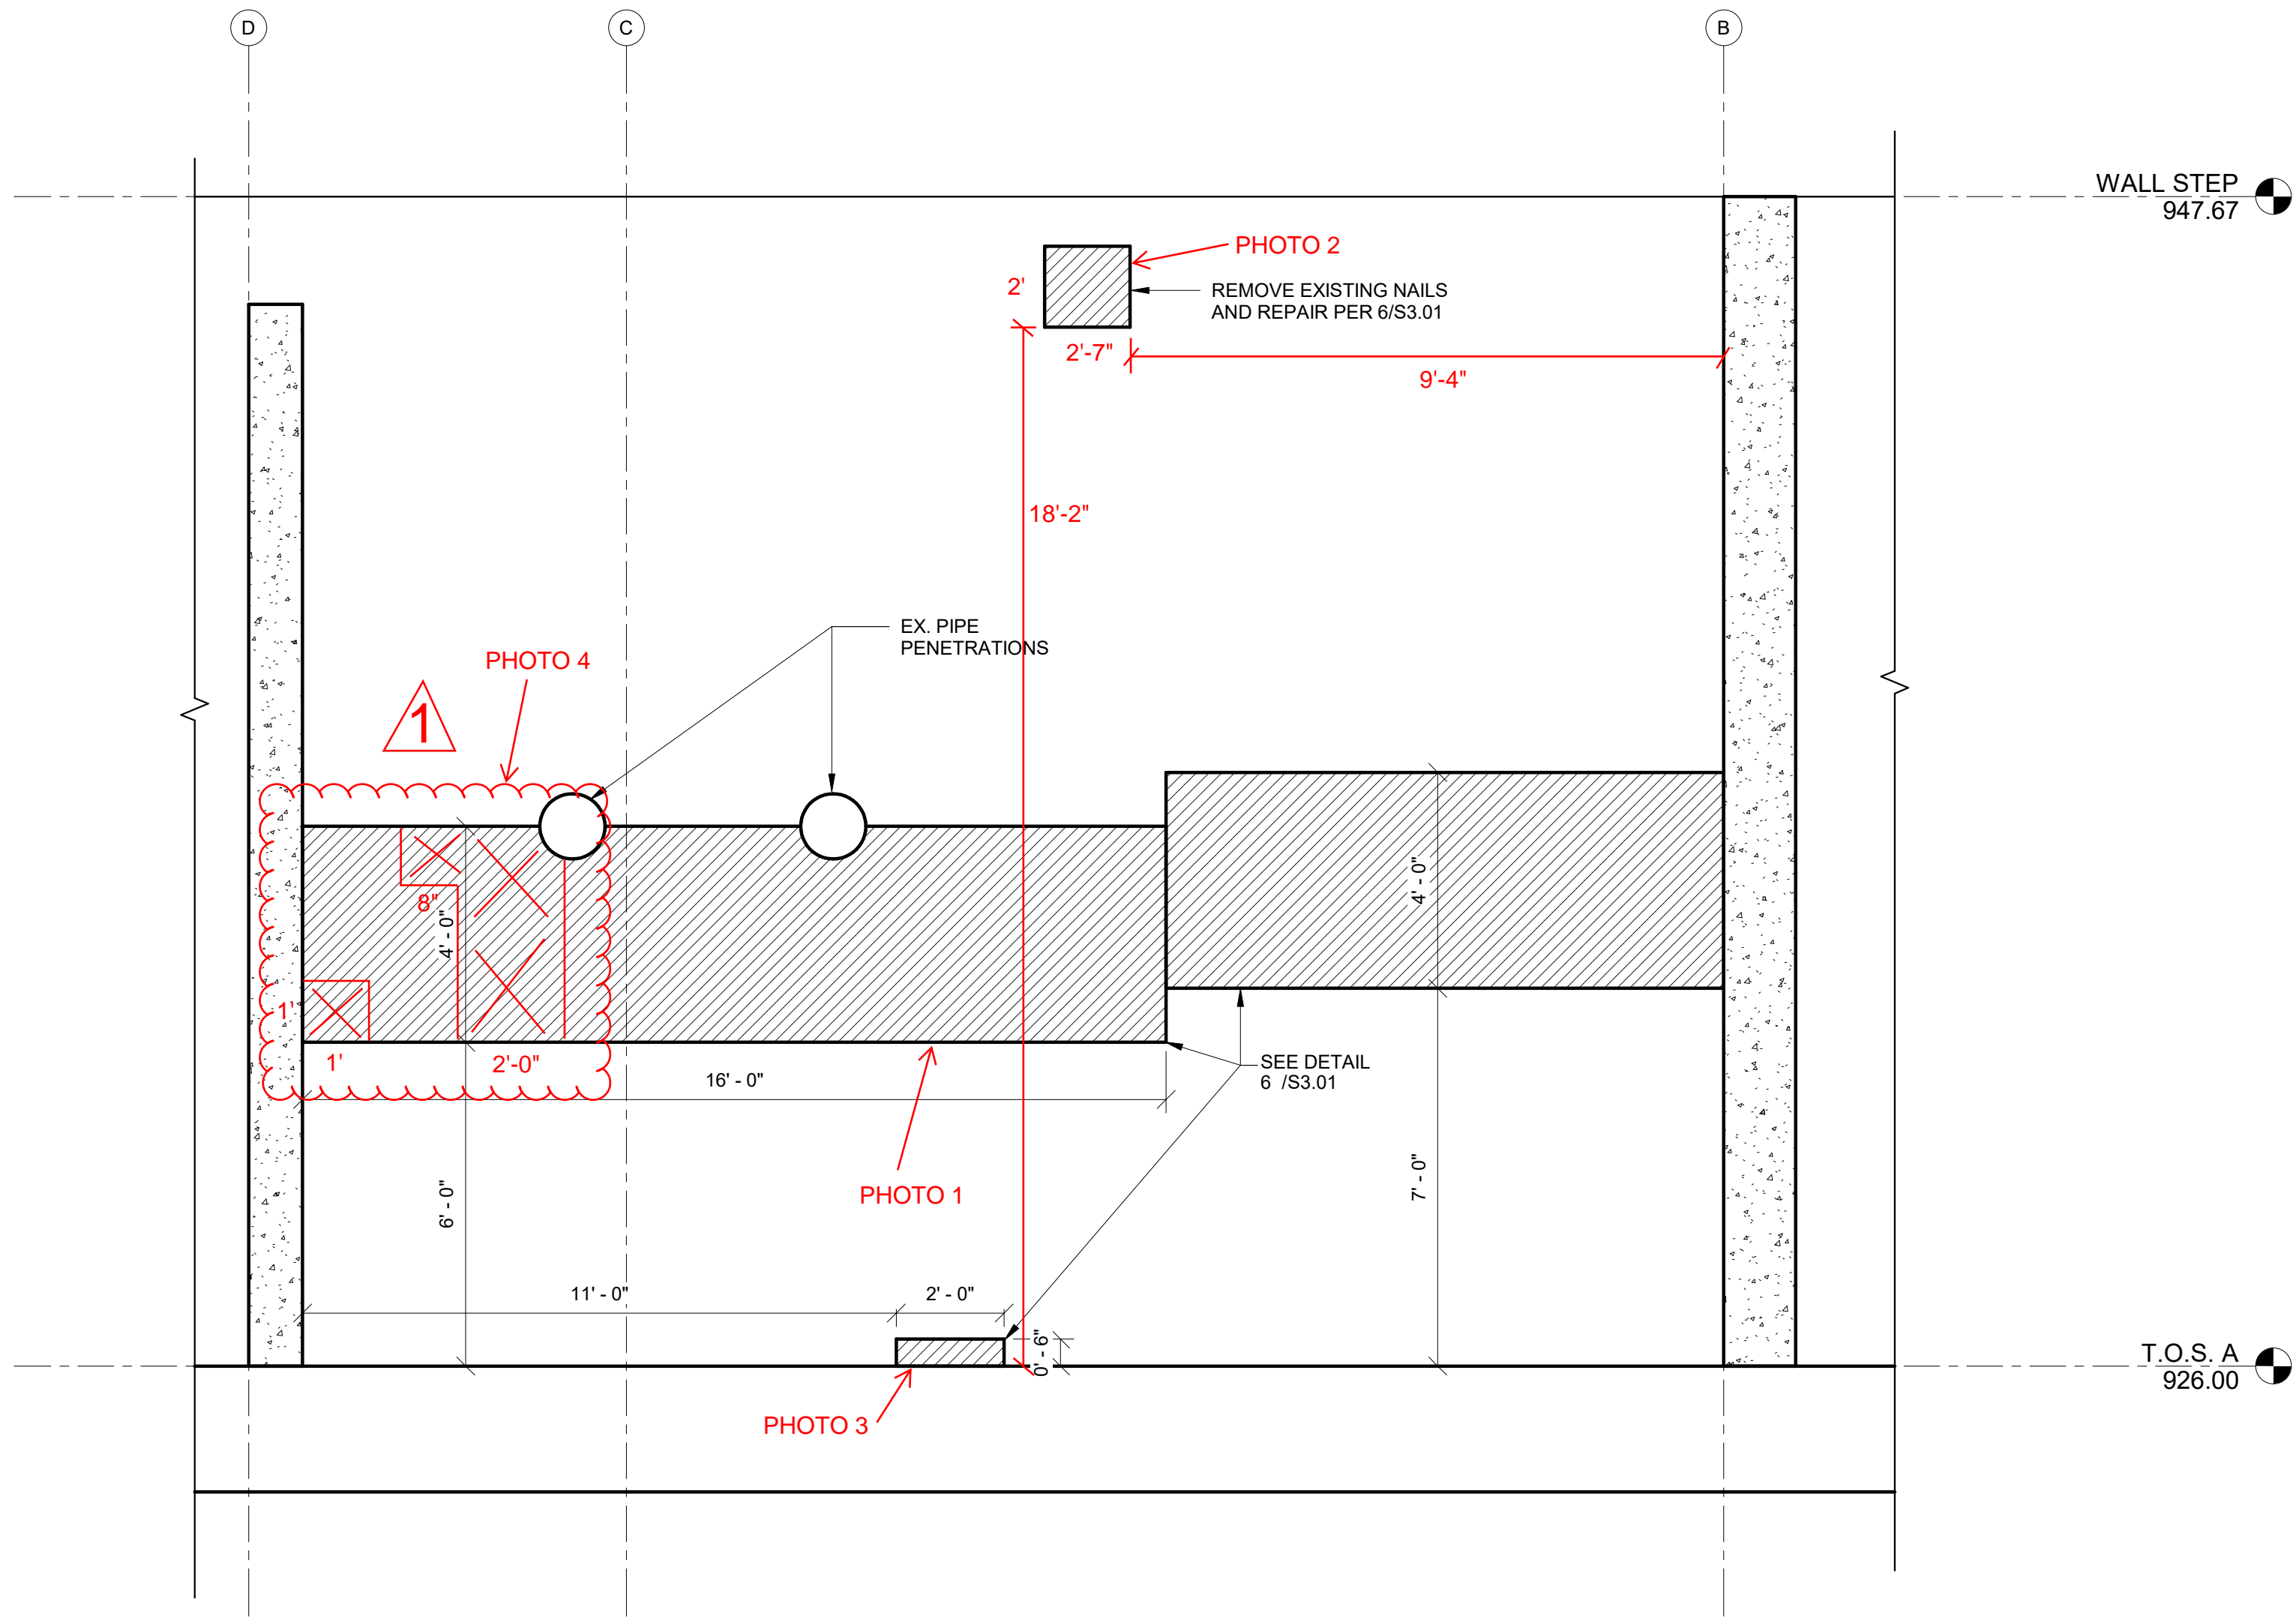

1 INTERIOR ELEVATION
3/8" = 1'-0"

1 REVISION 1: REPAIRED EXISTING REPAIRS

LEGEND:
X DENOTES REMOVAL



Before Repair



After Repair




After Repair

PHOTO 1



After Repair

PHOTO 1

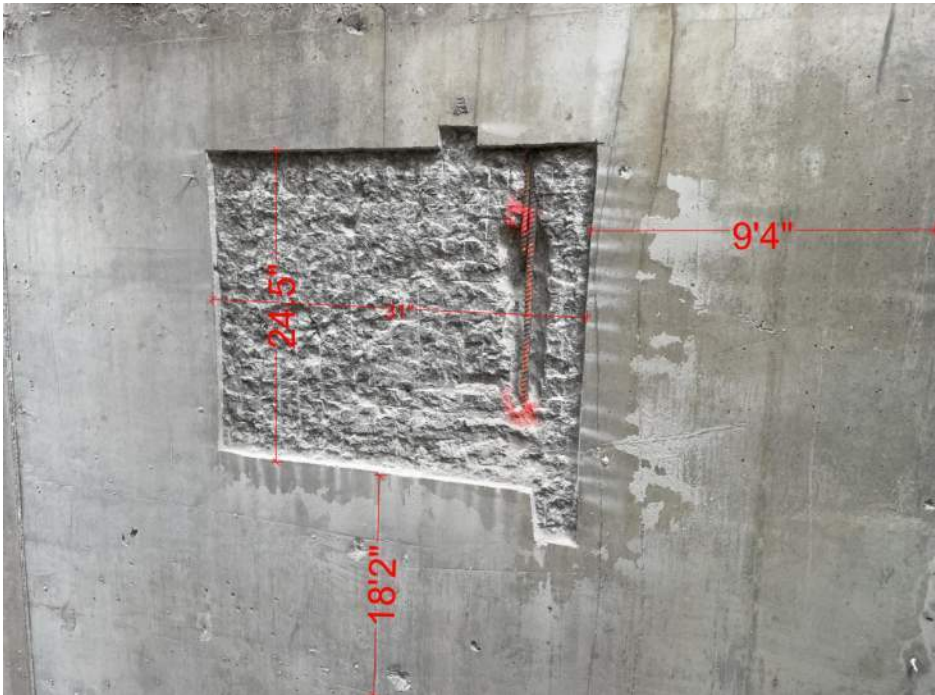

Before Repair



After Repair

PHOTO 2



Before Repair



After Repair

PHOTO 3





Before Repair



After Repair

PHOTO 4



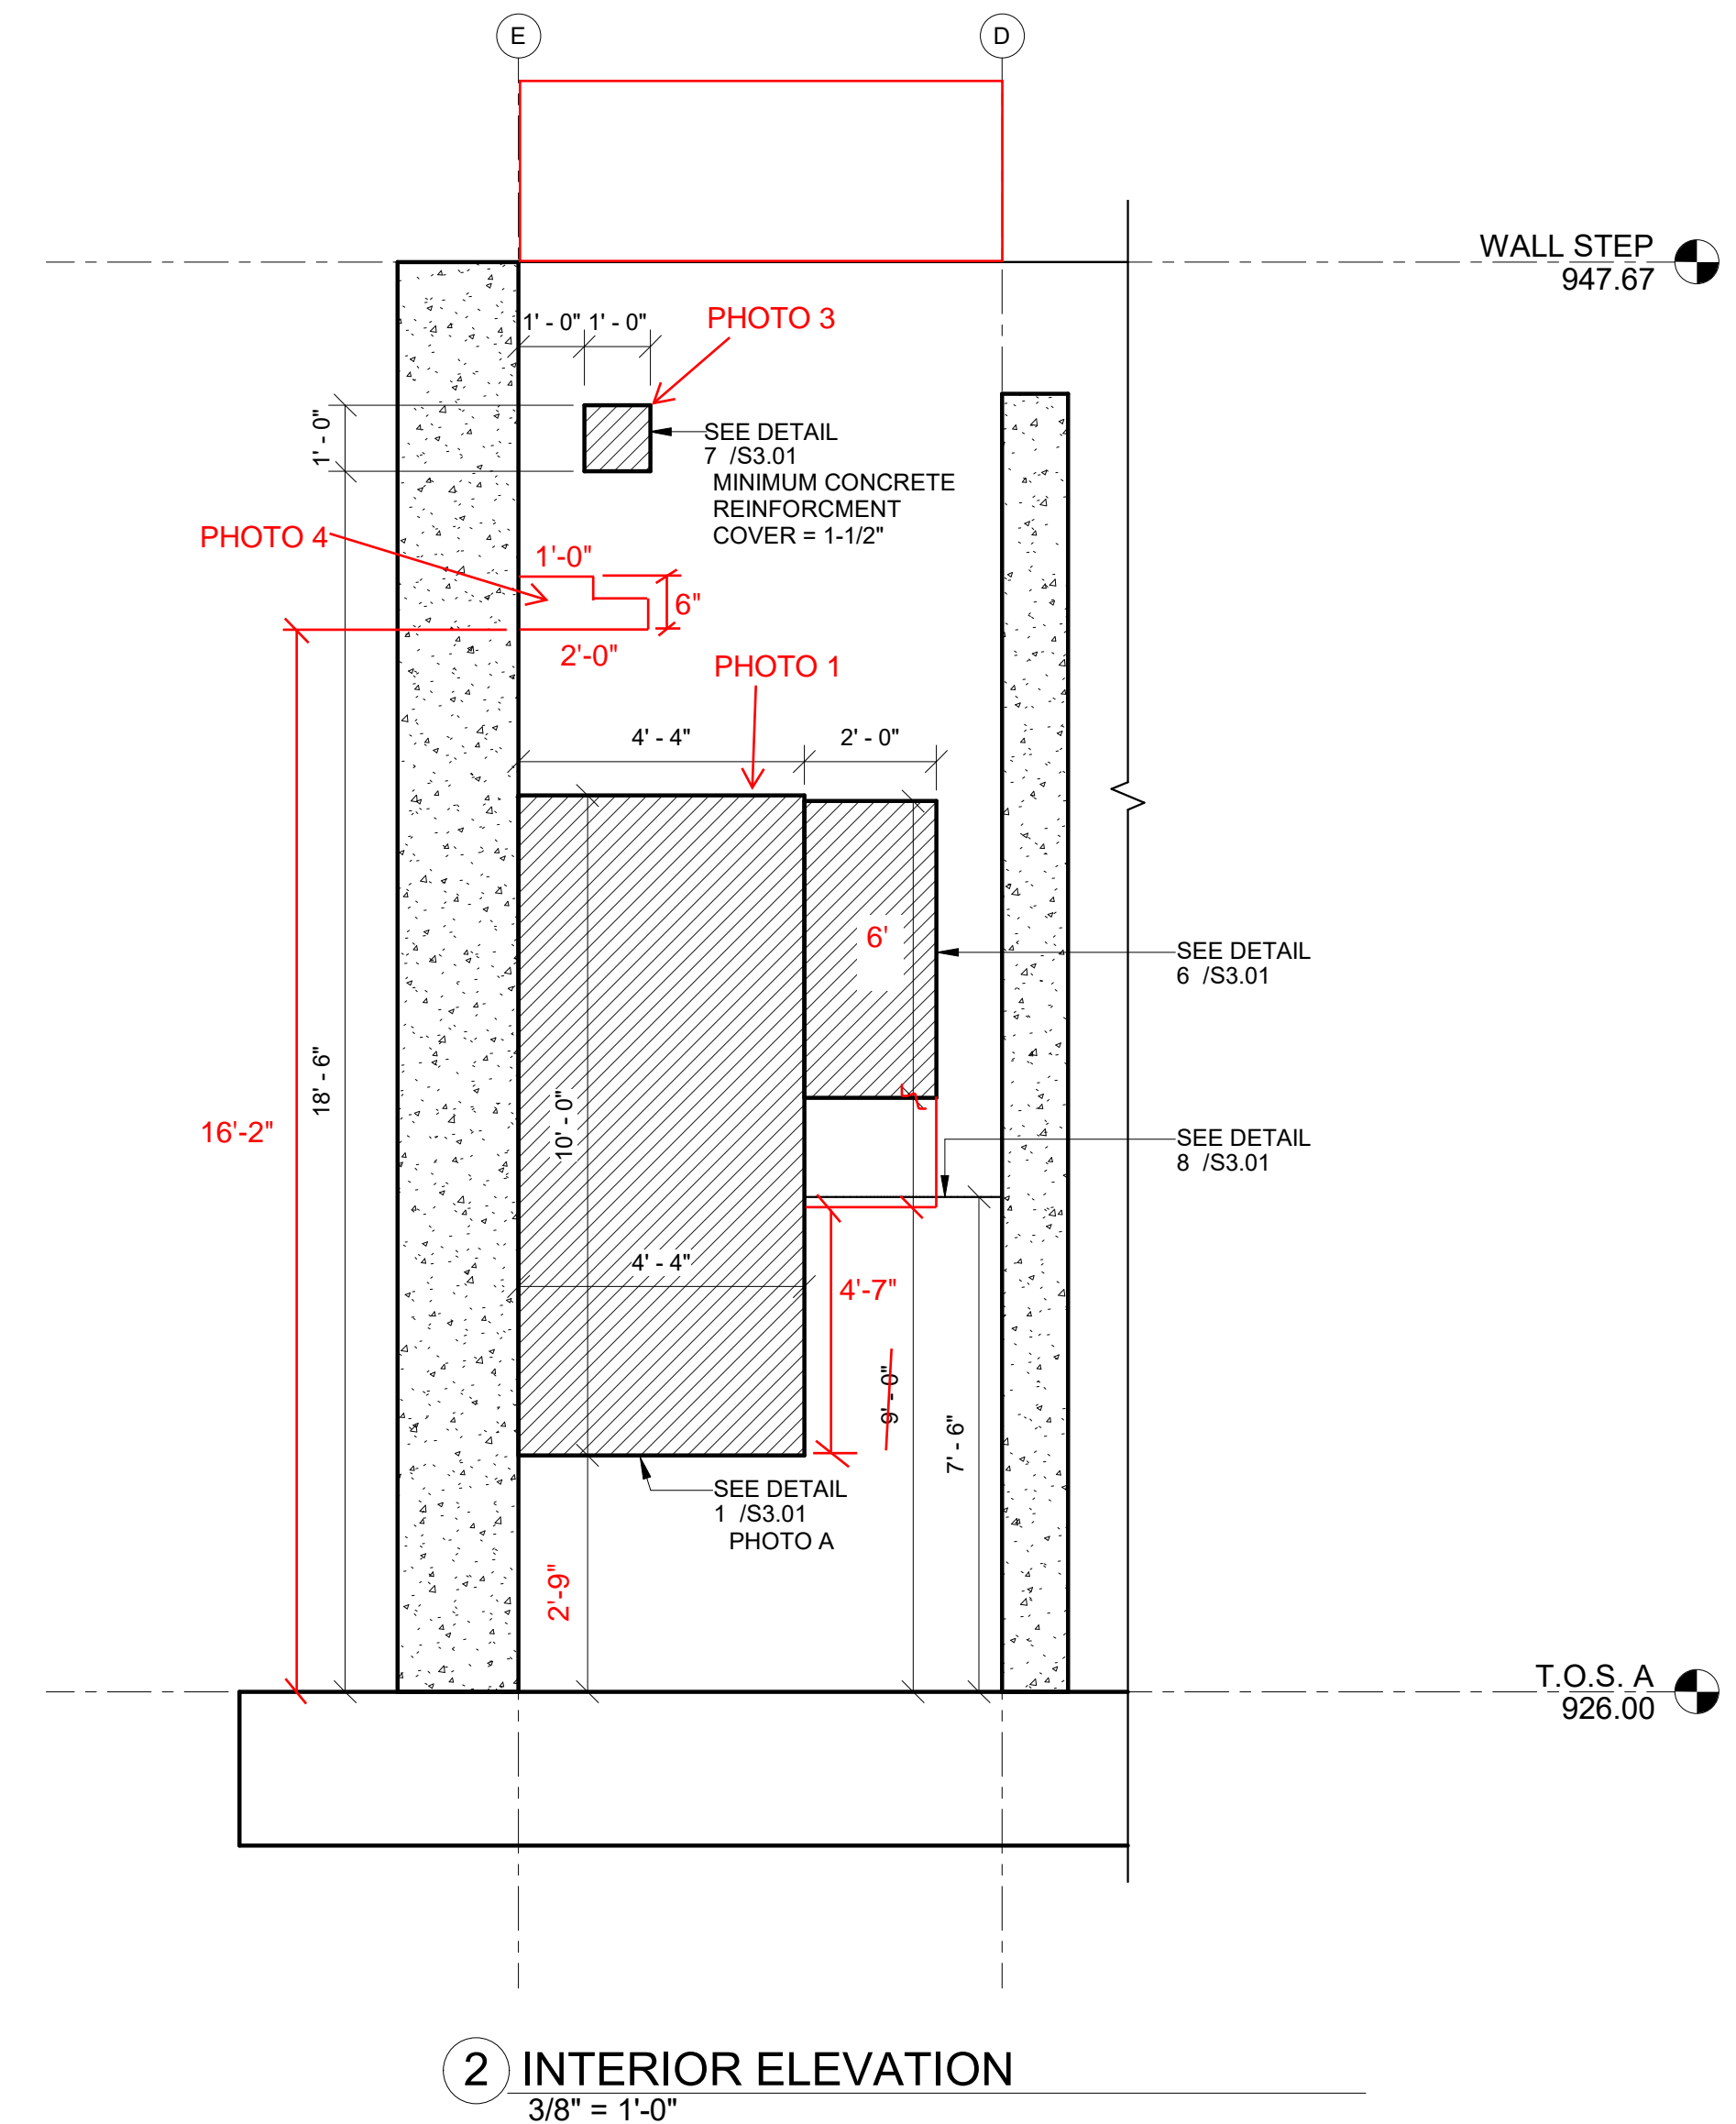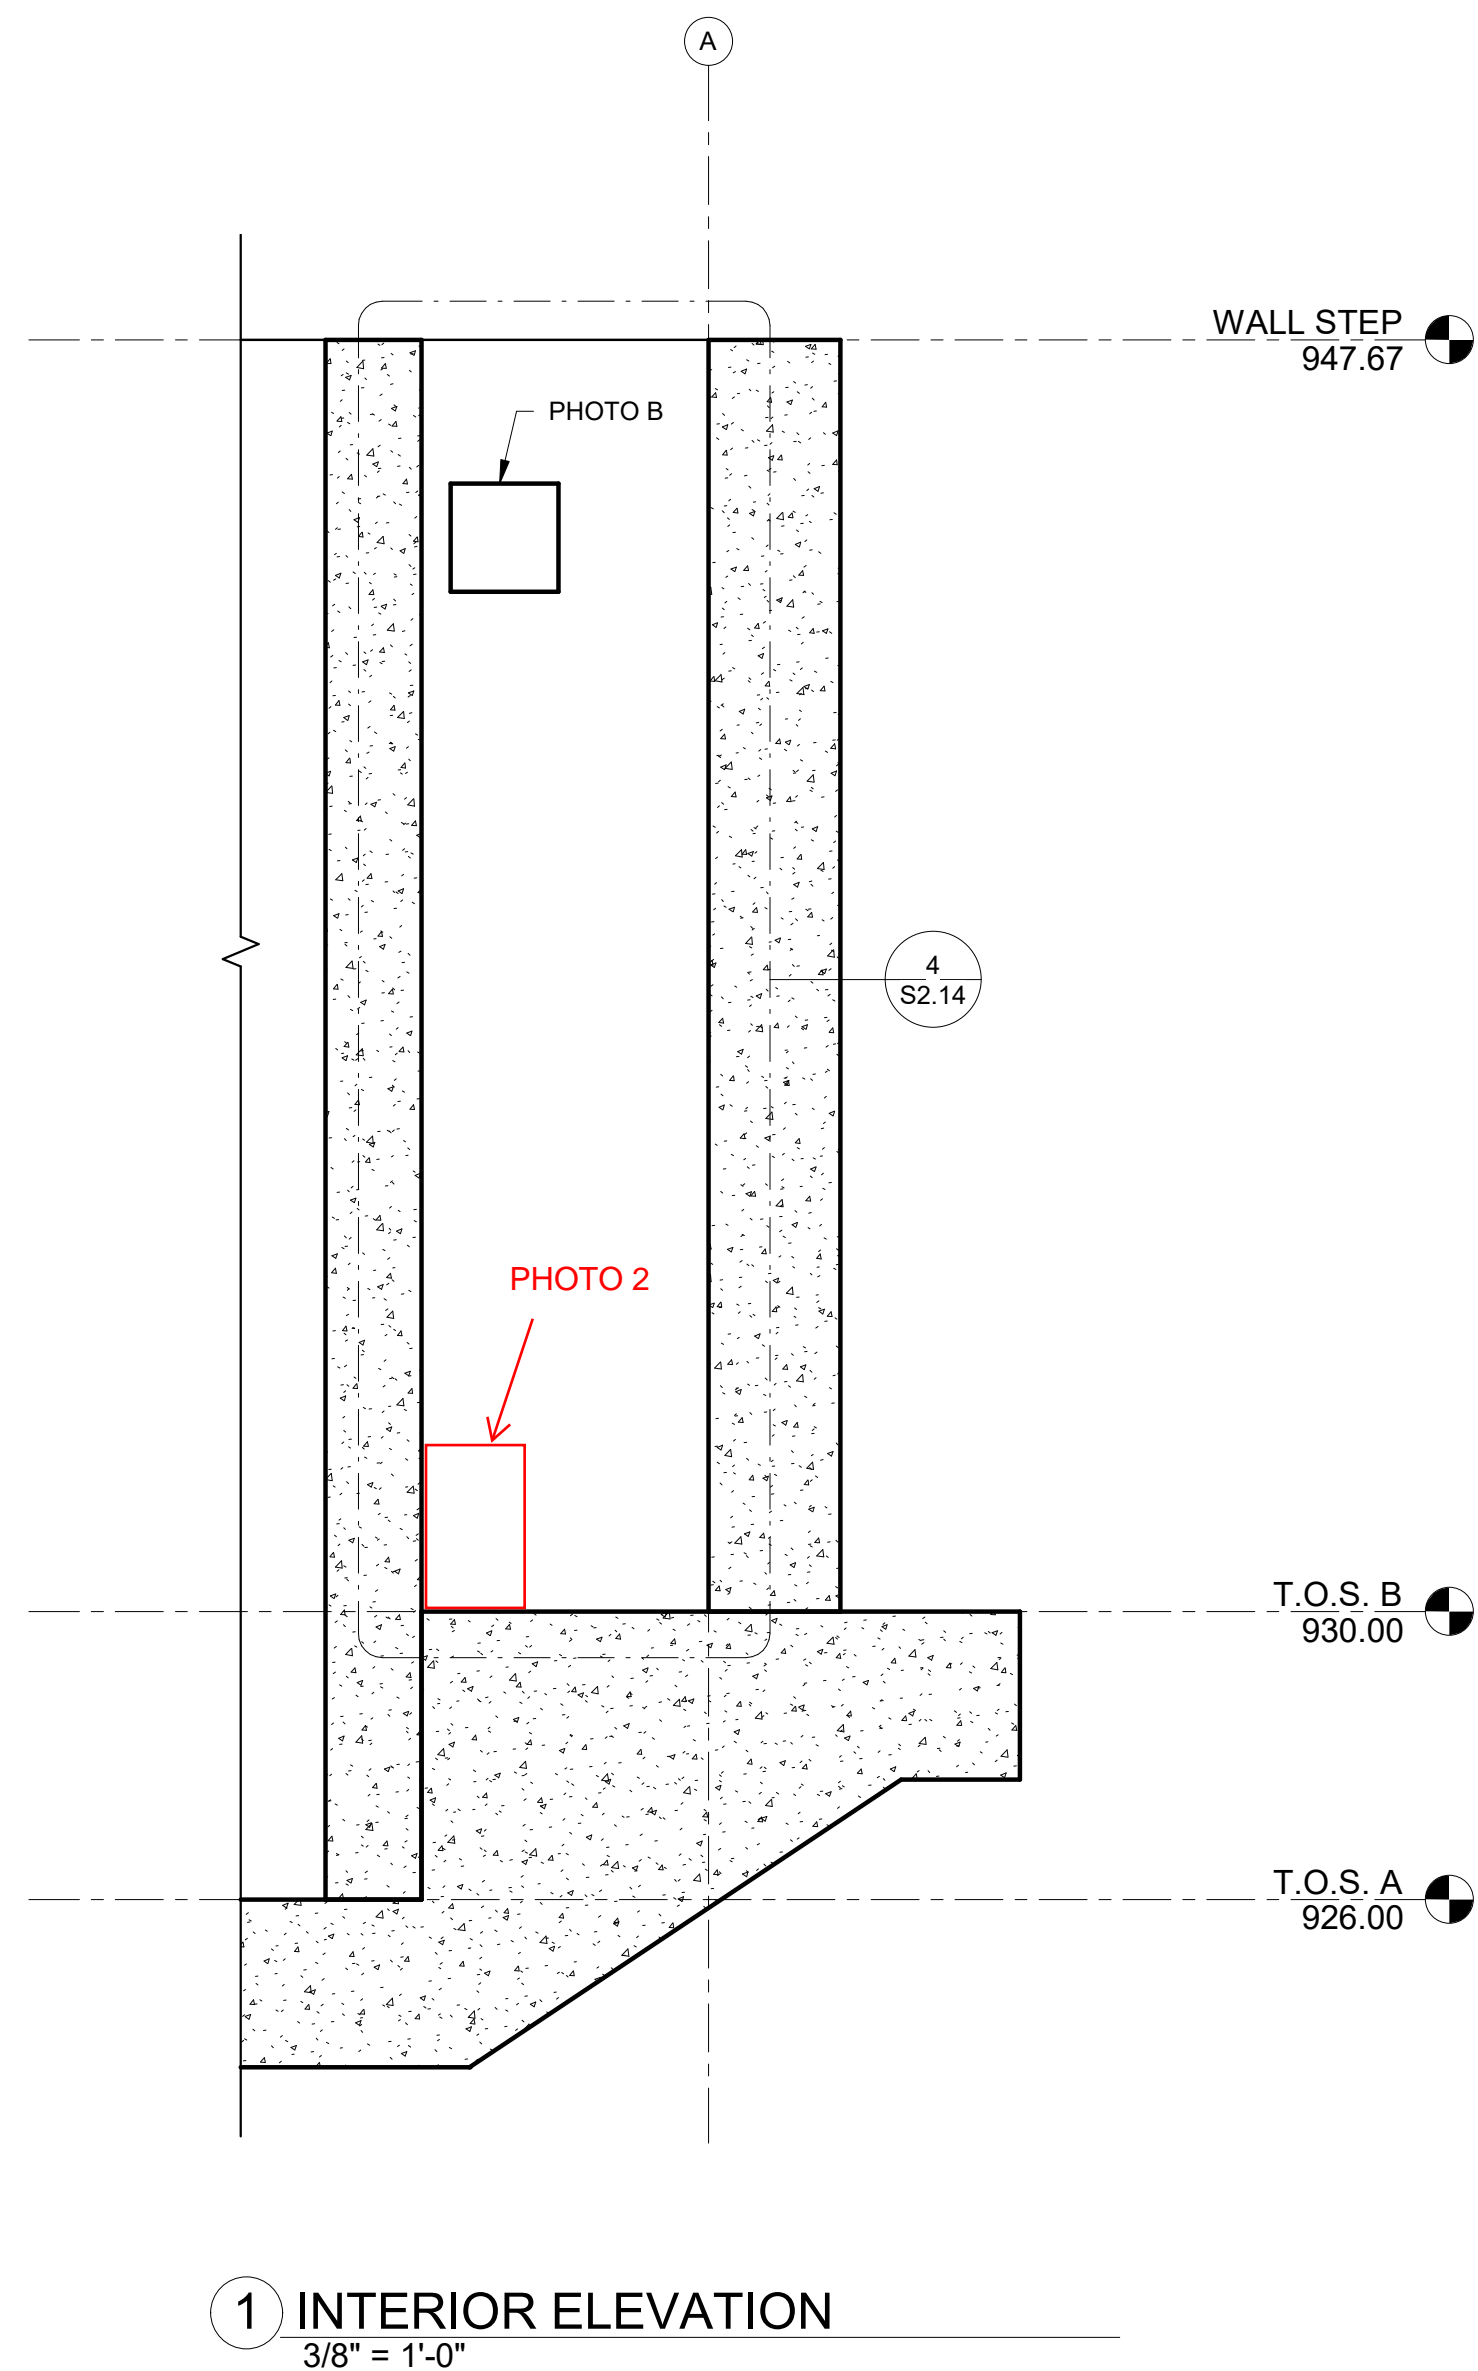

400 E COURT AVE.
SUITE 140.
DES MOINES, IOWA 50309
515-243-4477
www.shuck-britson.com

NEVADA WWTP IMPROVEMENTS LIMITED
CONCRETE WALL REPAIR
BOOMERANG

457 S. 6th STREET | NEVADA IOWA 50201

Project Status

PROJECT NUMBER	123.0172.00
----------------	-------------

03/24/2025

ALL ELEVATIONS

SHEET NO. _____

S2.14



Before Repair



After Repair

PHOTO 1



Before Repair



After Repair

PHOTO 2




Before Repair



After Repair

PHOTO 3

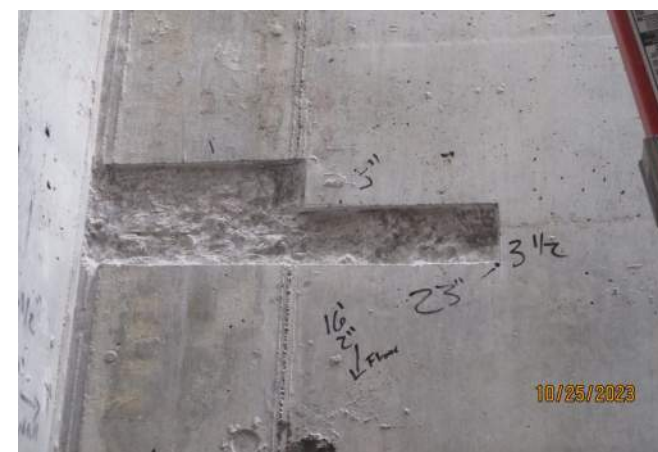


Before Repair



After Repair

PHOTO 4

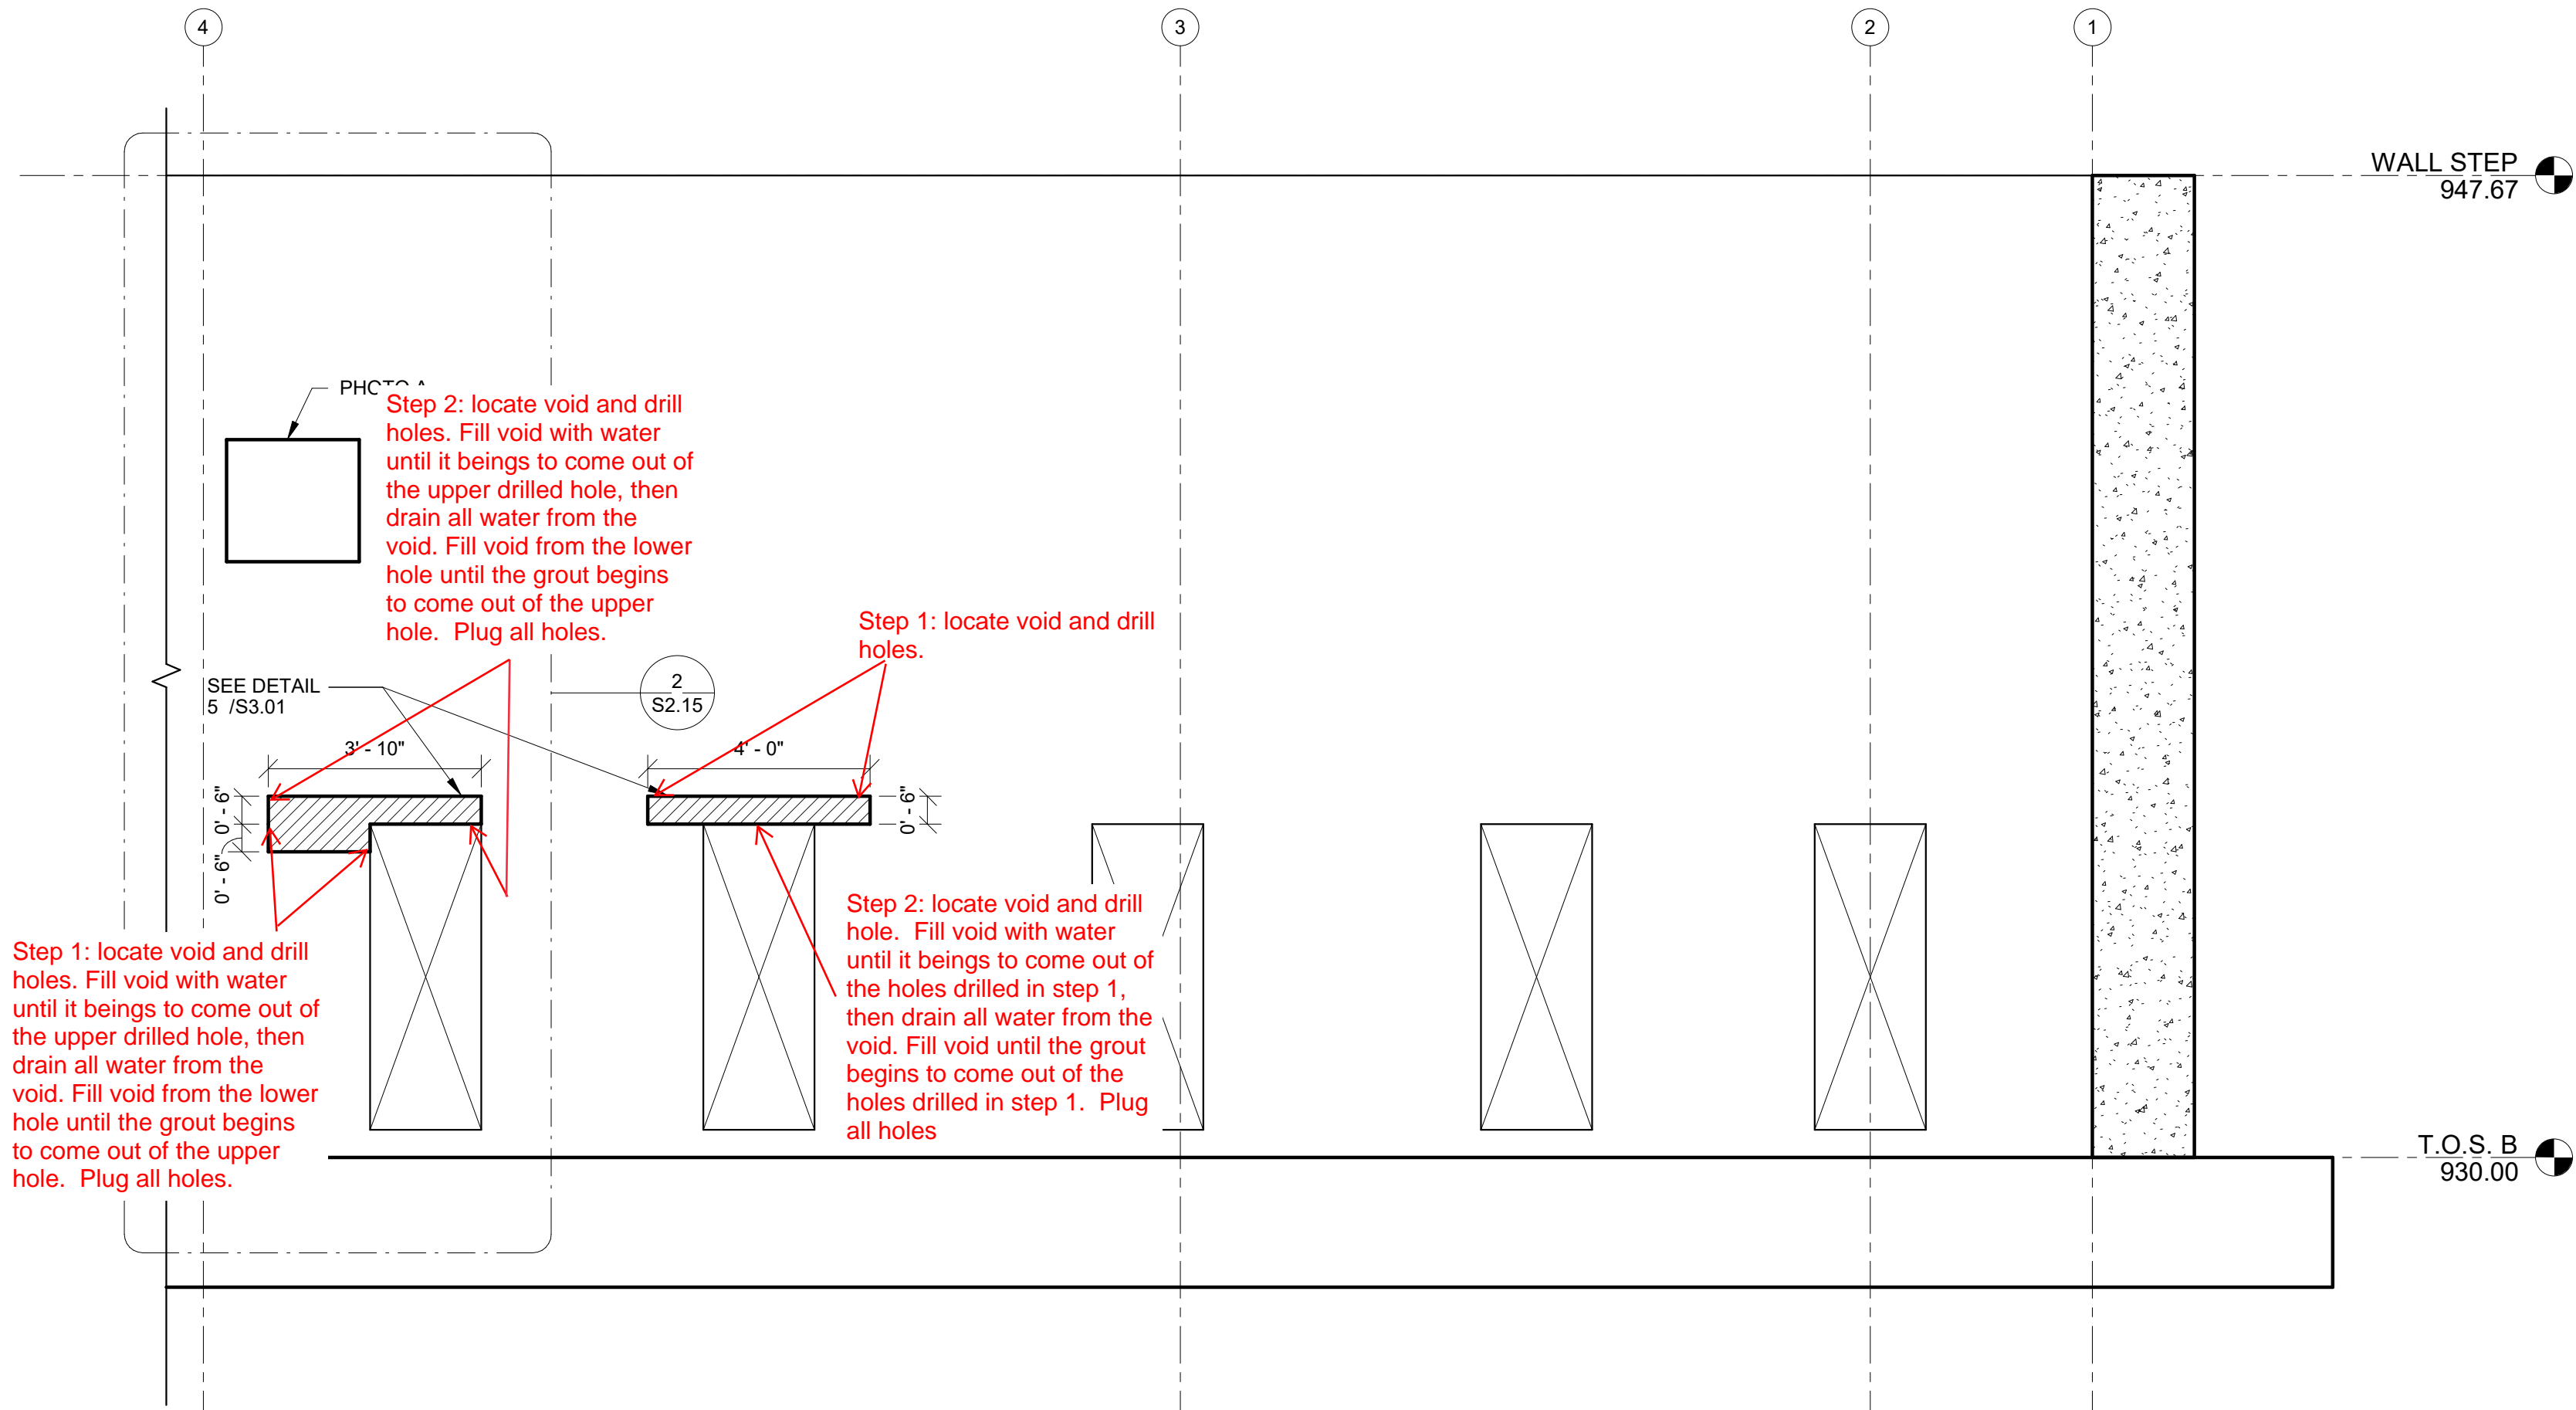

1 EXTERIOR ELEVATION
3/8" = 1'-0"



2 PHOTO A
1" = 1'-0"



SHUCK BRITSON

400 E COURT AVE.
SUITE 140.
DES MOINES, IOWA 50309
515-243-4477
www.shuck-britson.com

NEVADA WWTP IMPROVEMENTS LIMITED

CONCRETE WALL REPAIR

BOOMERANG

457 S. 6th STREET NEVADA IOWA 50201

Project Status

PROJECT NUMBER 123.0172.03

DATE 03/24/2023

SHEET TITLE
WALL ELEVATIONS

SHEET NO.

S2.15



Before Repair



After Repair

PHOTO 1



Before Repair



After Repair

PHOTO 2



Before Repair



Before Repair



After Repair




After Repair



After Repair

PHOTO 3

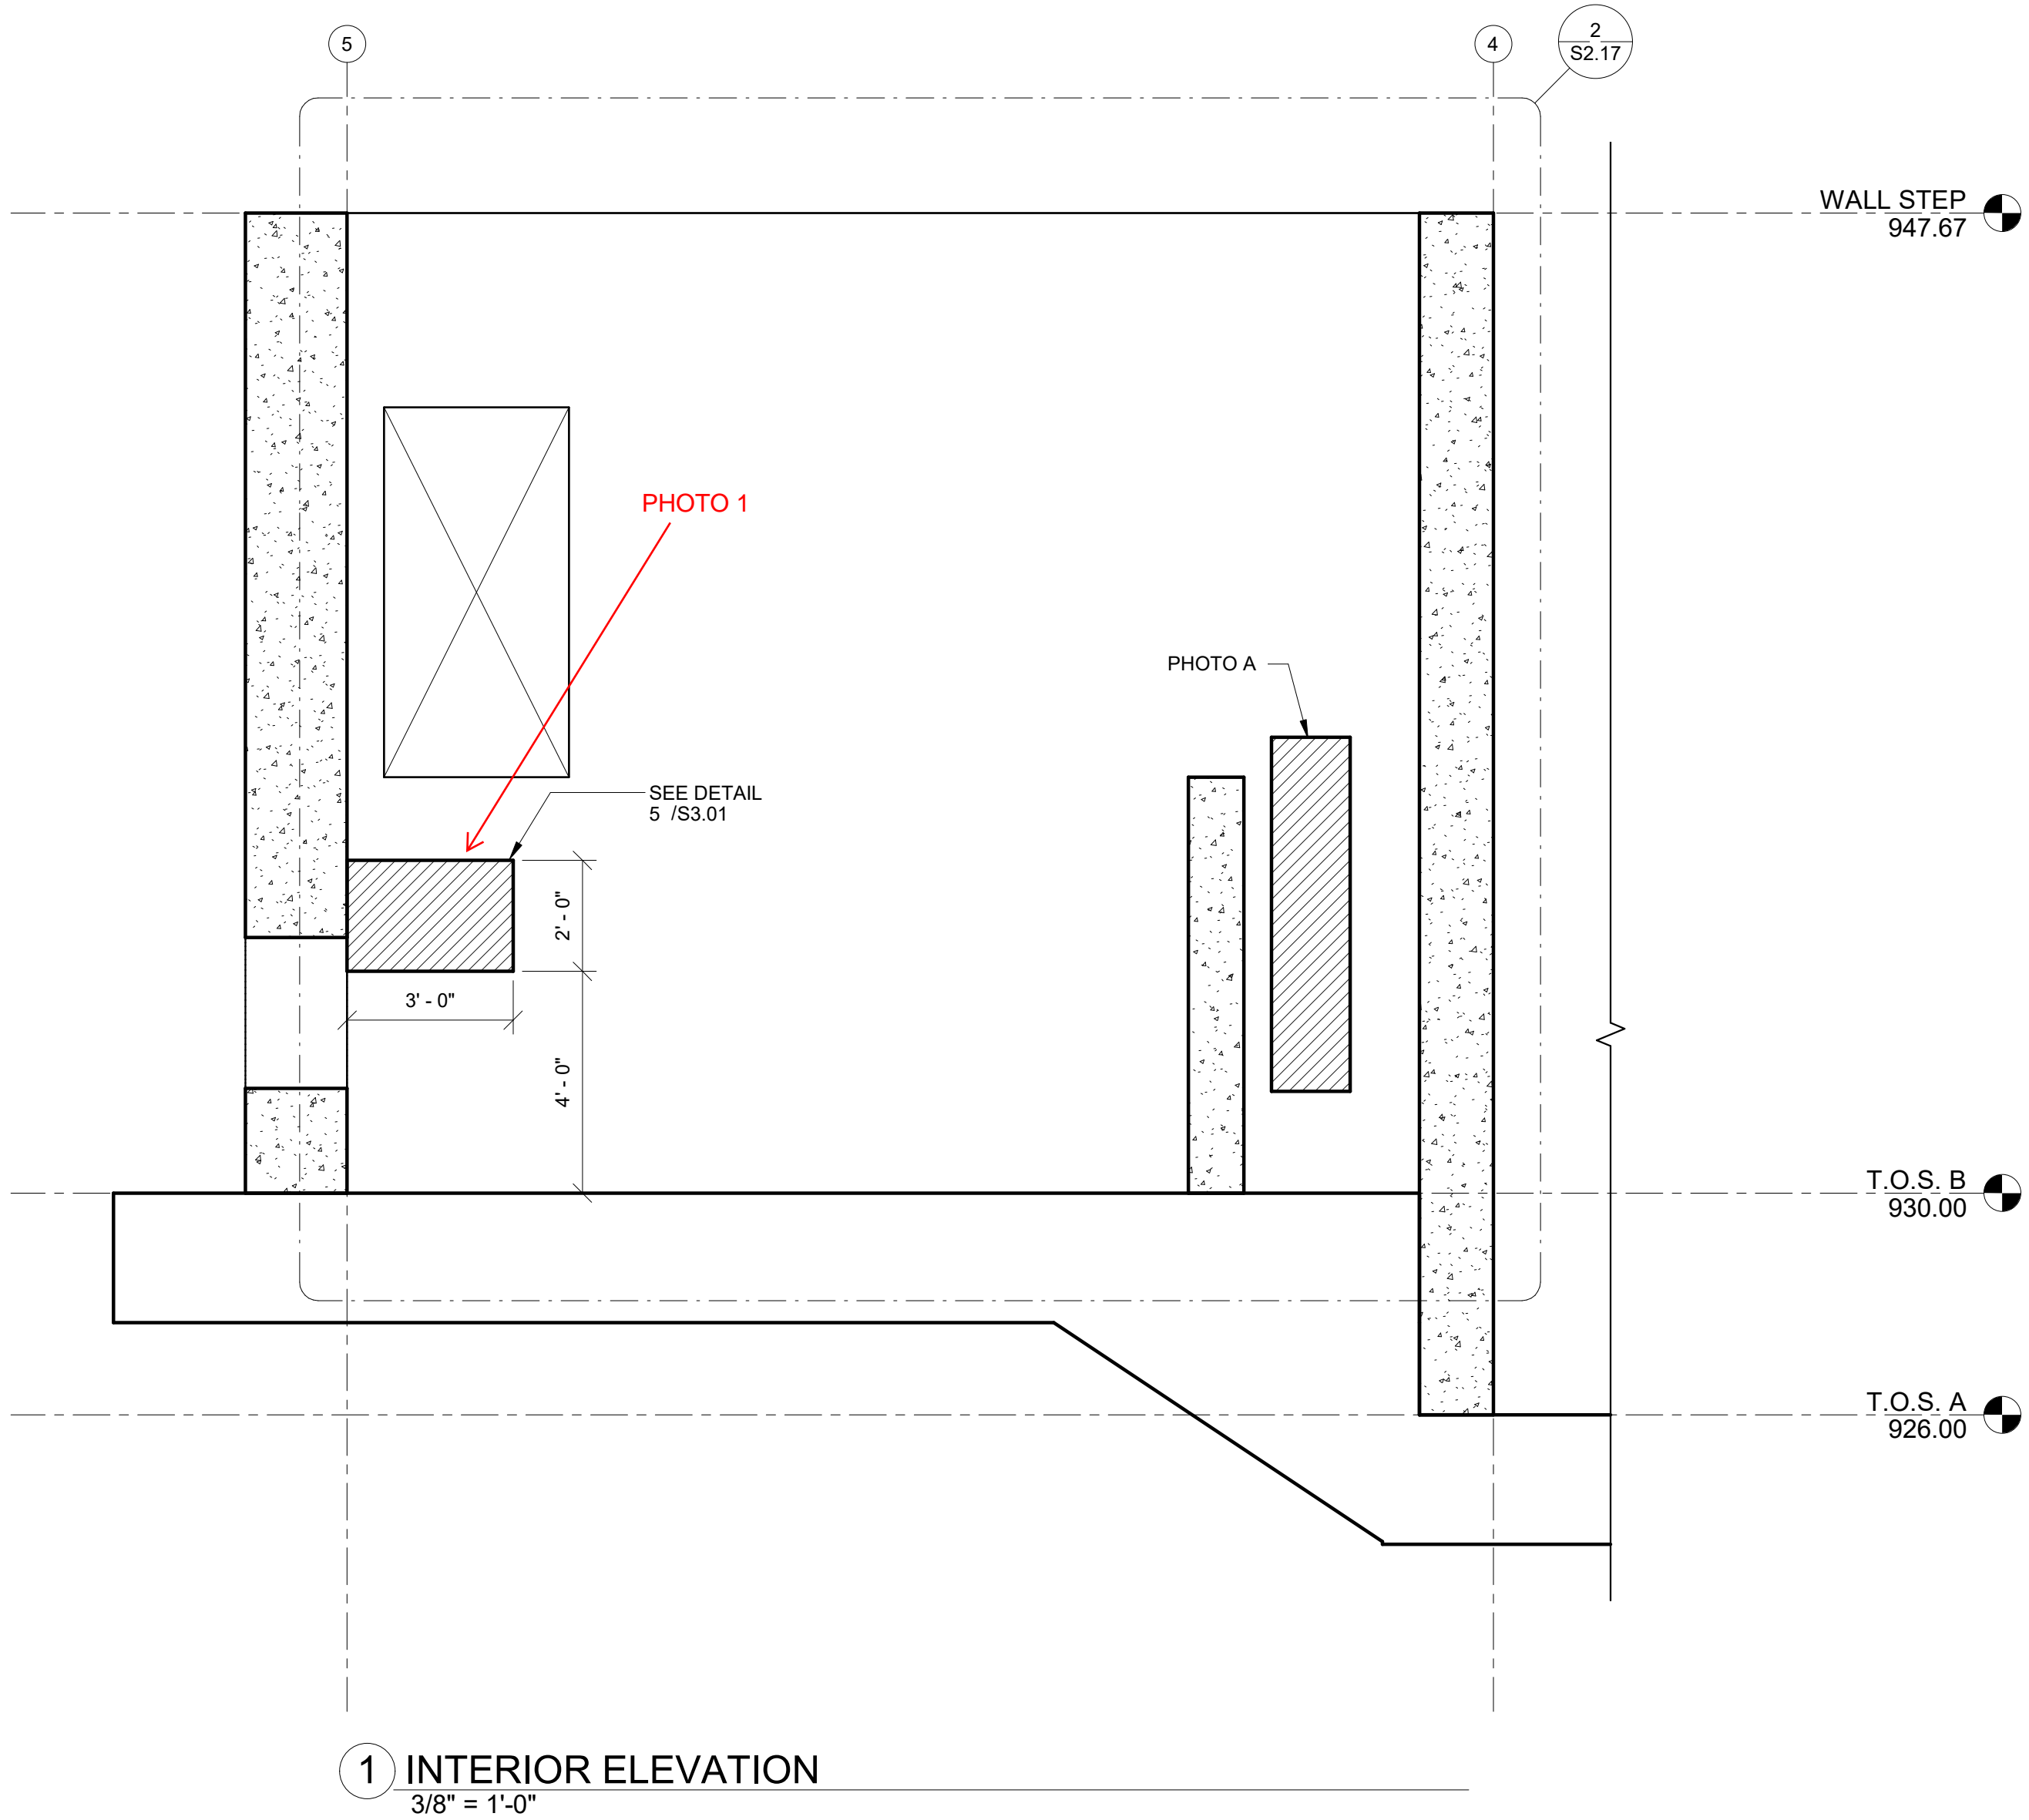

2 PHOTO A




Before Repair



After Repair


PHOTO 1

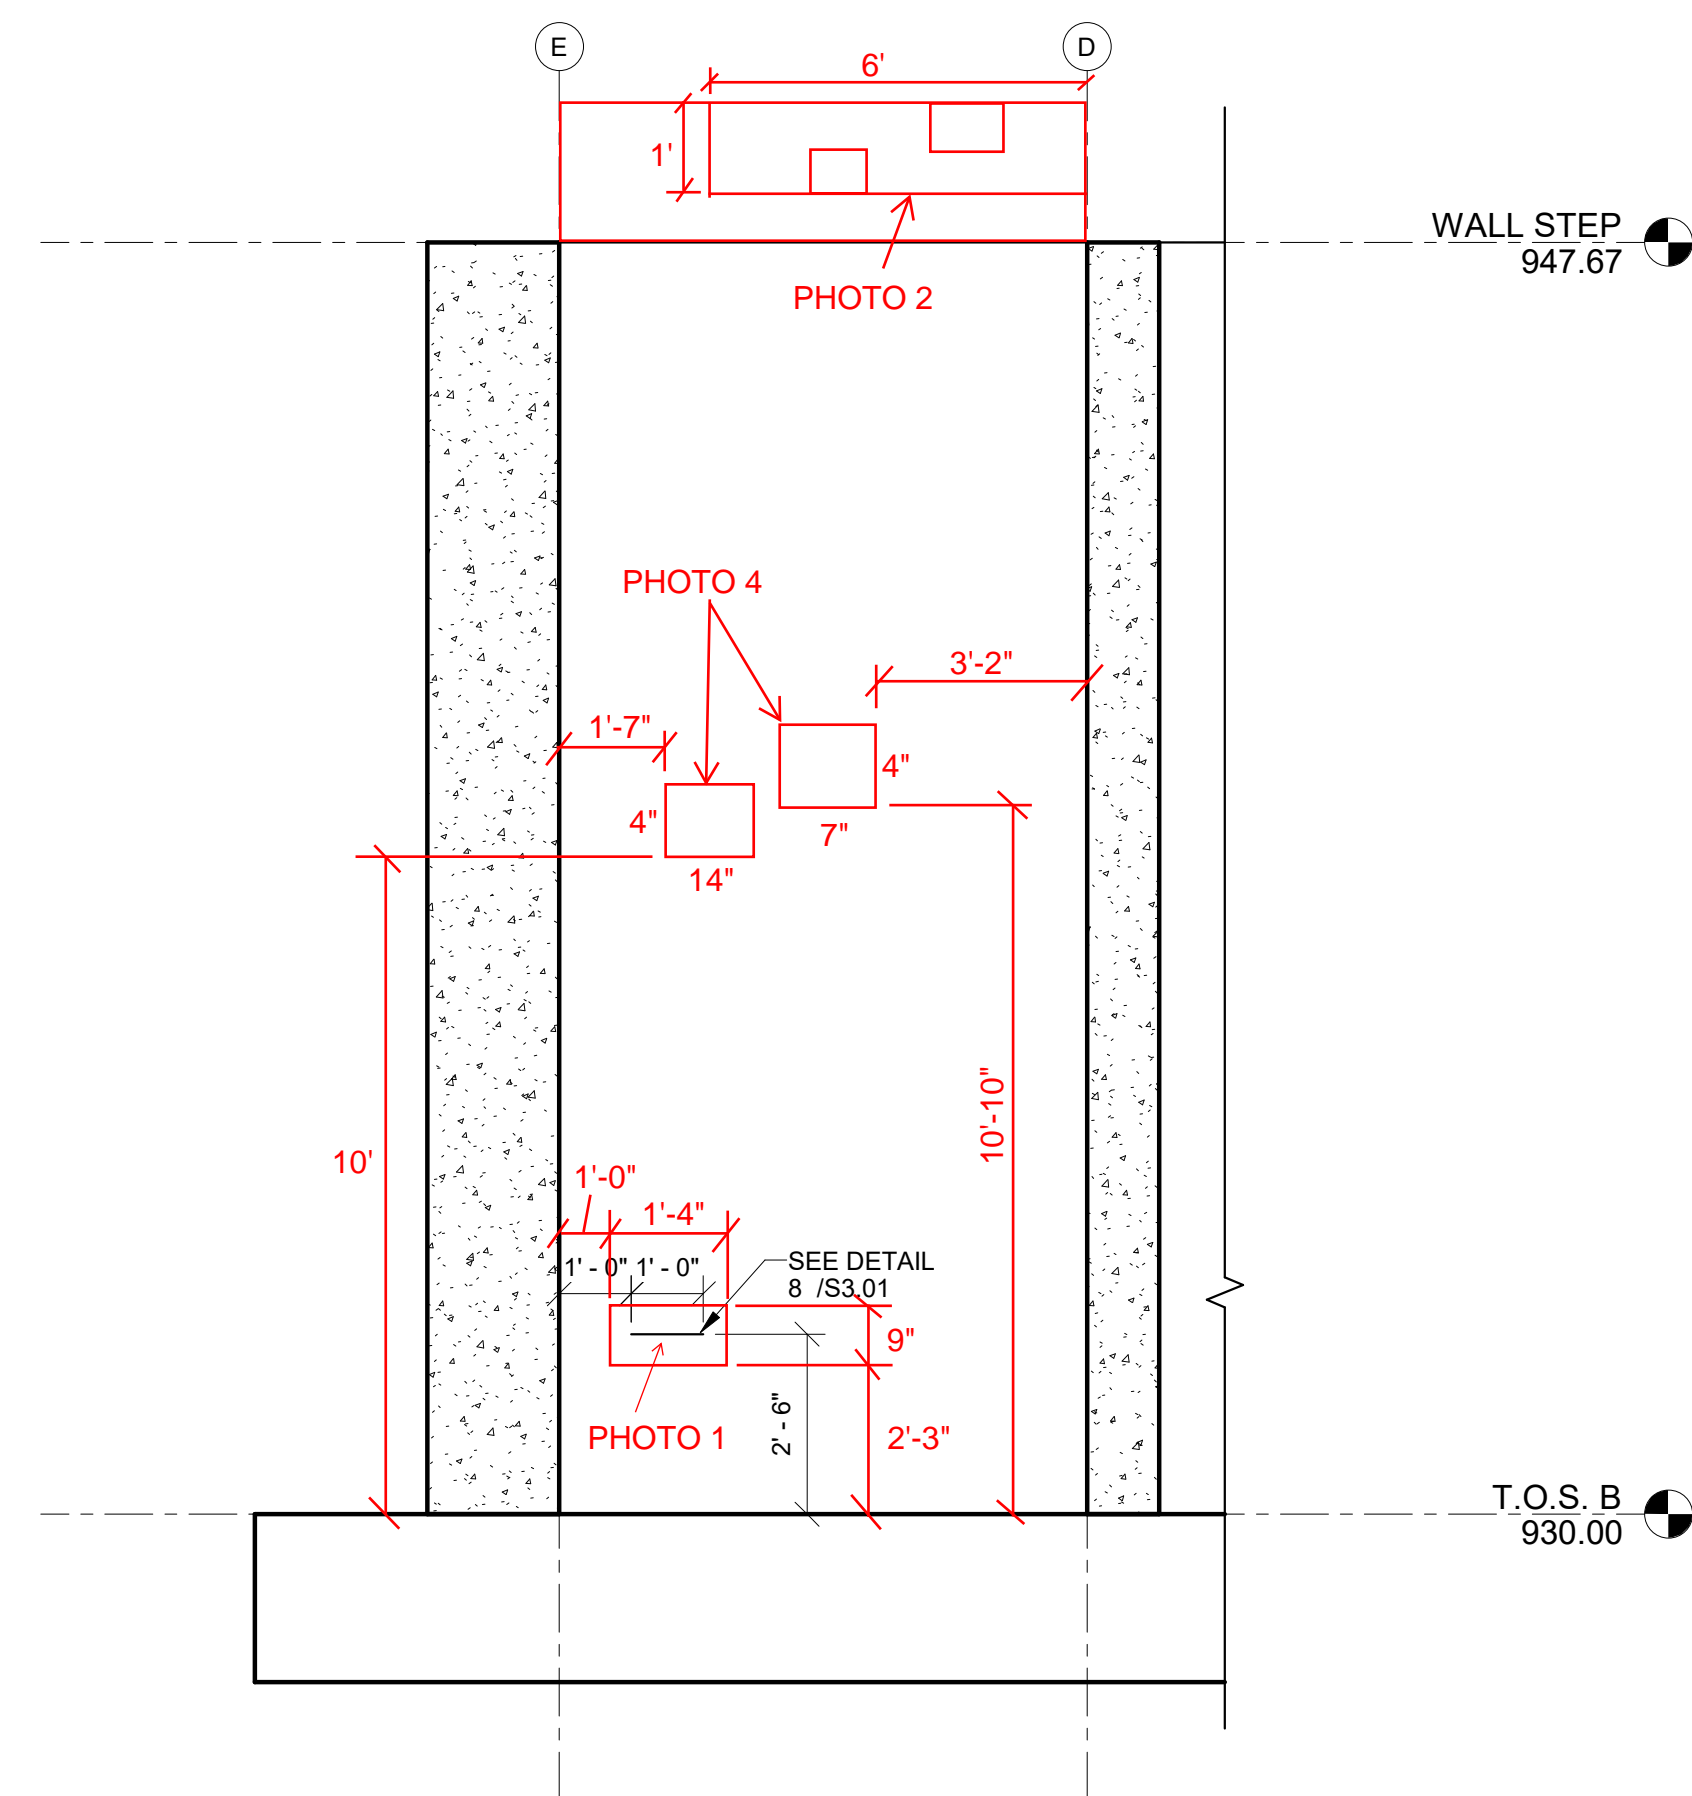

1 INTERIOR ELEVATION
3/8" = 1'-0"



3 PHOTO A

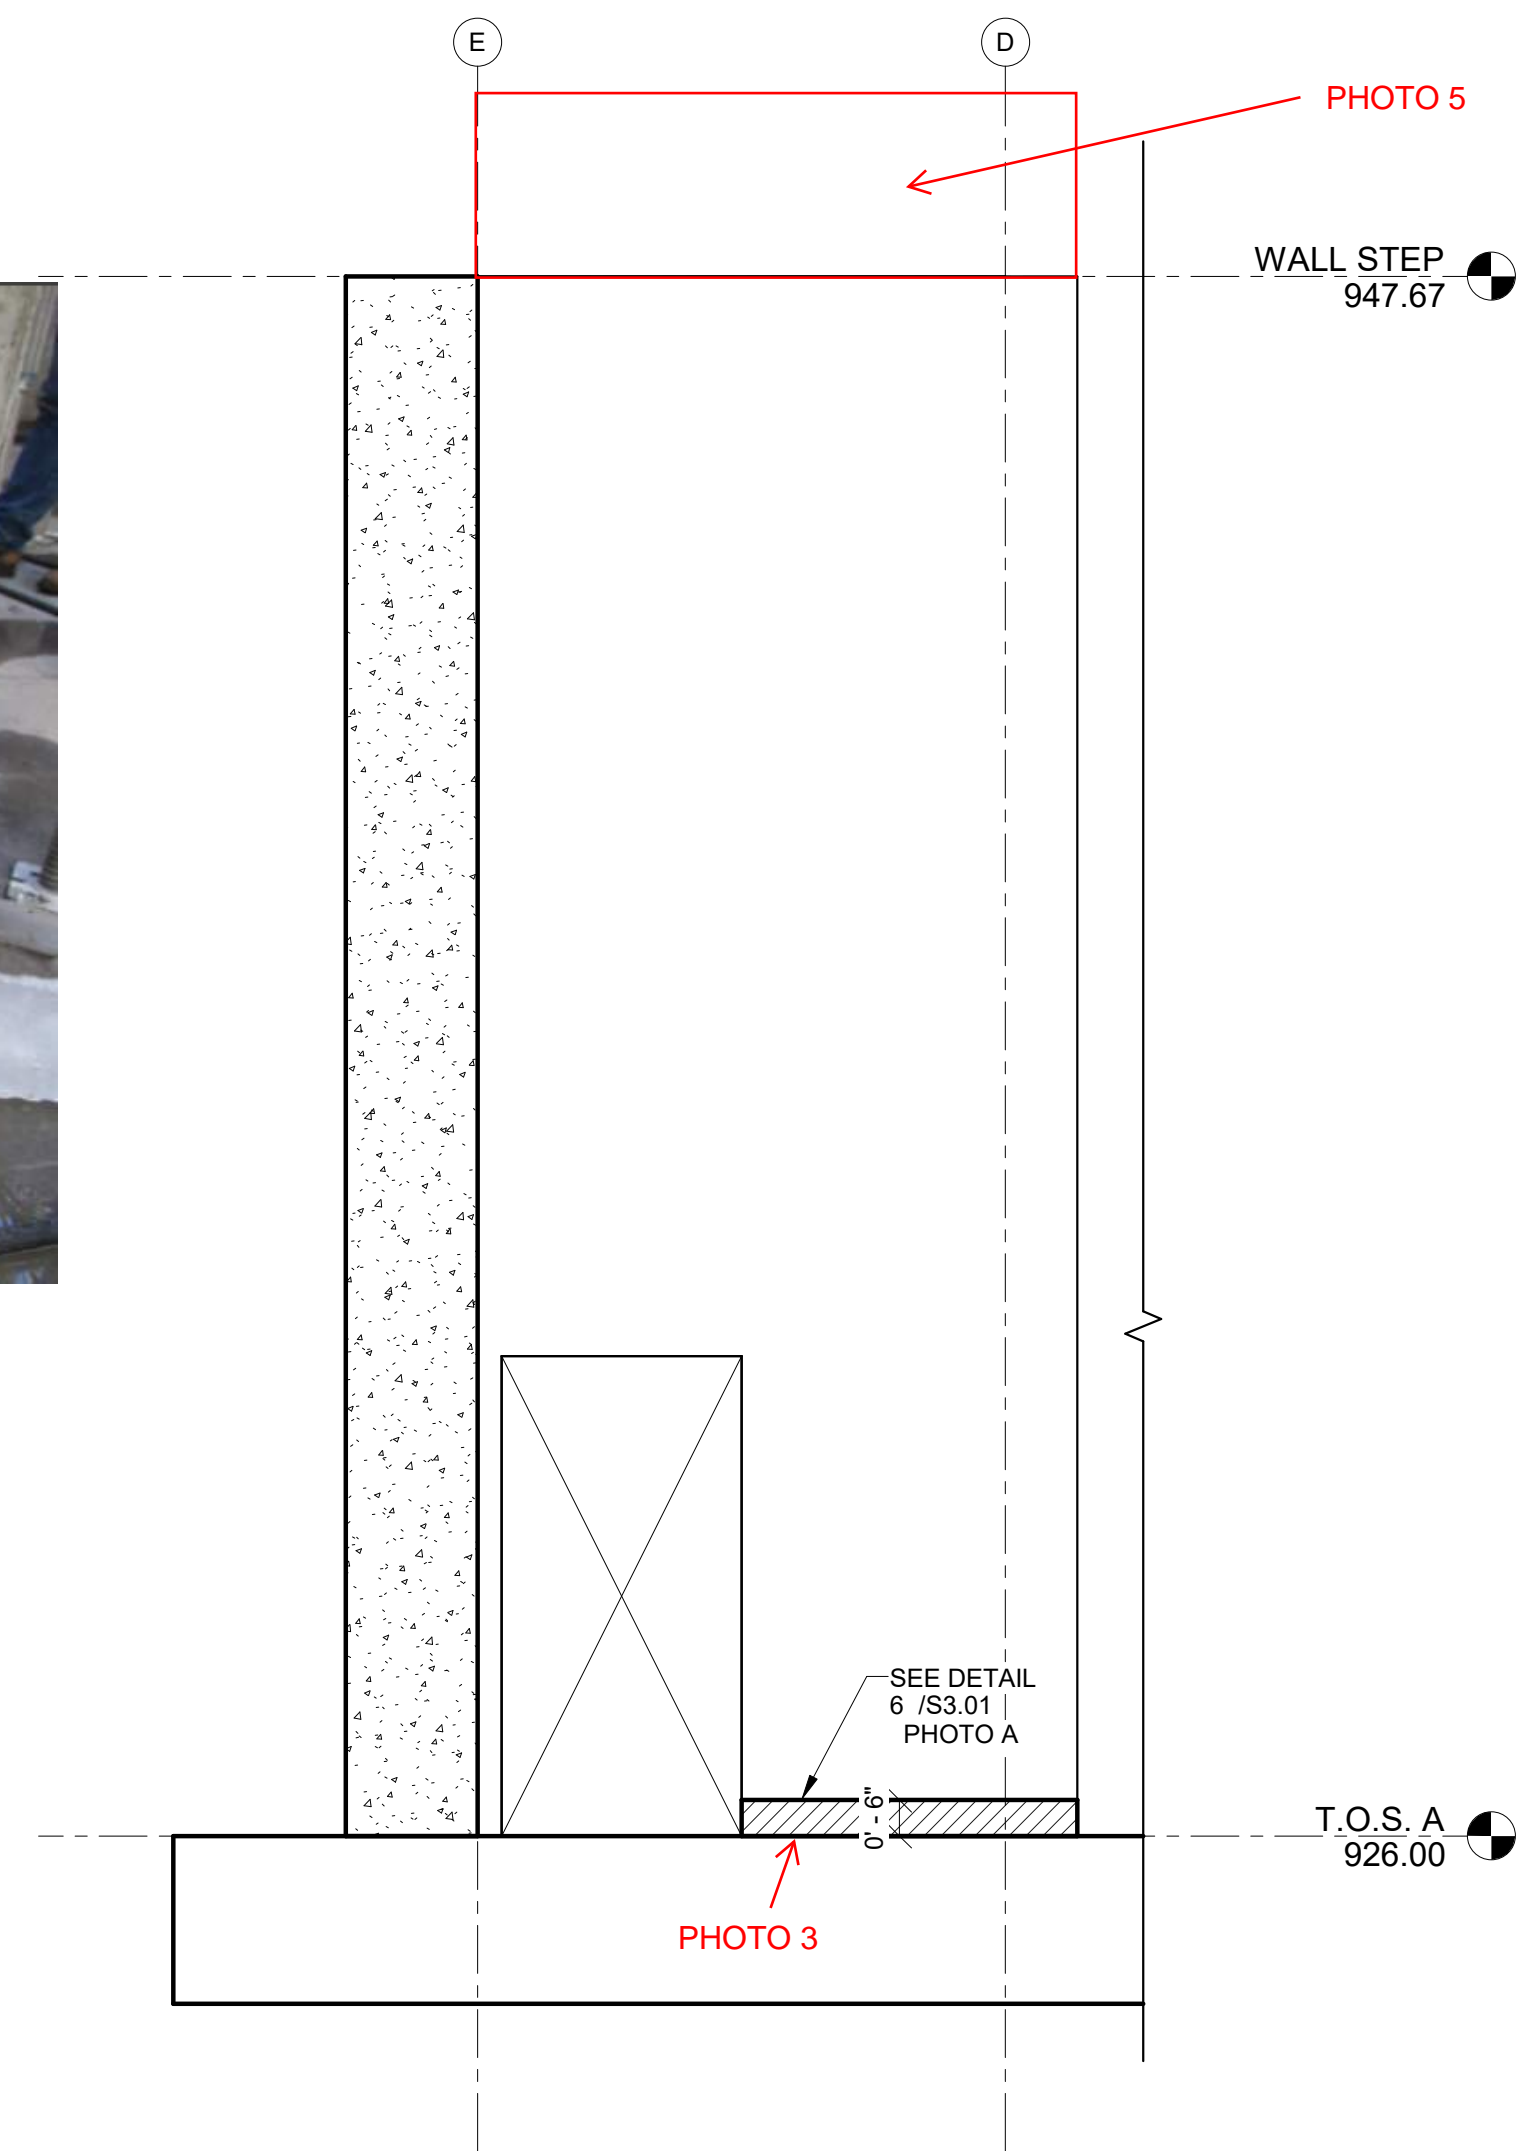

2 INTERIOR ELEVATION
3/8" = 1'-0"



CHUCK BRITSON

400 E COURT AVE.
SUITE 140.
DES MOINES, IOWA 50309
515-243-4477
www.shuck-britson.com

NEVADA WWTP IMPROVEMENTS LIMITED
CONCRETE WALL REPAIR

BOOMERANG
457 S. 6th STREET NEVADA IOWA 50201

Project Status

PROJECT NUMBER

3.0172.03

TE

HEET TITLE

3/24/2023

ALL ELEVATIONS

SHEET NO. _____

S2.18



PHOTO 1



PHOTO 2



PHOTO 3

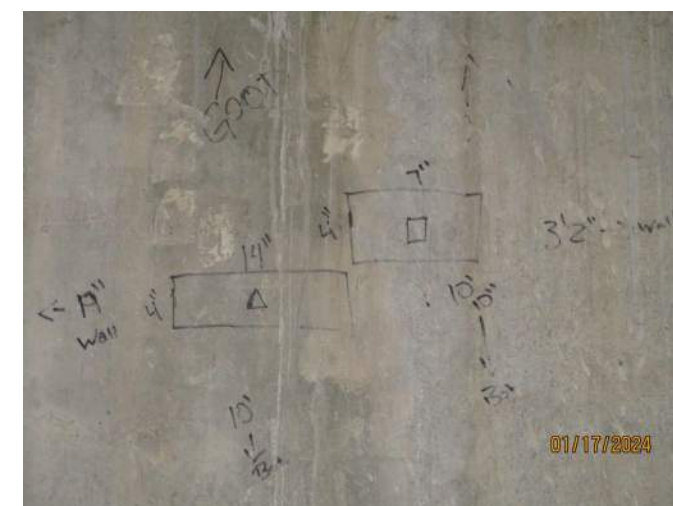


PHOTO 4



Before Repair




After Repair

PHOTO 5

3/24/2023 5:11:57 PM

C:\Users\chris\OneDrive\Documents\123.0172.03_STRUCT\123.0172.03_STRUCT\123.0172.03_STRUCT.dwg

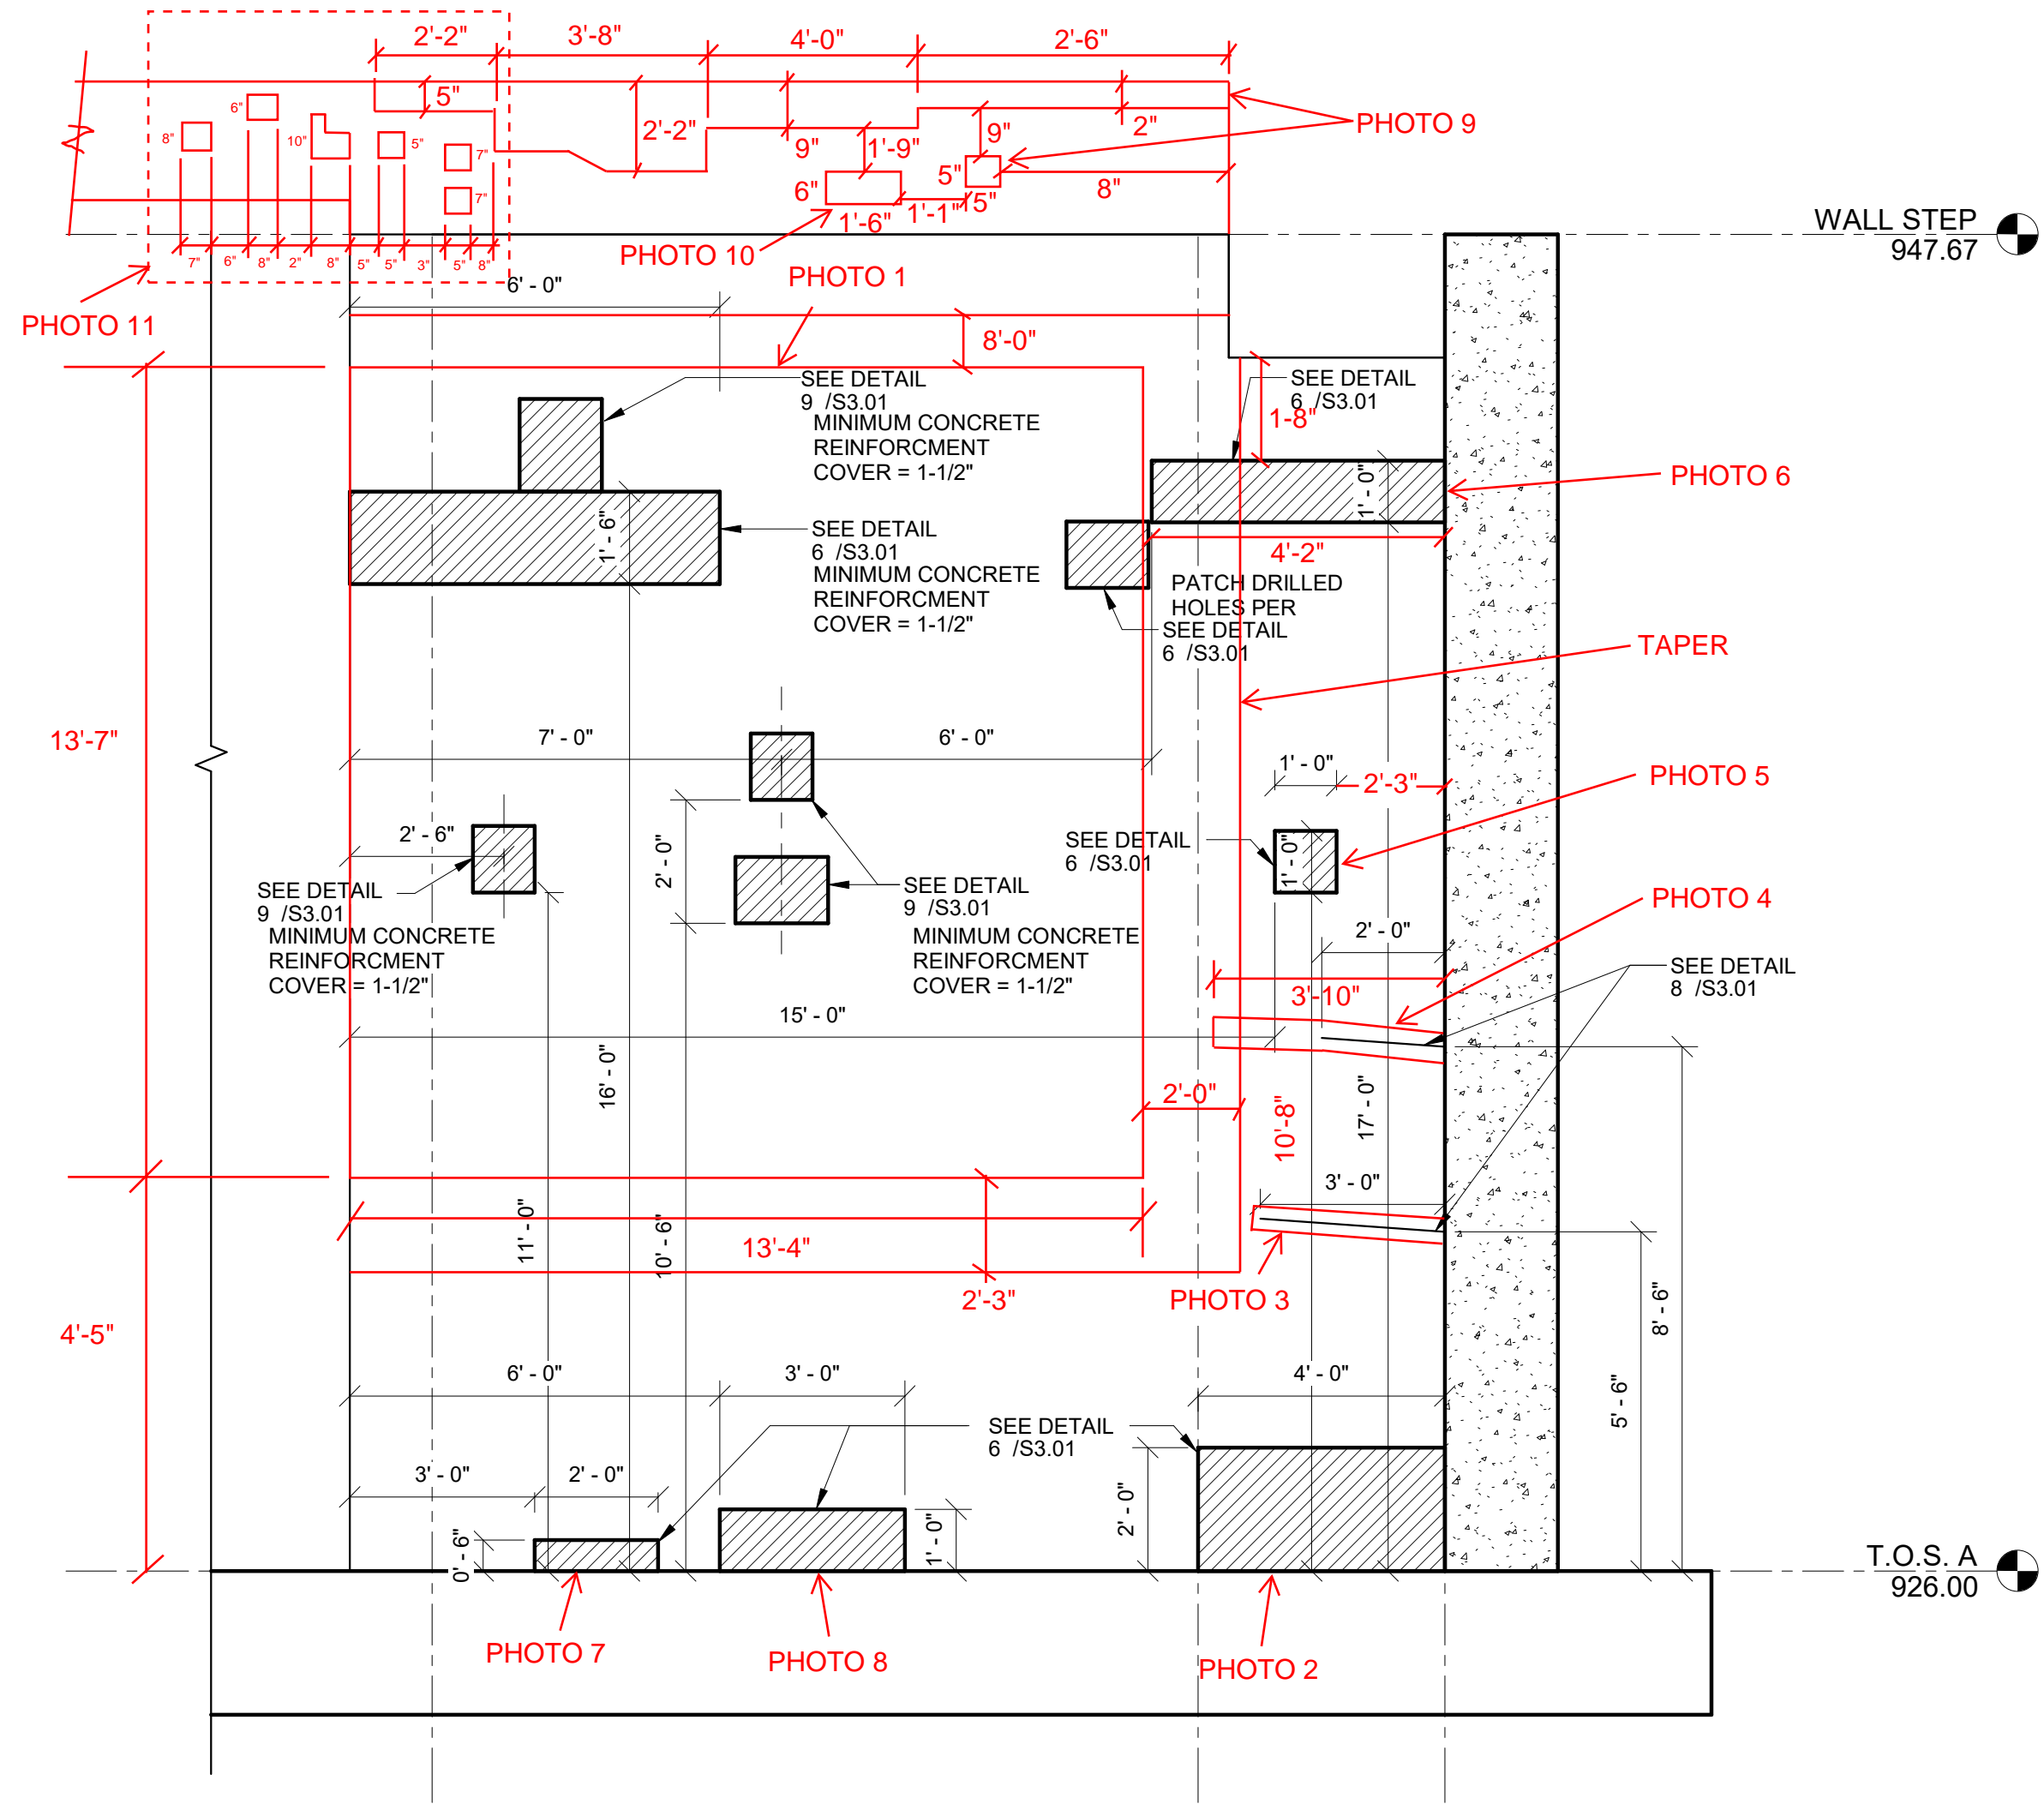

1 INTERIOR ELEVATION
3/8" = 1'-0"

ORIGINAL REPAIRS




SHUCK BRITSON
400 E COURT AVE.
SUITE 140.
DES MOINES, IOWA 50309
515-243-4477
www.shuck-britson.com

NEVADA WWTP IMPROVEMENTS LIMITED
CONCRETE WALL REPAIR
BOOMERANG
457 S. 6th STREET NEVADA IOWA 50201

Project Status	
PROJECT NUMBER	123.0172.03
DATE	03/24/2023
SHEET TITLE	
WALL ELEVATIONS	
SHEET NO.	
S2.19	

3/24/2023 5:11:57 PM

C:\Users\chris\OneDrive\Documents\123.0172.03_STRUCT\R220_chris\16BDR.vrt

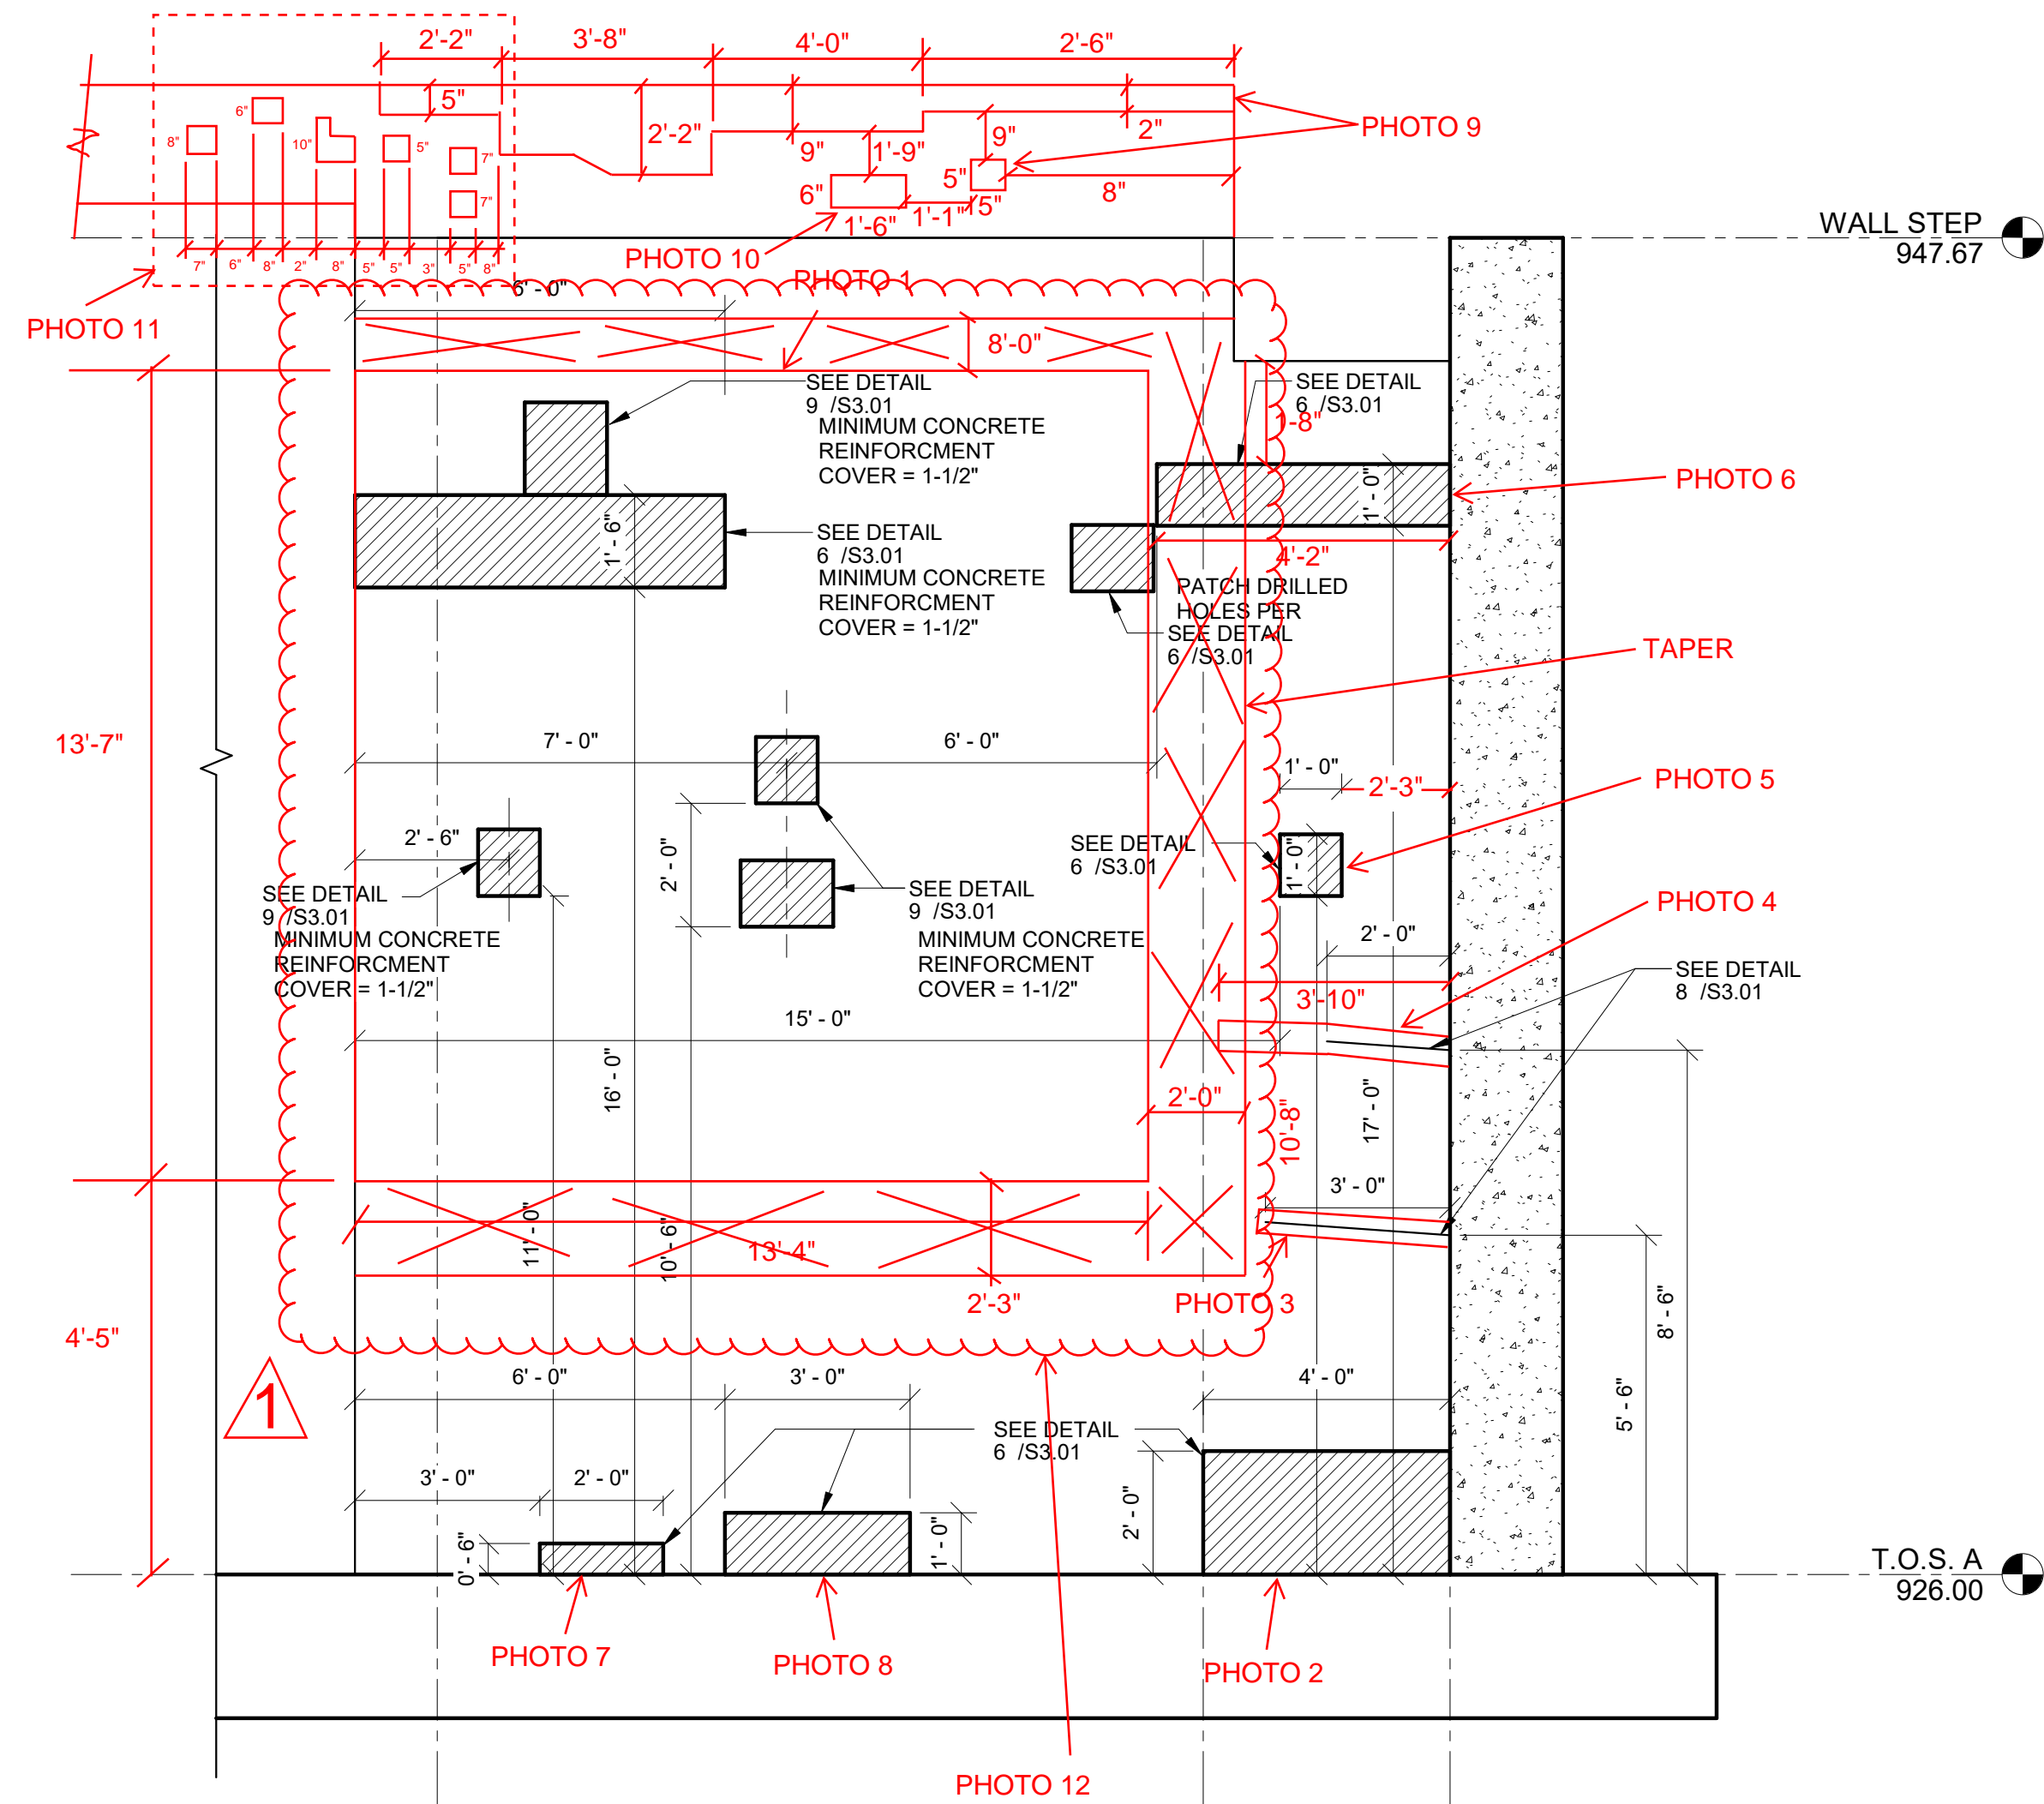

1 INTERIOR ELEVATION
3/8" = 1'-0"

1 REVISION 1: REPAIRED EXISTING REPAIRS

LEGEND:

X DENOTES REMOVAL



SHUCK BRITSON

400 E COURT AVE.
SUITE 140.
DES MOINES, IOWA 50309
515-243-4477
www.shuck-britson.com

NEVADA WWTP IMPROVEMENTS LIMITED
CONCRETE WALL REPAIR

BOOMERANG
457 S. 6th STREET NEVADA IOWA 50201

Project Status	
PROJECT NUMBER	123.0172.03
DATE	03/24/2023
SHEET TITLE	
WALL ELEVATIONS	
SHEET NO.	
S2.19	



Before Repair



After Repair

PHOTO 1



Before Repair



After Repair

PHOTO 2



Before Repair



After Repair

PHOTO 3



Before Repair



After Repair

PHOTO 4



Before Repair



After Repair

PHOTO 5




Before Repair



After Repair

PHOTO 6

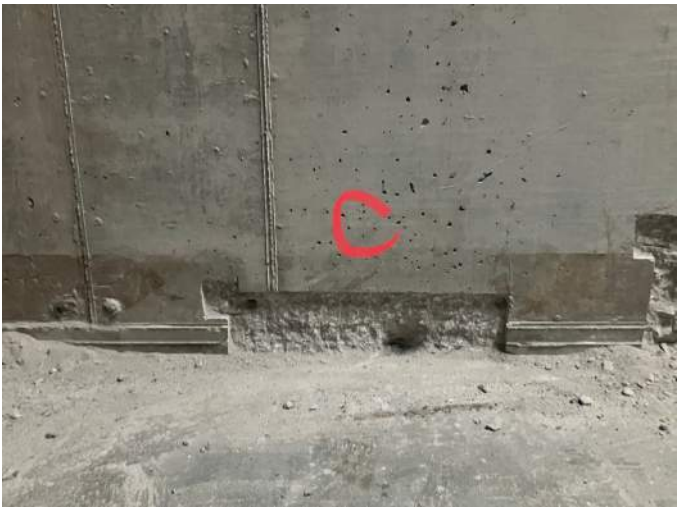

Before Repair



After Repair

PHOTO 7



Before Repair



After Repair

PHOTO 8



Before Repair



Before Repair

PHOTO 9



Before Repair



After Repair

PHOTO 10



Before Repair



Before Repair

PHOTO 11




Before Repair



After Repair

PHOTO 12


1

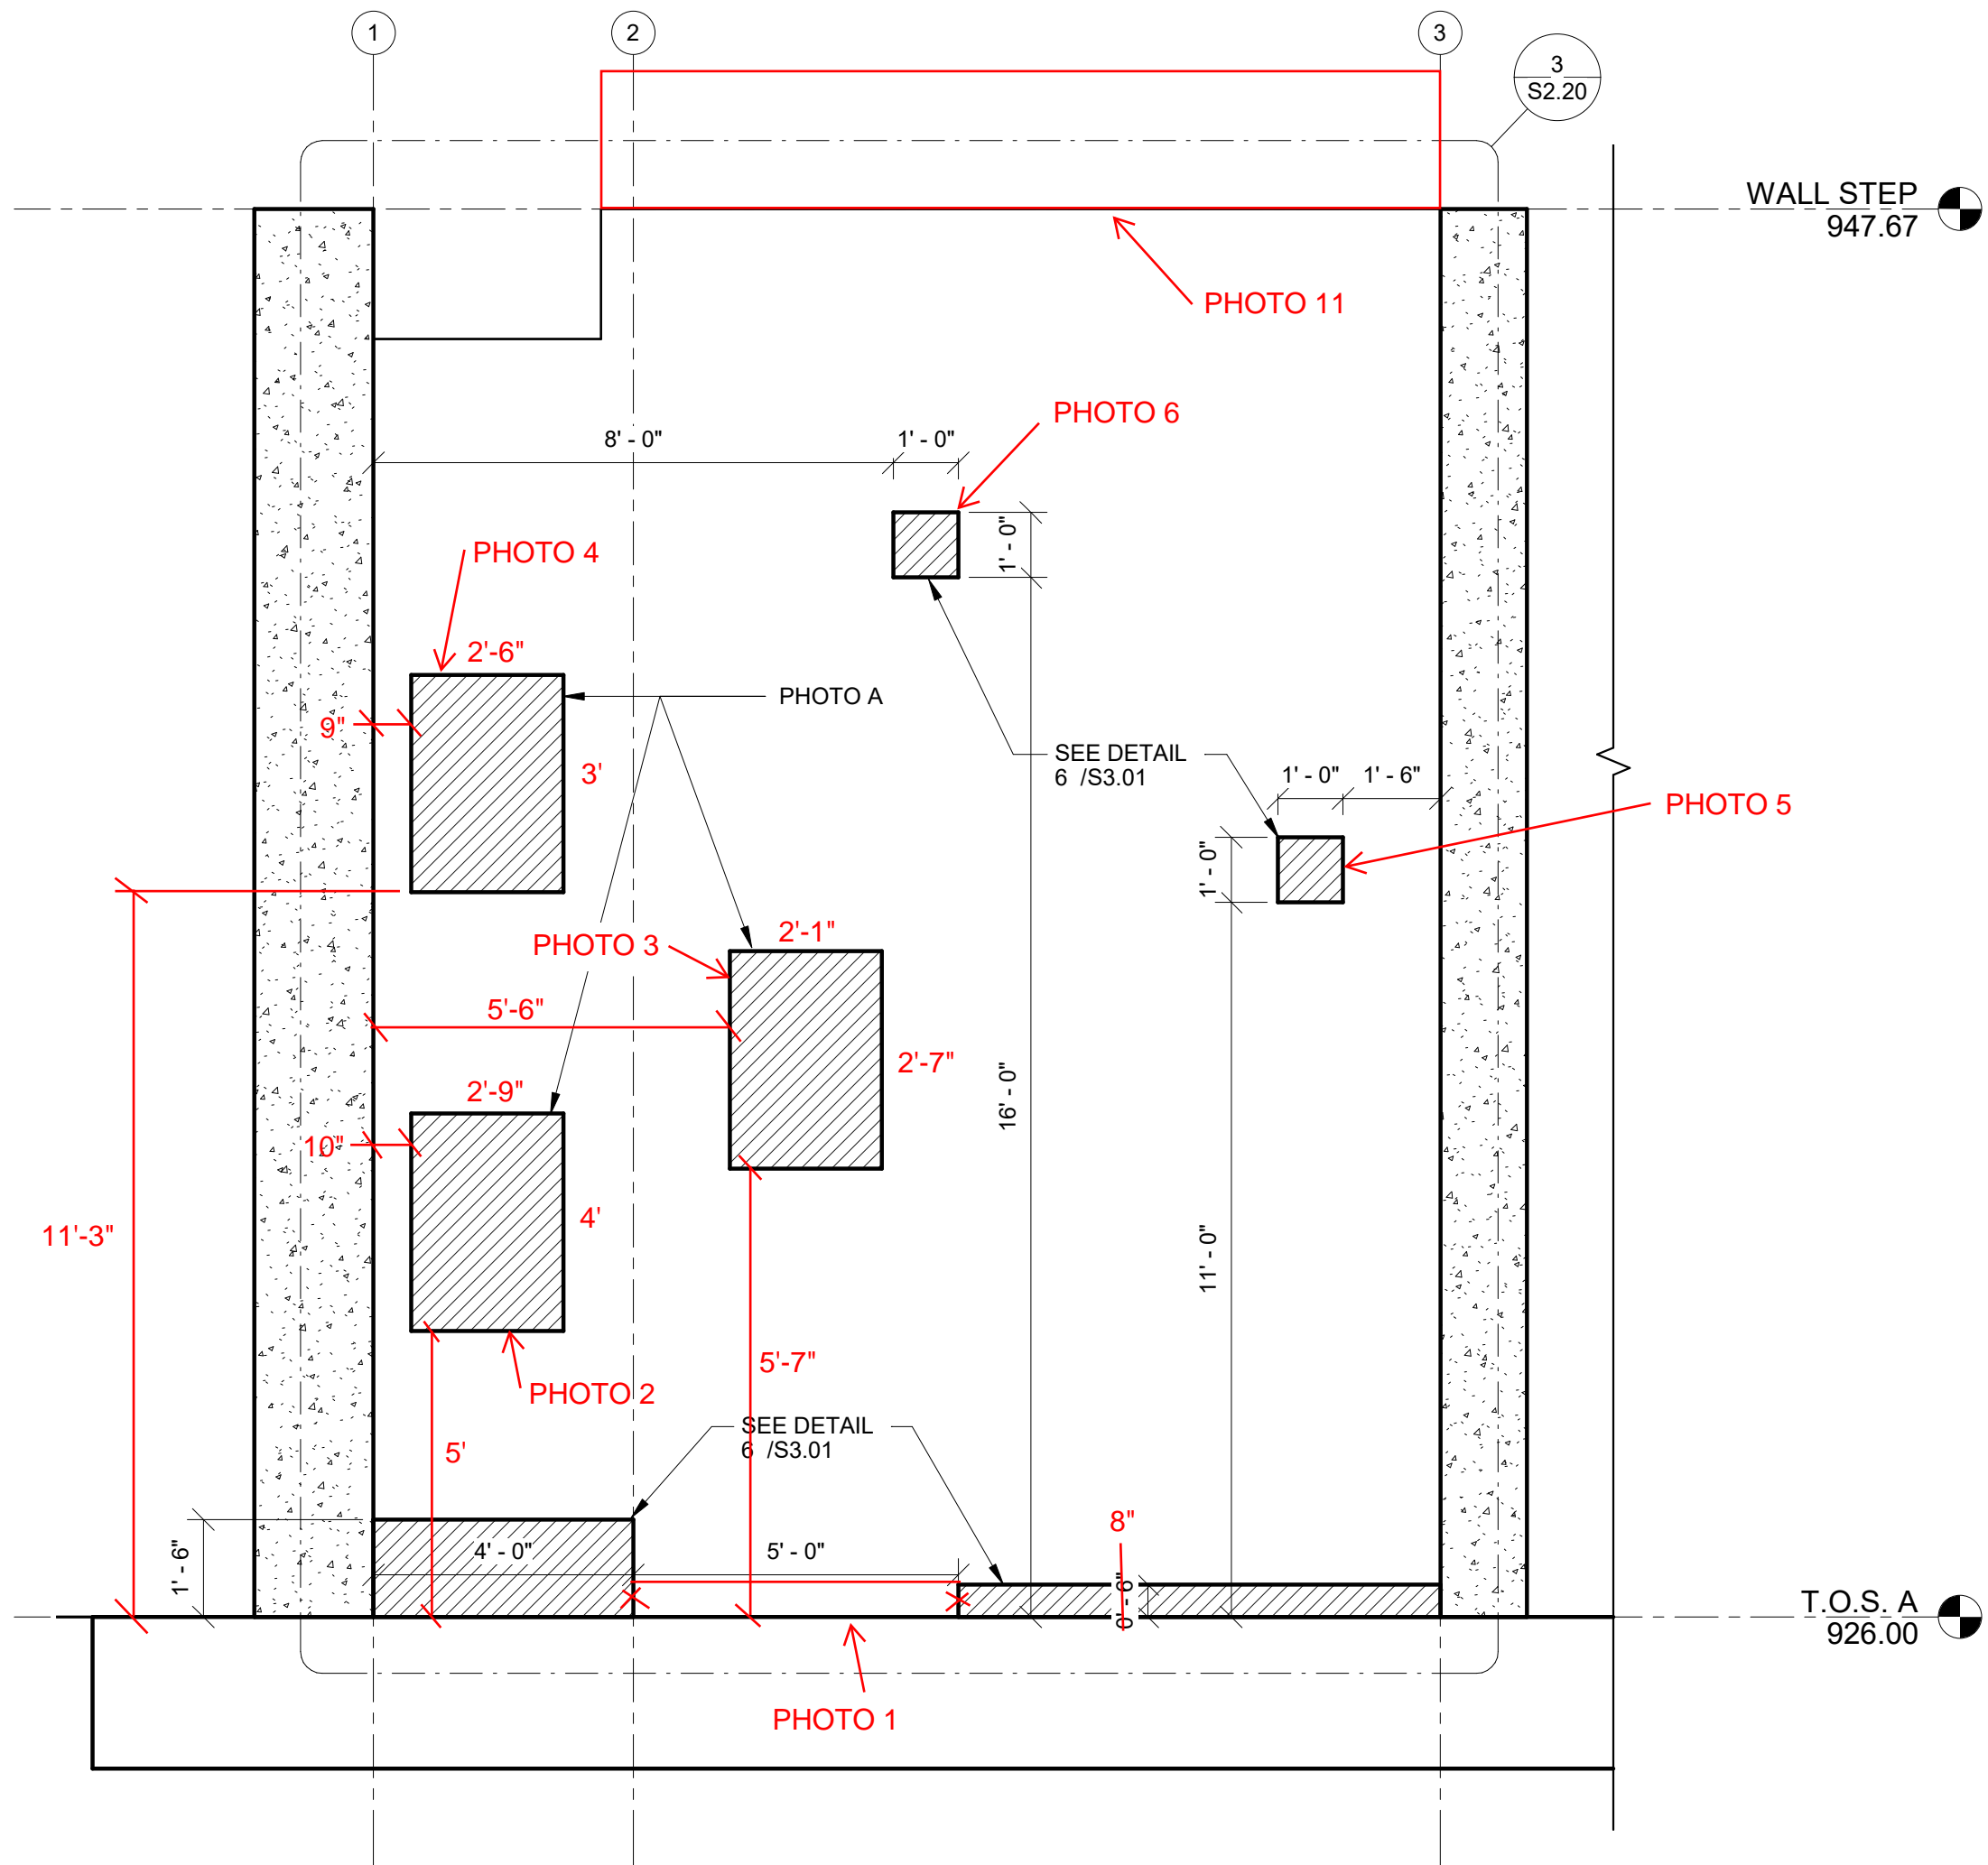

1 INTERIOR ELEVATION
3/8" = 1'-0"



3 PHOTO A

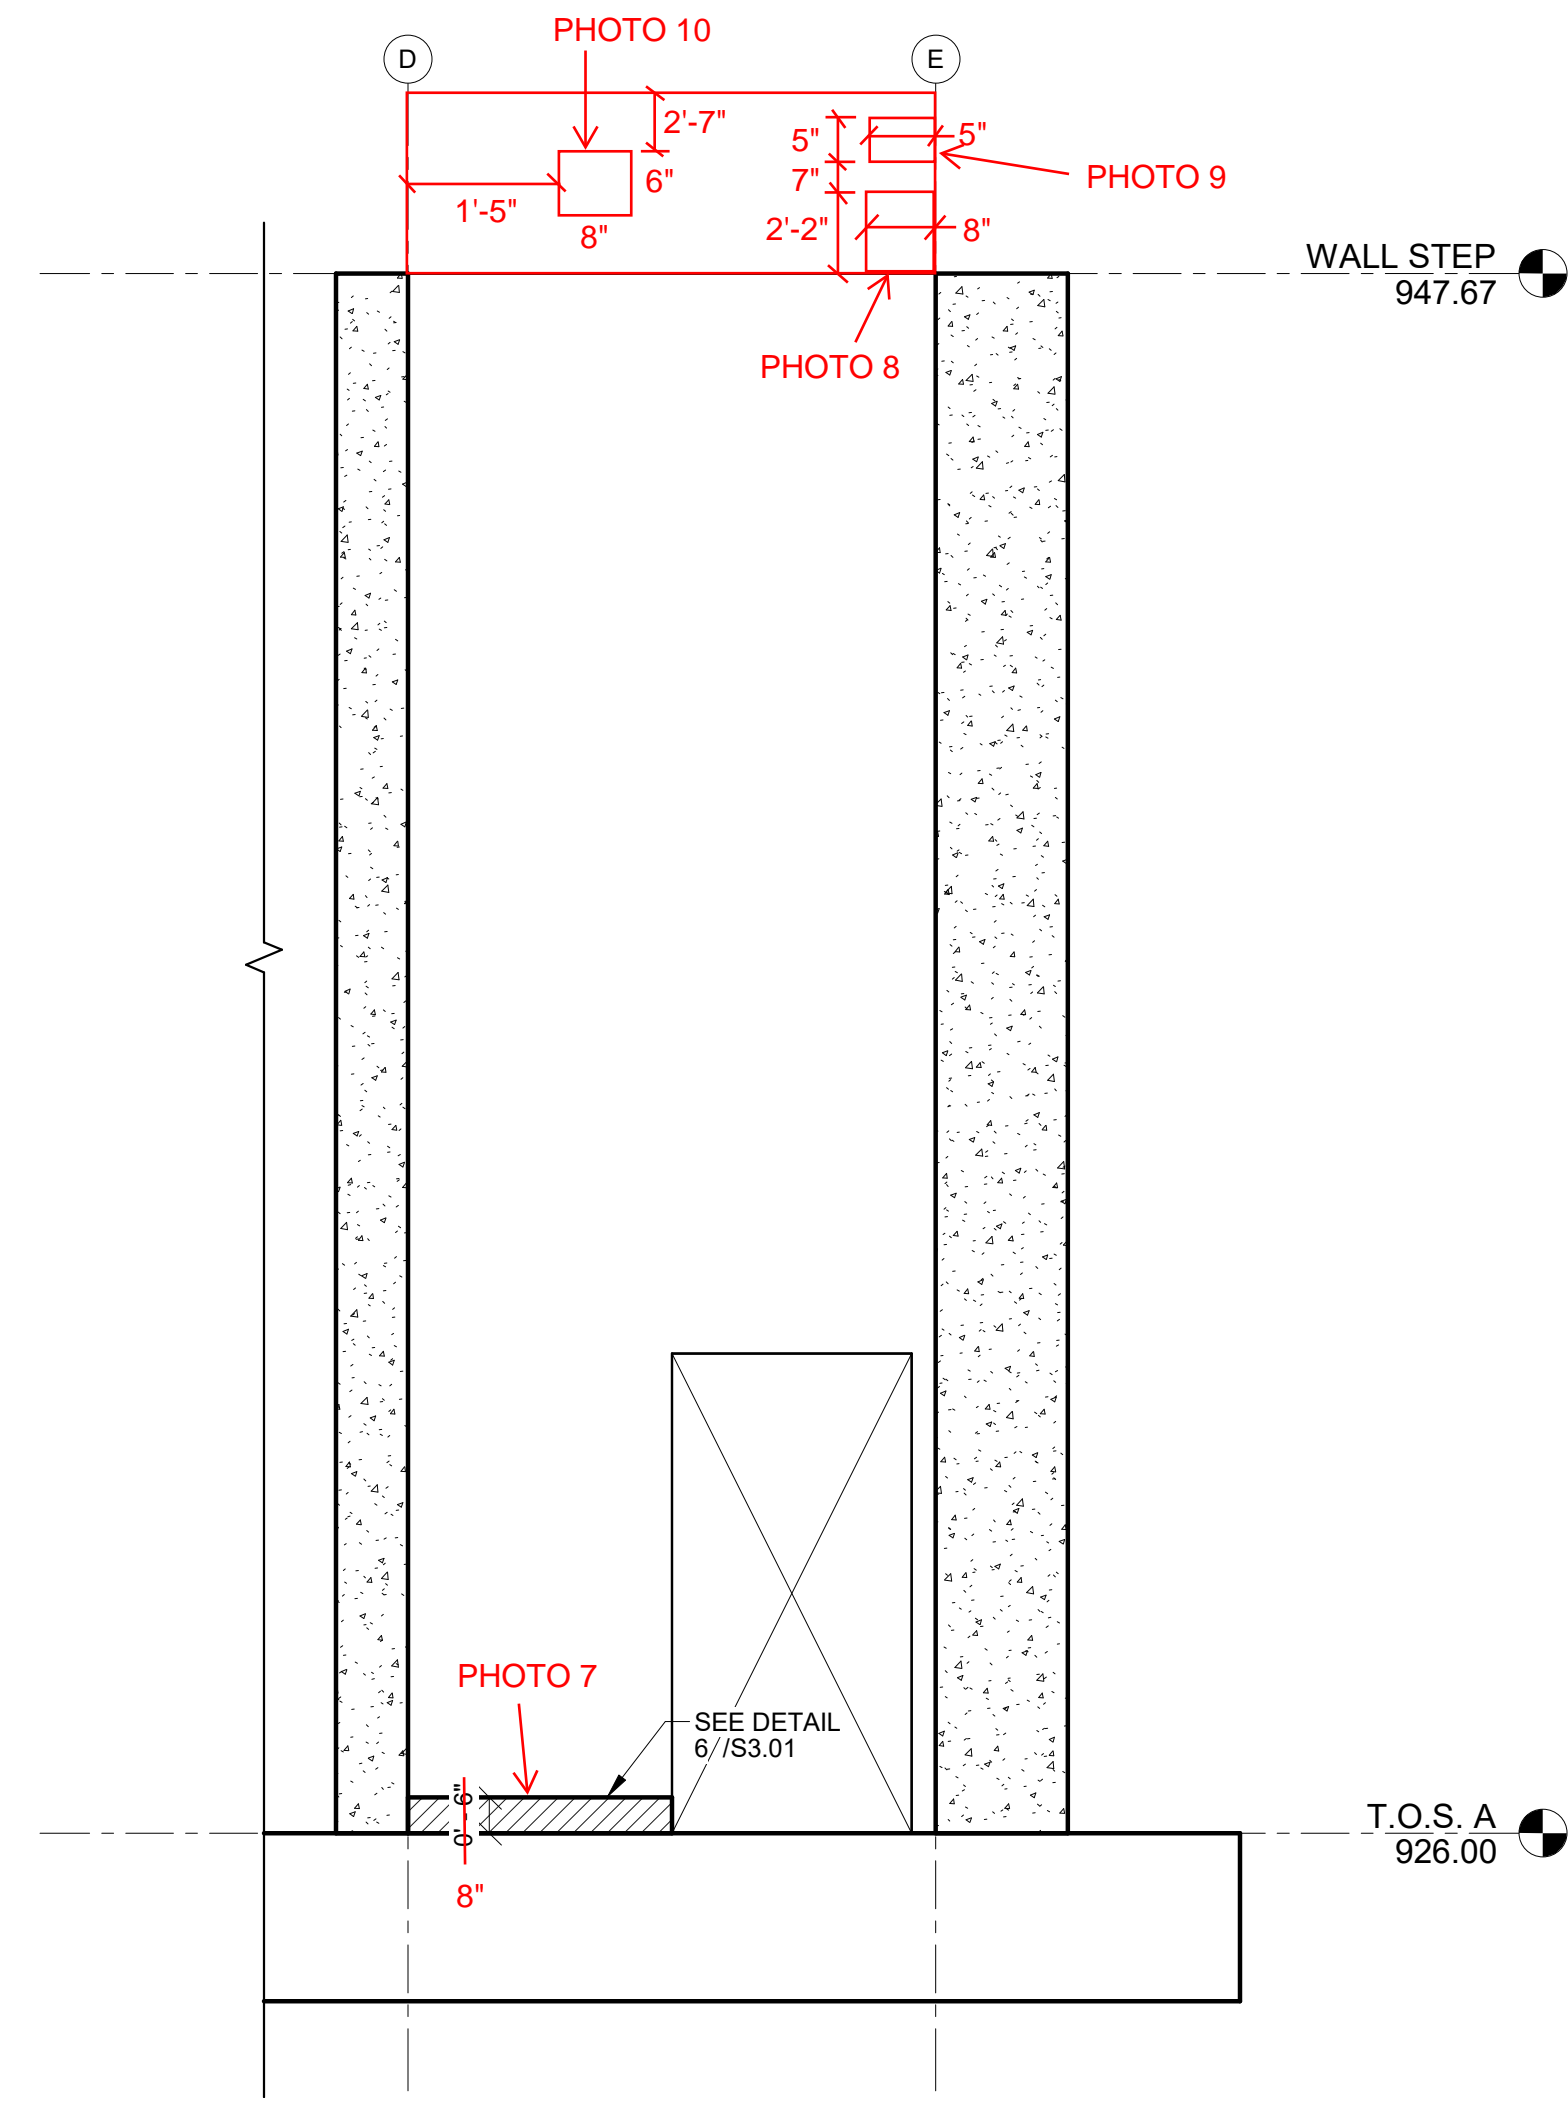

2 INTERIOR ELEVATION
3/8" = 1'-0"



Before Repair



Before Repair



Before Repair



Before Repair

PHOTO 1



After Repair



After Repair

PHOTO 1



Before Repair



After Repair

PHOTO 2



Before Repair



After Repair

PHOTO 3



Before Repair



After Repair

PHOTO 4



Before Repair



After Repair

PHOTO 5



Before Repair



After Repair

PHOTO 6



Before Repair



After Repair

PHOTO 7



Before Repair



After Repair

PHOTO 8



Before Repair



After Repair

PHOTO 9



Before Repair



After Repair

PHOTO 10




Before Repair



After Repair

PHOTO 11

1 INTERIOR ELEVATION
3/8" = 1'-0"

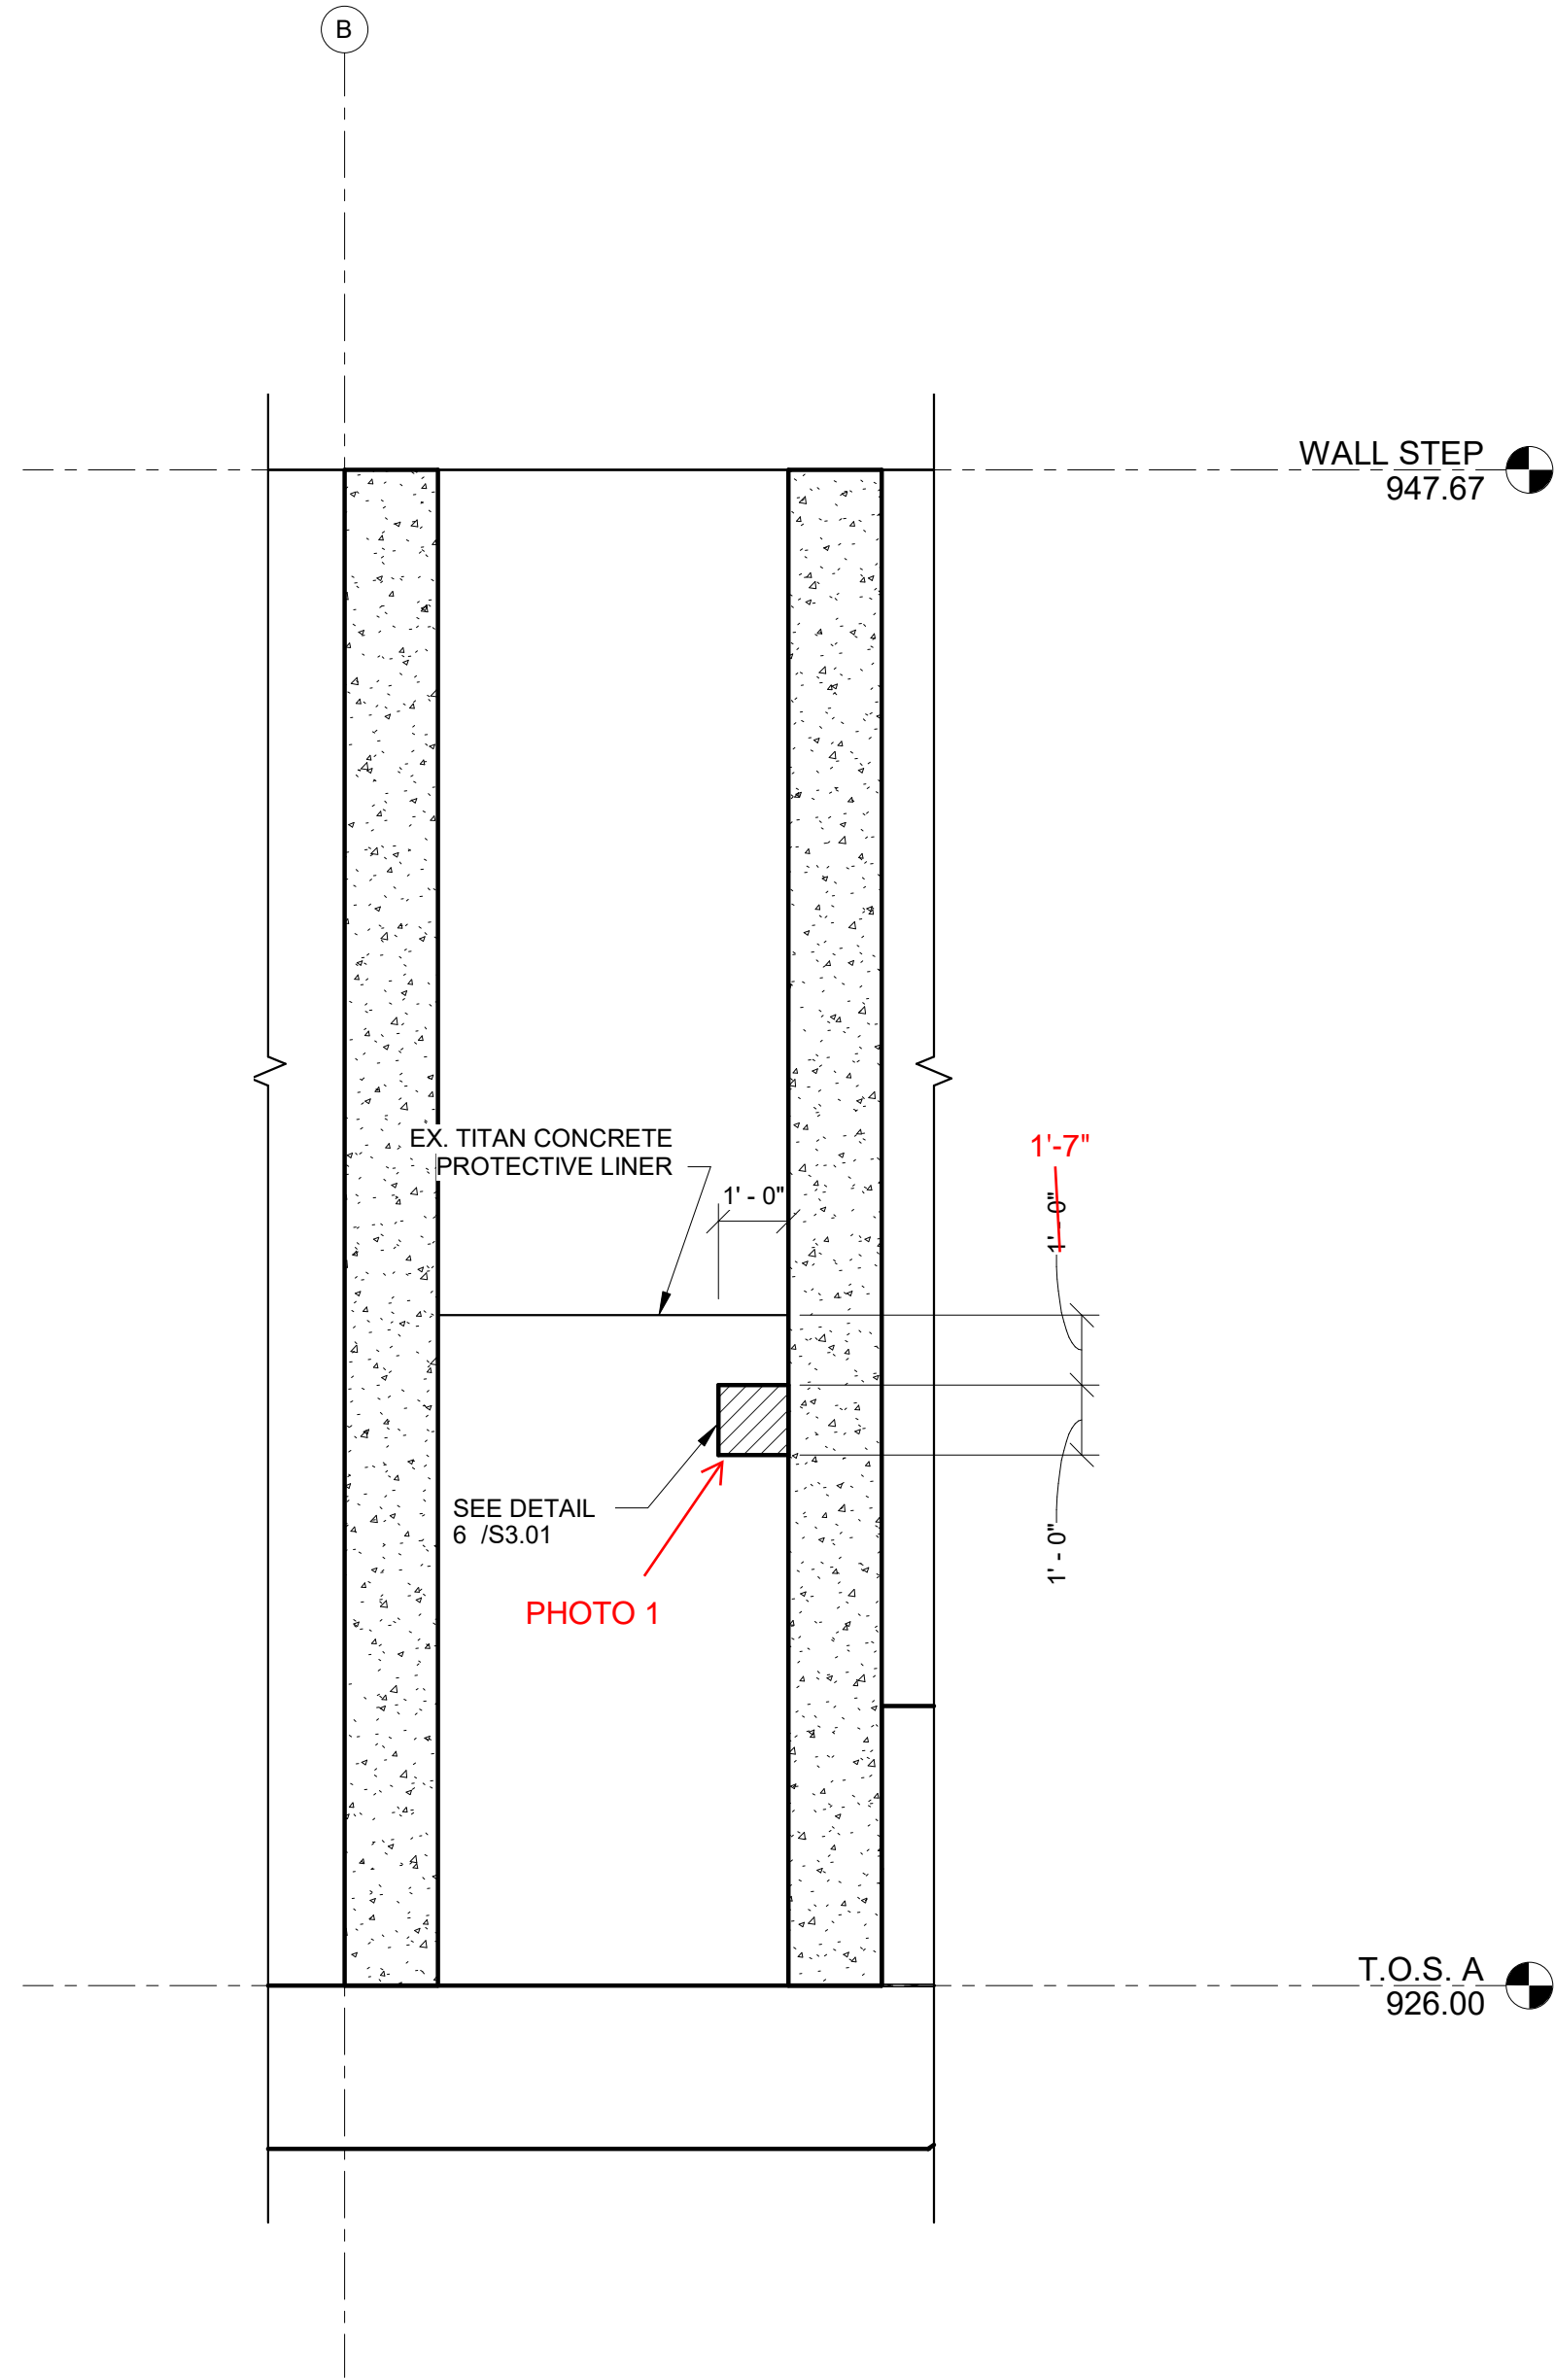


3 PHOTO A



4 PHOTO B

2 INTERIOR ELEVATION
3/8" = 1'-0"

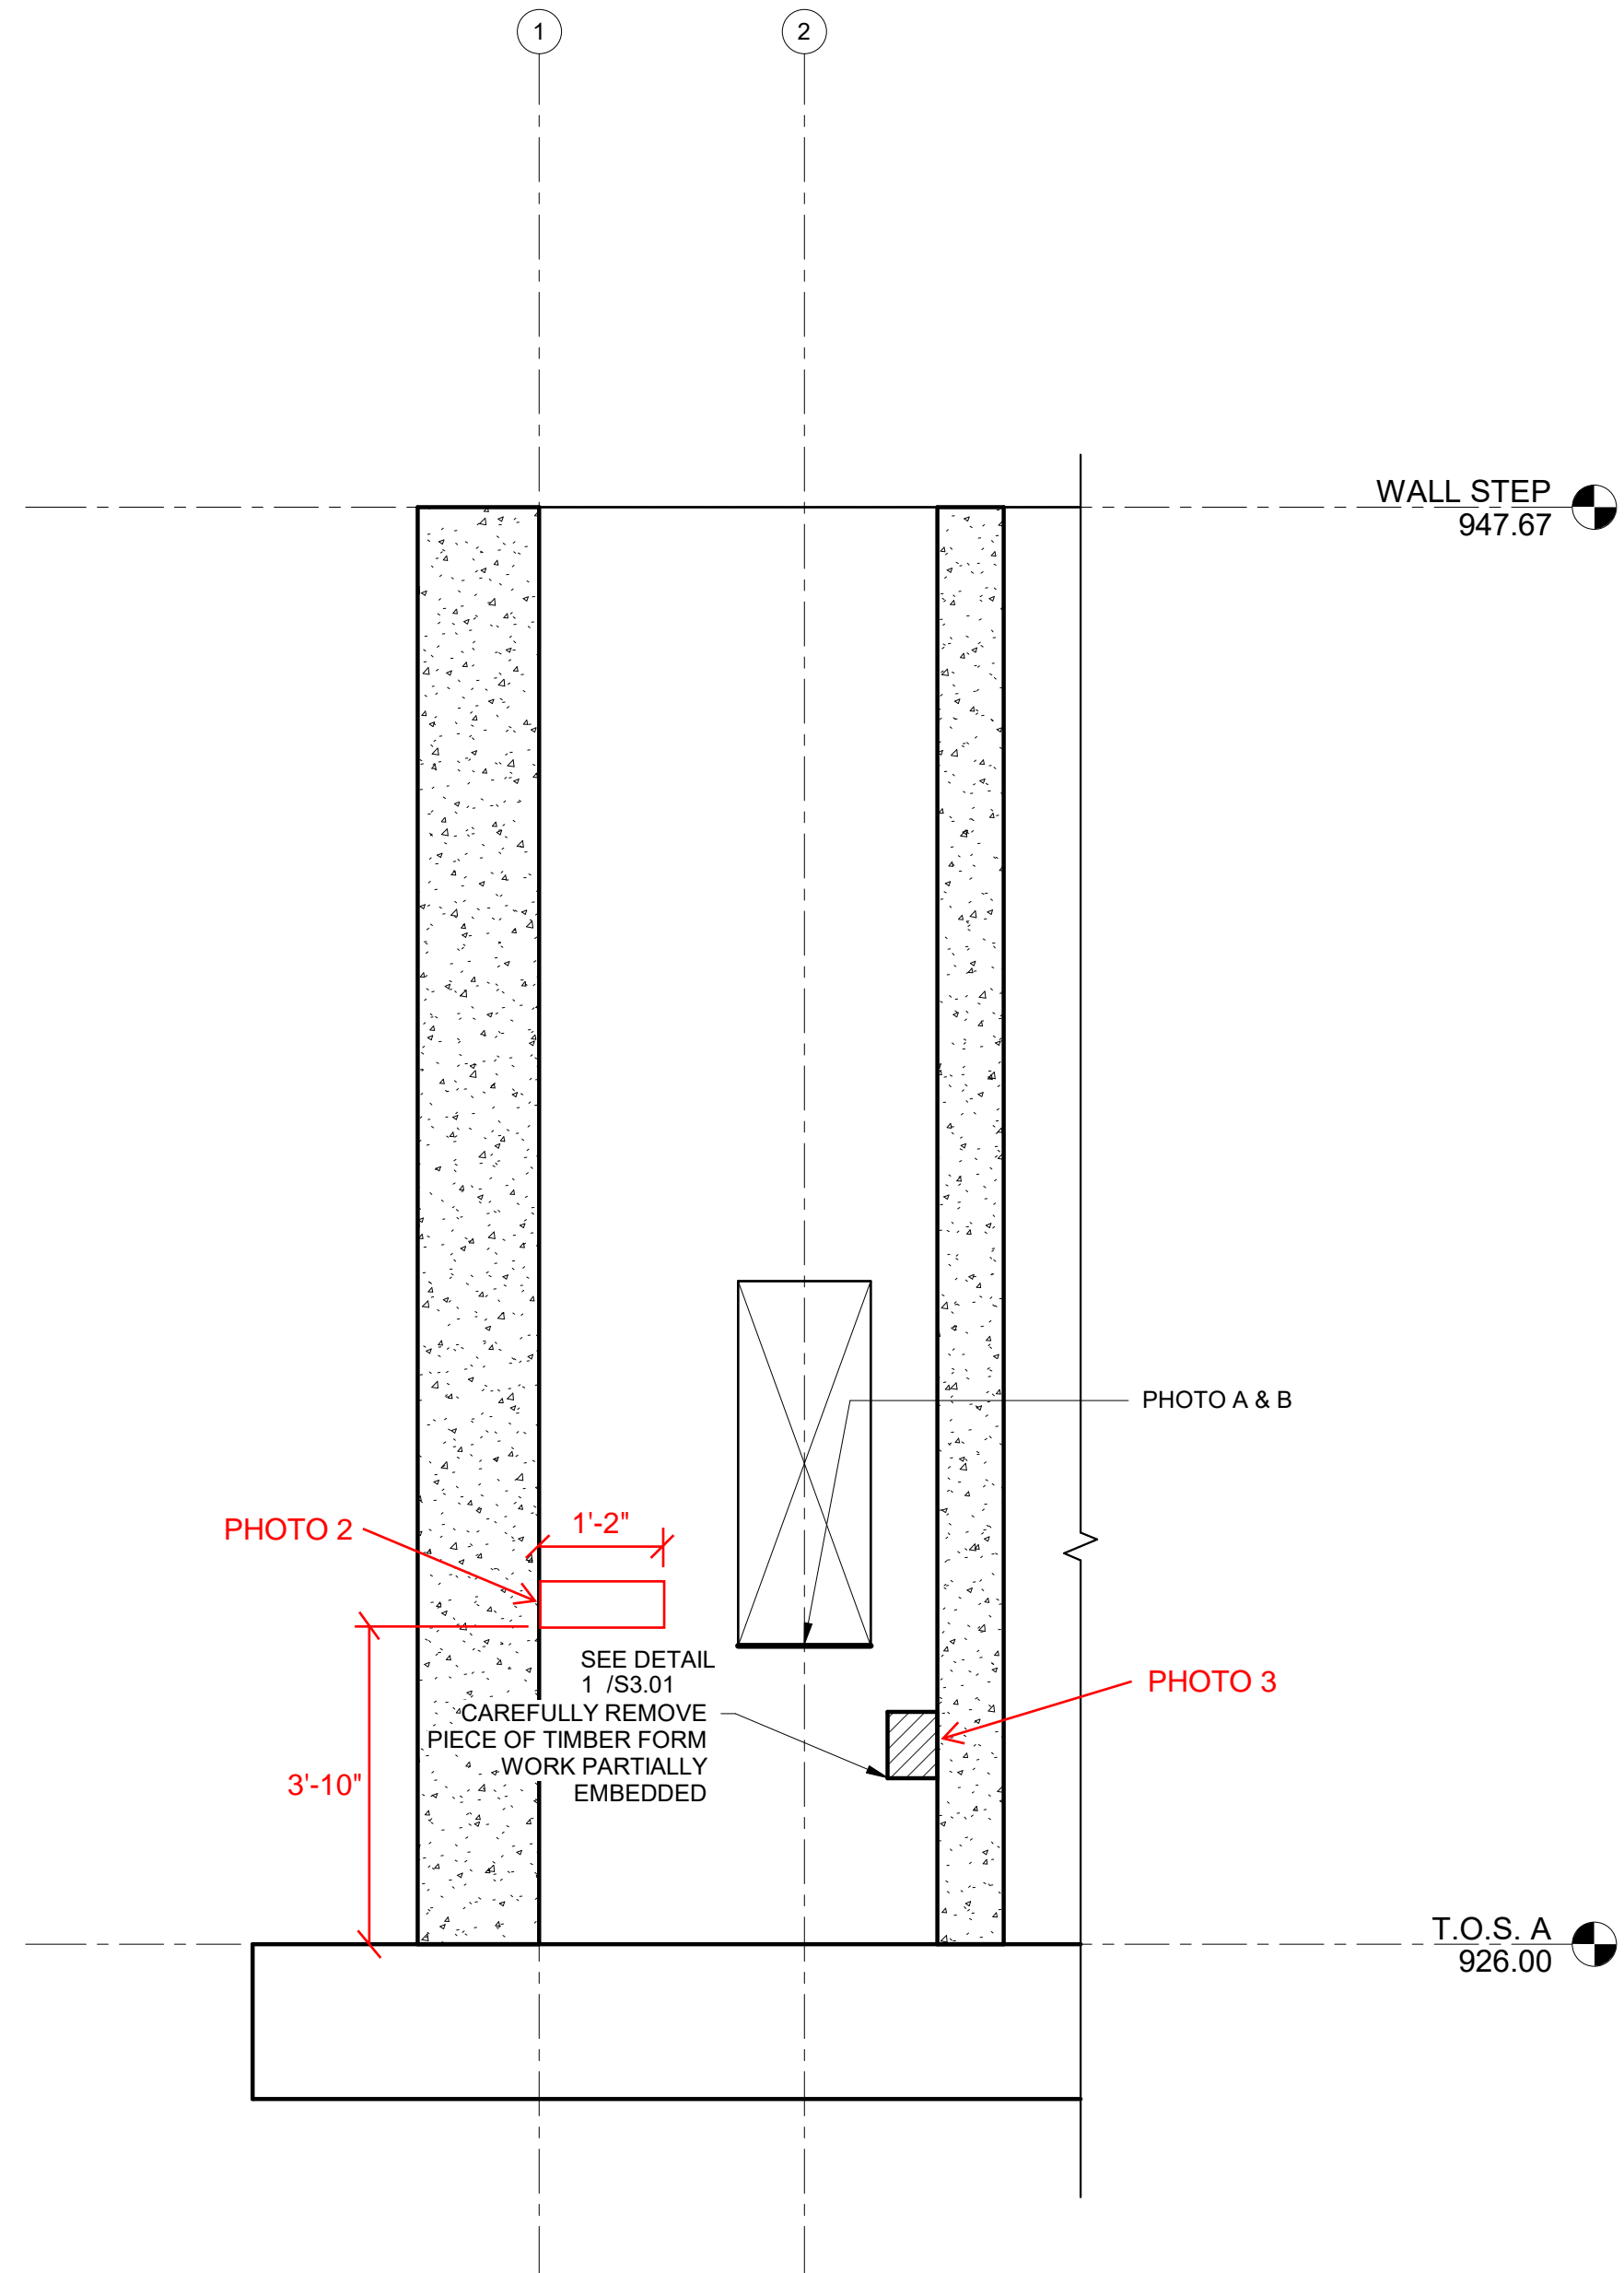



Before Repair



After Repair (fillet was already placed before the after repair photo could be taken)

PHOTO 1



Before Repair



After Repair (fillet was already placed before the after repair photo could be taken)

PHOTO 2





Before Repair



After Repair (fillet was already placed before the after repair photo could be taken)

PHOTO 3

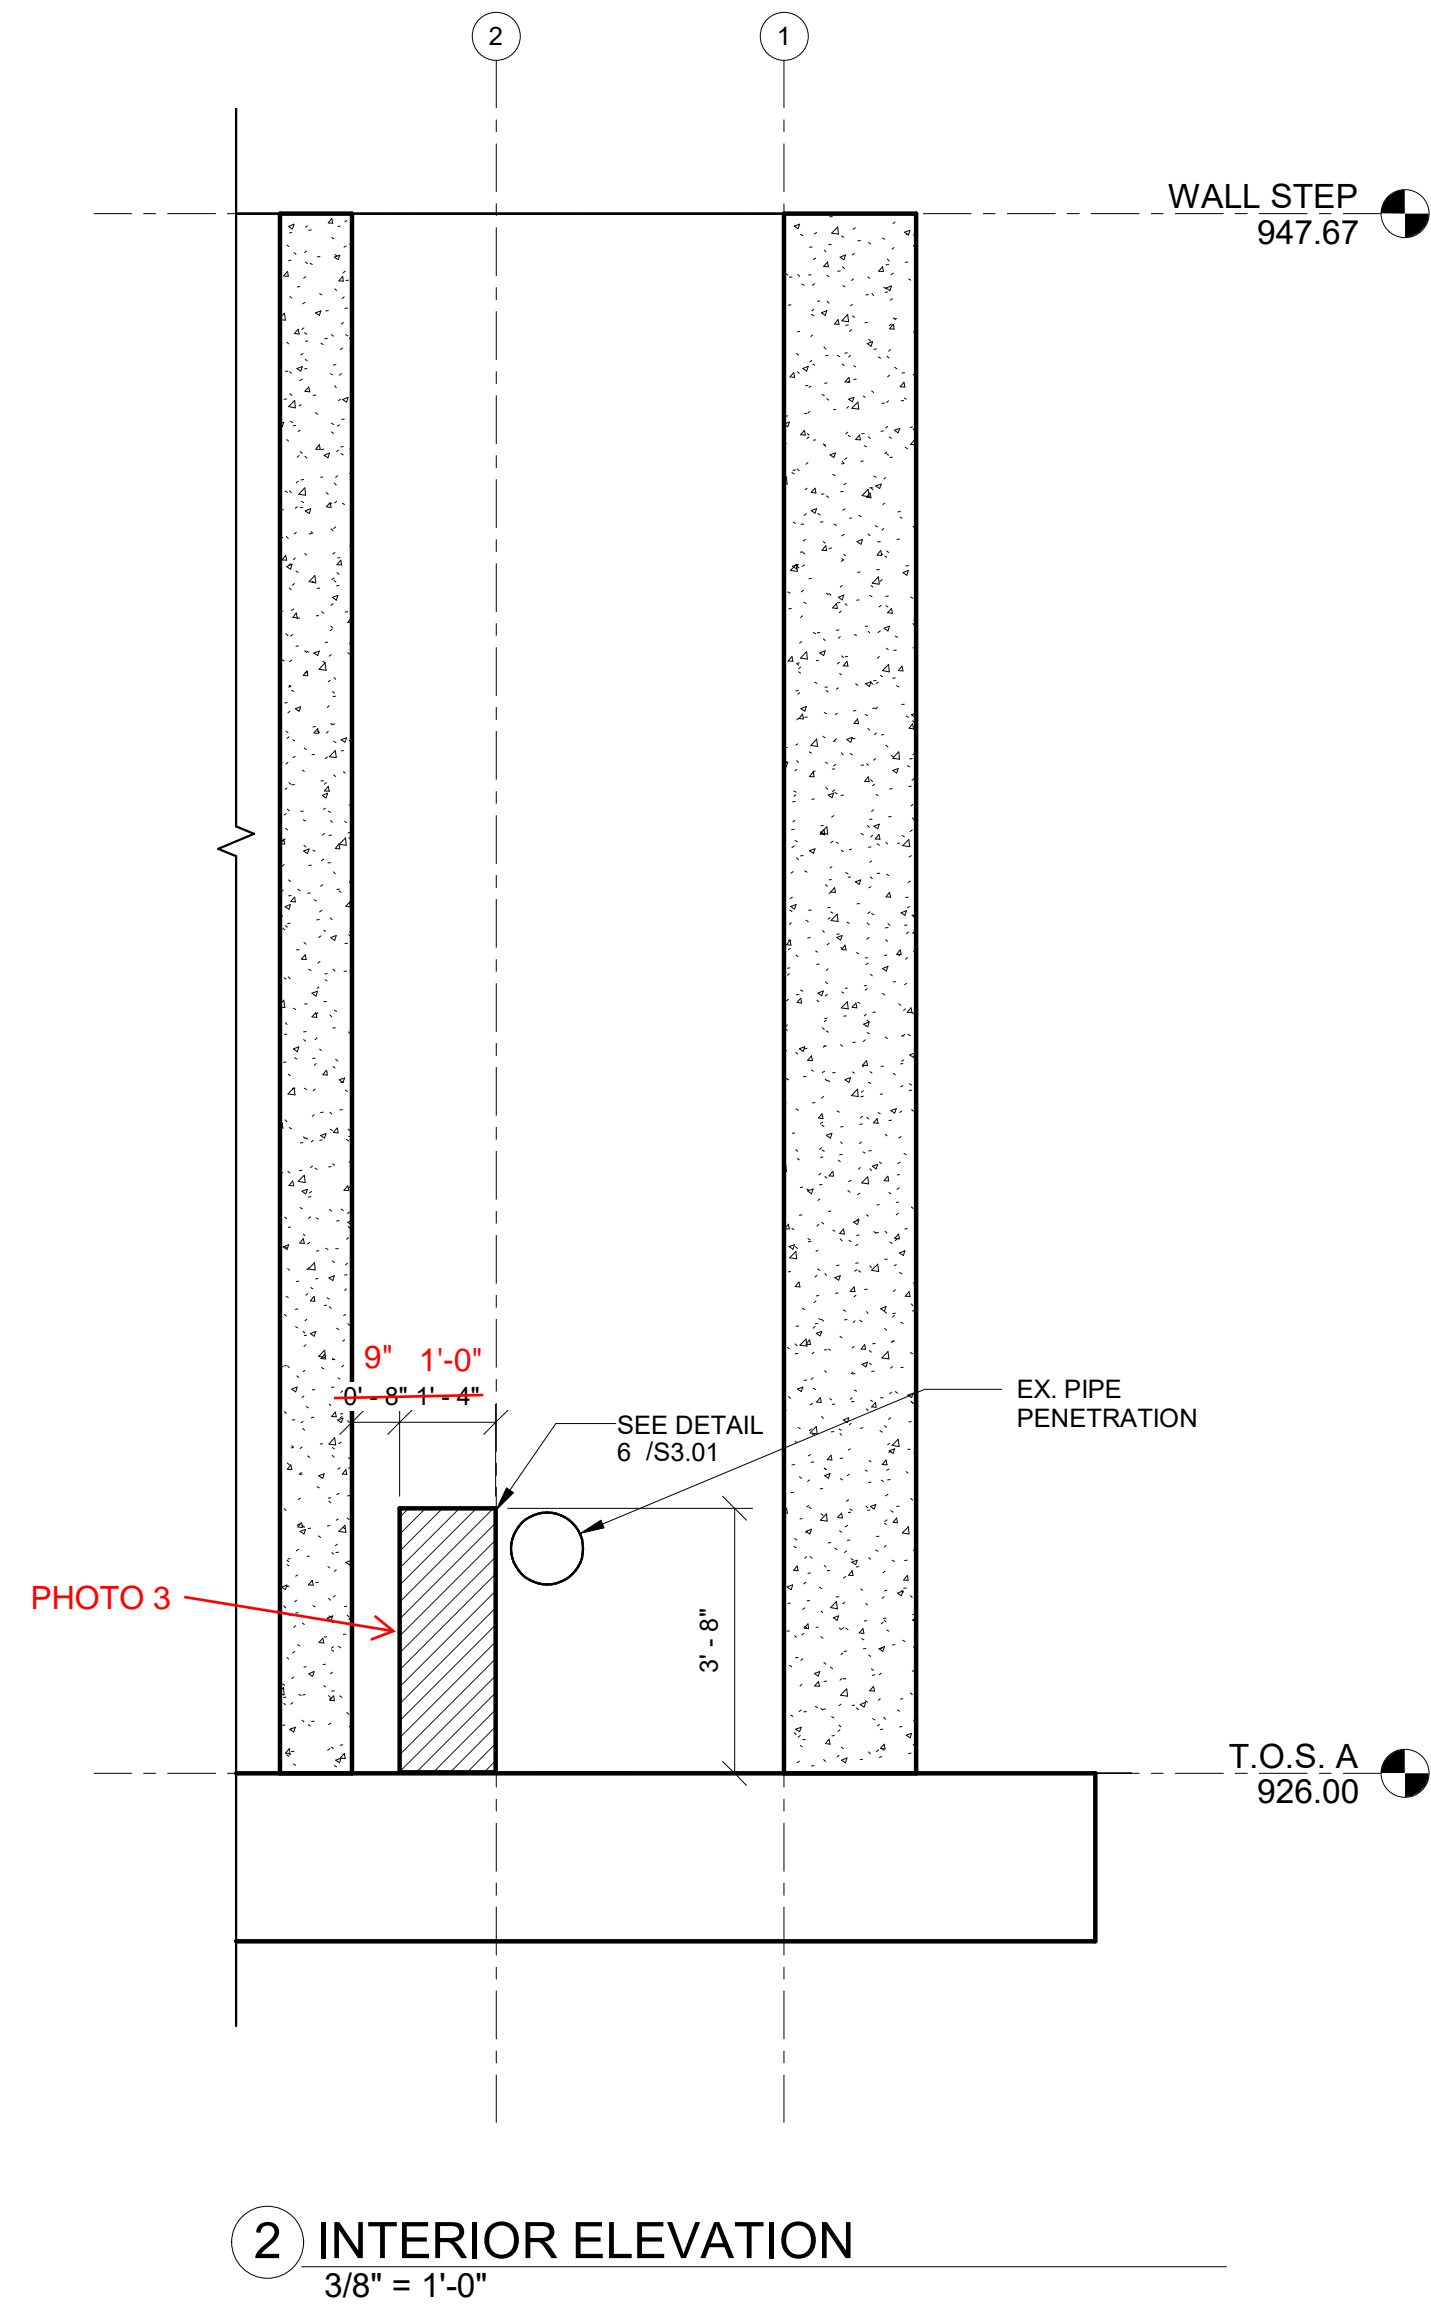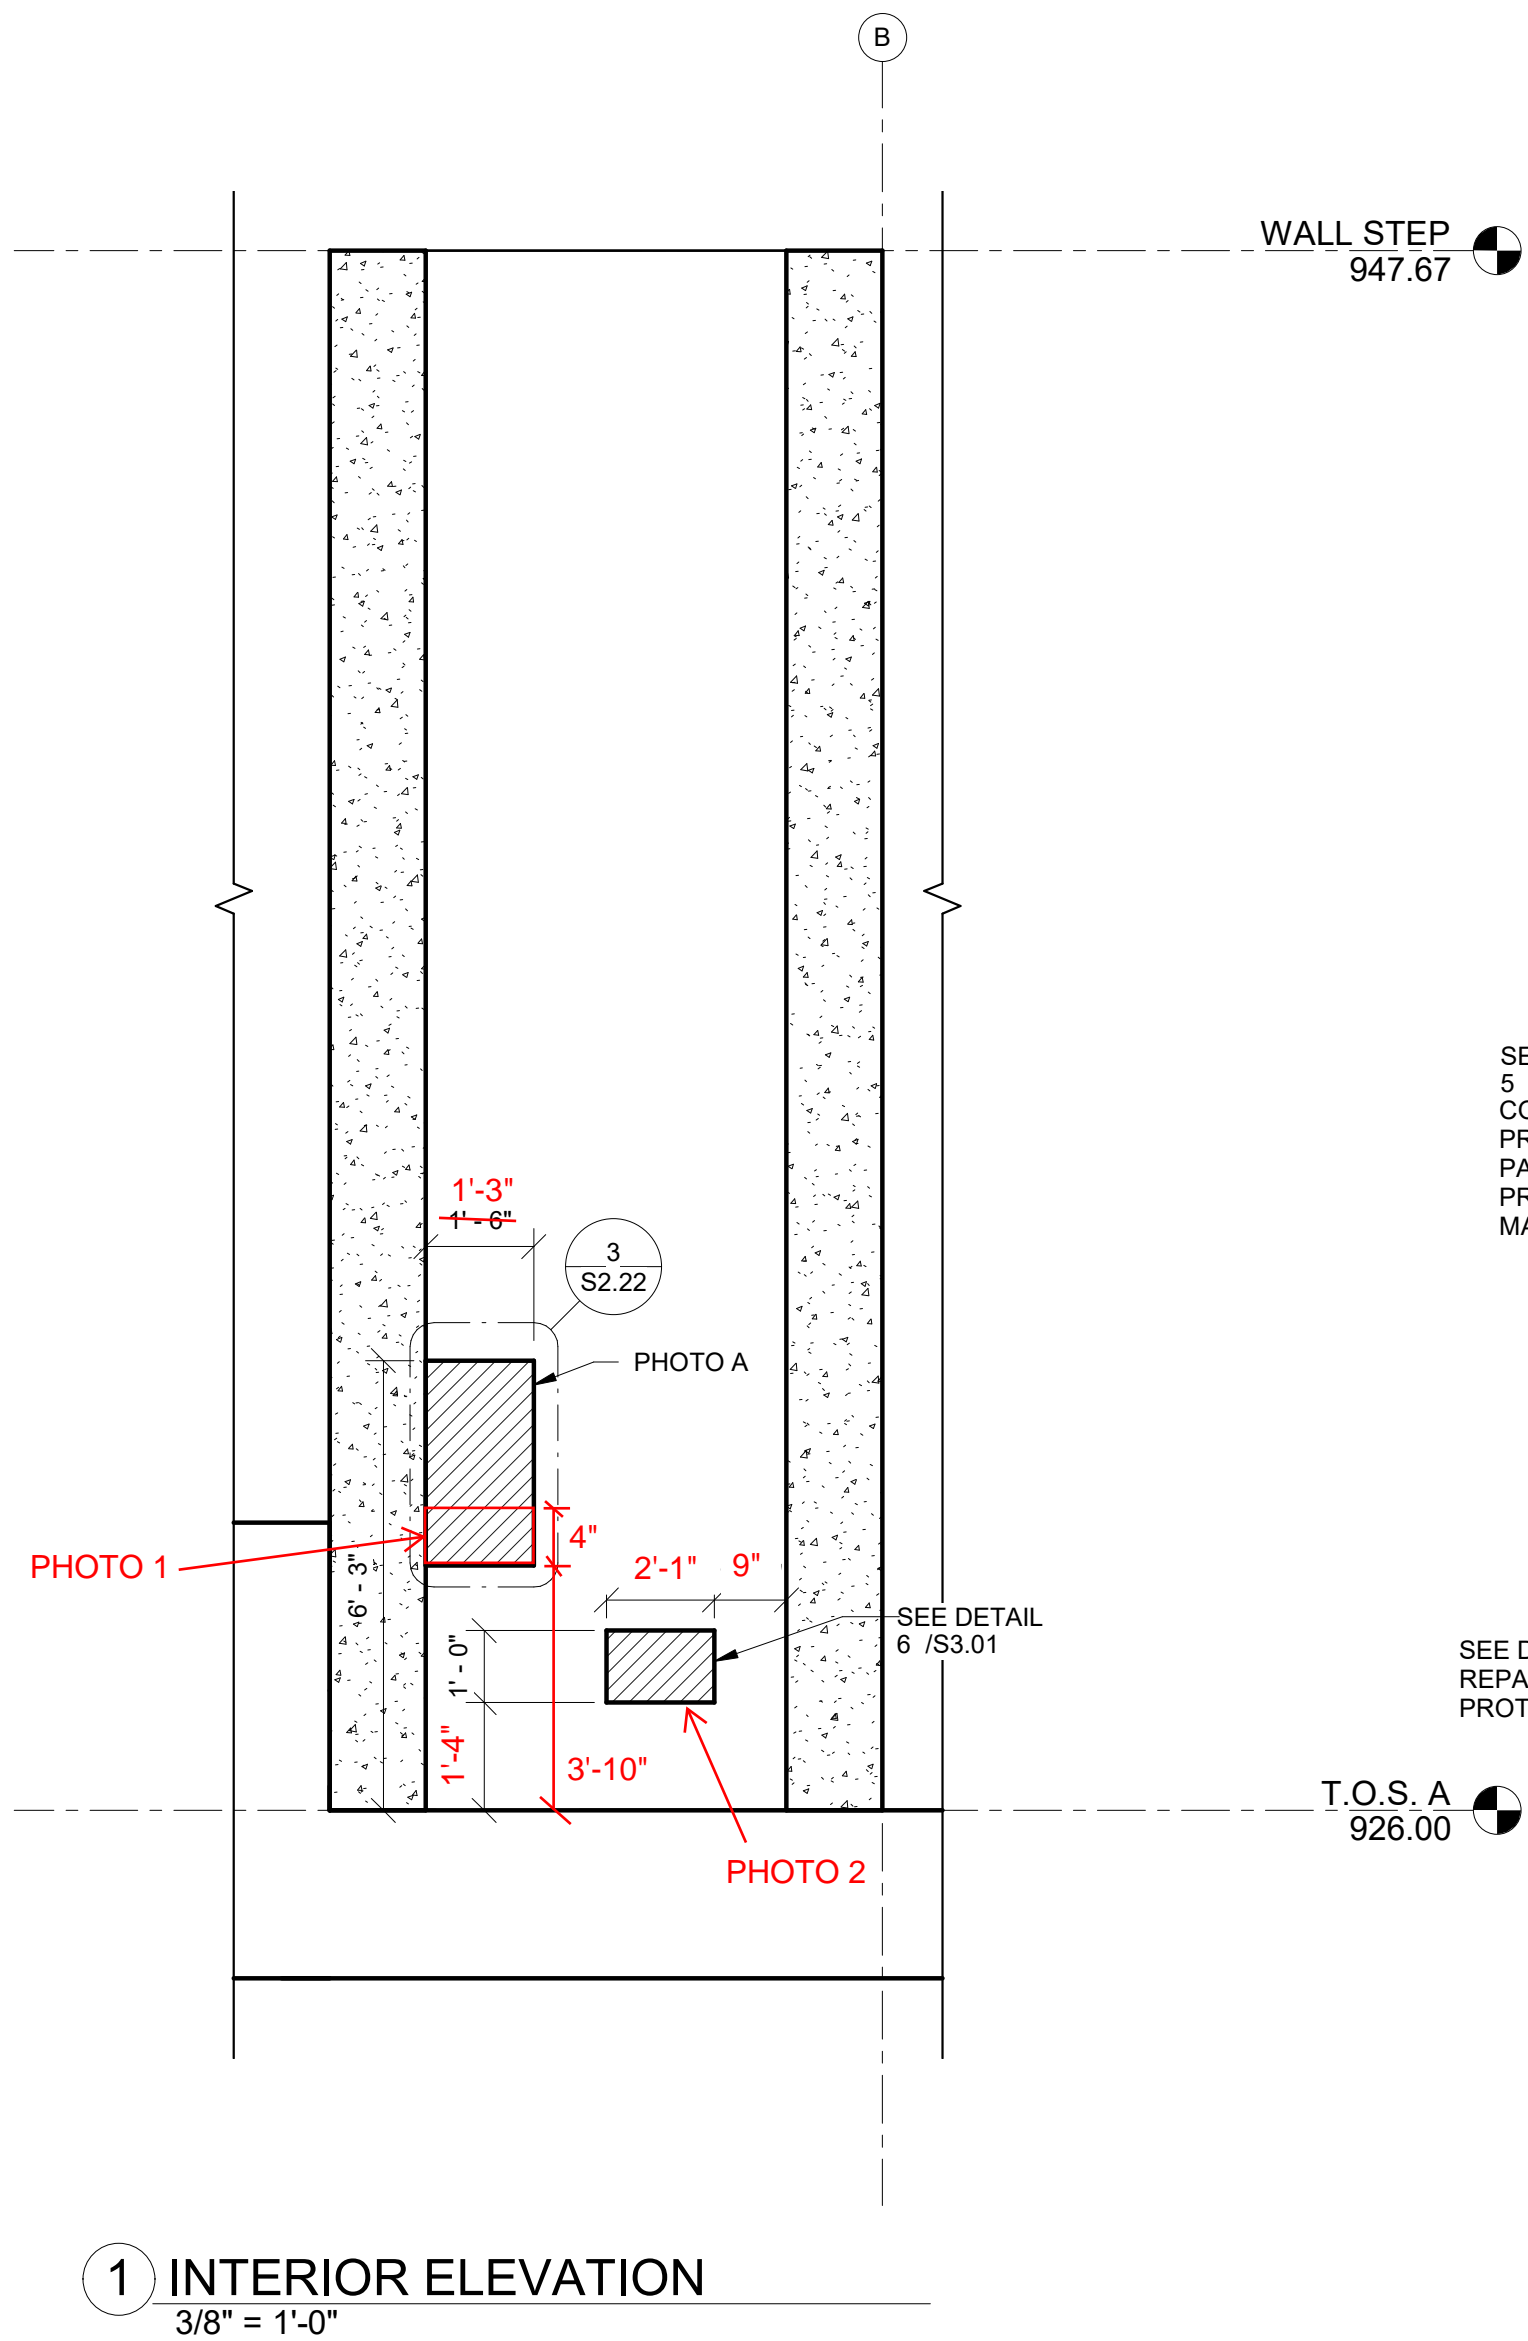

SHUCK BRITSON

400 E COURT AVE.
SUITE 140.
DES MOINES, IOWA 50309
515-243-4477
www.shuck-britson.com

NEVADA WWTP IMPROVEMENTS LIMITED
CONCRETE WALL REPAIR
BOOMERANG

457 S. 6th STREET NEVADA IOWA 50201

Project Status

PROJECT NUMBER 123.0172.03

DATE 03/24/2023

WALL ELEVATIONS

SHEET NO.

S2.22



Before Repair



After Repair (fillet was already placed before the after repair photo could be taken)

PHOTO 1



Before Repair



After Repair (fillet was already placed before the after repair photo could be taken)

PHOTO 2




Before Repair



After Repair (fillet was already placed before the after repair photo could be taken)

PHOTO 3

3/24/2023 5:11:59 PM
C:\Users\chris\Documents\123.0172.03_STRUC_R220_chris\6BDR.vrt

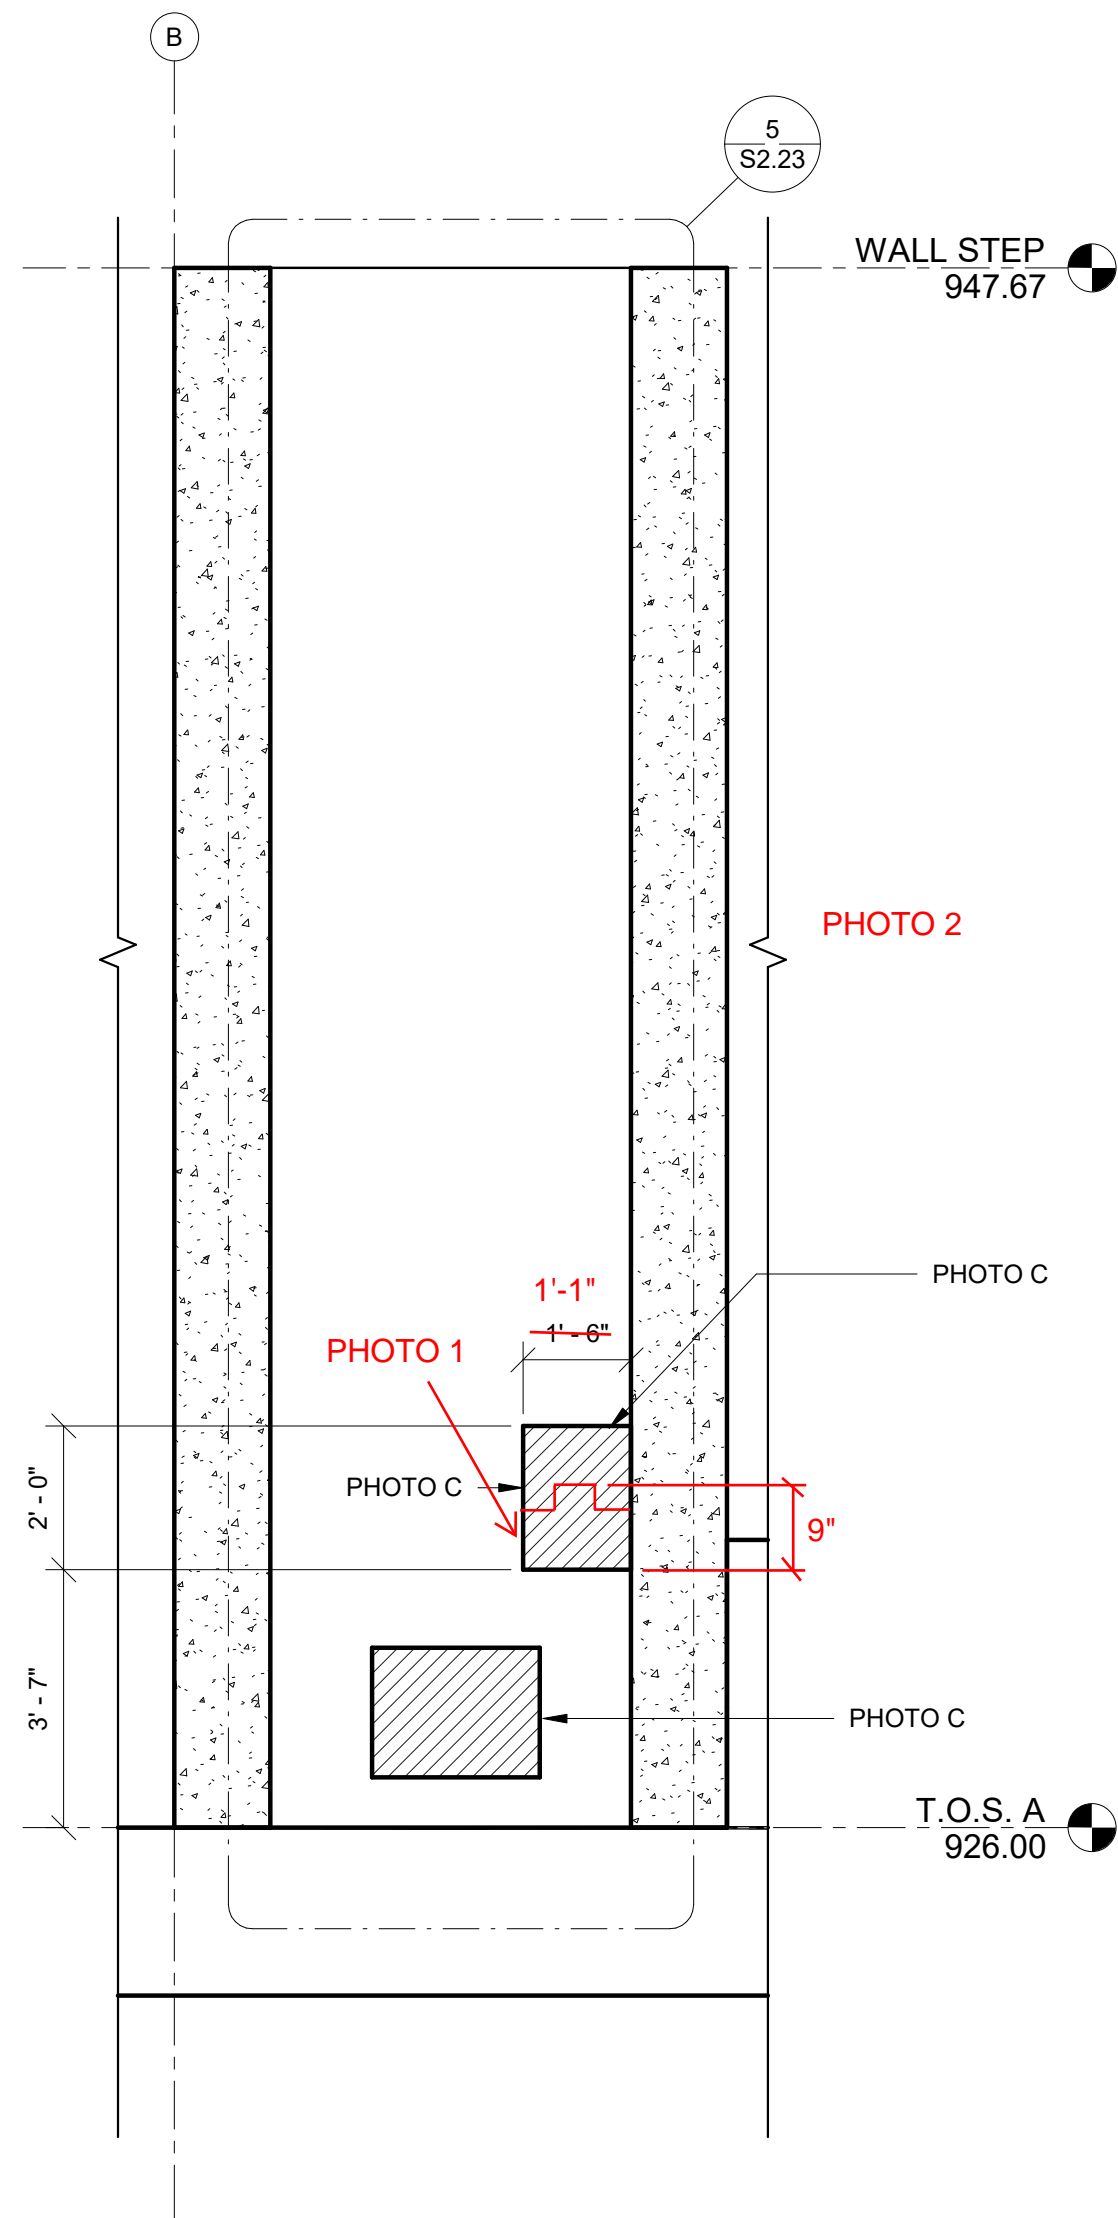

1 INTERIOR ELEVATION
3/8" = 1'-0"


SEE DETAIL
5 /S3.01
COORDINATE CONC.
PROTECTION LINER
PANEL JOINT SEALING
PRIOR TO REPAIR W/
MANUFACTURER

NO REPAIR REQUIRED
AREA SHALL BE FILLED W/ CONC. FILL AS
SPECIFIED ON ORIGINAL CONSTRUCTION
DOCUMENTS. THIS WILL SERVE AS
ADEQUATE CONC. COVER




5 PHOTO C

SEE DETAIL 6/S3.01 FOR
REPAIR BELOW CONCRETE
PROTECTION LINER

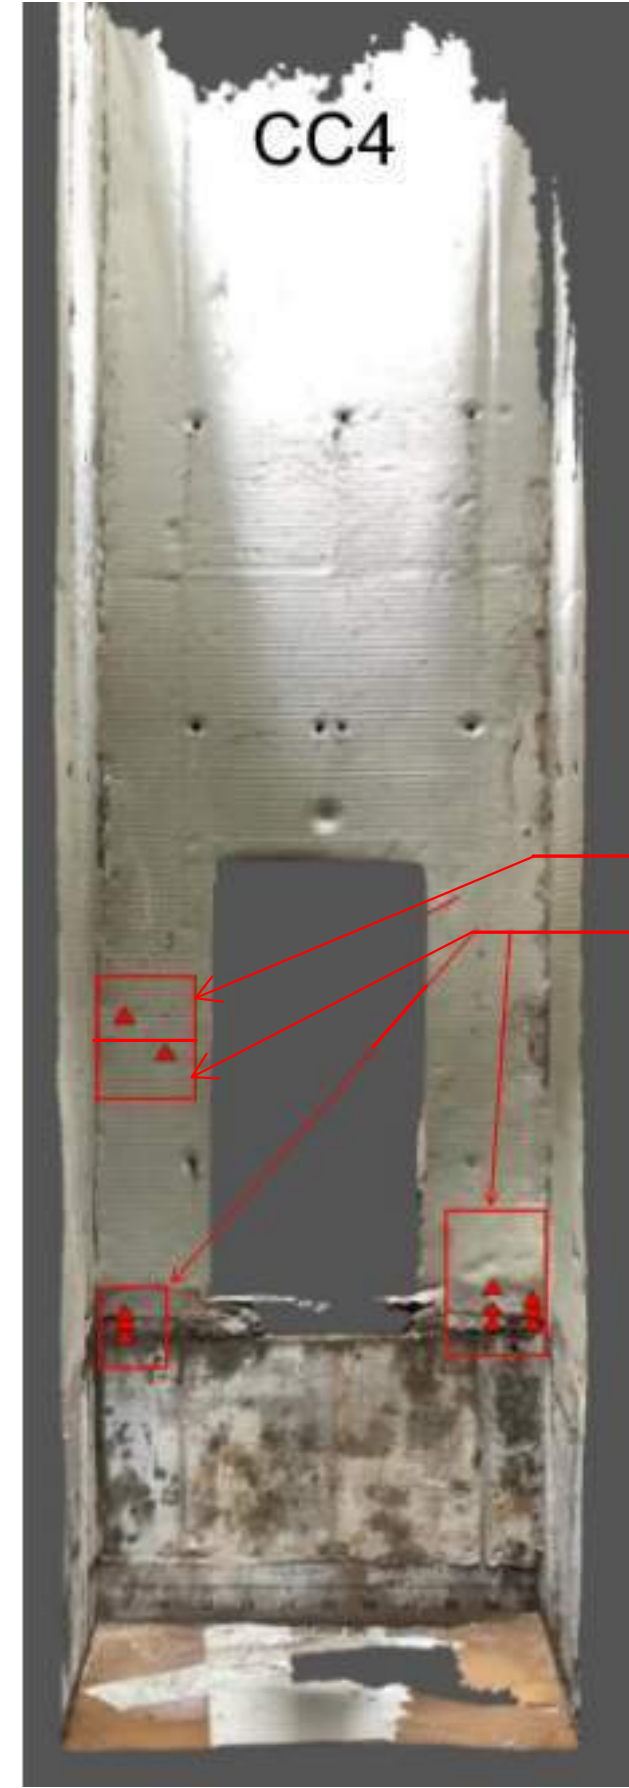

6 PHOTO D
1 1/2" = 1'-0"

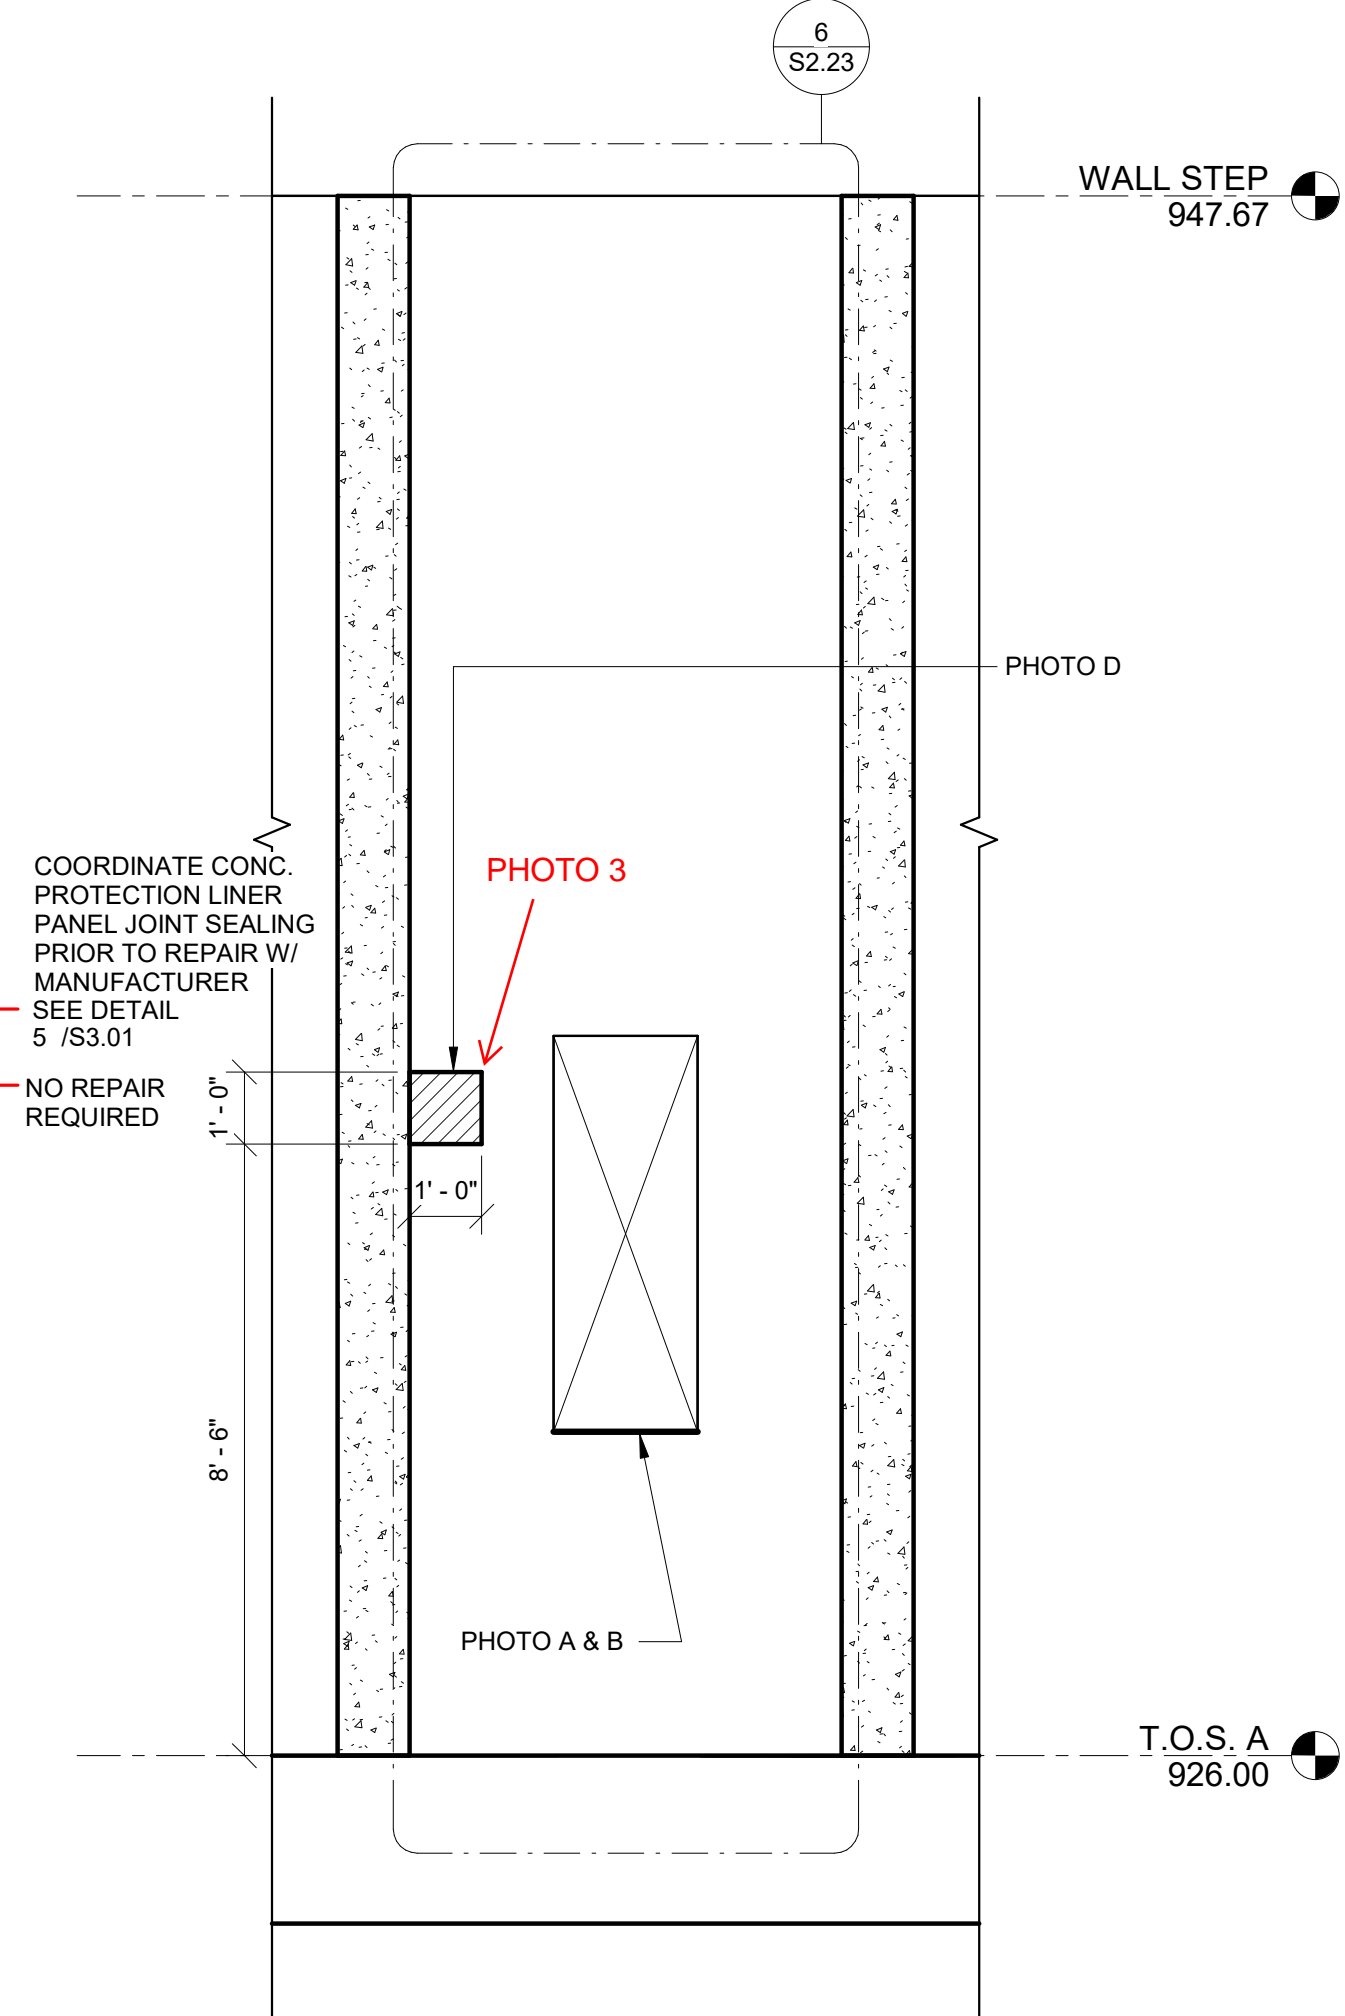

2 INTERIOR ELEVATION
3/8" = 1'-0"



3 PHOTO A



4 PHOTO B
1" = 1'-0"



SHUCK BRITSON

400 E COURT AVE.
SUITE 140.
DES MOINES, IOWA 50309
515-243-4477
www.shuck-britson.com

NEVADA WWTP IMPROVEMENTS LIMITED
CONCRETE WALL REPAIR
BOOMERANG

457 S. 6th STREET NEVADA IOWA 50201

Project Status

PROJECT NUMBER 123.0172.03

DATE 03/24/2023

WALL ELEVATIONS

SHEET NO.

S2.23



Before Repair



After Repair (fillet was already placed before the after repair photo could be taken)

PHOTO 1



Before Repair



After Repair (fillet was already placed prior to the before and after repair photo could be taken)

PHOTO 2




Before Repair




After Repair

PHOTO 3

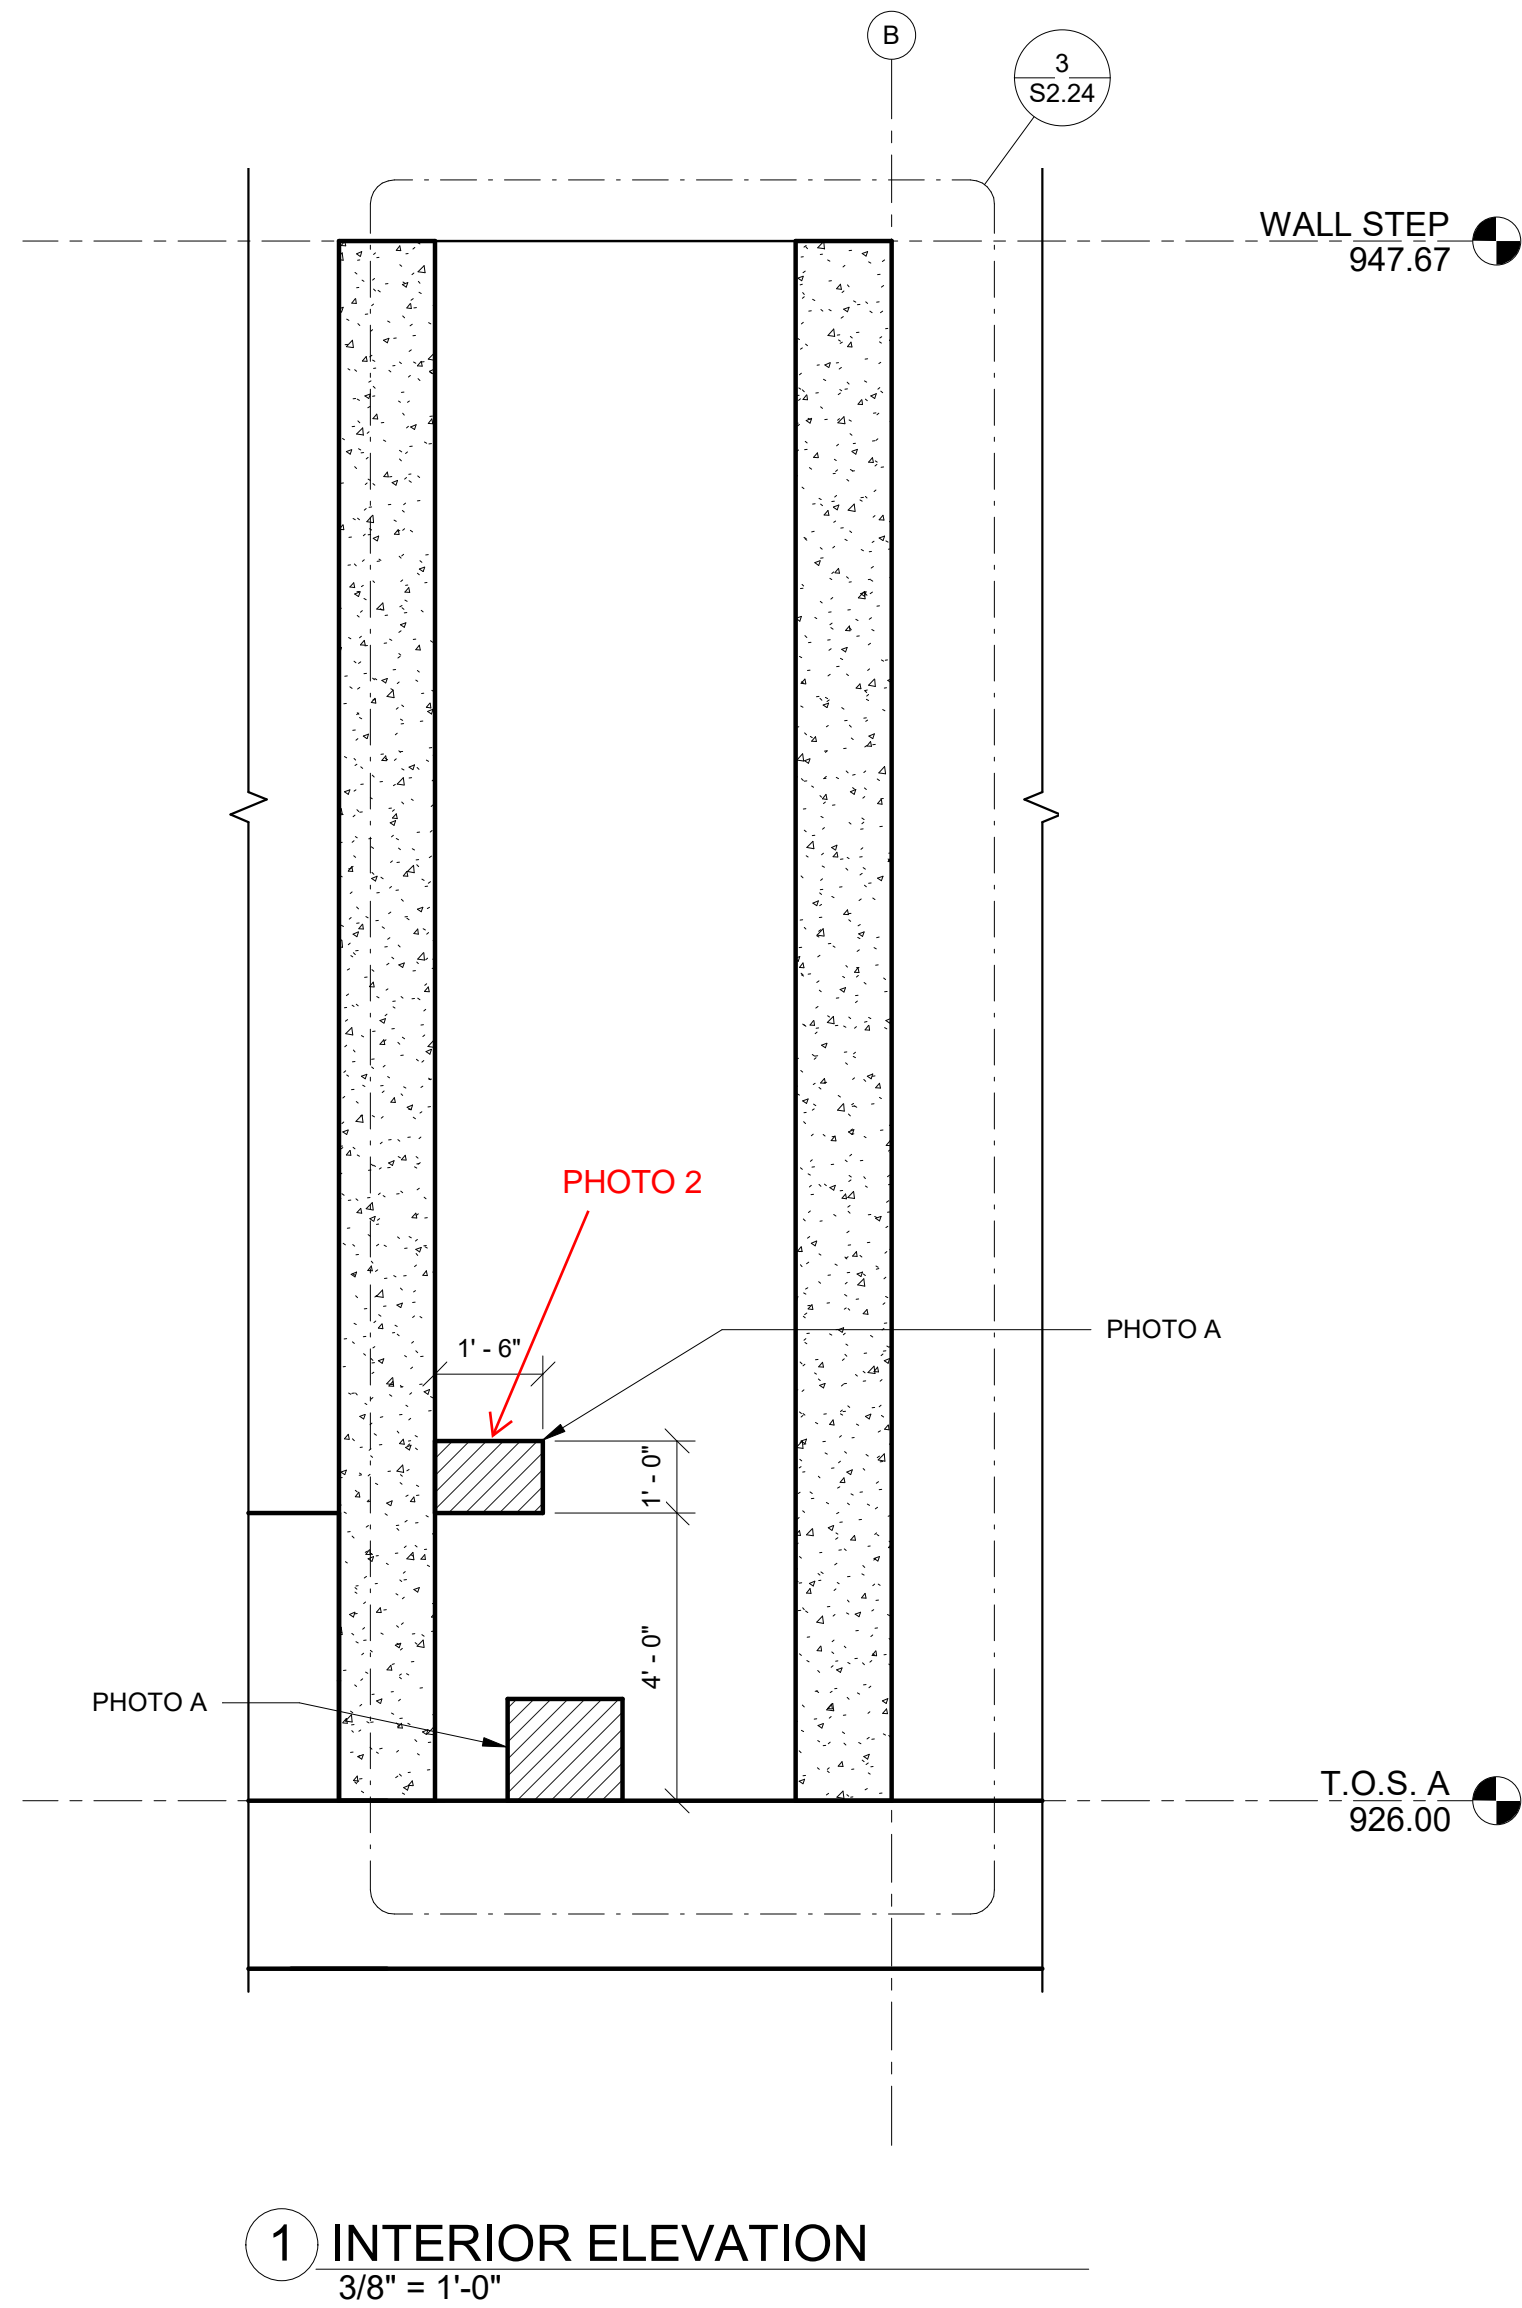

SEE DETAIL 6/S3.01 FOR REPAIR
BELOW CONCRETE PROTECTION
LINER

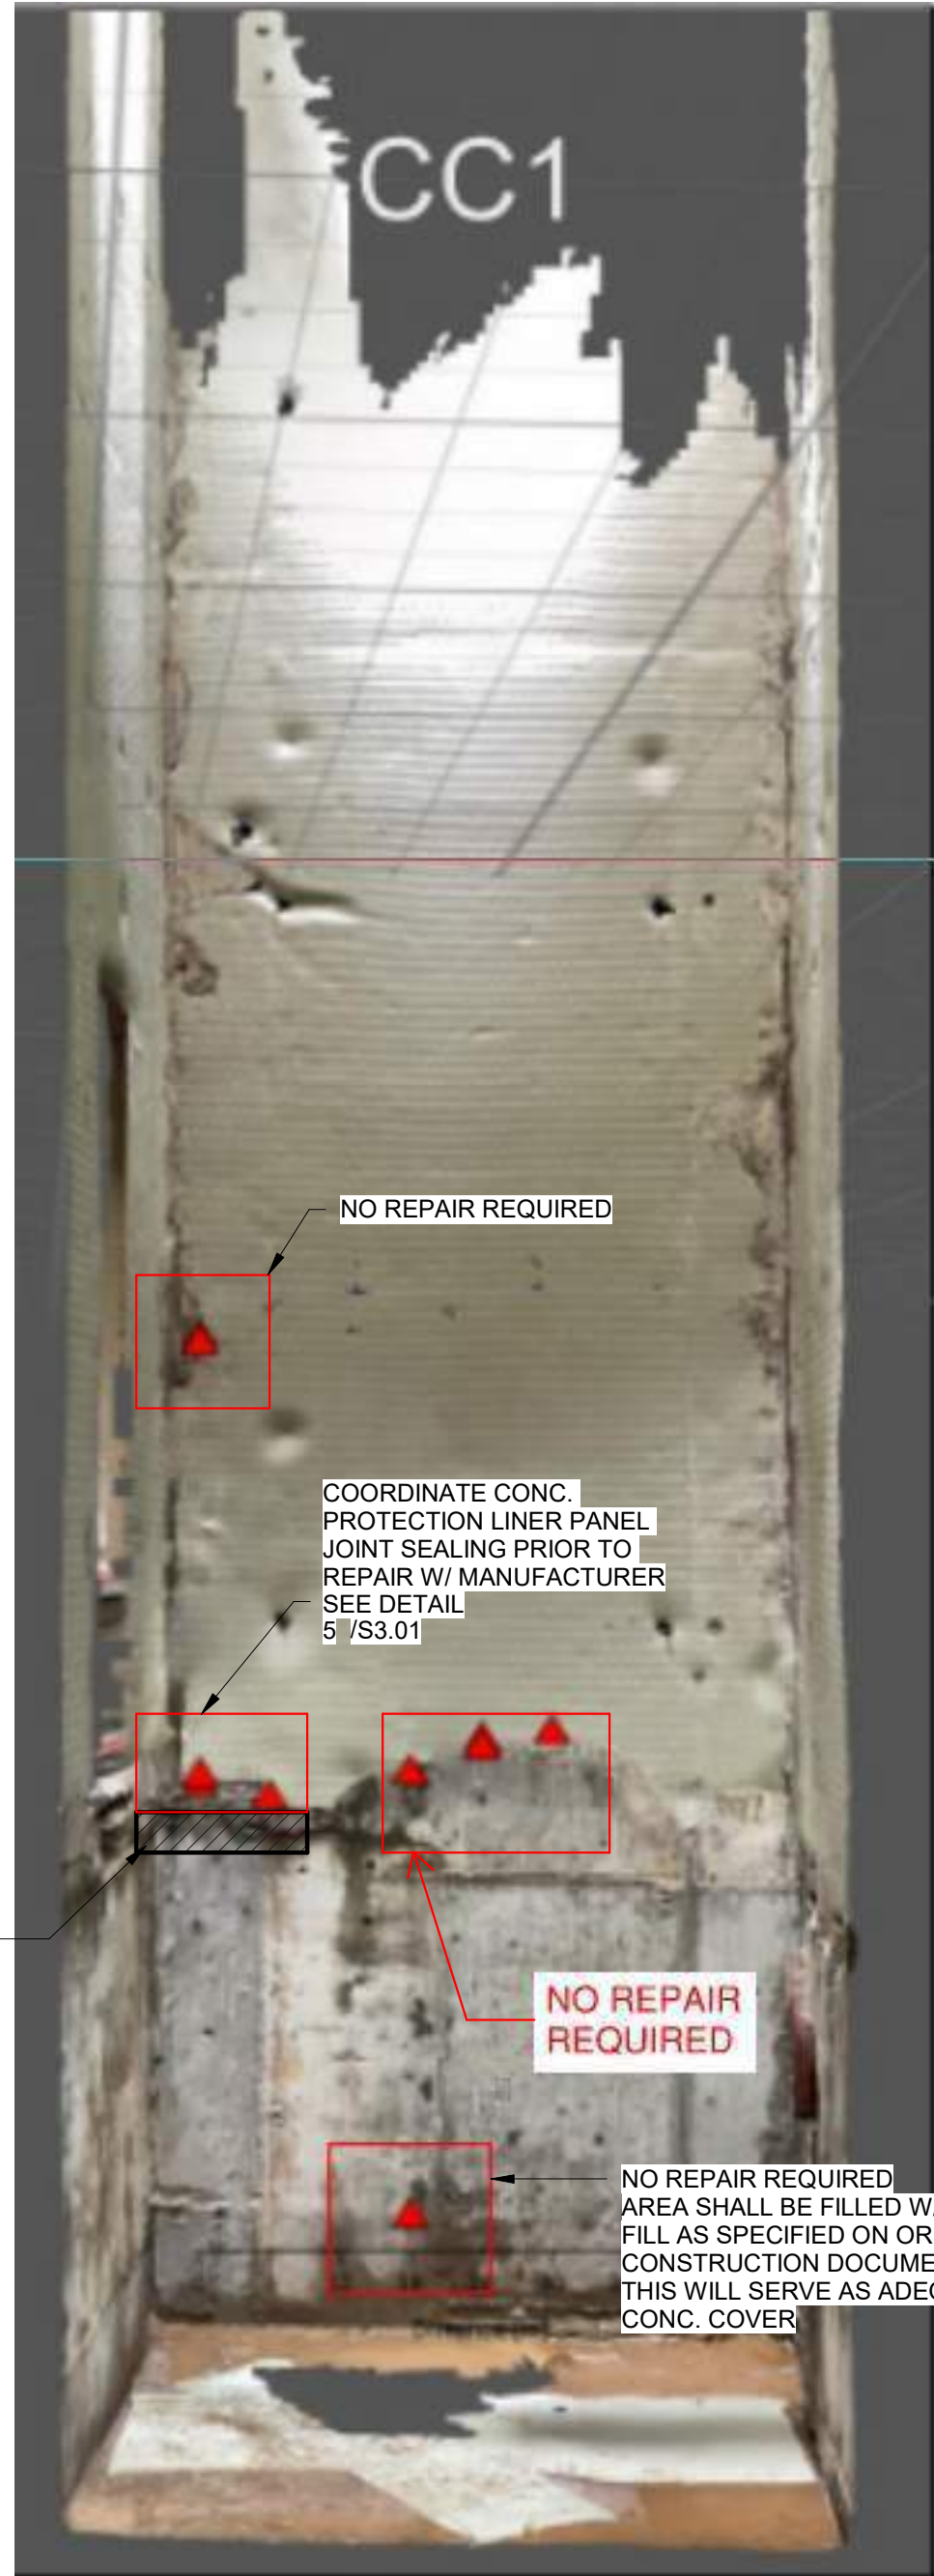

NO REPAIR REQUIRED


COORDINATE CONC.
PROTECTION LINER PANEL
JOINT SEALING PRIOR TO
REPAIR W/ MANUFACTURER
SEE DETAIL
5/S3.01

NO REPAIR
REQUIRED

NO REPAIR REQUIRED
AREA SHALL BE FILLED W/ CONC.
FILL AS SPECIFIED ON ORIGINAL
CONSTRUCTION DOCUMENTS.
THIS WILL SERVE AS ADEQUATE
CONC. COVER

▲ Potential Void

3 PHOTO A

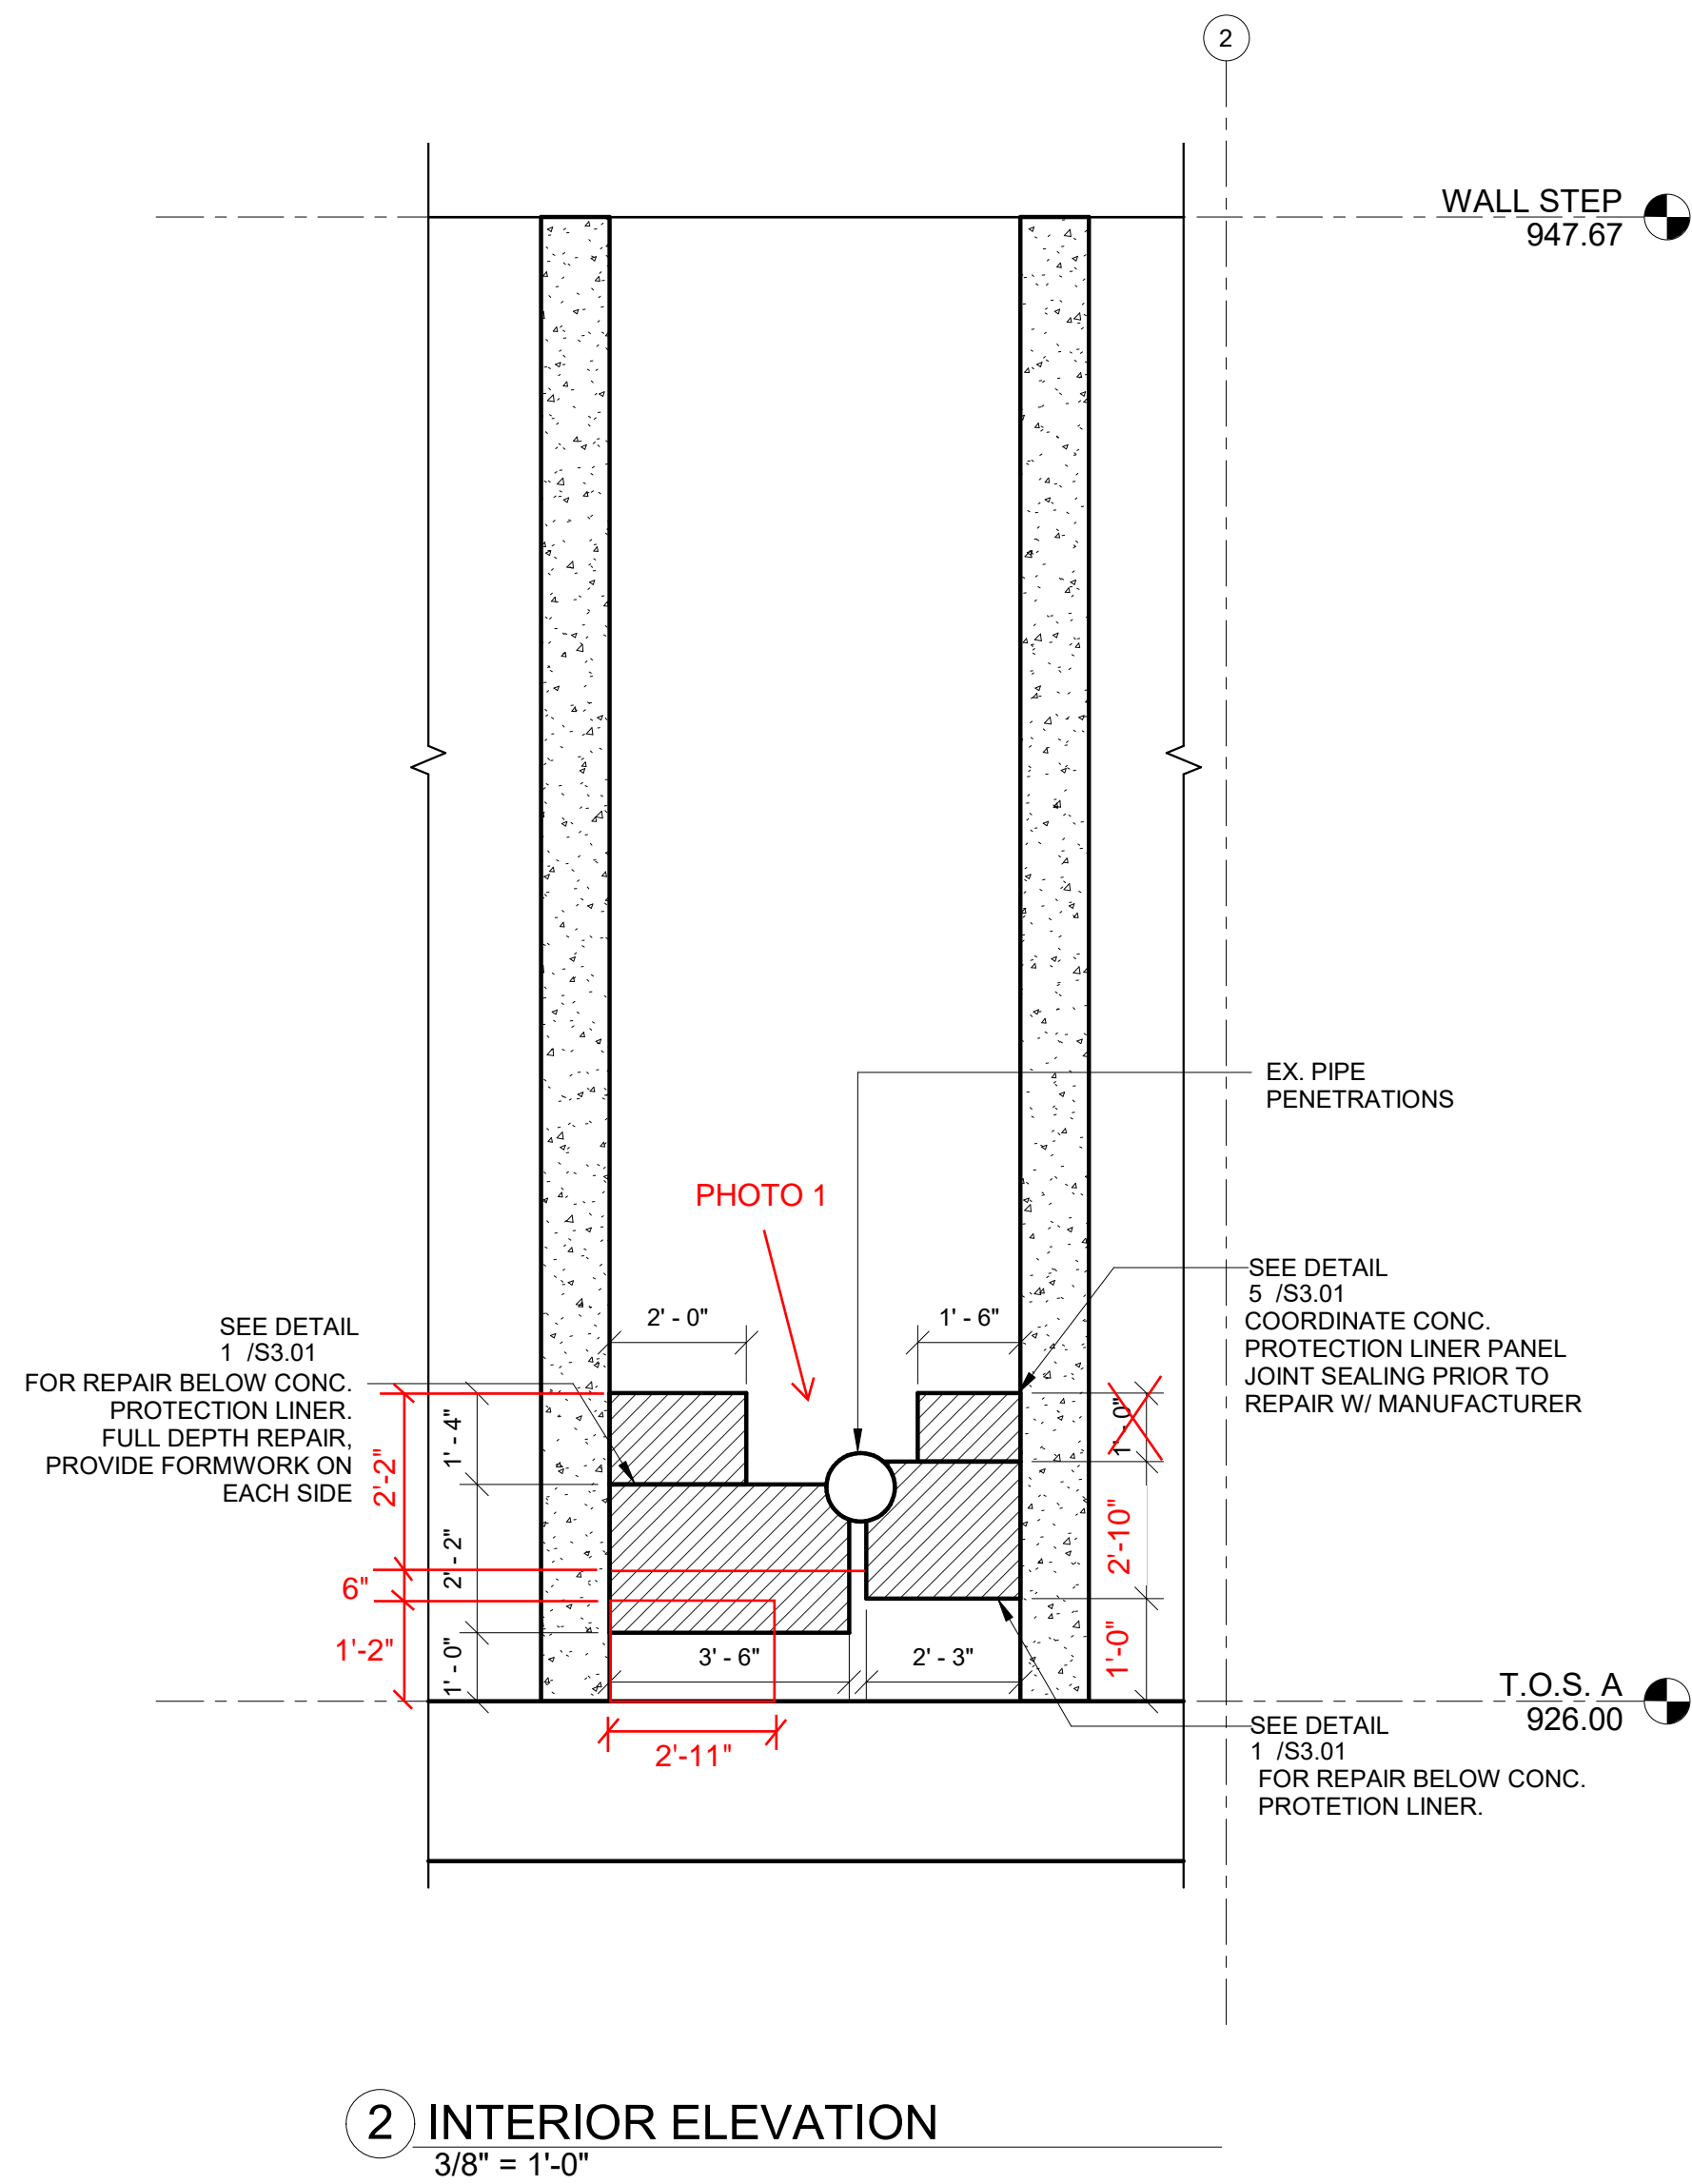

EX. PIPE
PENETRATIONS

SEE DETAIL
5 /S3.01
COORDINATE CONC.
PROTECTION LINER PANEL
JOINT SEALING PRIOR TO
REPAIR W/ MANUFACTURER

SEE DETAIL
1 /S3.01
FOR REPAIR BELOW CONC.
PROTECTION LINER.



Before Repair



Before Repair



Before Repair



After Repair (fillet was already placed prior to the after repair photo could be taken)

PHOTO 1






Before Repair



After Repair (fillet was already placed prior to the before and after repair photo could be taken)

PHOTO 2

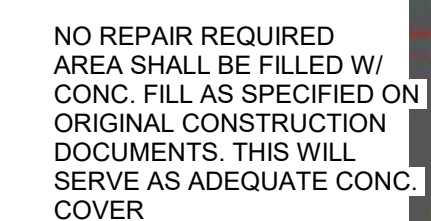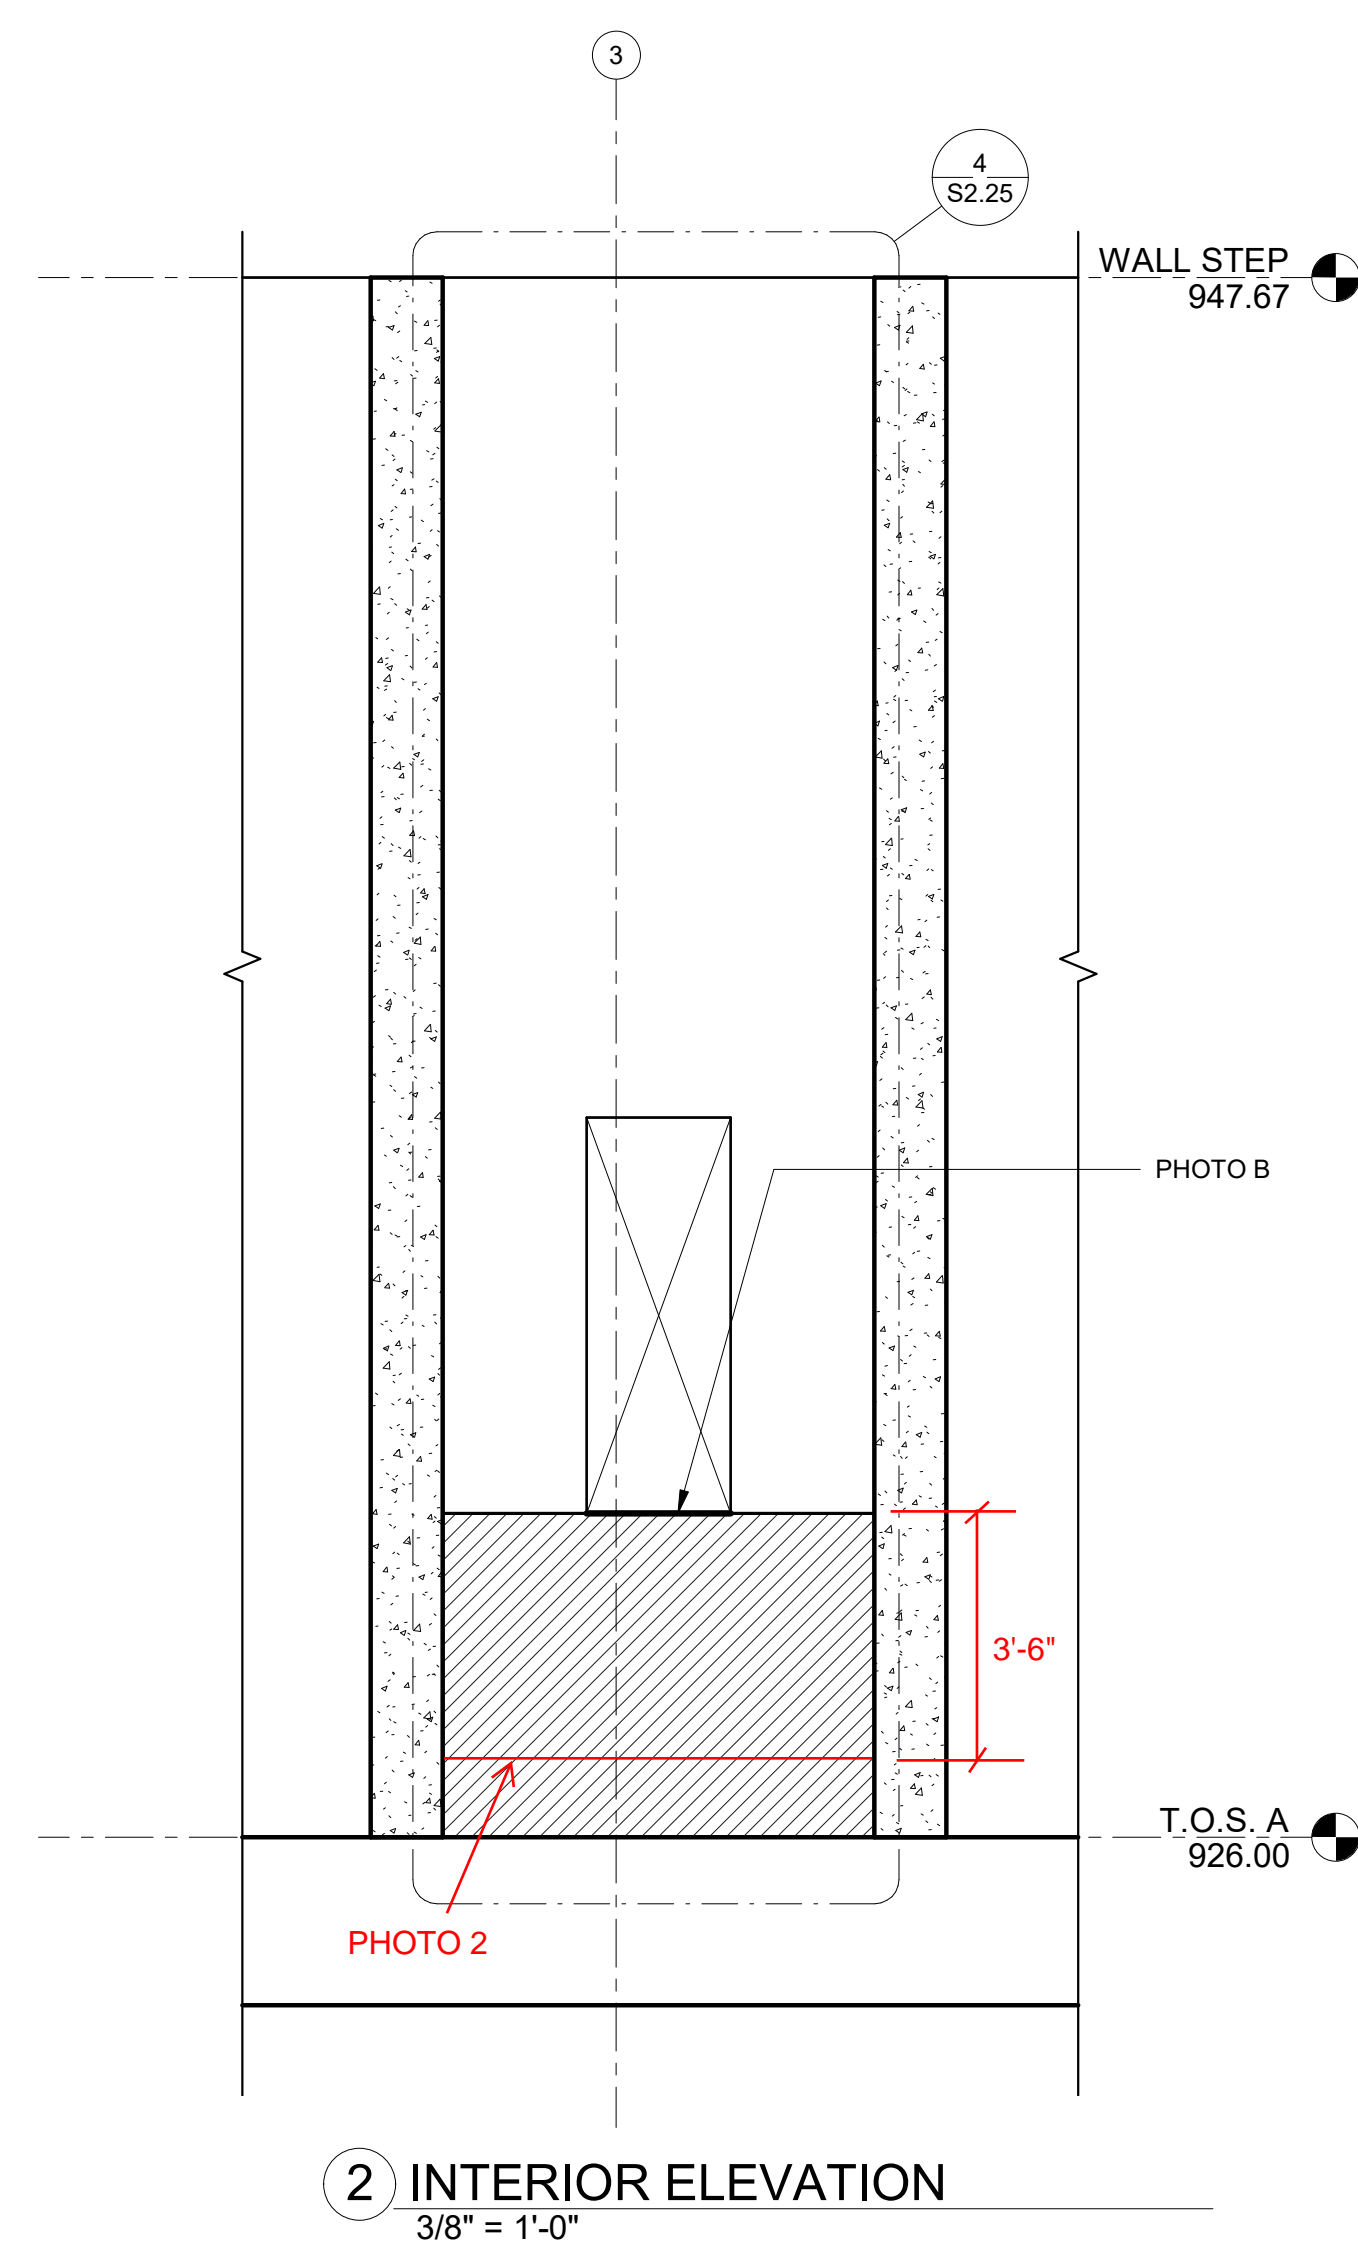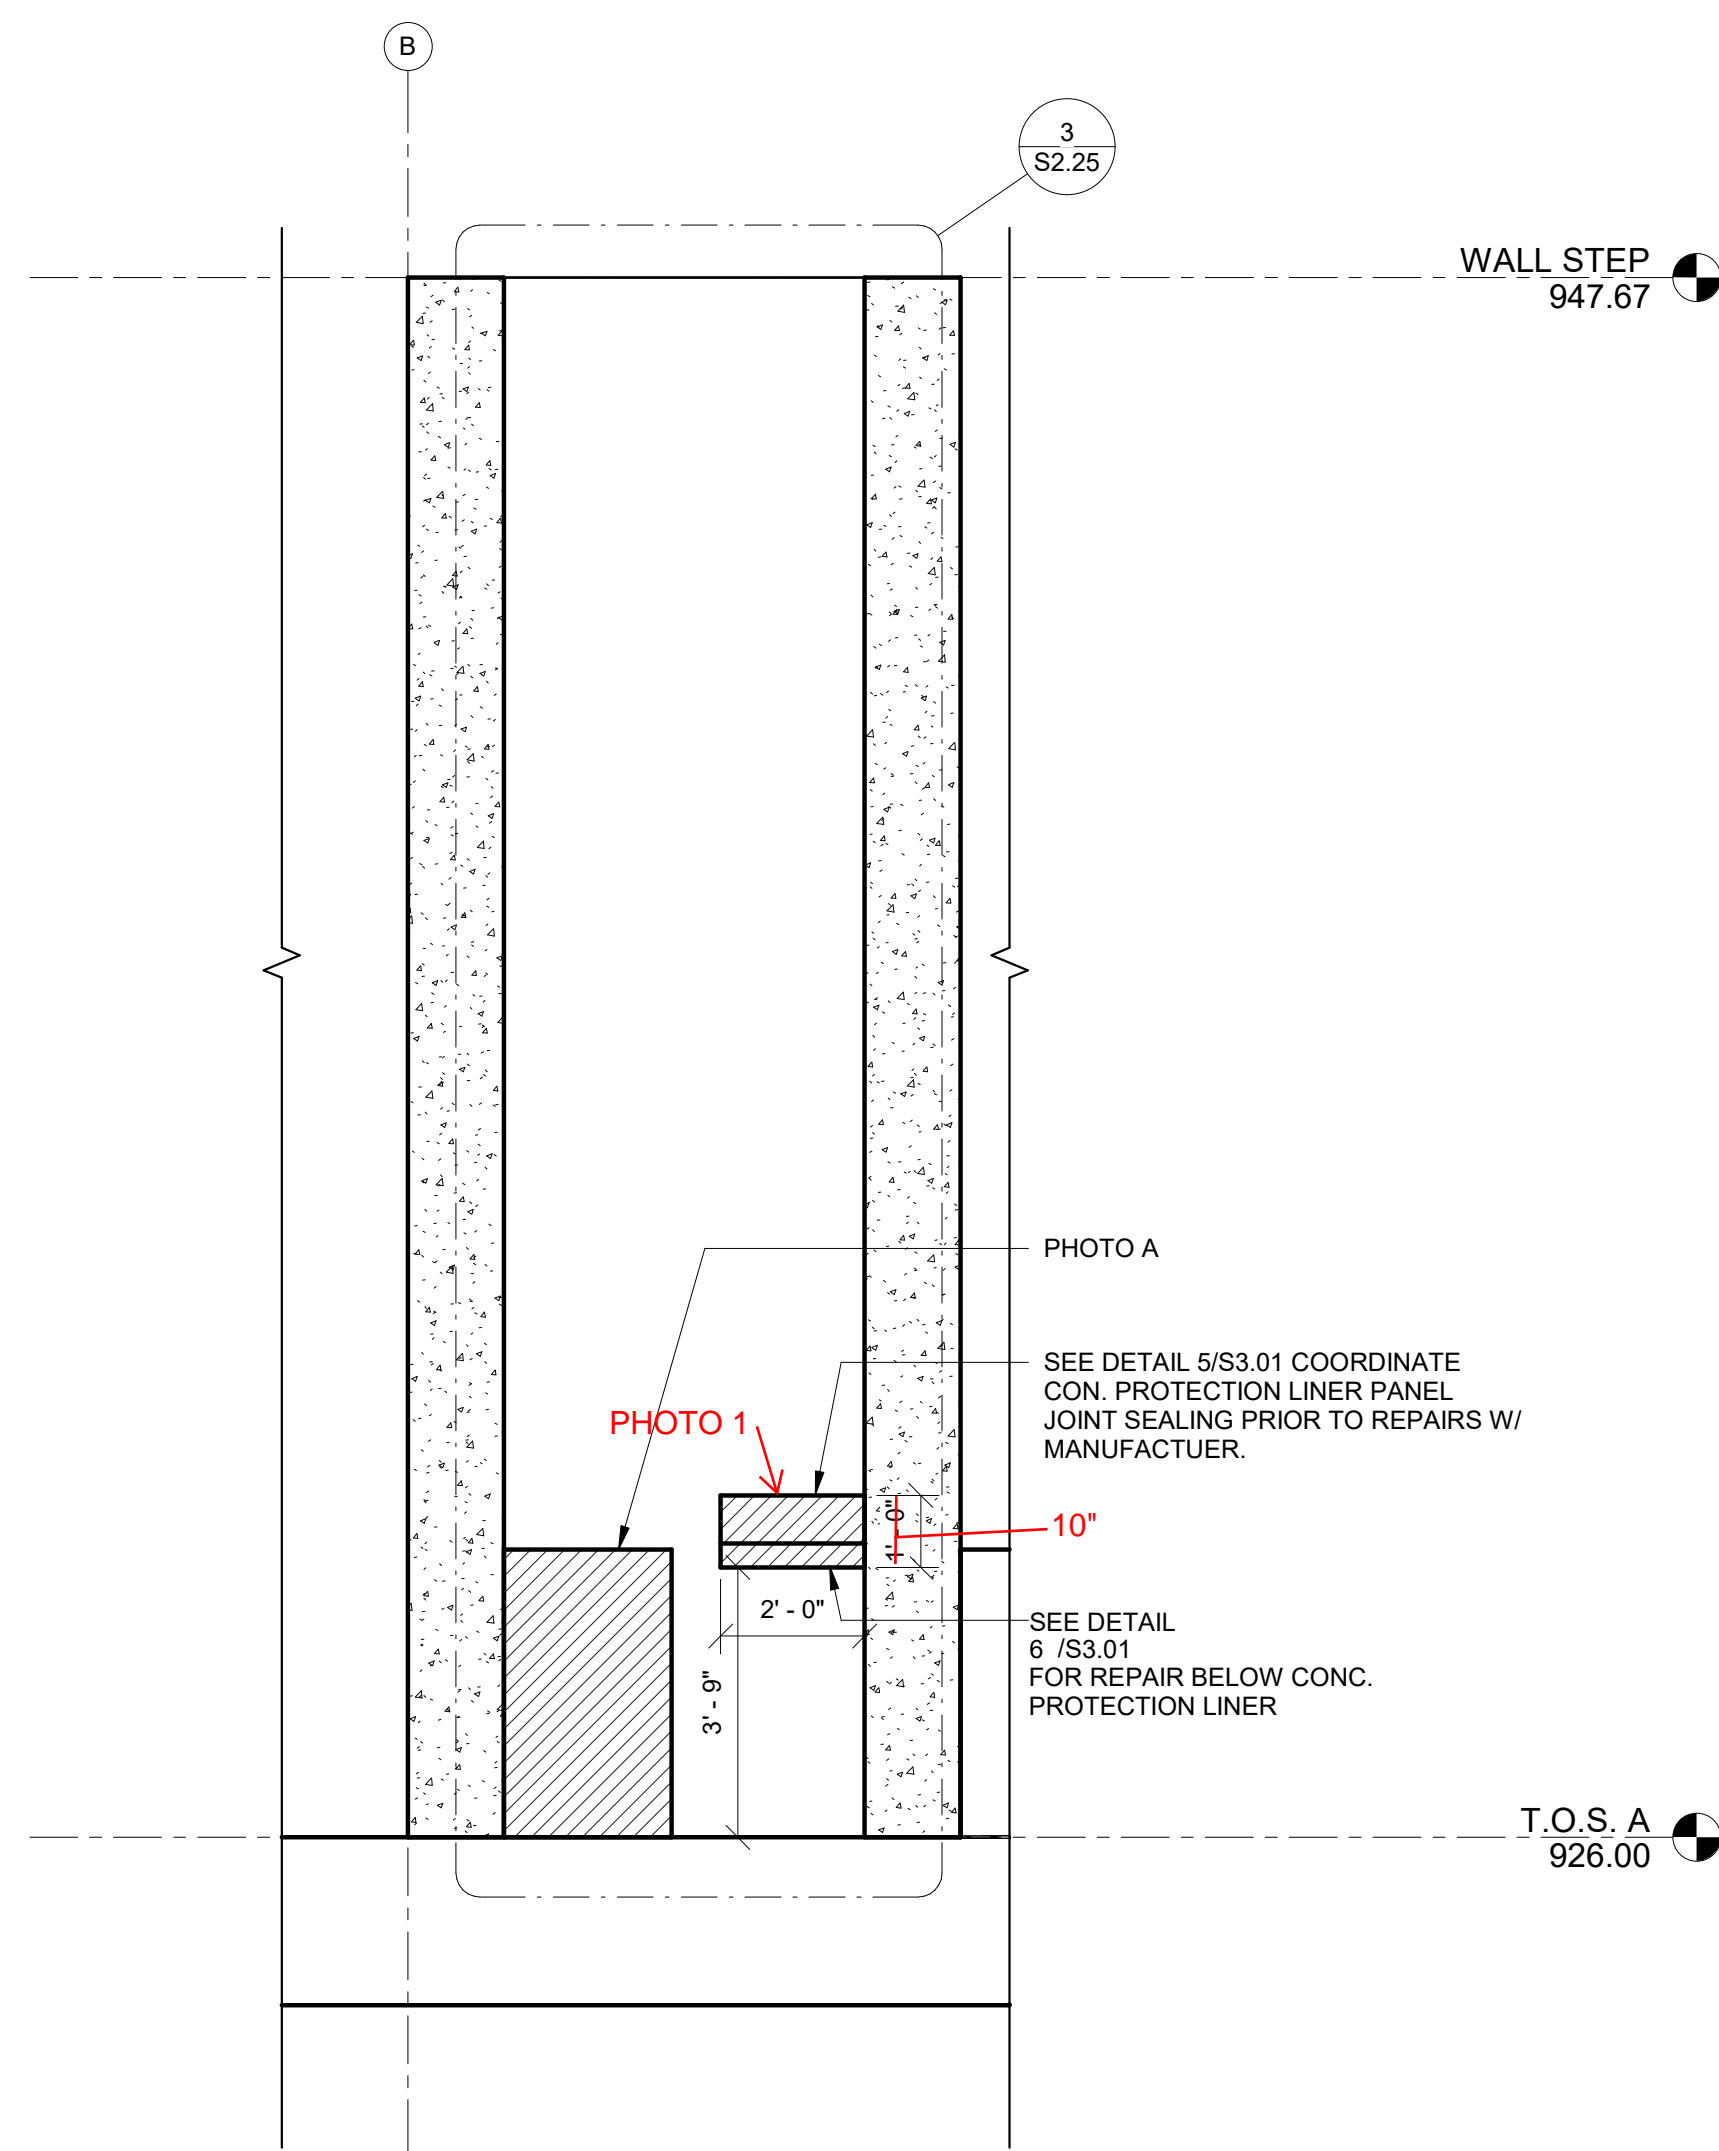

SHUCK ■ BRITSON

400 E COURT AVE.
SUITE 140.
DES MOINES, IOWA 50309
515-243-4477
www.shuck-britson.com

NEVADA WWTP IMPROVEMENTS LIMITED
CONCRETE WALL REPAIR

BOOMERANG

457 S. 6th STREET NEVADA IOWA 50201

Project Status

PROJECT NUMBER	123.0172.00
----------------	-------------

DATE	03/24/202
------	-----------

WALL ELEVATIONS

SHEET NO.

S2.25



Before Repair



After Repair (fillet was already placed prior to the after repair photo could be taken)

PHOTO 1



Before Repair




Before Repair



After Repair (fillet was already placed prior to the after repair photo could be taken)


PHOTO 2

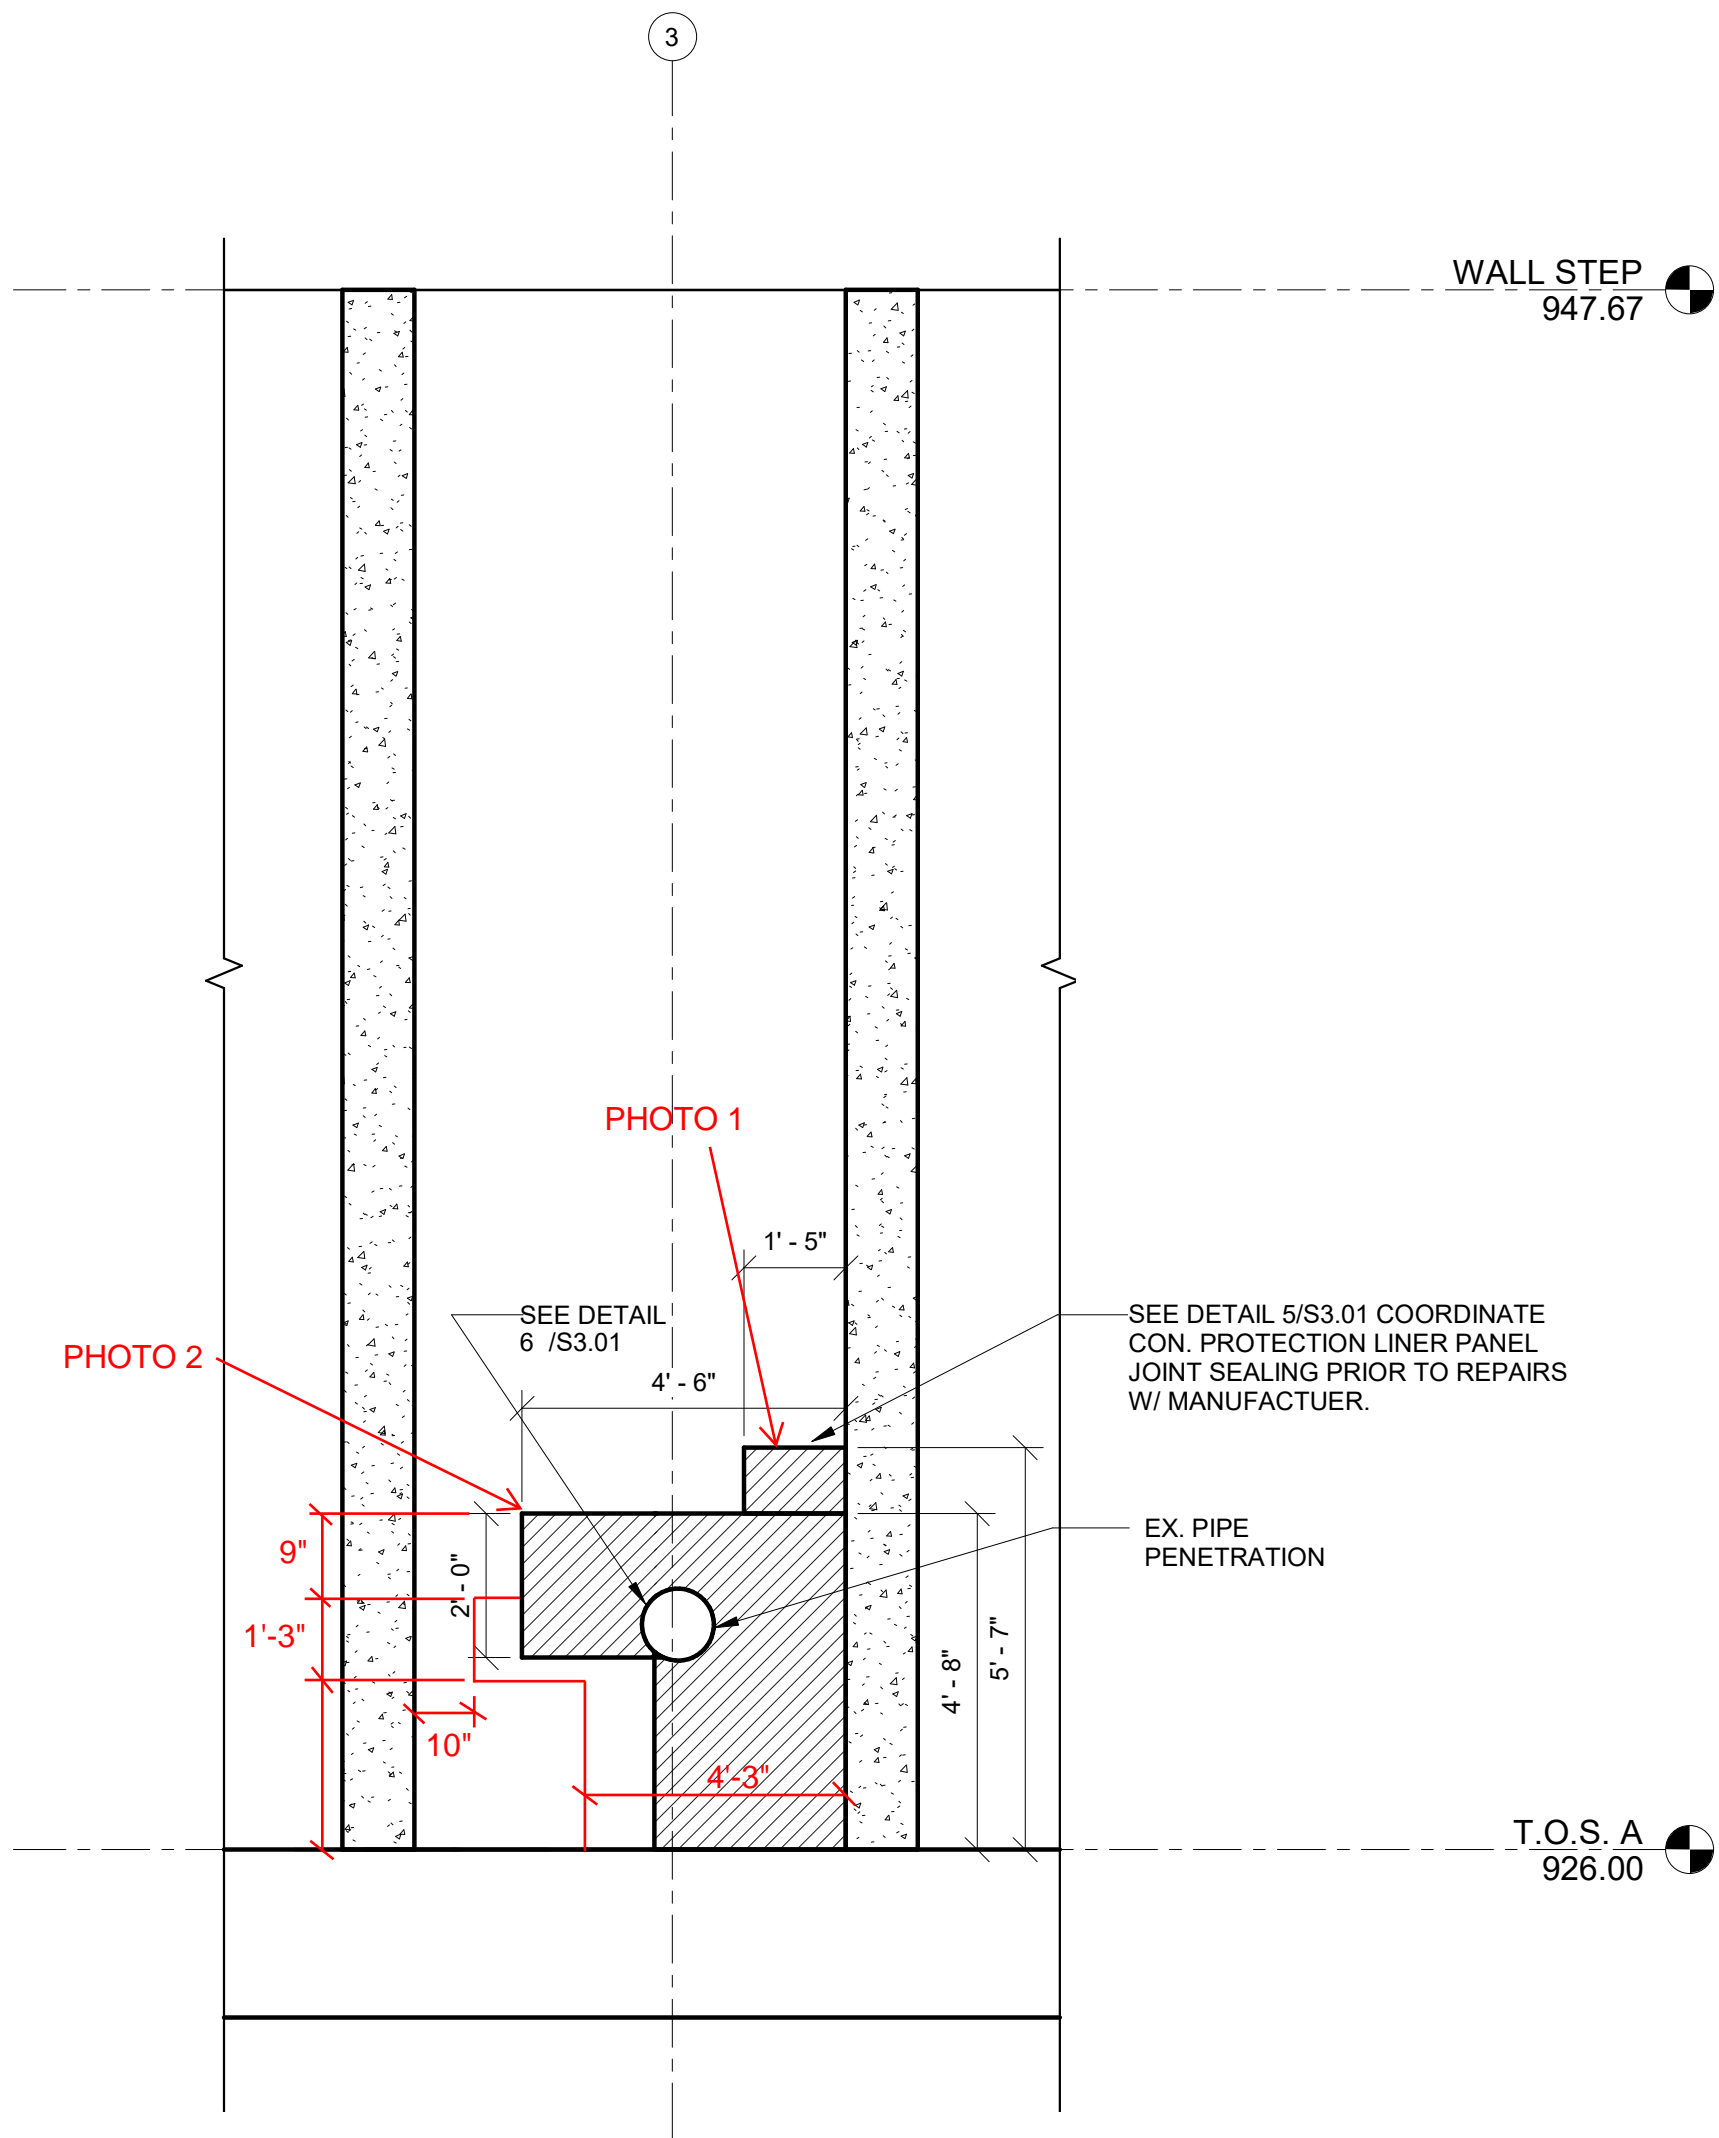

1 INTERIOR ELEVATION
3/8" = 1'-0"



3 PHOTO A

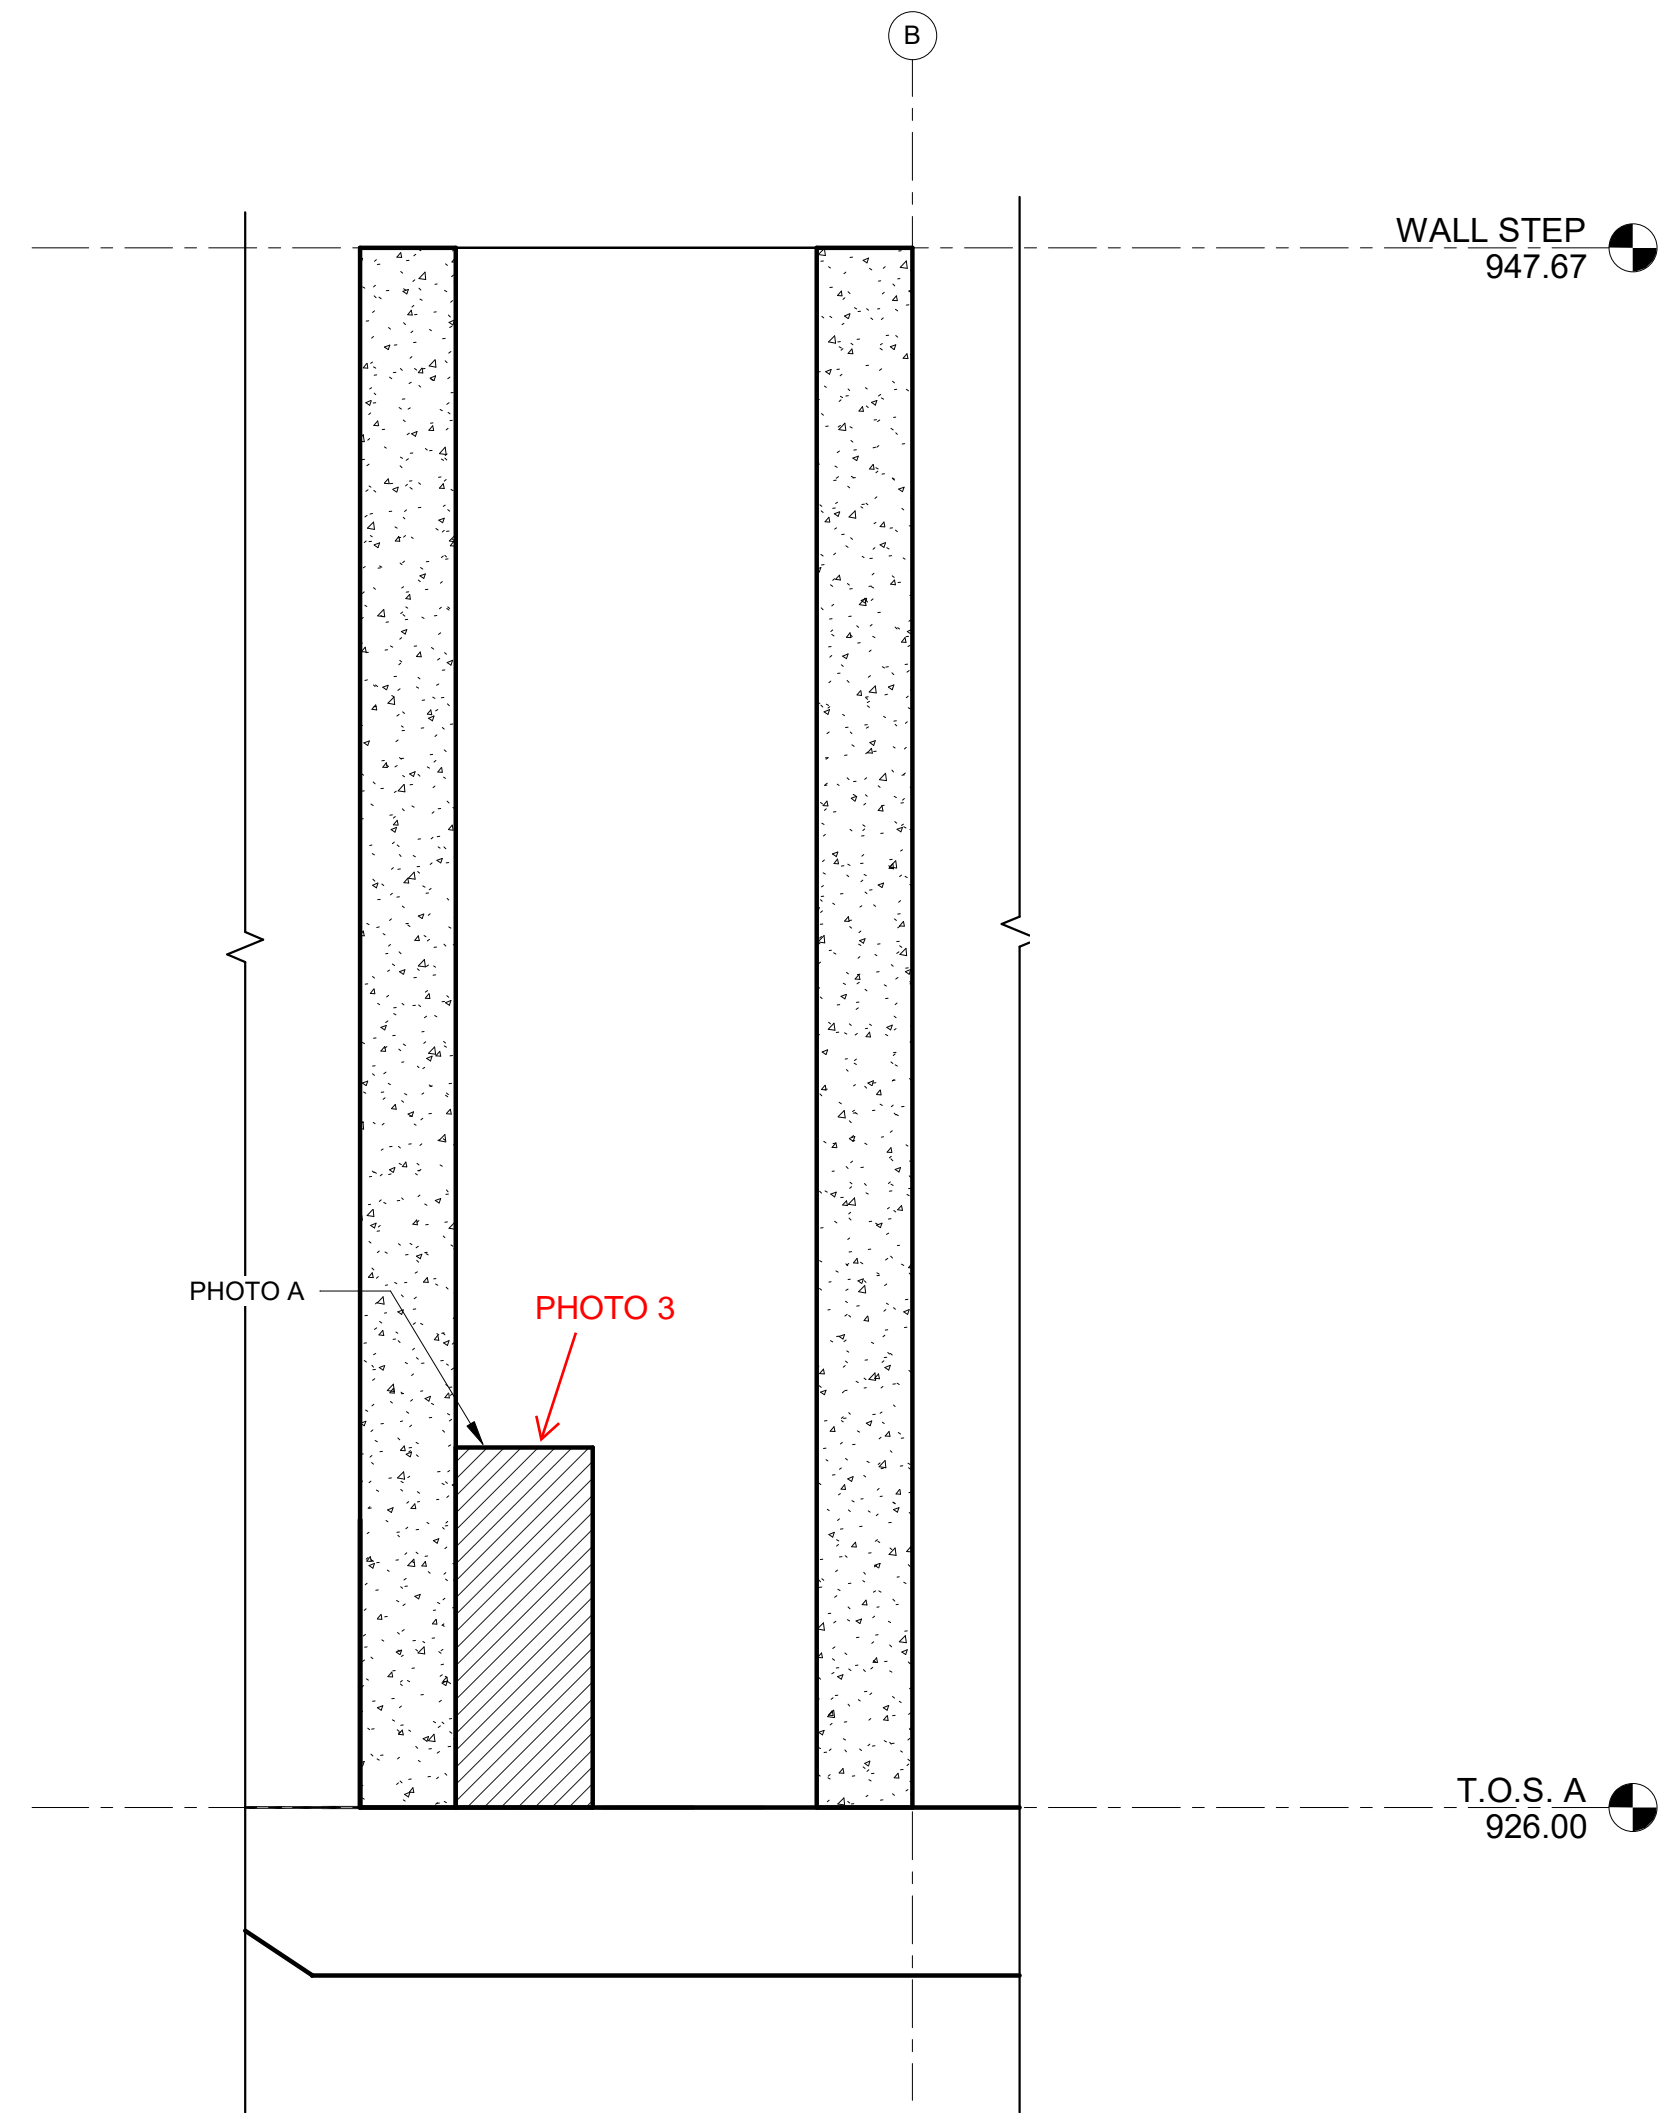

2 INTERIOR ELEVATION
3/8" = 1'-0"



Before Repair



After Repair (fillet was already placed prior to the after repair photo could be taken)

PHOTO 1



Before Repair



Final Photo

PHOTO 3



Before Repair



Before Repair



Before Repair



After Repair (fillet was already placed prior to the after repair photo could be taken)

PHOTO 2



Before Repair




After Repair

PHOTO 1

CHUCK BRITSON


400 E COURT AVE.
SUITE 140.
E MOINES, IOWA 50309
515-243-4477
www.shuck-britson.com

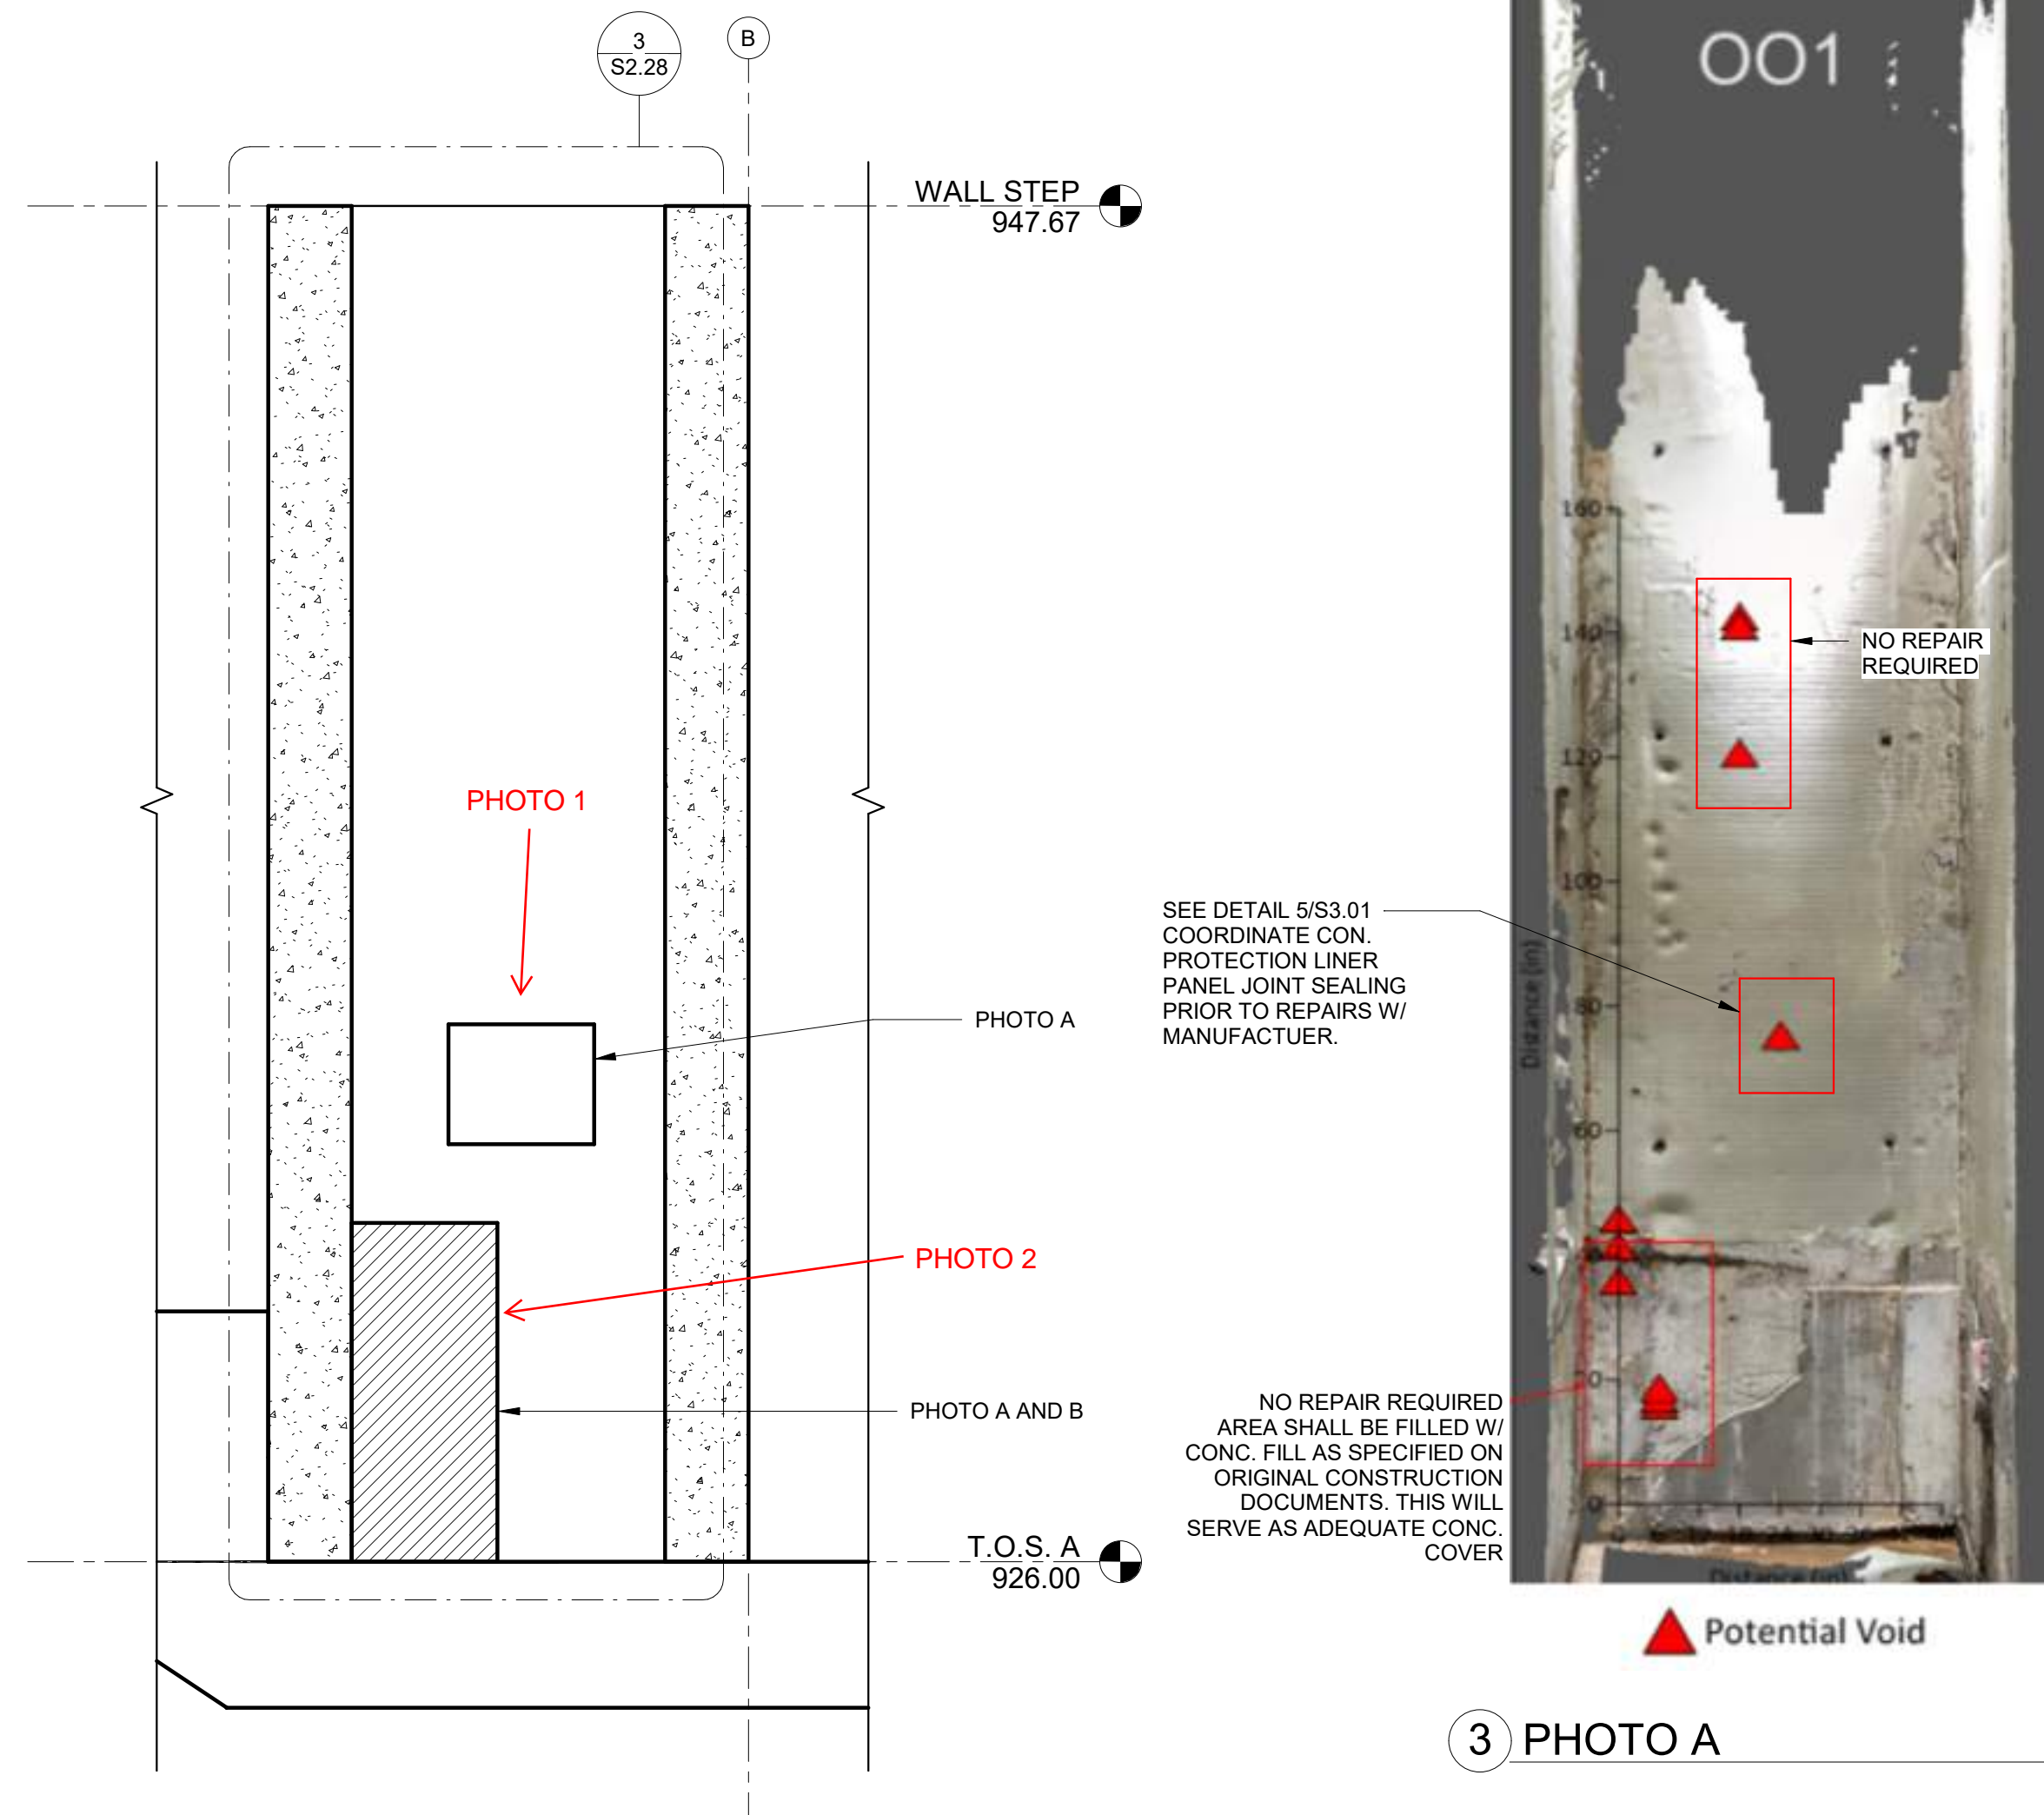

1 INTERIOR ELEVATION
3/8" = 1'-0"



5 PHOTO C

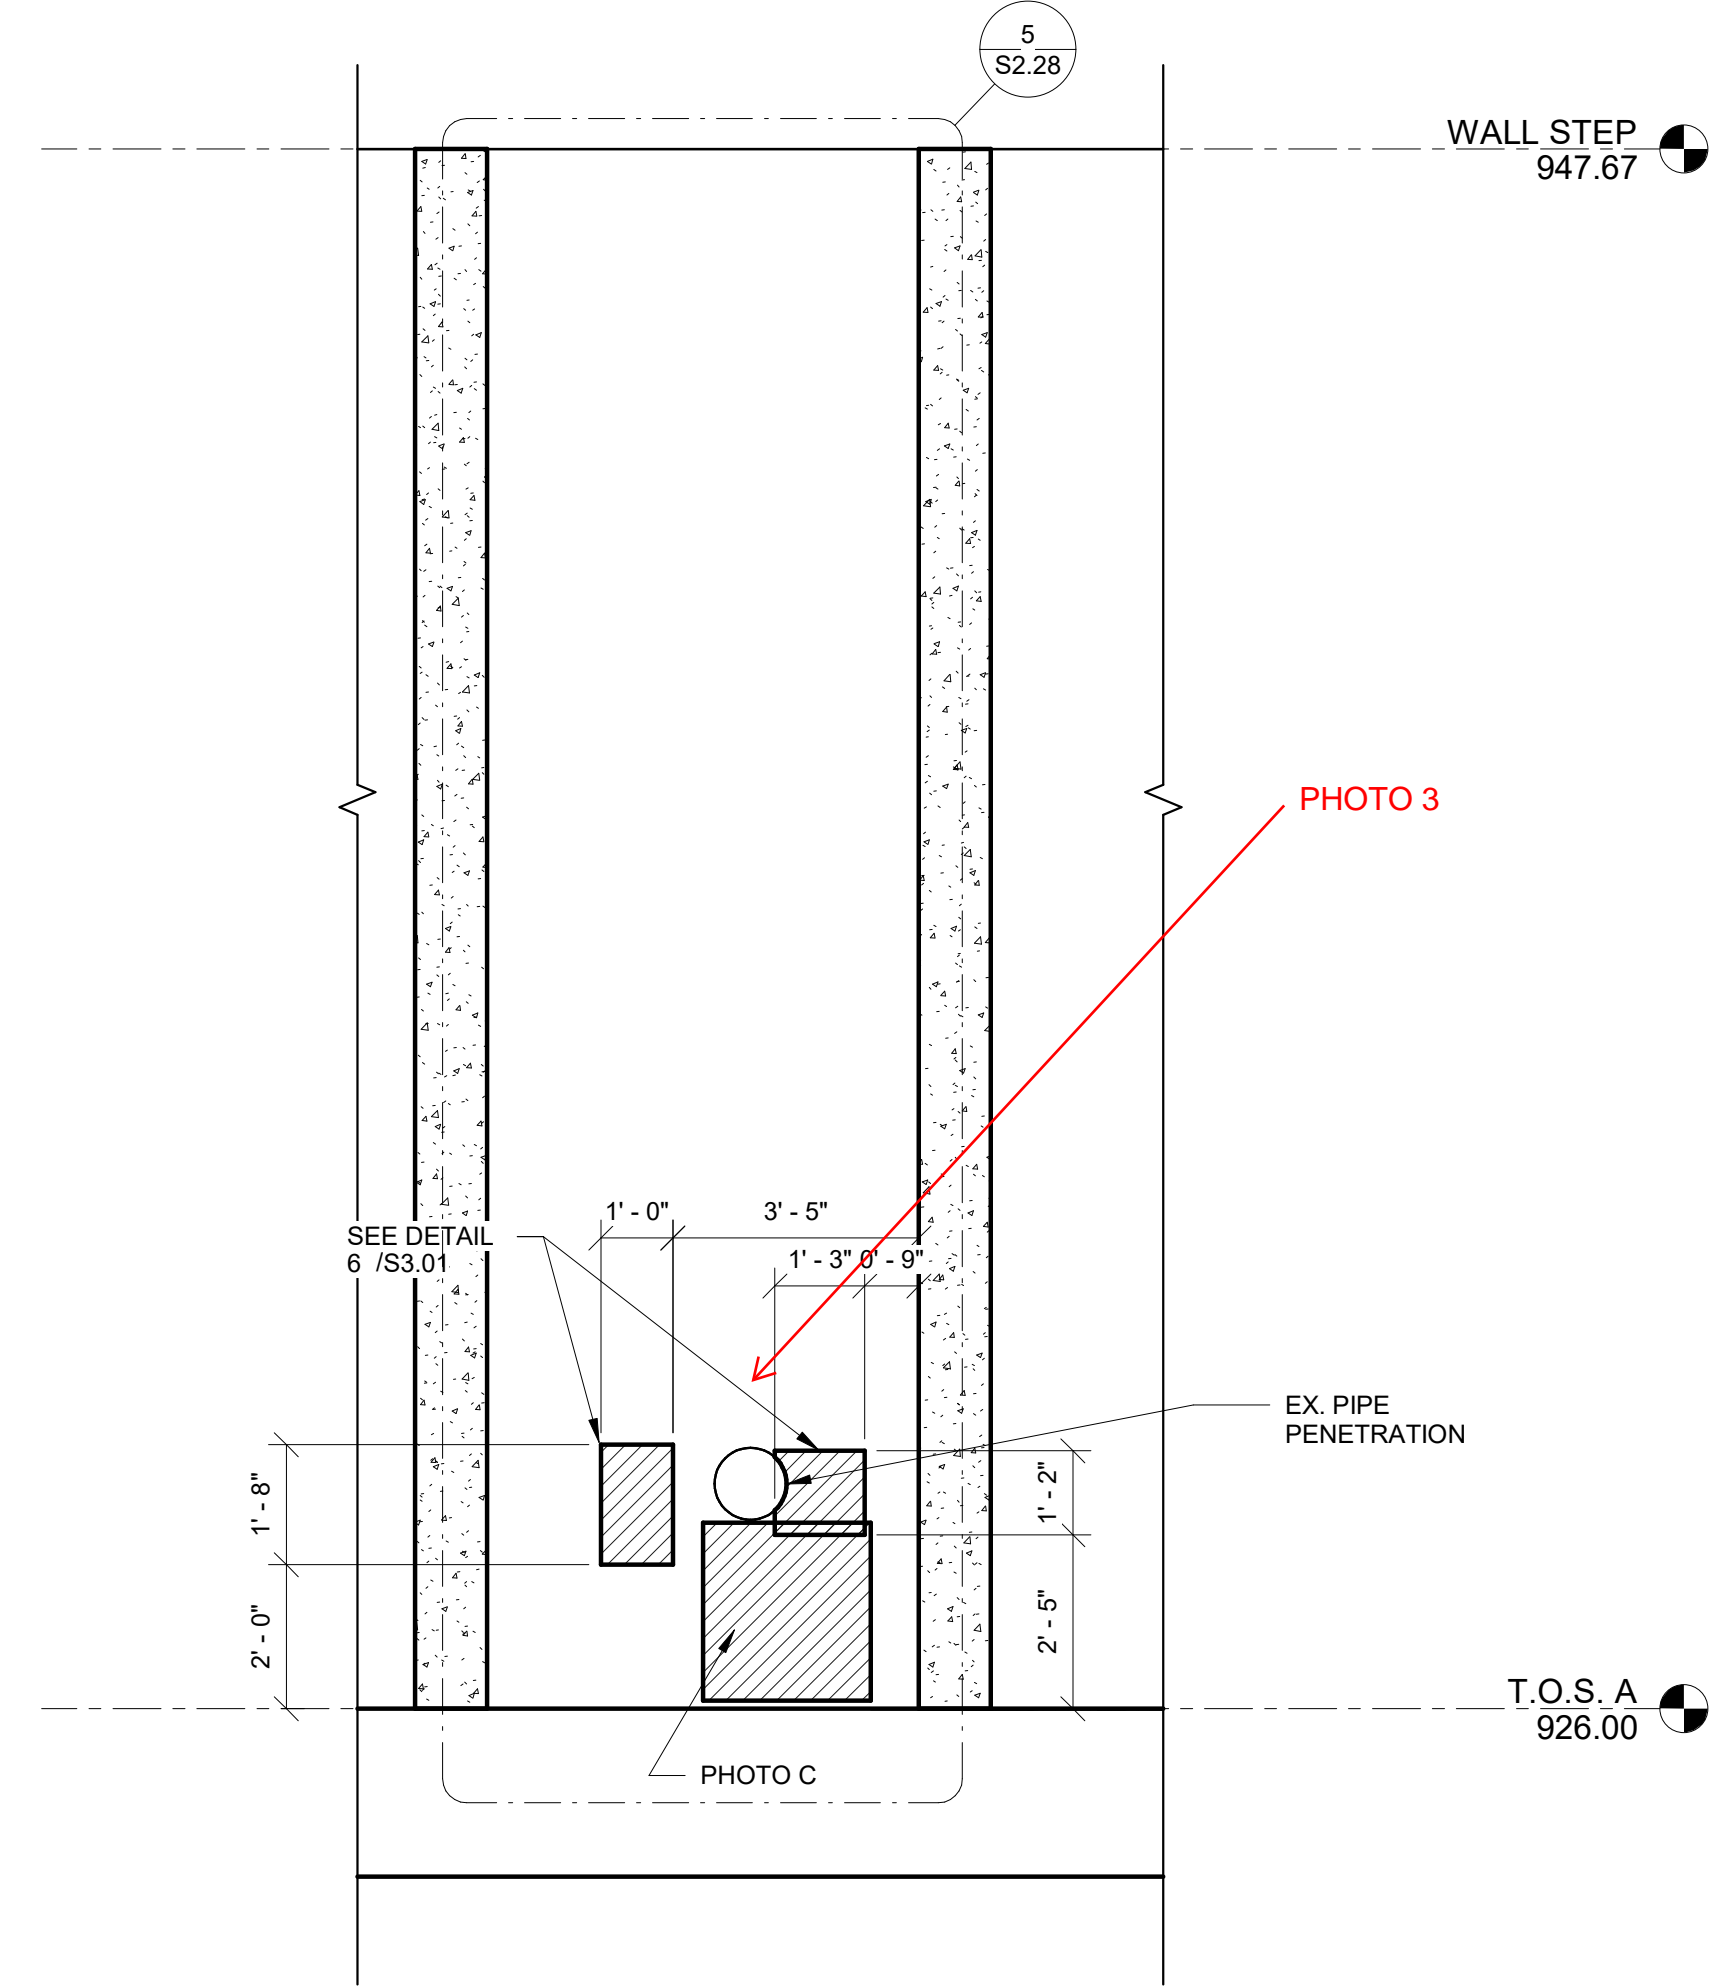

2 INTERIOR ELEVATION
3/8" = 1'-0"



4 PHOTO B

NEVADA WWTP IMPROVEMENTS LIMITED
CONCRETE WALL REPAIR
BOOMERANG
457 S. 6th STREET NEVADA IOWA 50201

Project Status

PROJECT NUMBER

0172.03

TE

ET TITLE

24/2023

ALL ELEVATIONS

SHEET NO. _____

S2.28



Before Repair



After Repair

PHOTO 1



Before Repair



After Repair (fillet was already placed prior to the after repair photo could be taken)

PHOTO 2




Before Repair



After Repair (fillet was already placed prior to the before and after repair photo could be taken)

PHOTO 3

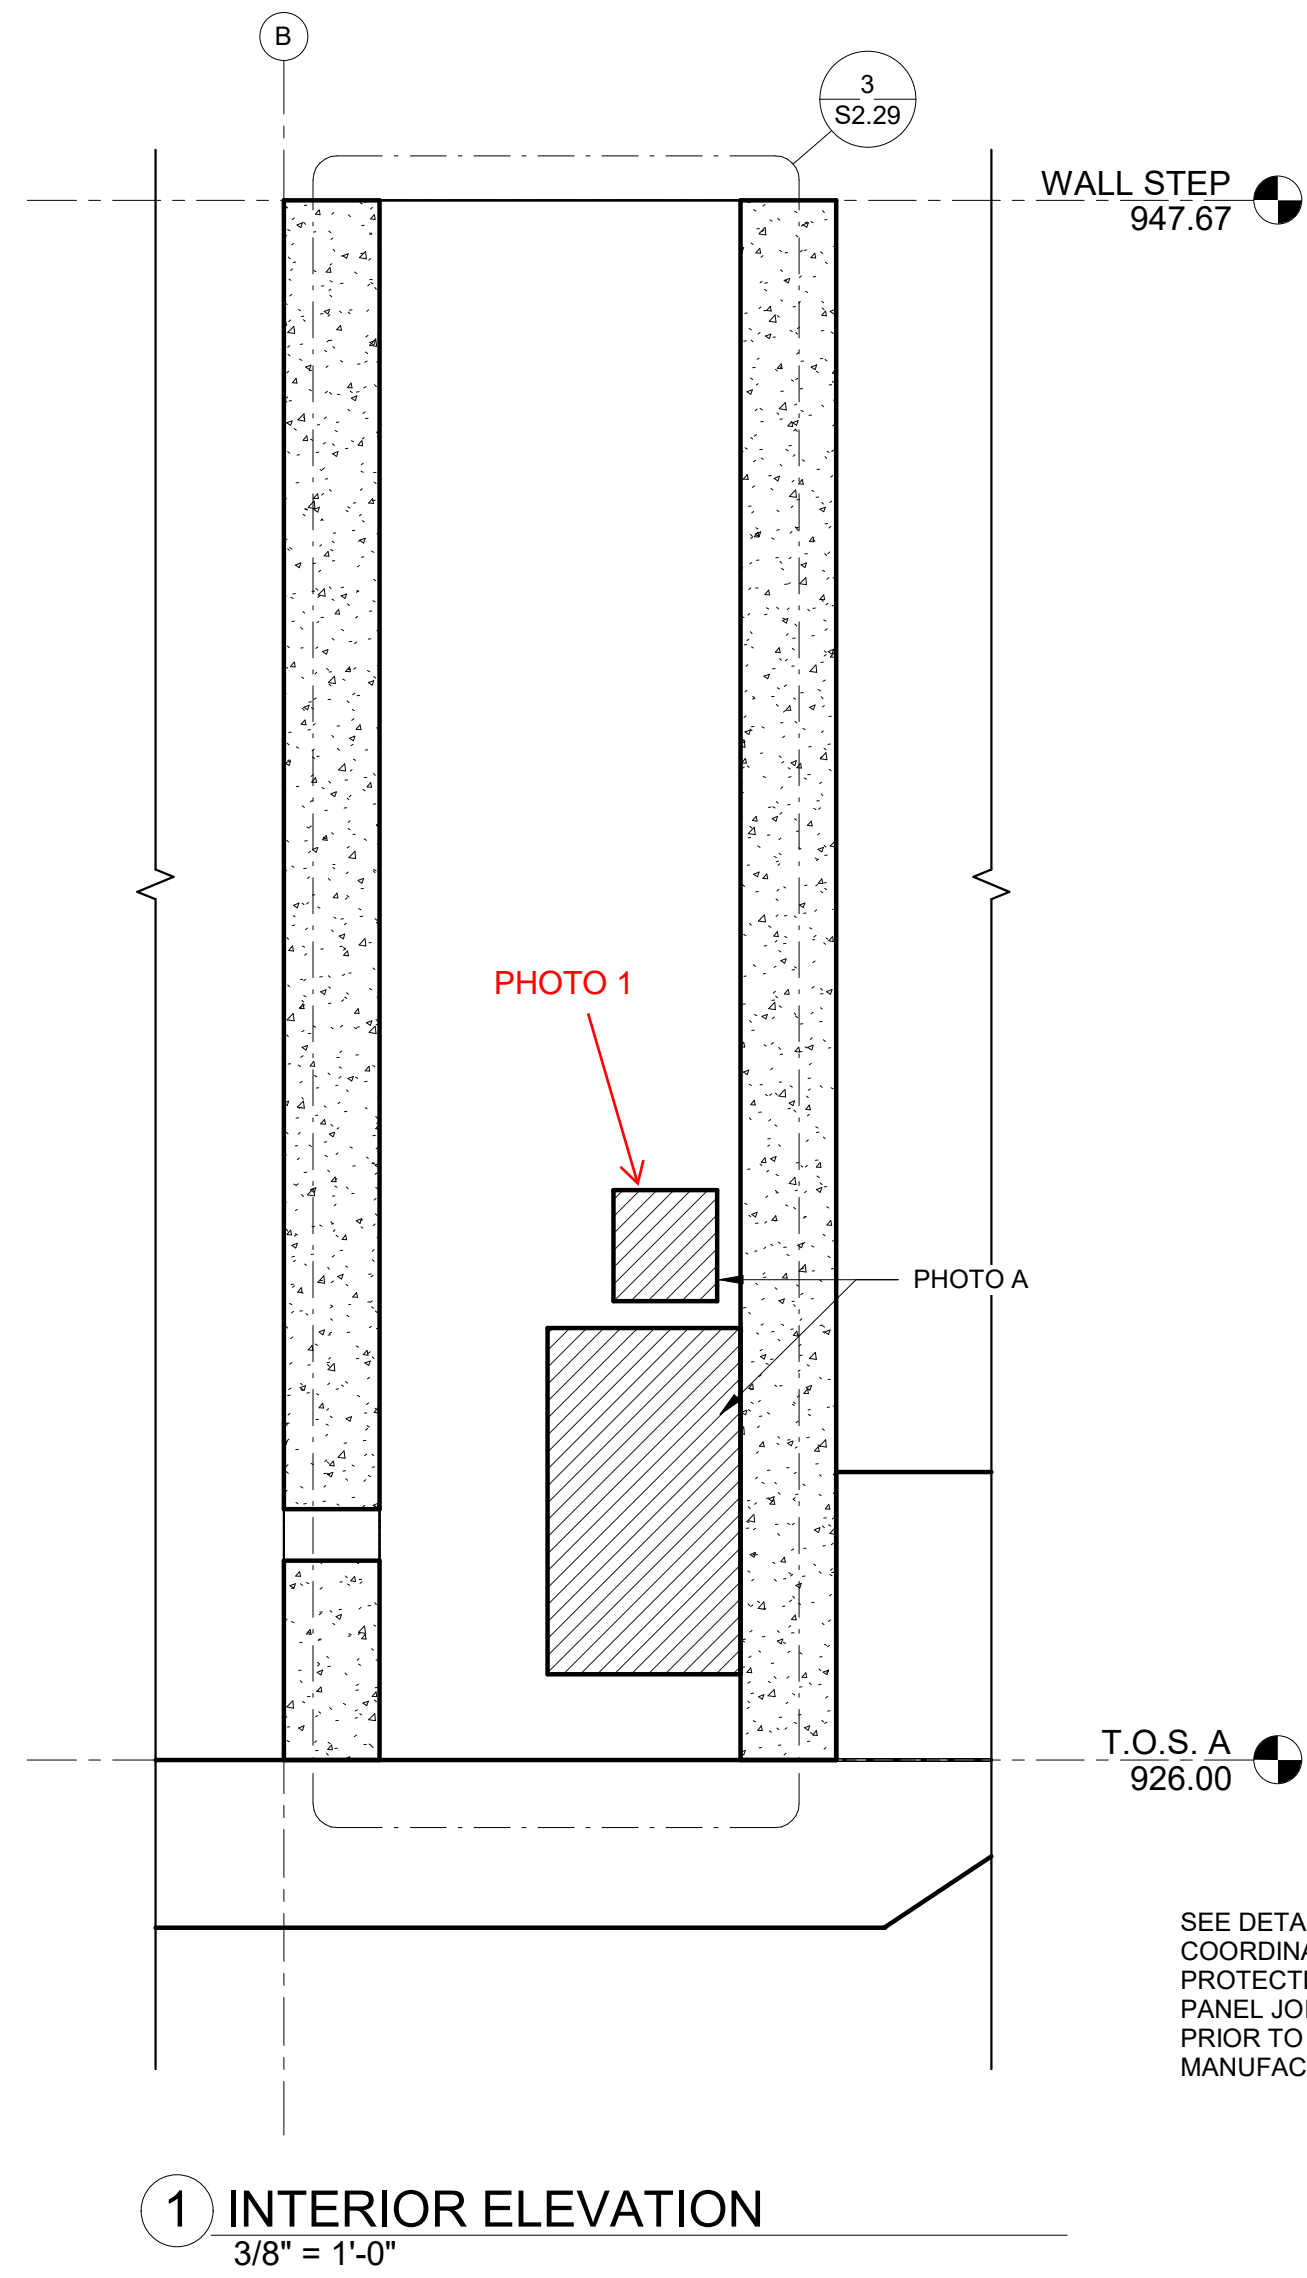



1 INTERIOR ELEVATION
3/8" = 1'-0"

SEE DETAIL 5/S3.01
COORDINATE CON.
PROTECTION LINER
PANEL JOINT SEALING
PRIOR TO REPAIRS W/
MANUFACTURER.

NO REPAIR
REQUIRED
AREA SHALL BE FILLED W/ CONC. FILL
AS SPECIFIED ON ORIGINAL
CONSTRUCTION DOCUMENTS. THIS
WILL SERVE AS ADEQUATE CONC.
COVER

CAREFULLY REMOVE 5/8"
THICK CONCRETE OVER
POUR BACK TO ORIGINAL
POUR FACE.

3 PHOTO A

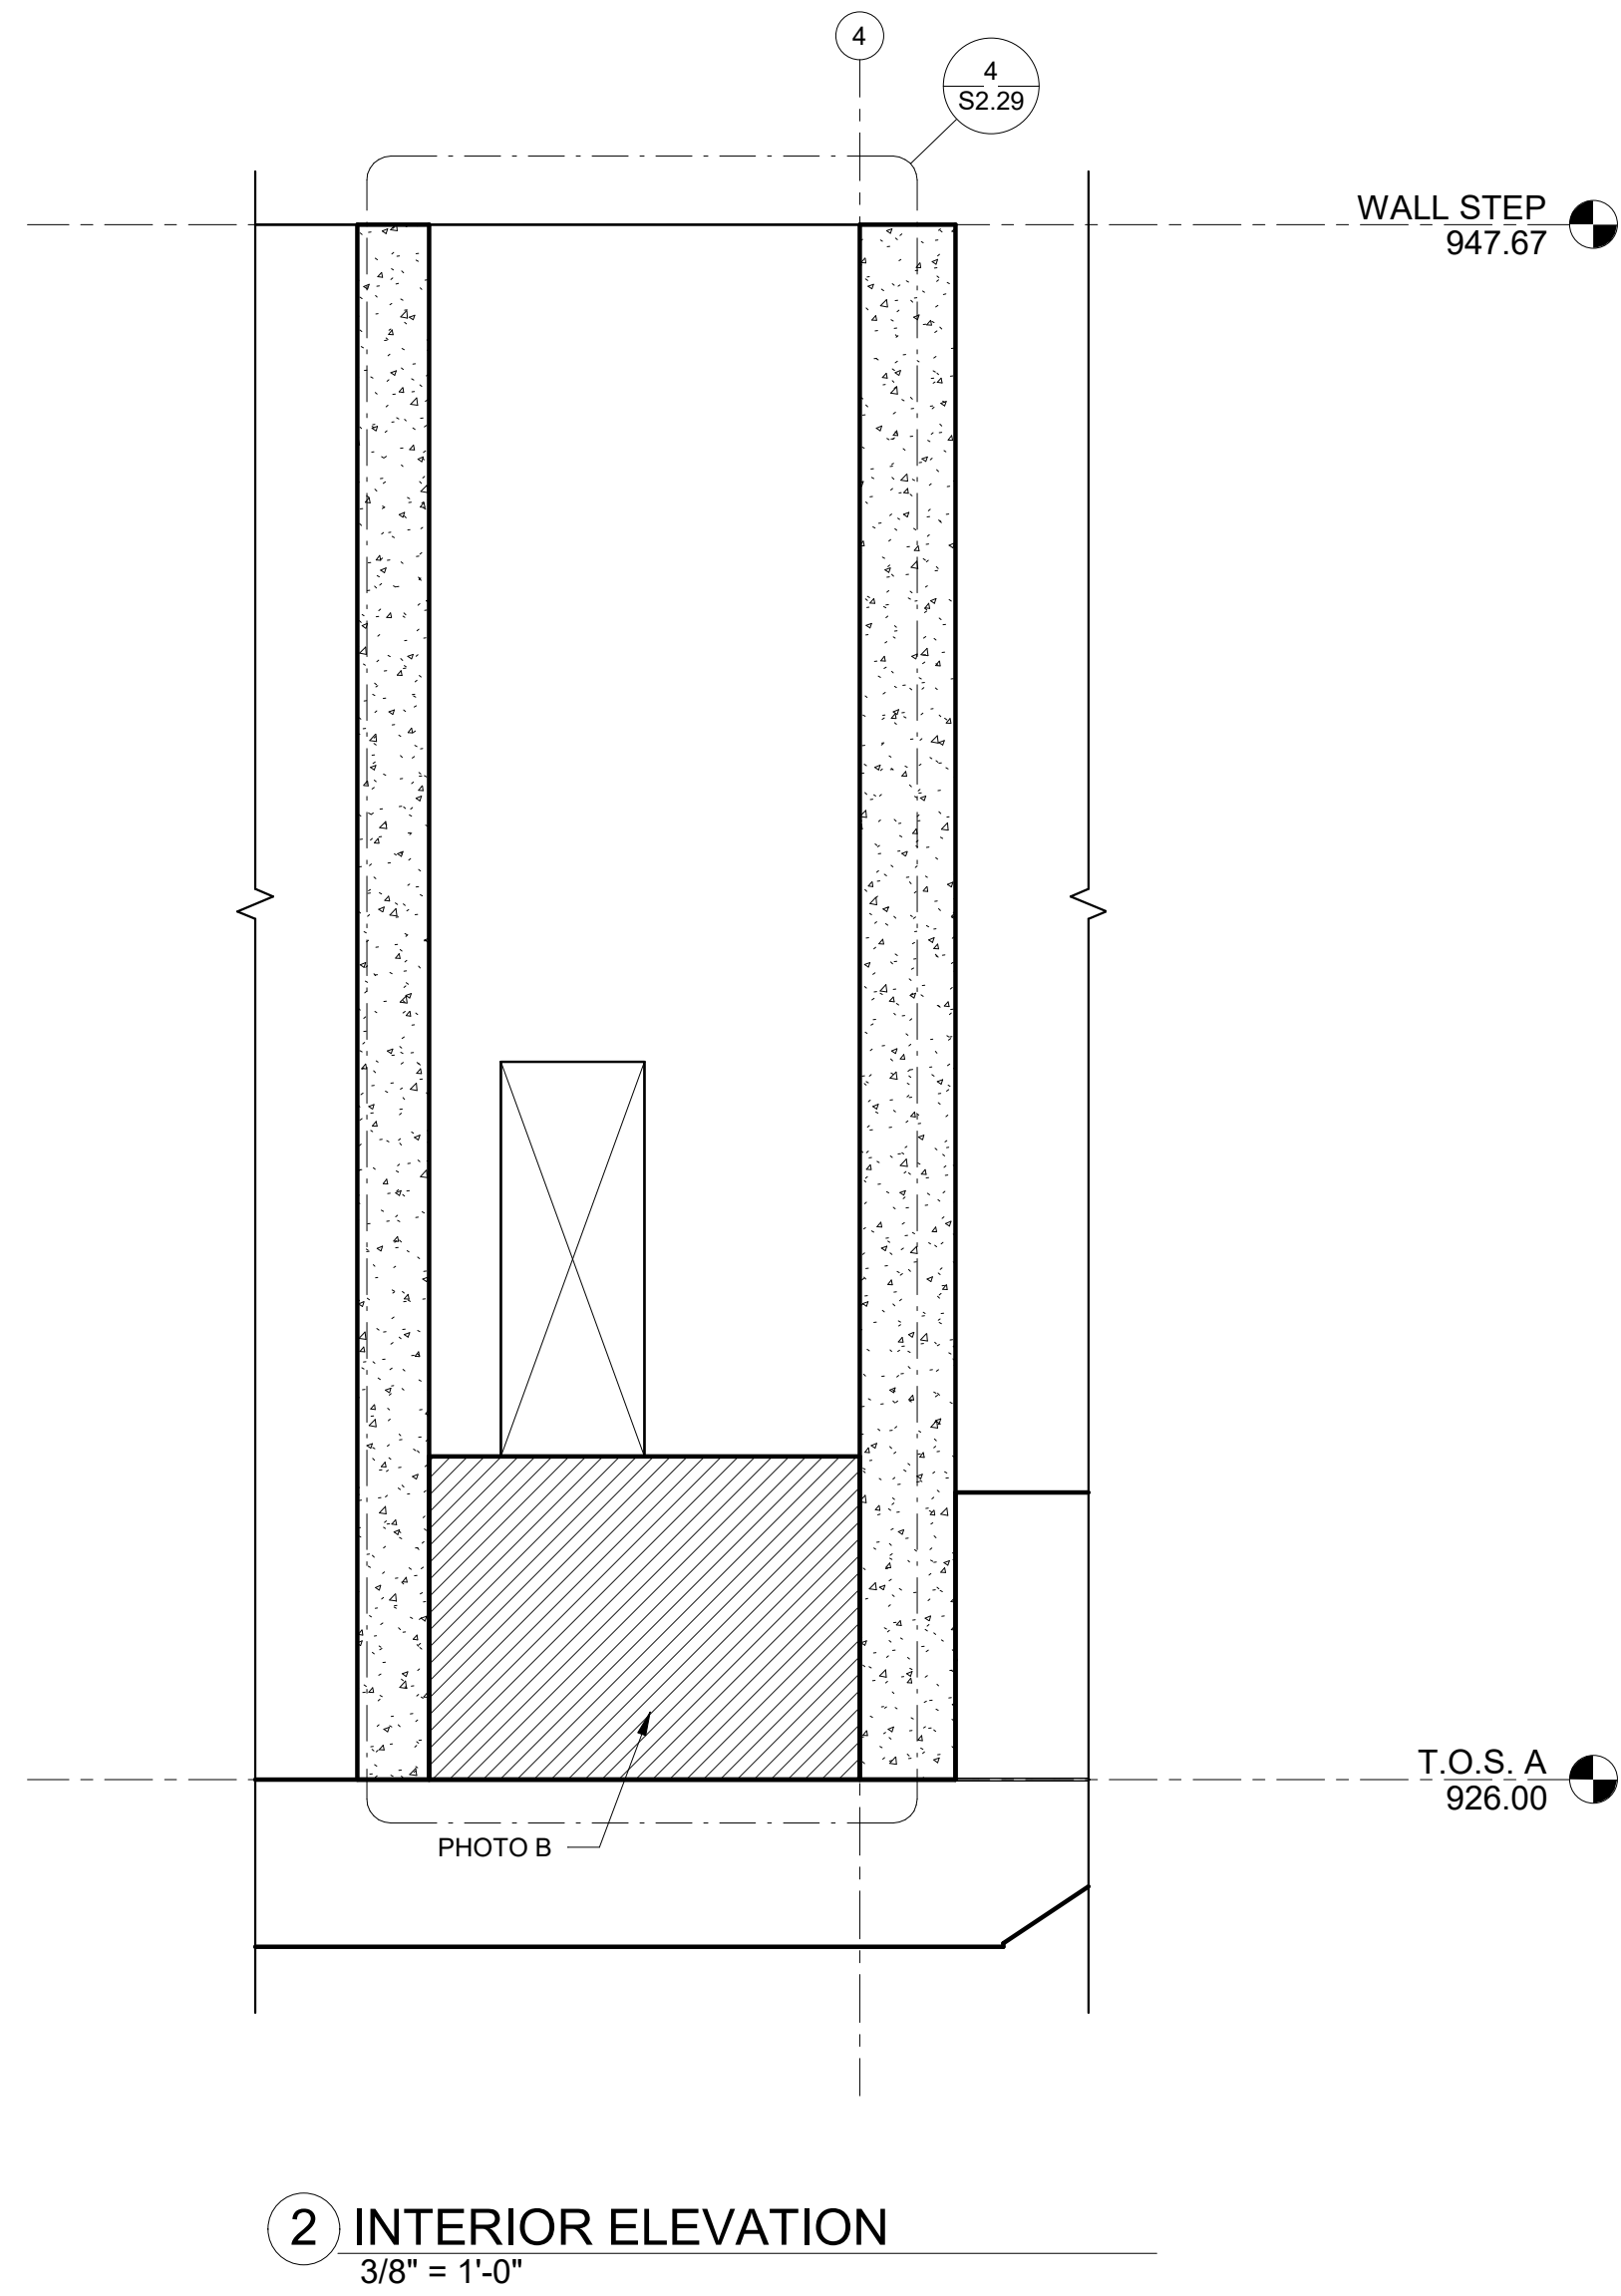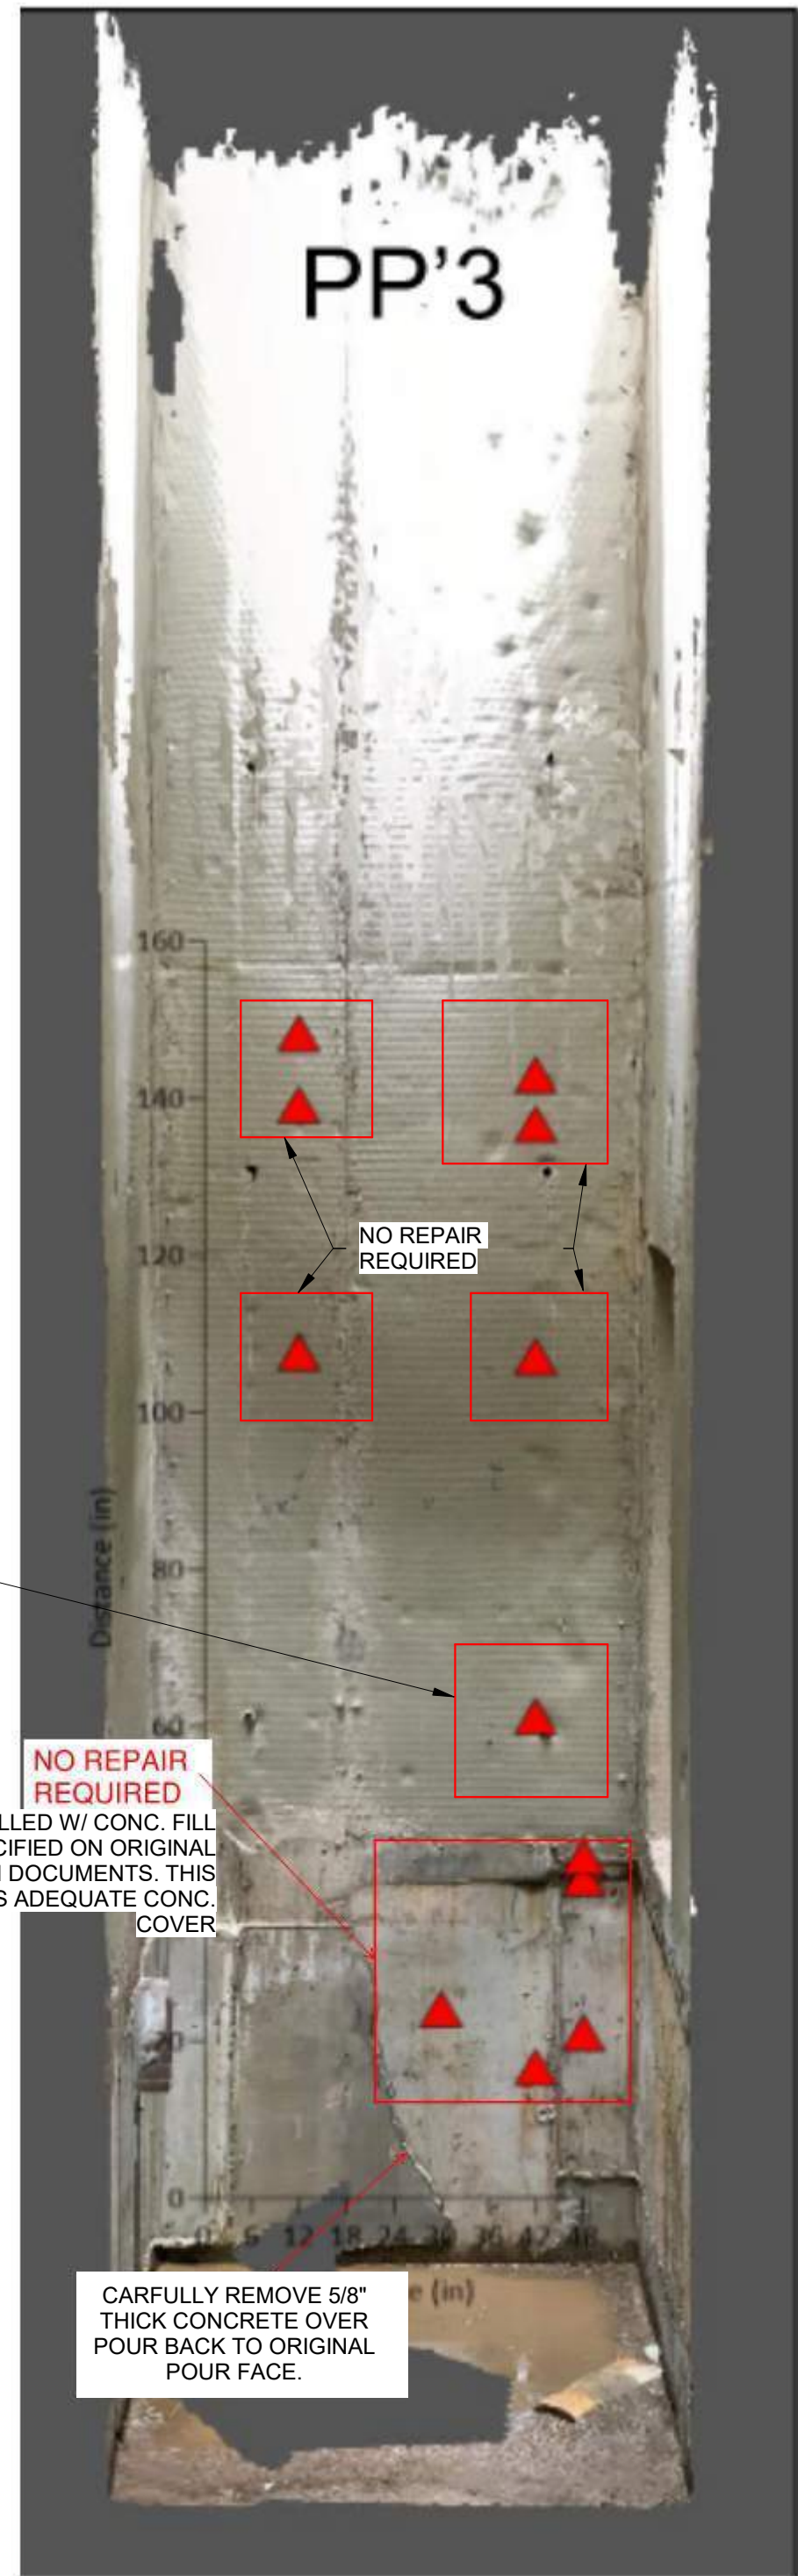


2 INTERIOR ELEVATION
3/8" = 1'-0"

T.O.S. A
926.00

NO REPAIR
REQUIRED
AREA SHALL BE FILLED W/ CONC. FILL
AS SPECIFIED ON ORIGINAL
CONSTRUCTION DOCUMENTS. THIS
WILL SERVE AS ADEQUATE CONC.
COVER

4 PHOTO B

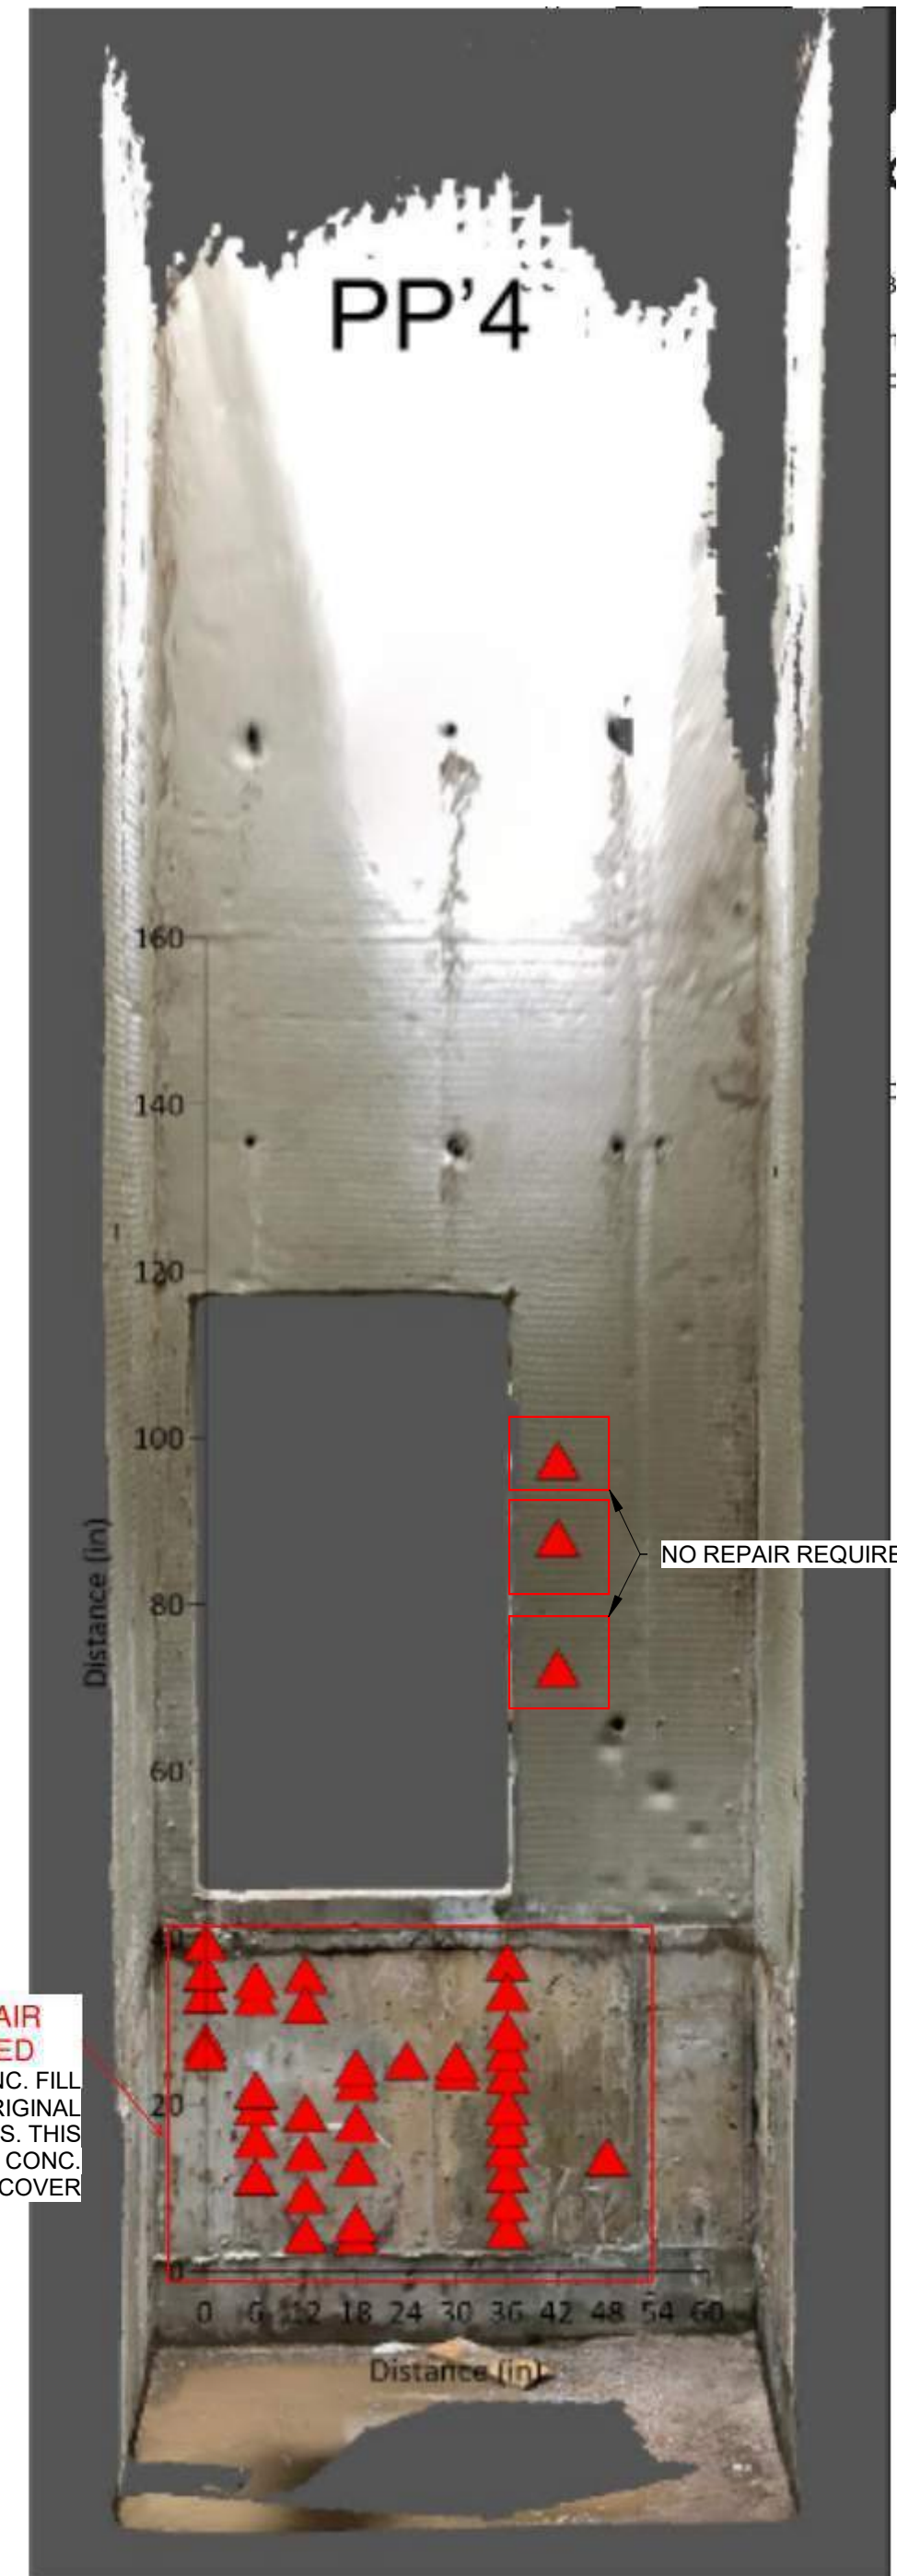




Before Repair



After Repair

PHOTO 1

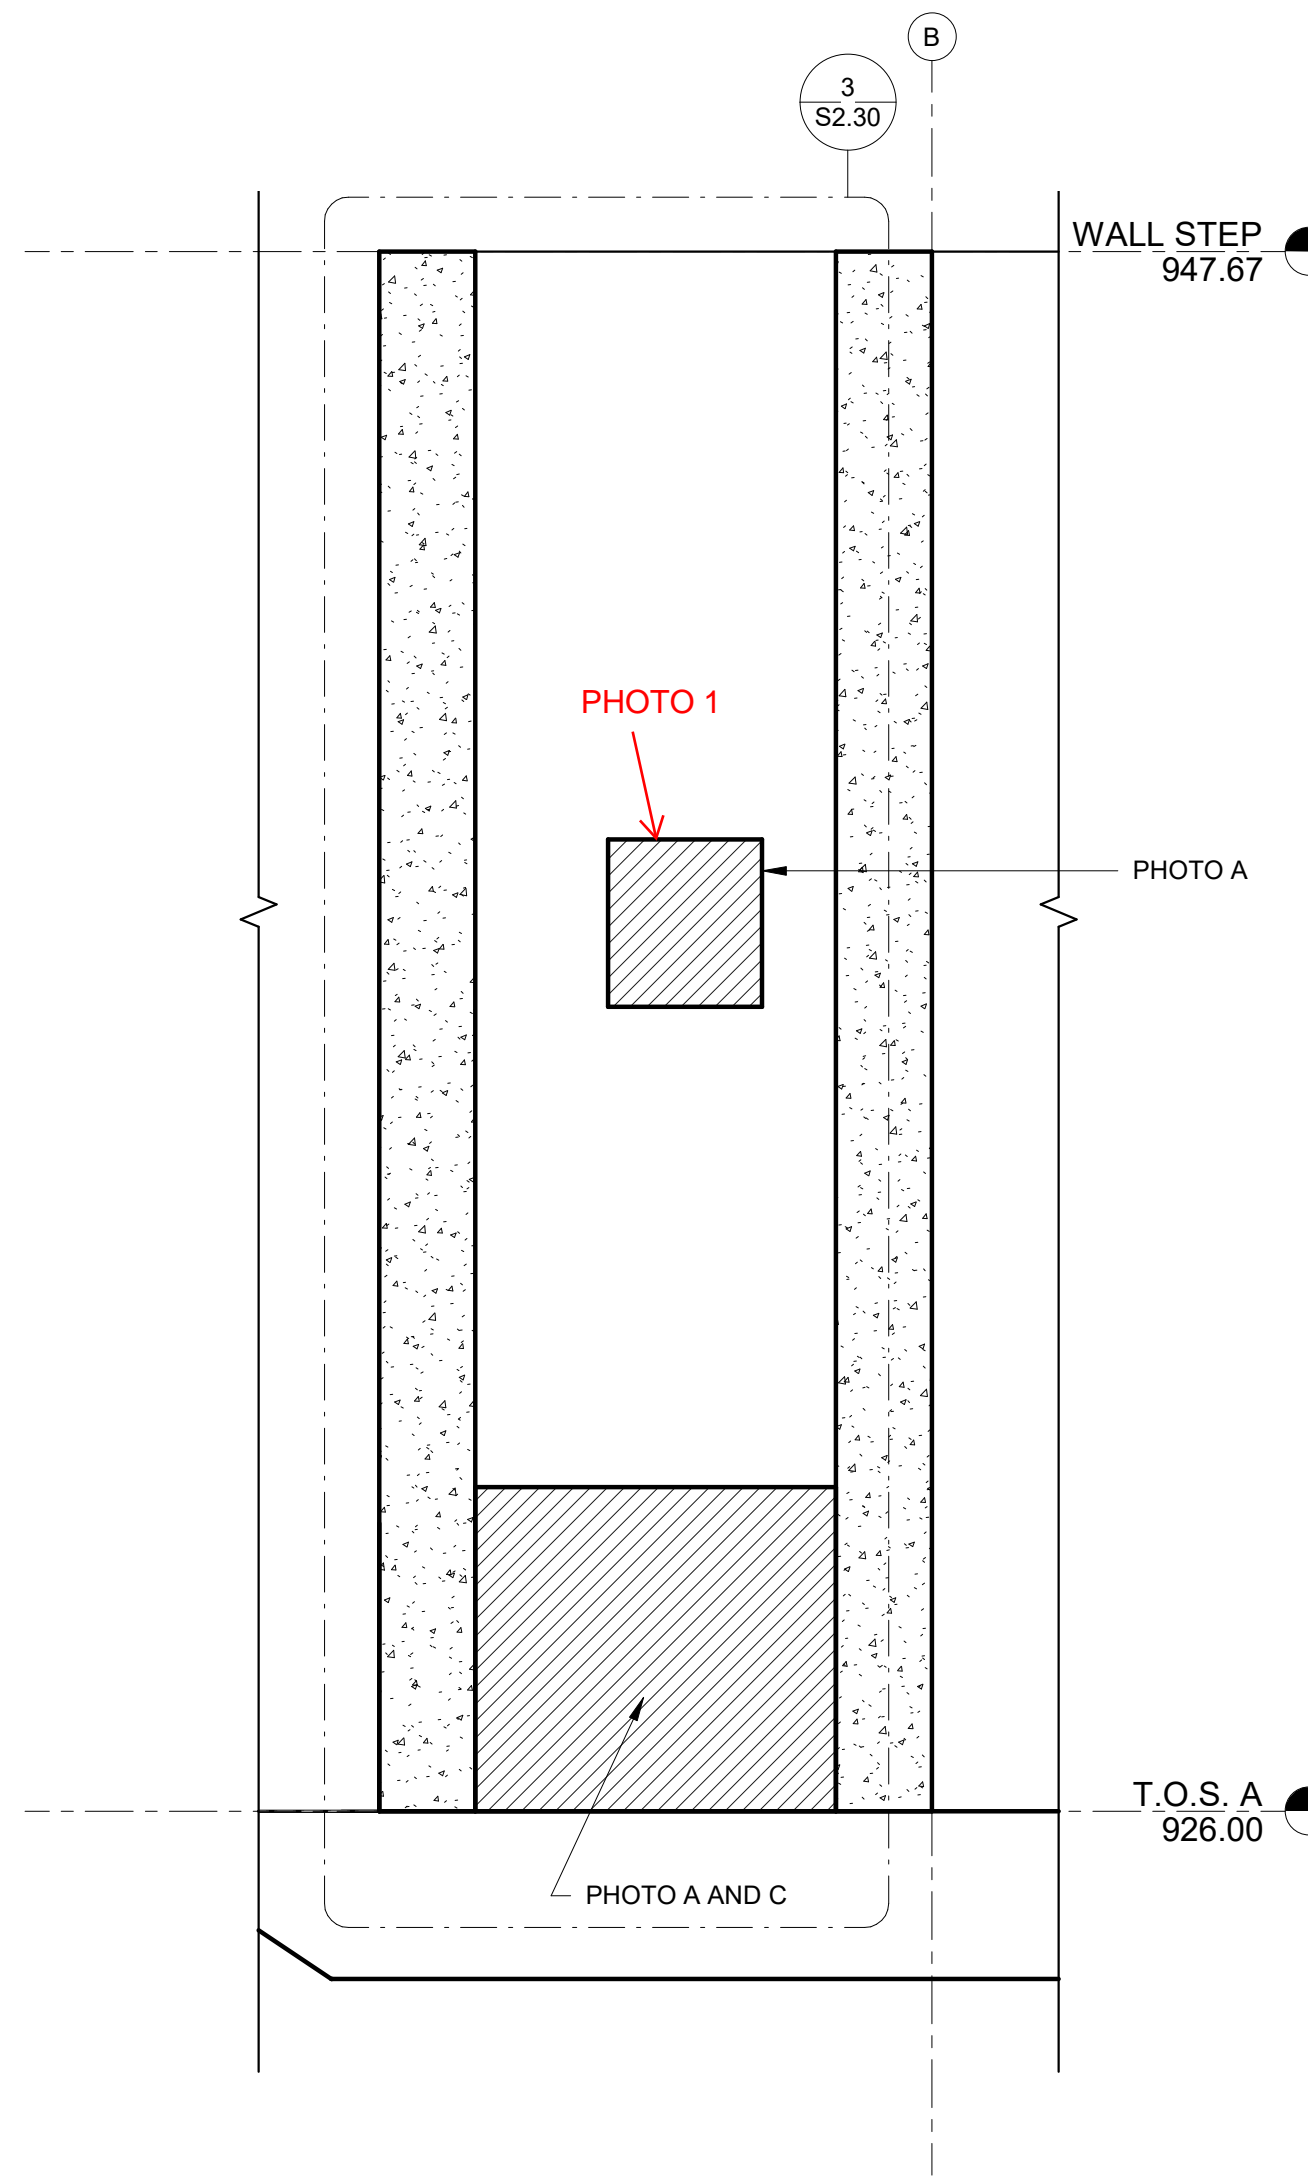


1 INTERIOR ELEVATION
3/8" = 1'-0"

SEE DETAIL 5/S3.01
COORDINATE CON. PROTECTION
LINER PANEL JOINT SEALING PRIOR
TO REPAIRS W/ MANUFACTUER.

NO REPAIR
REQUIRED
AREA SHALL BE FILLED W/ CONC. FILL
AS SPECIFIED ON ORIGINAL
CONSTRUCTION DOCUMENTS. THIS
WILL SERVE AS ADEQUATE CONC.
COVER



3 PHOTO A

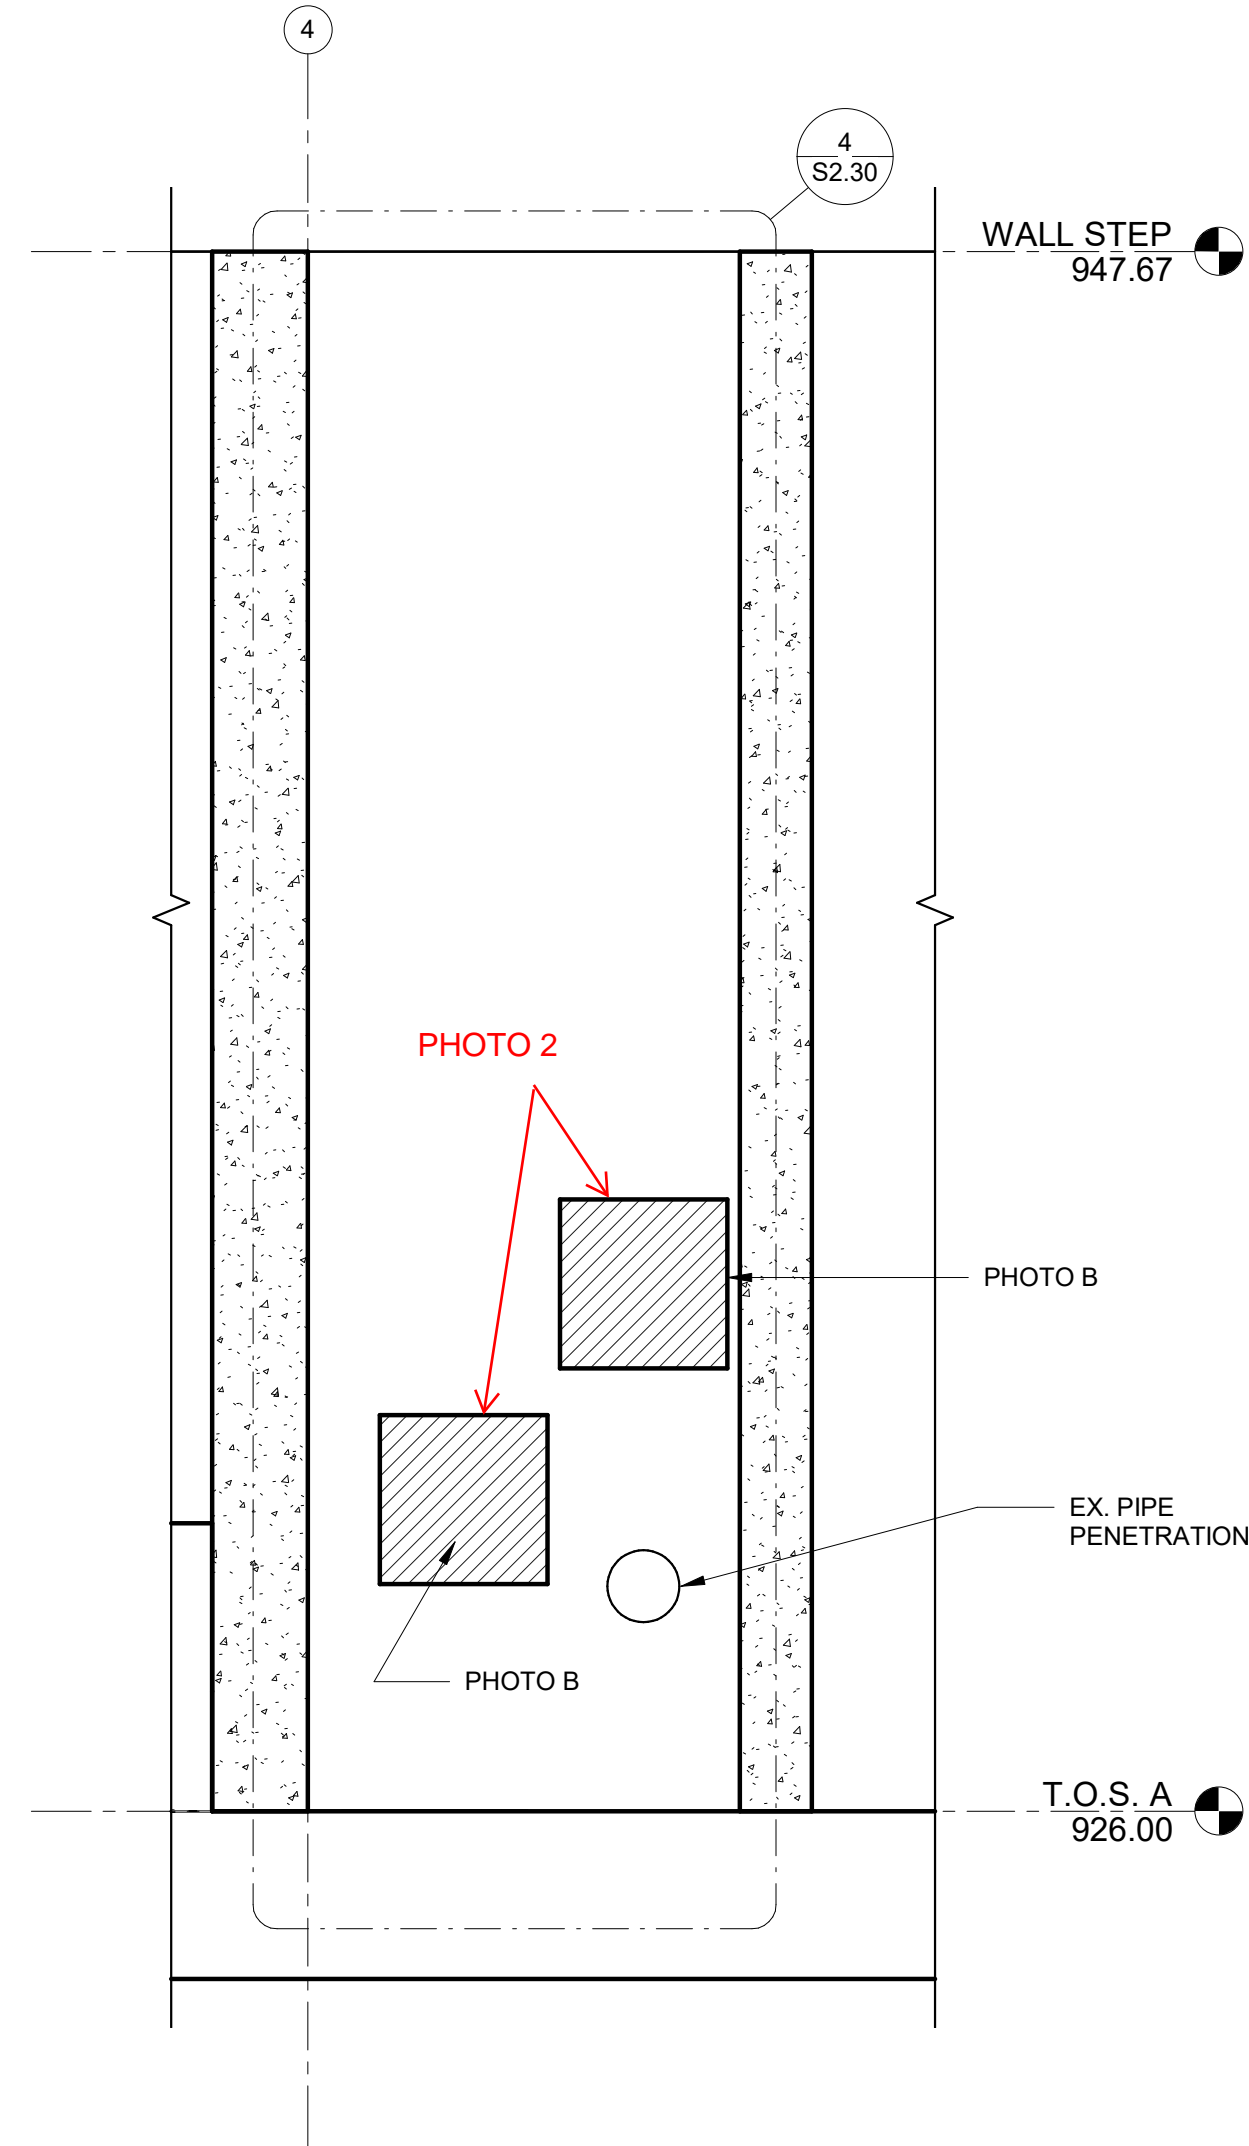

2 INTERIOR ELEVATION
3/8" = 1'-0"

SEE DETAIL 5/S3.01
COORDINATE CON. PROTECTION LINER
PANEL JOINT SEALING PRIOR TO REPAIRS W/
MANUFACTUER.

NO REPAIR
REQUIRED
AREA SHALL BE FILLED W/ CONC. FILL
AS SPECIFIED ON ORIGINAL
CONSTRUCTION DOCUMENTS. THIS
WILL SERVE AS ADEQUATE CONC.
COVER



4 PHOTO B



5 PHOTO C
3/16" = 1'-0"



Before Repair



After Repair

PHOTO 1



Before Repair




After Repair (fillet was already placed prior to the before and after repair photo could be taken)

PHOTO 2


3/24/2023 5:12:02 PM

C:\Users\chris\OneDrive\Documents\123.0172.03_STRUCT\R220_chris\16BDR.vrt

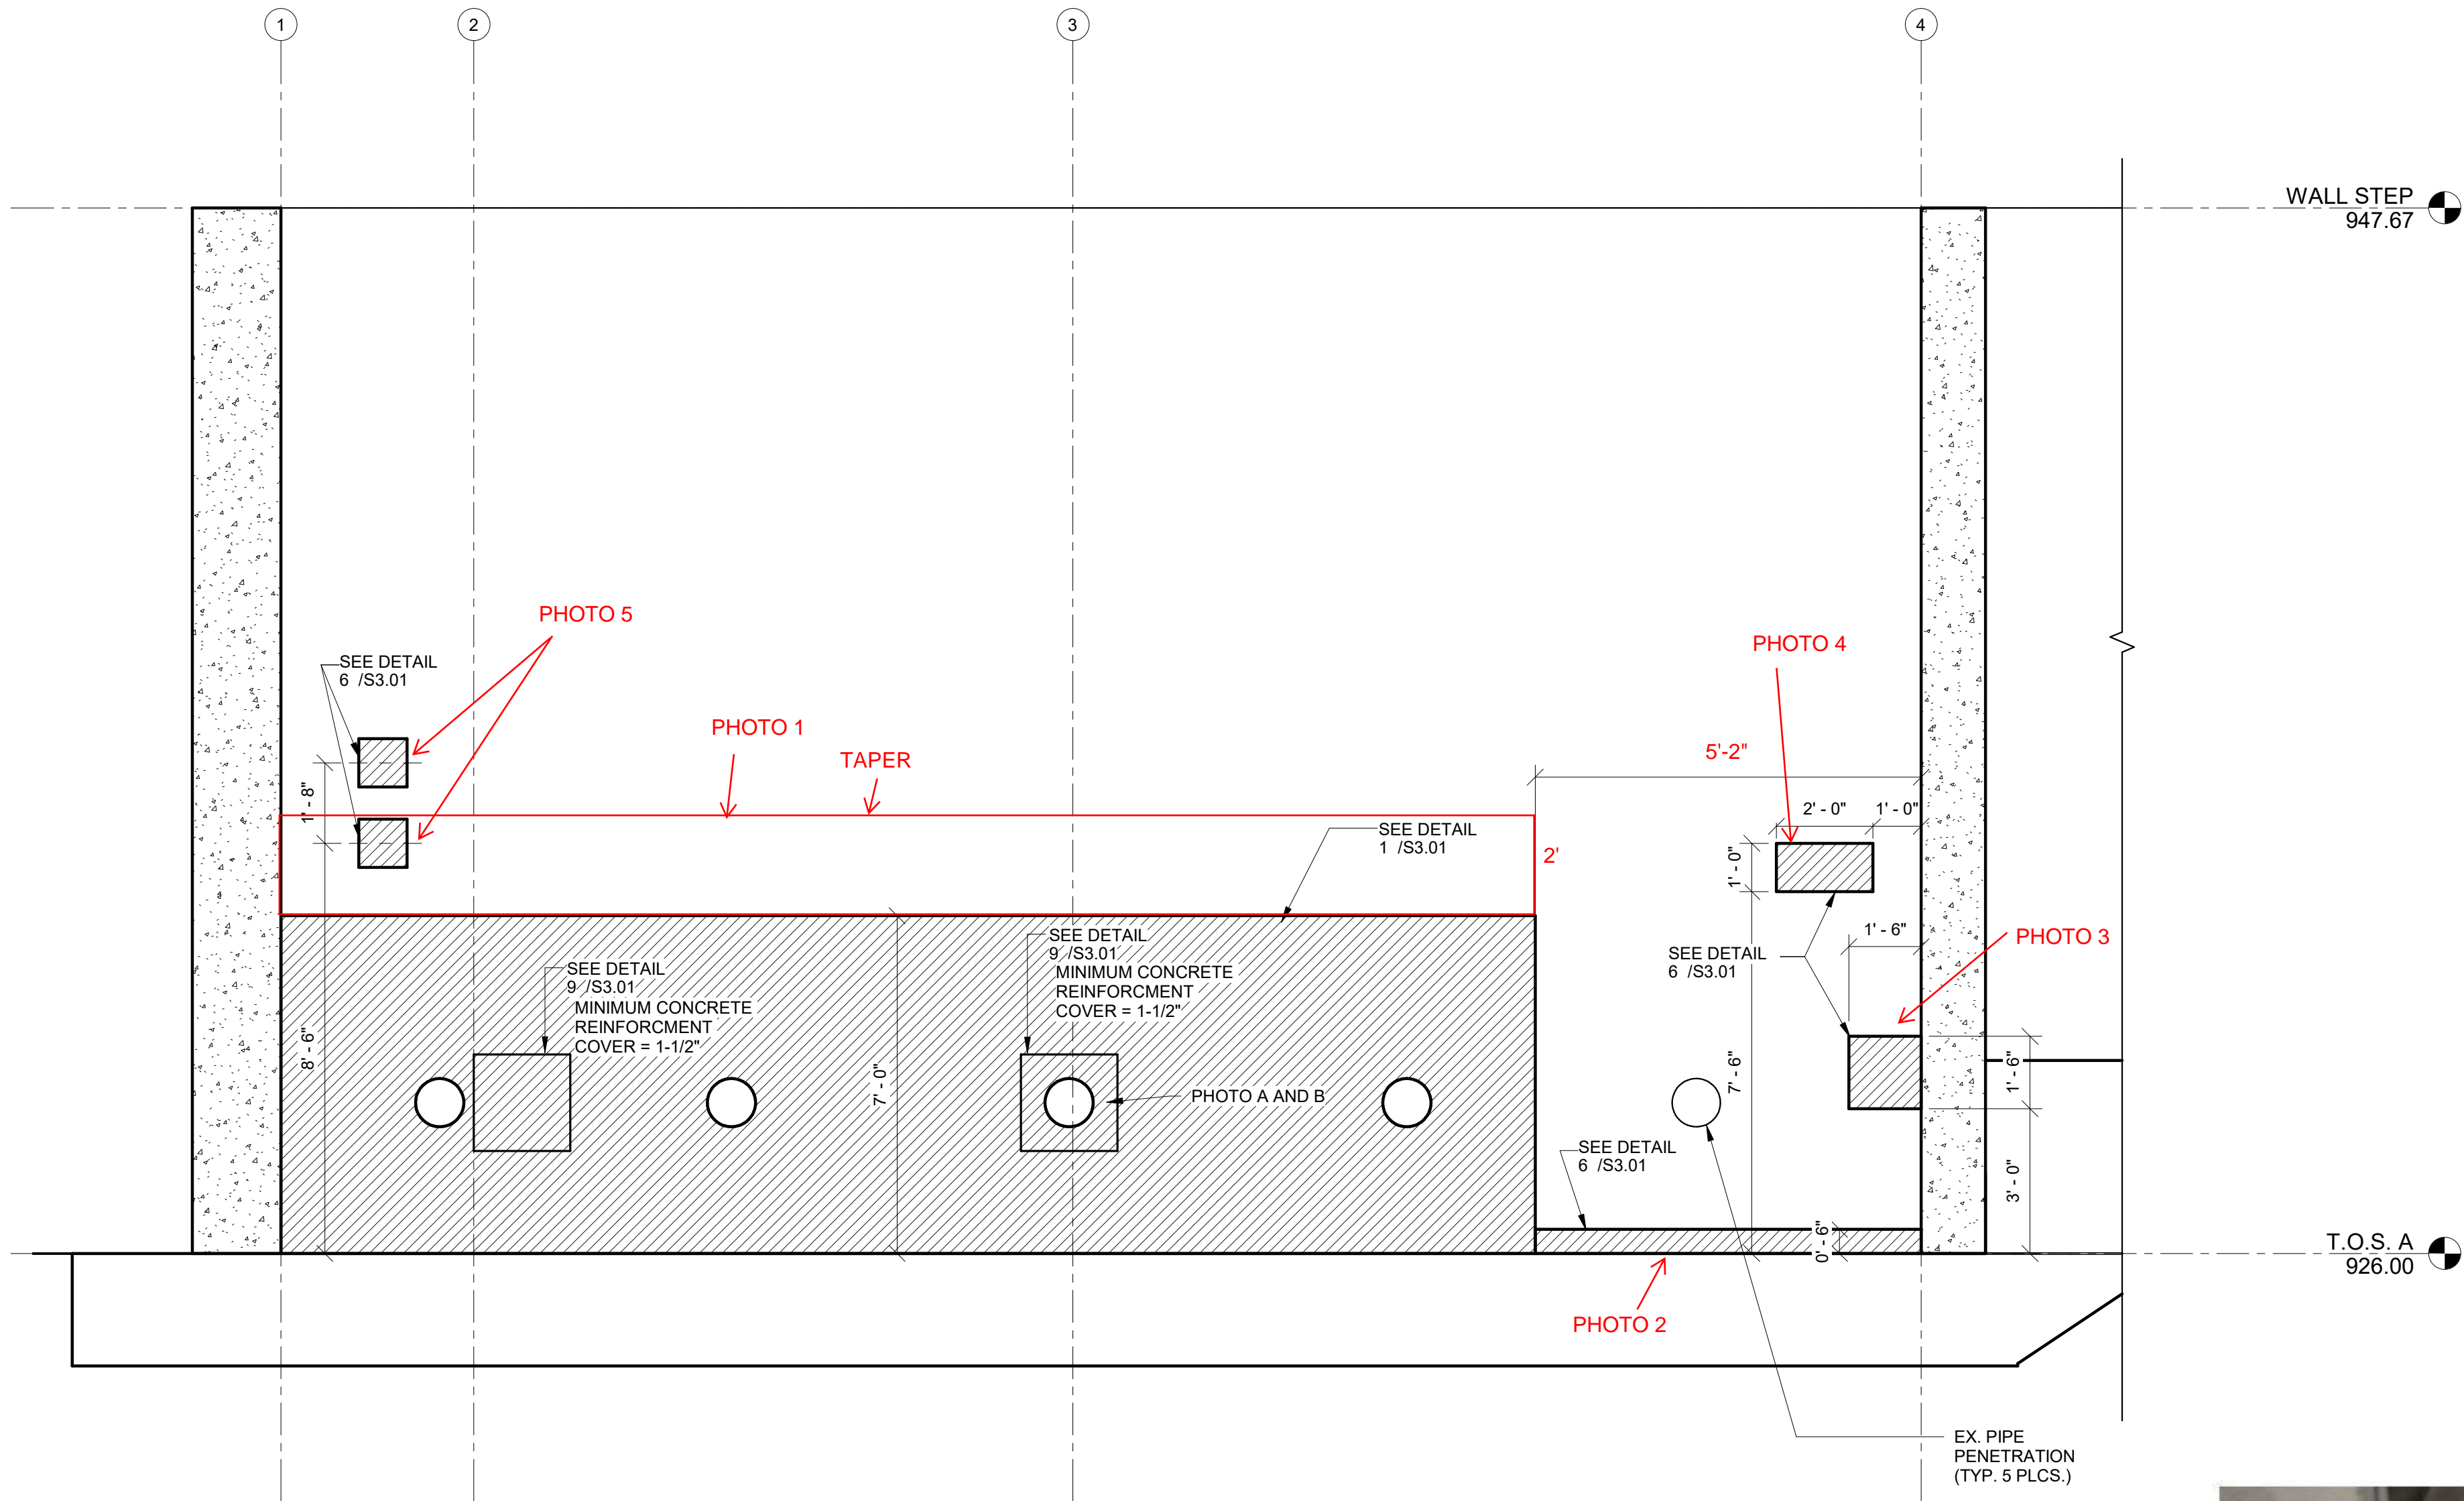

1 INTERIOR ELEVATION
3/8" = 1'-0"

ORIGINAL REPAIRS

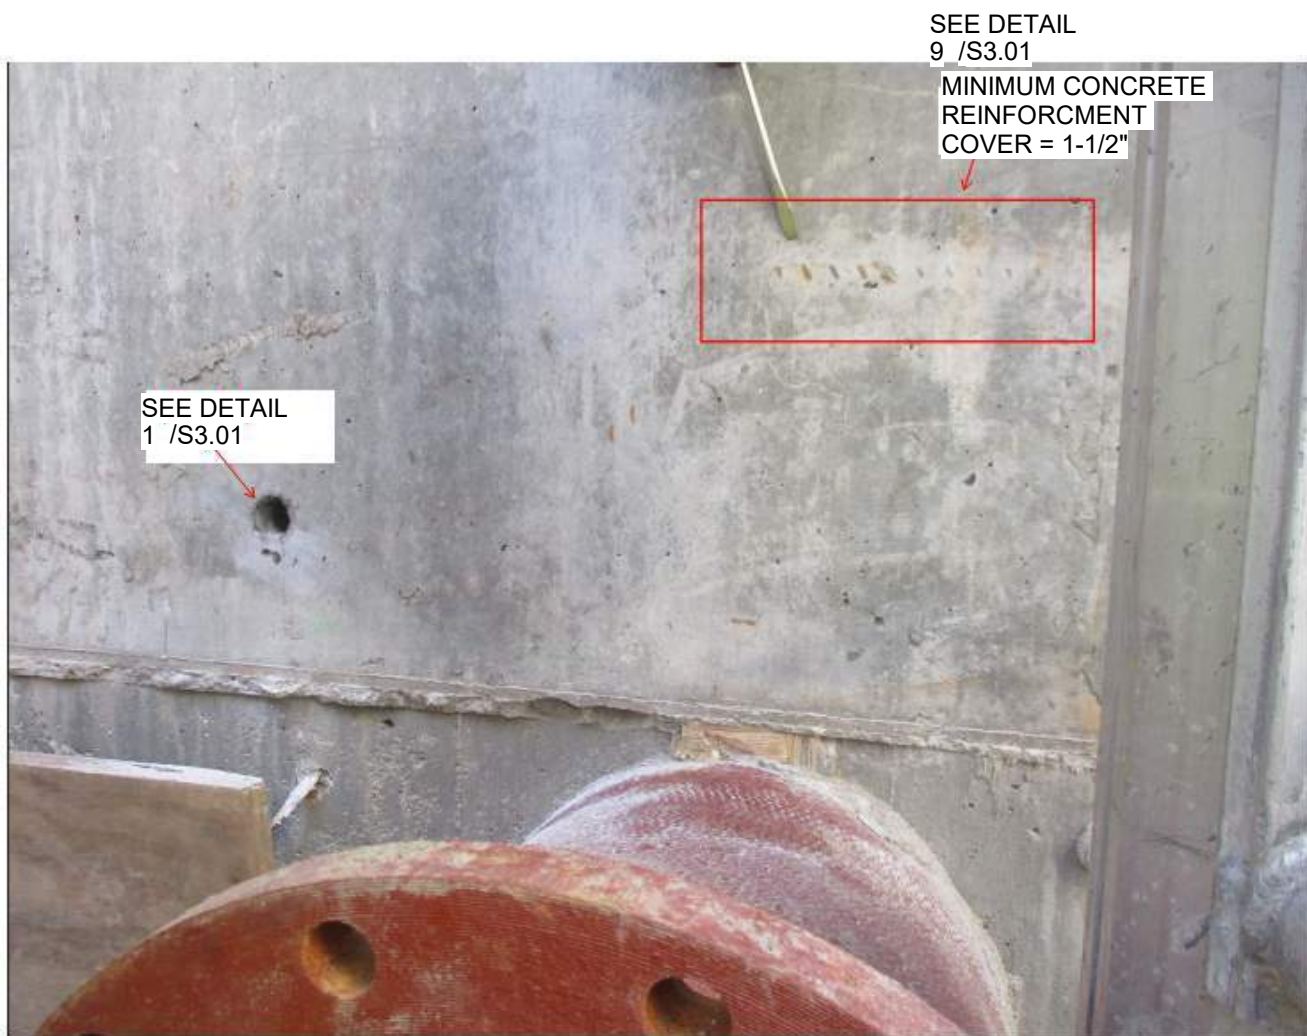

2 PHOTO A



3 PHOTO B



SHUCK-BRITSON

400 E COURT AVE.
SUITE 140.
DES MOINES, IOWA 50309
515-243-4477
www.shuck-britson.com

NEVADA WWTP IMPROVEMENTS LIMITED
CONCRETE WALL REPAIR

BOOMERANG

457 S. 6th STREET NEVADA IOWA 50201

Project Status

PROJECT NUMBER 123.0172.03

DATE 03/24/2023

WALL ELEVATIONS

SHEET NO.

S2.31



Before Repair



Before Repair



Before Repair



After Repair

PHOTO 1



After Repair



After Repair

PHOTO 1



Before Repair



After Repair

PHOTO 2



Before Repair



After Repair

PHOTO 3



Before Repair



After Repair

PHOTO 4



Before Repair



After Repair

PHOTO 5



Before Repair



Before Repair




After Repair

PHOTO 6



After Repair

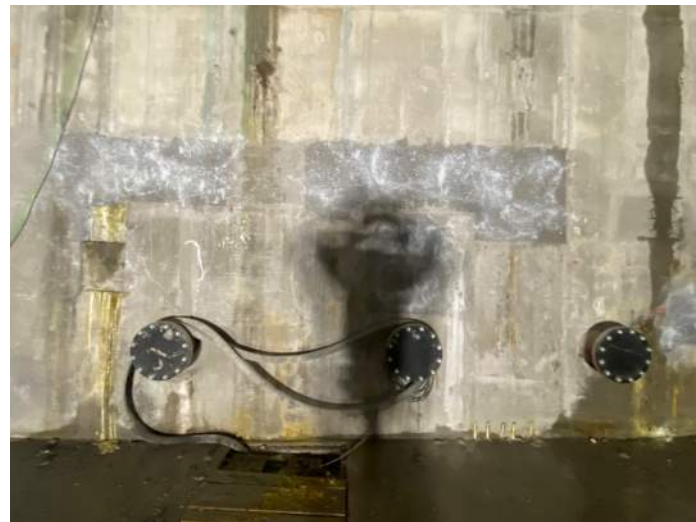

After Repair

PHOTO 6



CHUCK BRITSON

400 E COURT AVE.
SUITE 140.
ES MOINES, IOWA 50309
515-243-4477
www.shuck-britson.com

NEVADA WWTP IMPROVEMENTS LIMITED
CONCRETE WALL REPAIR

BOOMERANG
457 S. 6th STREET NEVADA IOWA 50201

Project Status


PROJECT NUMBER	123.0172.03
----------------	-------------

DATE 03/24/2023

ALL ELEVATIONS

SHEET NO. _____

S2.32

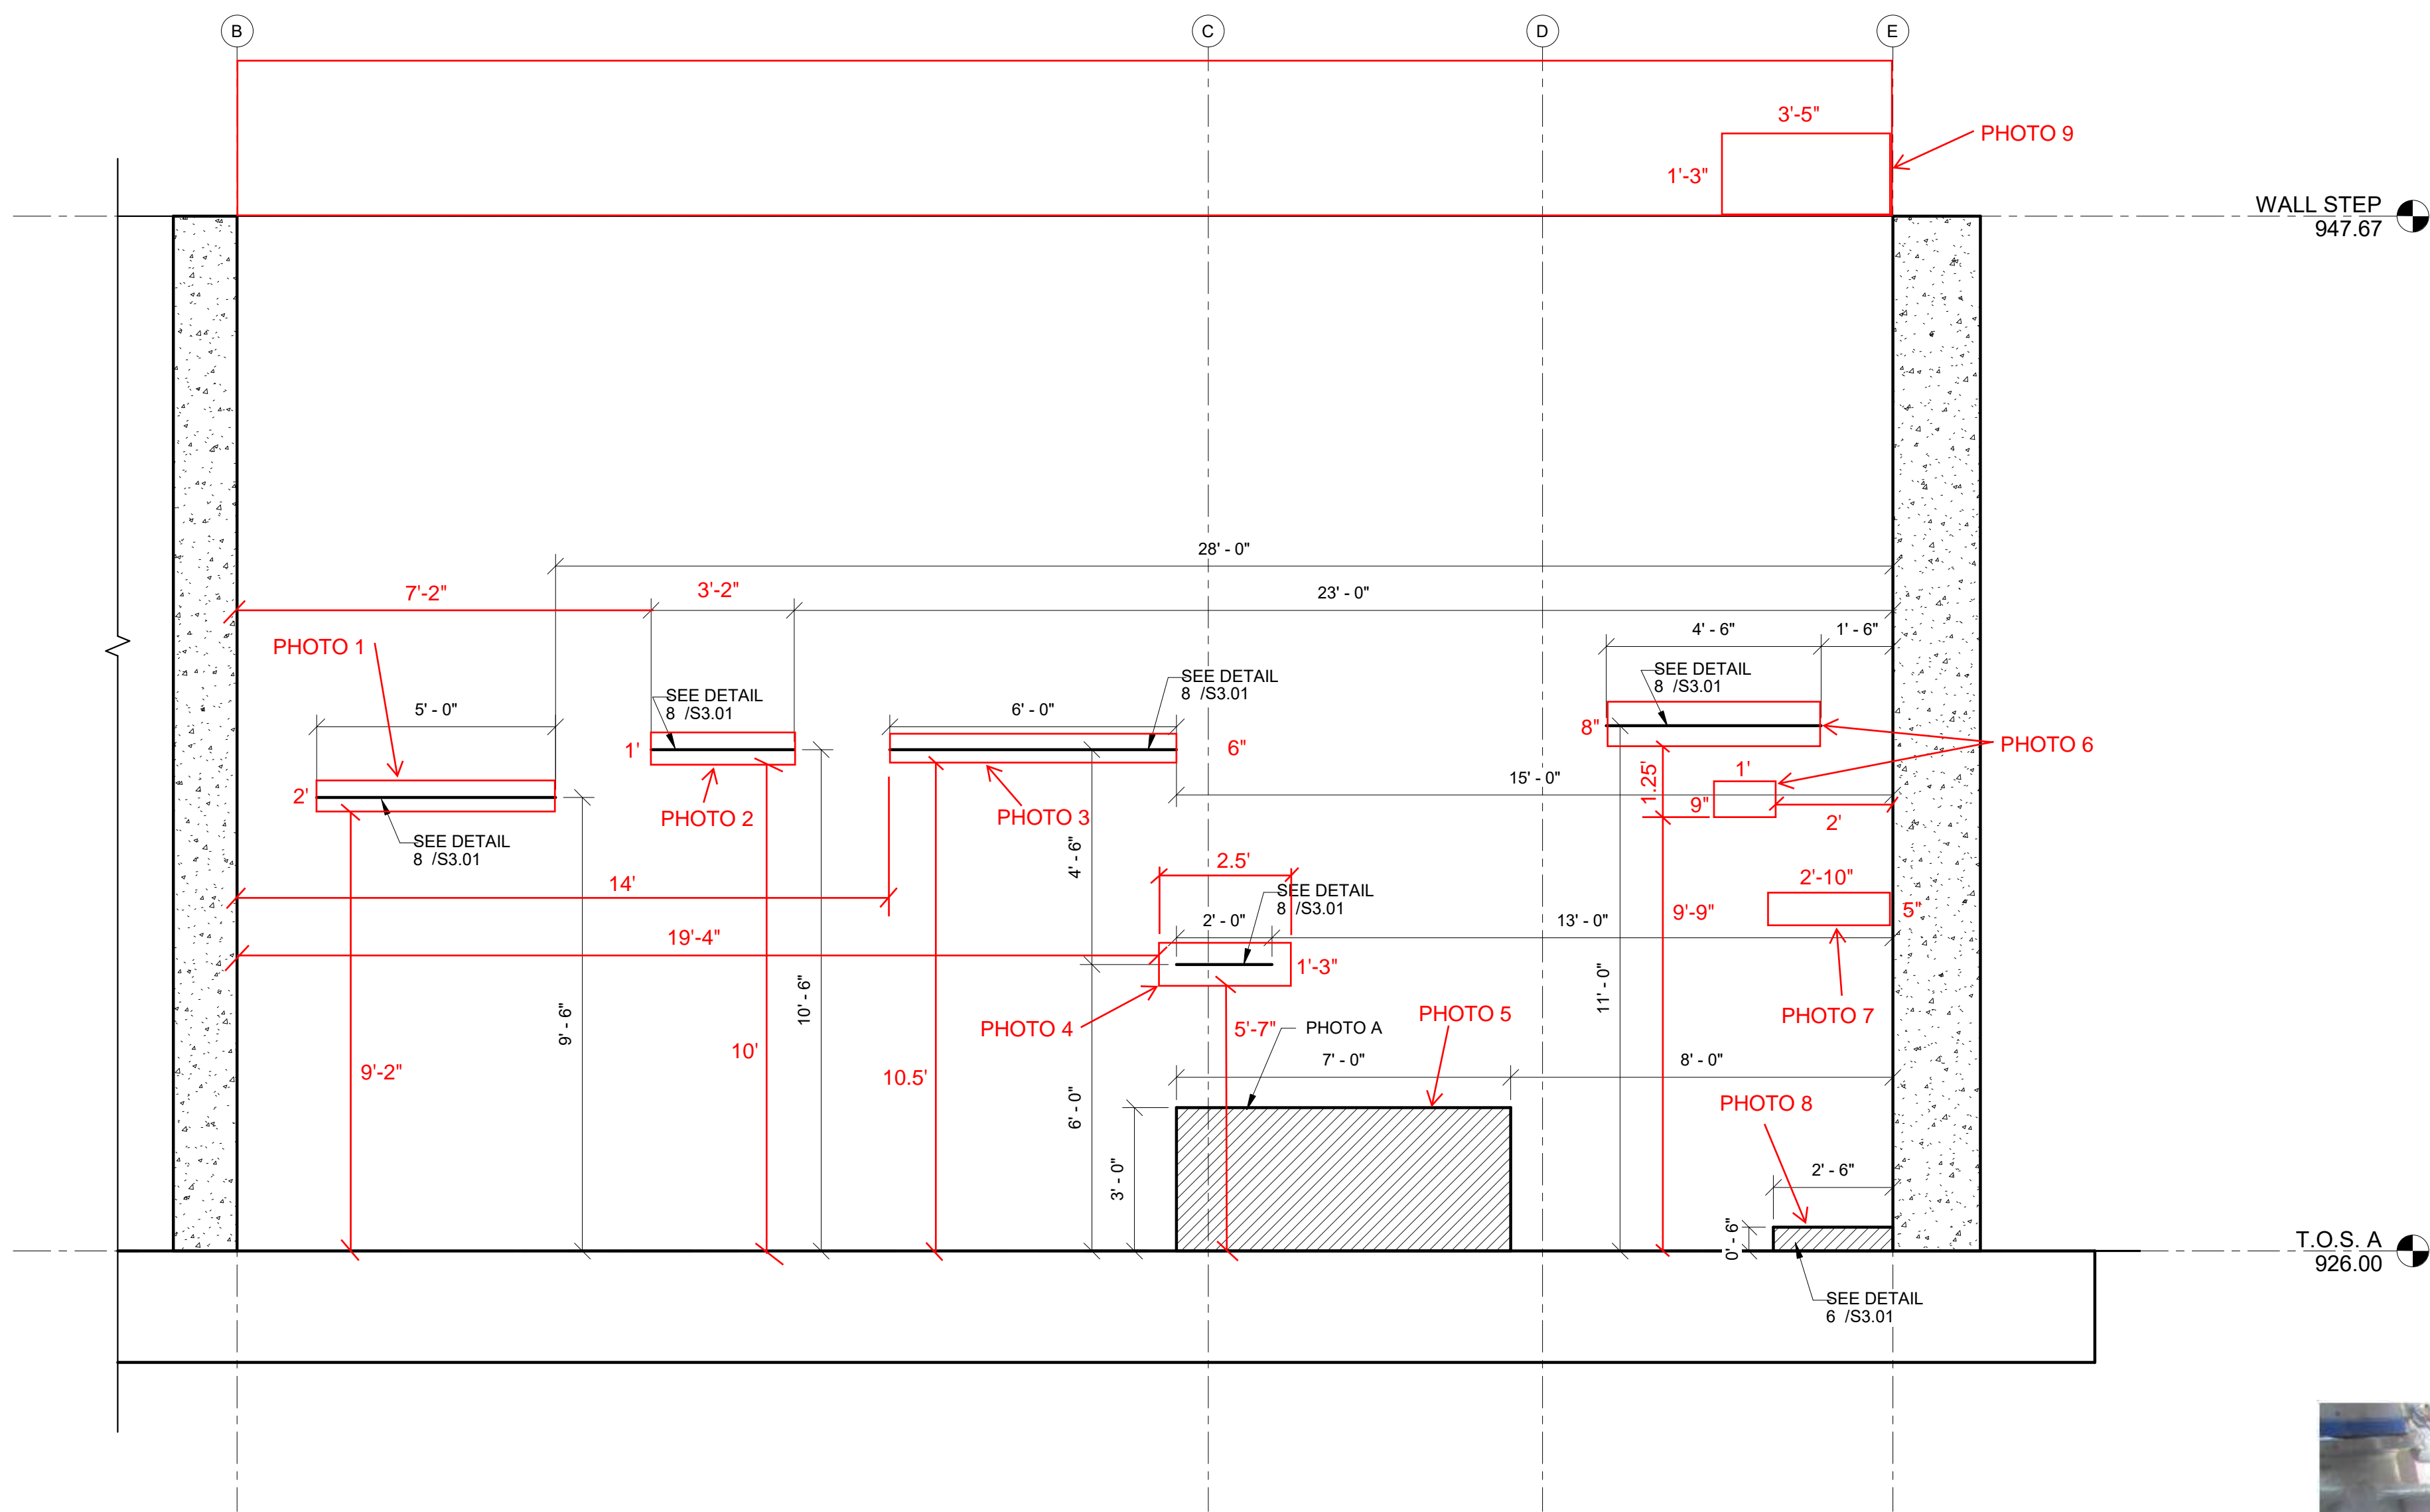

1 INTERIOR ELEVATION
3/8" = 1'-0"


ORIGINAL REPAIRS



② PHOTO A

3/24/2023 5:12:02 PM

C:\Users\shuckb\Documents\123.0172.03_STRUCT\REV2_civil\wall6BDR.dwg

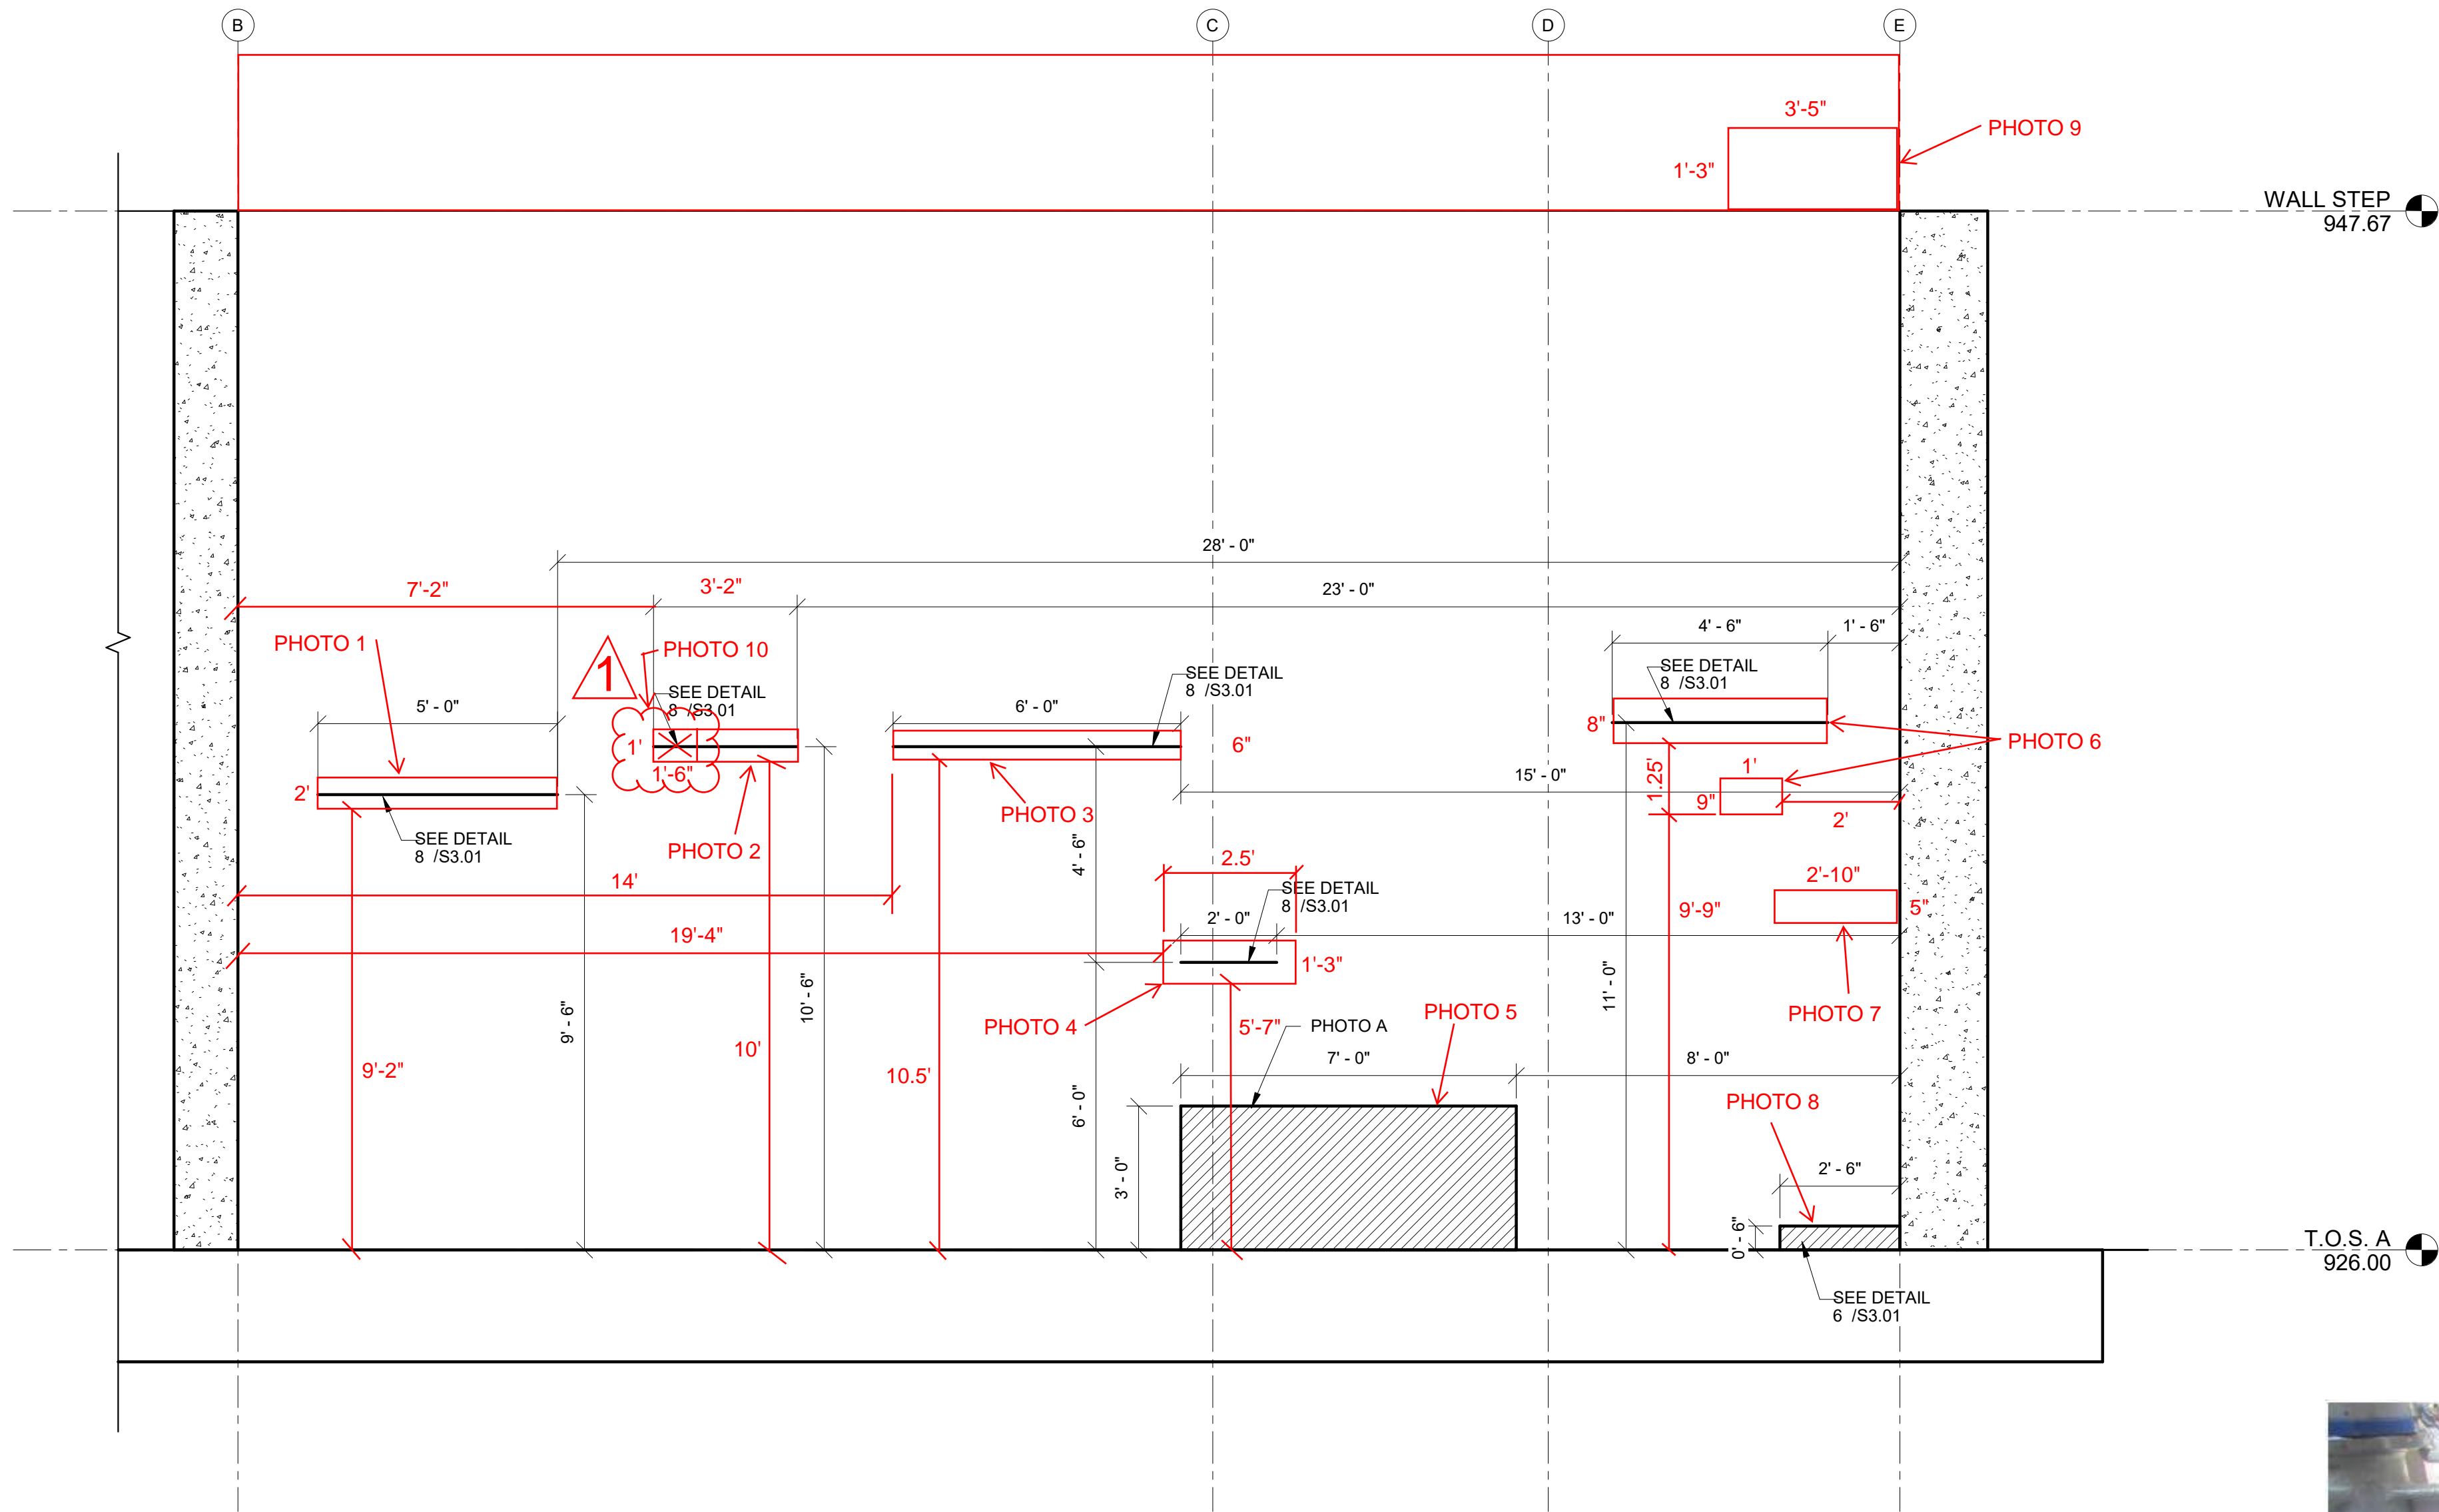

1 INTERIOR ELEVATION
3/8" = 1'-0"

1 REVISION 1: REPAIRED EXISTING REPAIRS

LEGEND:

X DENOTES REMOVAL



2 PHOTO A



Before Repair



After Repair

PHOTO 1



Before Repair



After Repair

PHOTO 2



Before Repair



After Repair

PHOTO 3



Before Repair



After Repair

PHOTO 4



Before Repair



After Repair

PHOTO 5



Before Repair



After Repair

PHOTO 6



Before Repair



After Repair

PHOTO 7



Before Repair



After Repair

PHOTO 8



Before Repair



After Repair

PHOTO 9



Before Repair





After Repair

PHOTO 10



3/24/2023 5:12:03 PM

C:\Users\chris\OneDrive\Documents\123.0172.03_STRUCT\R220_chriswall6BDR.dwg

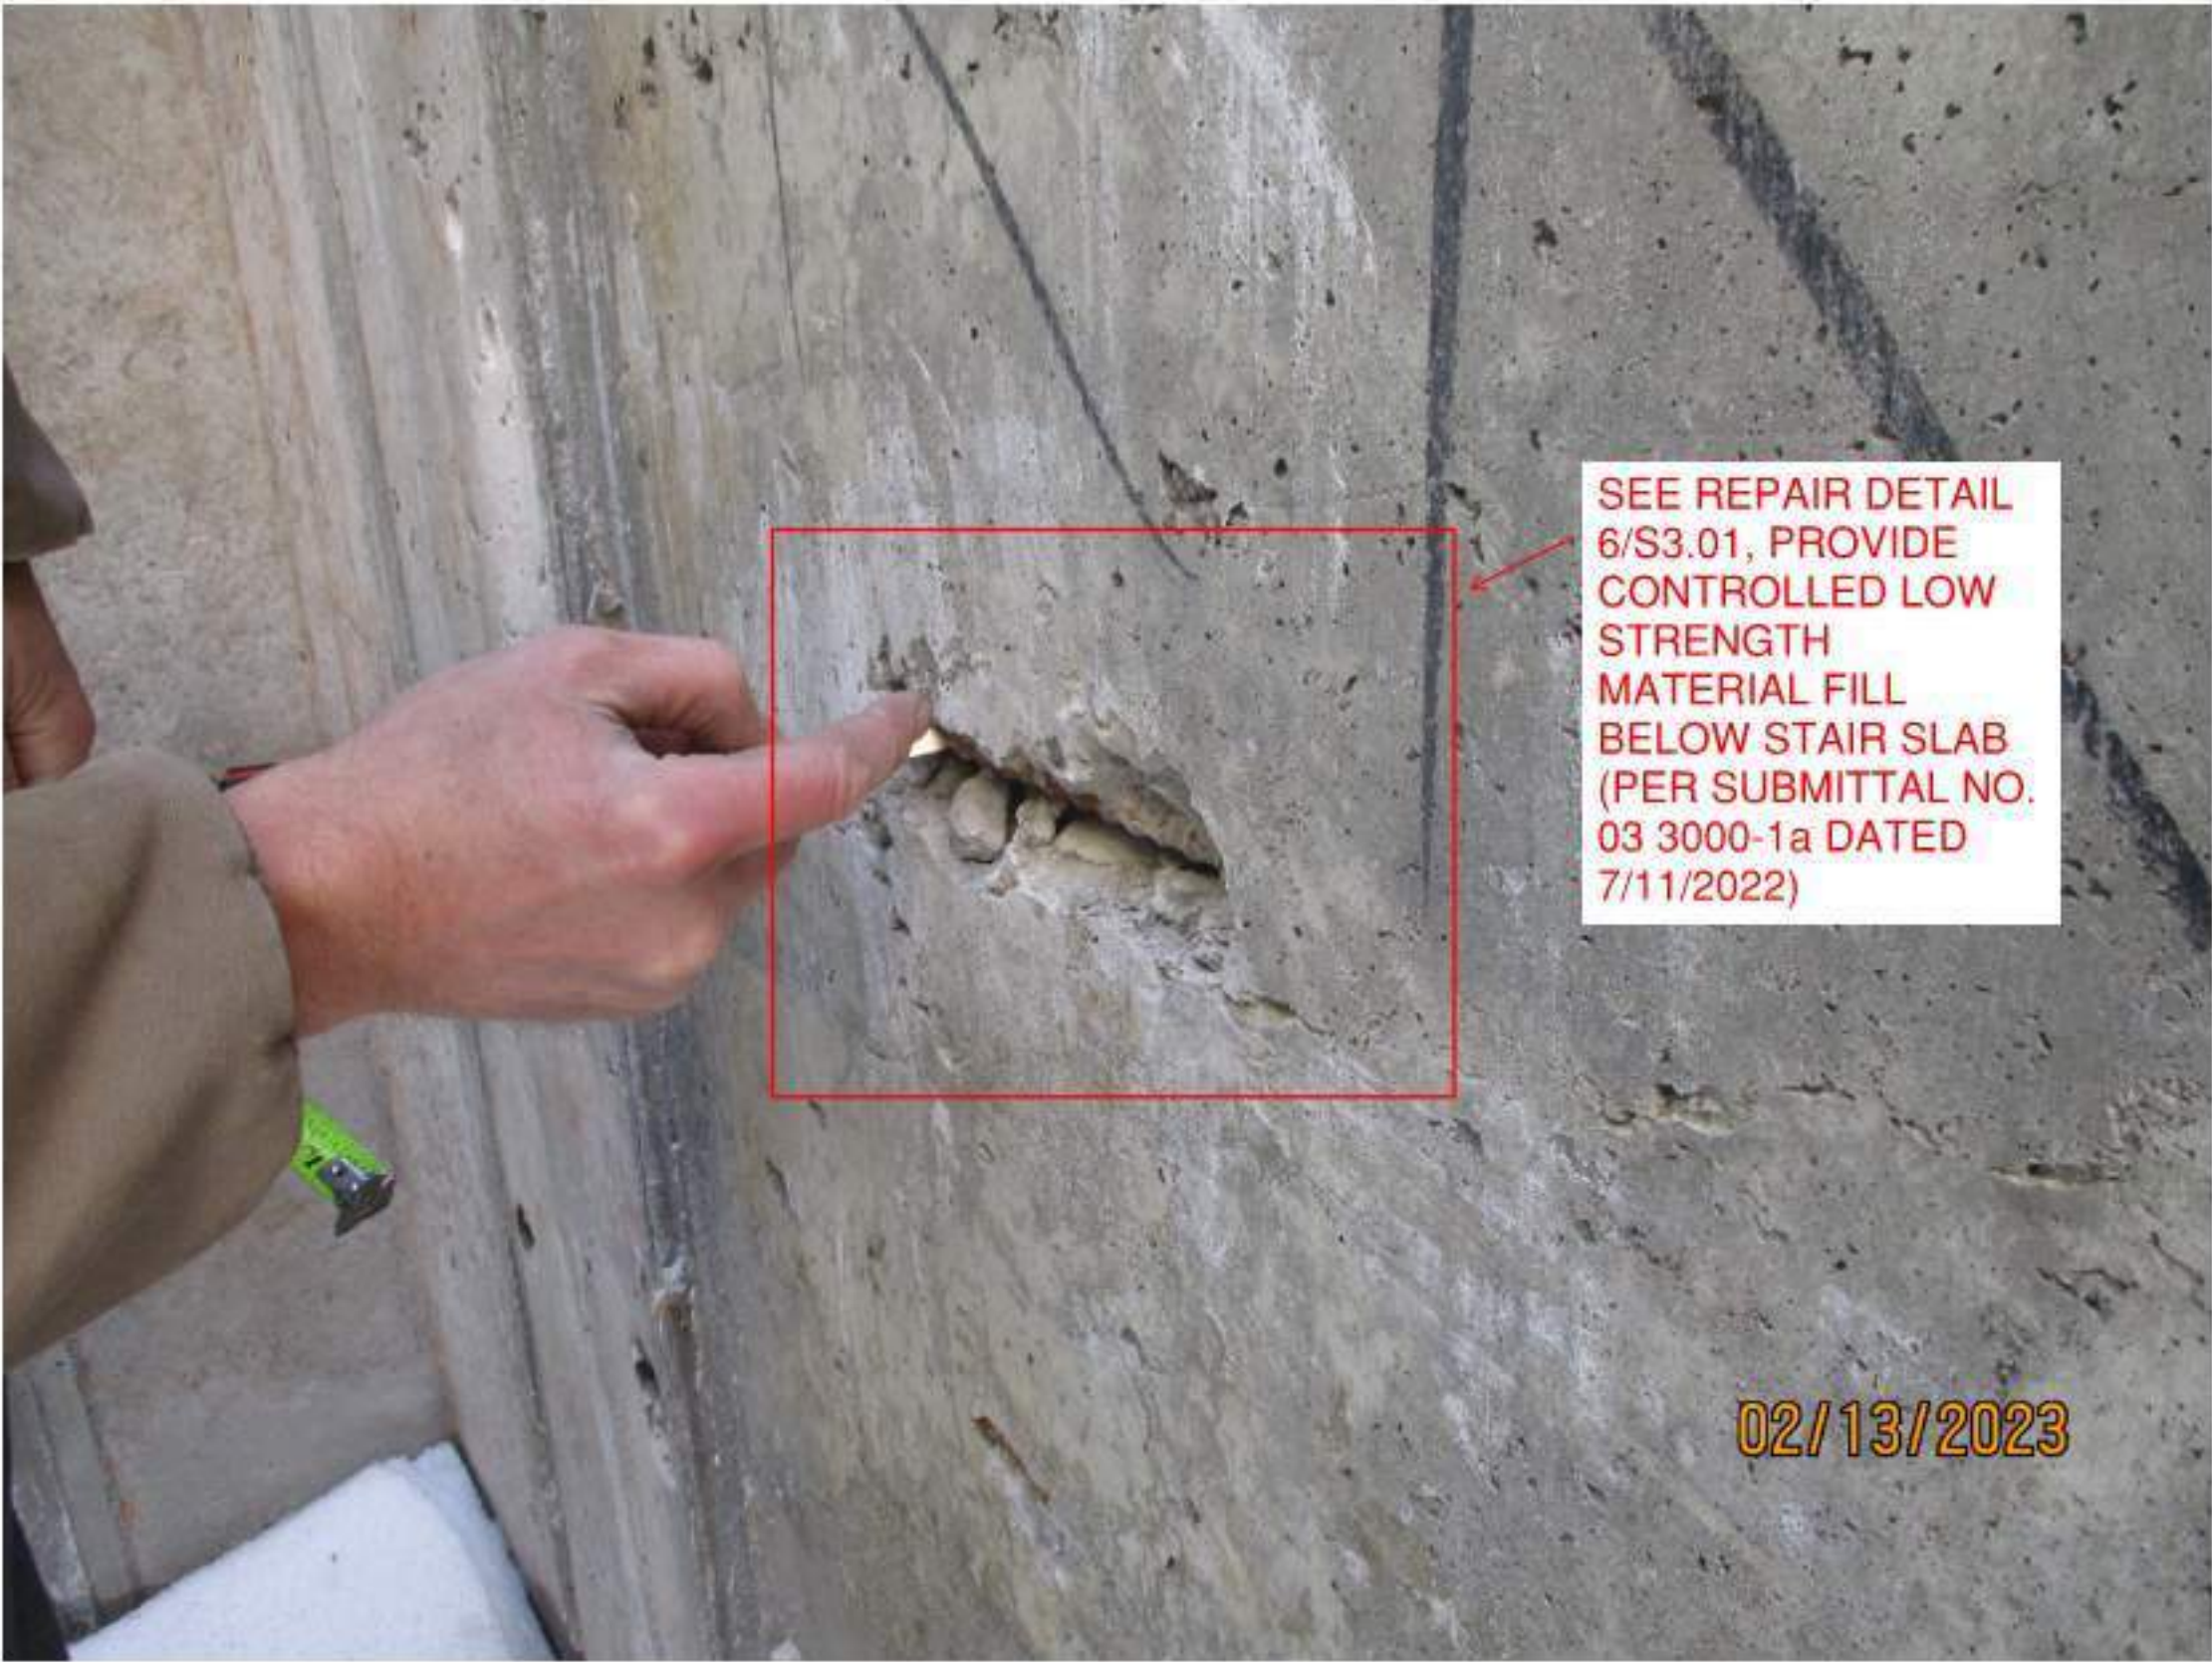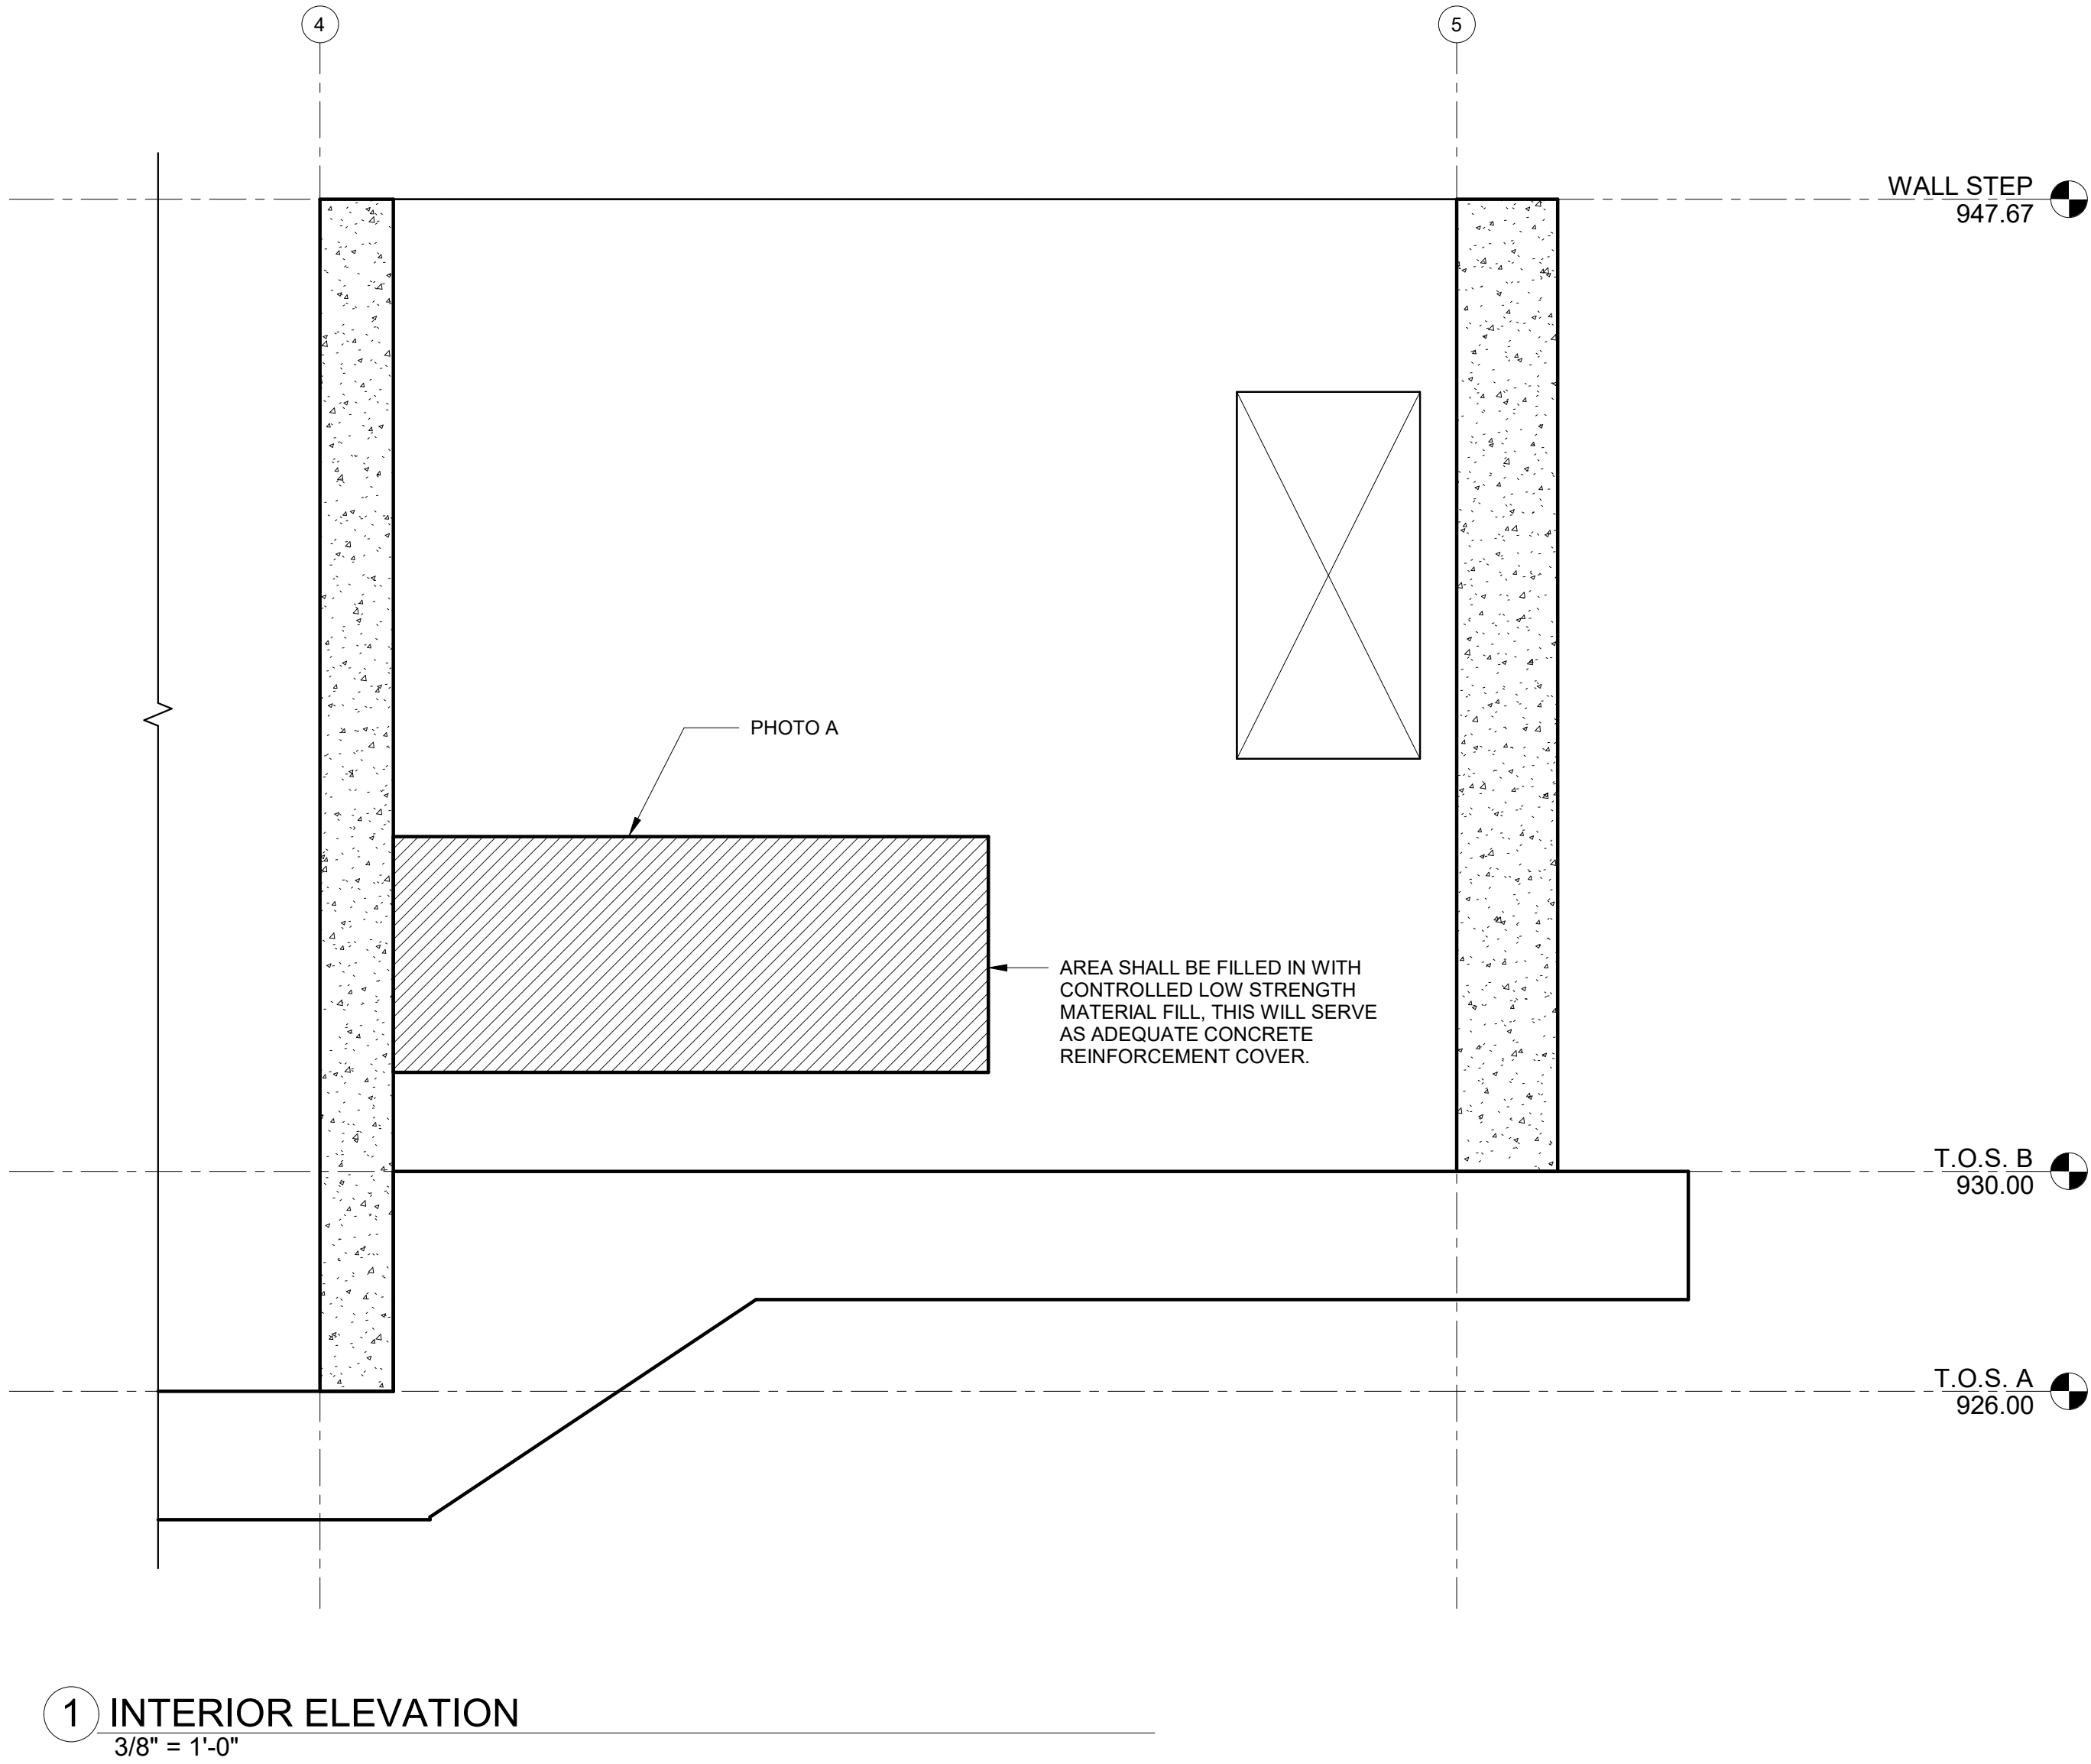

2 PHOTO A



SHUCK BRITSON

400 E COURT AVE.
SUITE 140.
DES MOINES, IOWA 50309
515-243-4477
www.shuck-britson.com

NEVADA WWTP IMPROVEMENTS LIMITED
CONCRETE WALL REPAIR

BOOMERANG

457 S. 6th STREET NEVADA IOWA 50201

Project Status

PROJECT NUMBER 123.0172.03

DATE 03/24/2023

SHEET TITLE
WALL ELEVATIONS

SHEET NO.

S2.33



- ## ⑨ CONCRETE COVER REPAIR DETAIL





- REPAIR ALL CONCRETE SPOILS WITH AVANTI AV-202 LV. AERATION PIPE SHALL BE LOCATED ABOVE FILL PIPE TO ENSURE ENTIRE VOID IS REPAIRED. CONCRETE SHALL BE SATURATED SURFACE DRY PRIOR TO REPAIR. FILL ENTIRE VOID WITH WATER AND COMPLETELY DRAIN PRIOR TO REPAIR. INSTALL PER MANUFACTURER RECOMMENDATIONS
2. NEW PATCH SHALL MATCH EXISTING FINISH.
3. SURFACE PREP EXISTING EXTERIOR CONCRETE AND REPAIRS PER BENTONITE WATERPROOFING MANUFACTURER.
4. PATCH ALL TIE HOLES PER REPAIR NOTE 6.
5. FULL DEPTH CONCRETE REPAIRS SHALL BE REPAIRED WITH SIKA CRETE - 211 SCC PLUS. REMOVE ALL DETERIORATED CONCRETE, DIRT, OIL, GREASE AND OTHER BOND INHIBITING MATERIALS FROM THE SURFACE. REMOVE ALL CORROSION FROM THE REINFORCEMENT WITH A WIRE BRUSH. APPLY BONDING AGENT, SIKA ARMATIC-110 EPOCROM TO REINFORCEMENT. CONCRETE SHALL BE SATURATED SURFACE DRY PRIOR TO REPAIR. INSTALL PER MANUFACTURER RECOMMENDATIONS.
6. PARTIAL DEPTH CONCRETE REPAIRS SHALL BE REPAIRED WITH SIKA QUICK VOH. APPLY A SCRUB COAT OF SIKA VOH TO THE CONCRETE SUBSTRATE PRIOR TO REPAIR PER MANUFACTURERS RECOMMENDATIONS. MOVE ALL DETERIORATED CONCRETE, DIRT, OIL, GREASE AND OTHER BOND INHIBITING MATERIALS FROM THE SURFACE. FOR OVERHEAD CONDITIONS, APPLY IN MAXIMUM 2" LIFTS. INSTALL PER MANUFACTURER RECOMMENDATIONS.
7. CLEAN AND PREP ALL SURFACES PER MANUFACTURERS RECOMMENDATIONS.
8. PLACE PATCH REPAIR MIX INTO PATCH AREA AND THOROUGHLY CONSOLIDATE.
9. CURE PATCH THOROUGHLY TOP AND BOTTOM. BOTTOM TO BE CURED IF FORM IS REMOVED.
10. ALL WORK SHALL BE PERFORMED AS INDICATED BY PRODUCT MANUFACTURER INCLUDING ANY COLD WEATHER CONCRETE PRACTICES.
11. PROVIDE FORMS WHERE NECESSARY TO CONFINED PATCH TO REQUIRED SHAPE.
12. WET SUBSTRATE AND FORMS THOROUGHLY AN THEN REMOVE STANDING WATER.
13. GENERAL TROWEL PLACEMENT: PLACE PATCHING MORTAR BY TROWELLING TOWARD EDGES OF PATCH TO FORCE INTIMATE CONTACT WITH EDGE SURFACES. FOR LARGE PATCHES, FILL EDGES FIRST AND THEN WORK TOWARD CENTER. ALWAYS TROWELLING TOWARD EDGES OF PATCH. AT THE END OF REINFORCING BARS, DRILL 2" DIAMETER HOLES THROUGH THE PATCH BEHIND BARS BY COMPACTING WITH TROWEL FROM SIDES OF BARS.
14. VERTICAL PATCHING: PLACE MATERIAL IN LIFTS OF NOT MORE THAN 1 INCH OR AS INDICATED BY MANUFACTURER, OR LESS THAN 1/4 INCH. DO NOT FEATHER EDGE.
15. CONSOLIDATION: AFTER EACH LIFT IS PLACED, CONSOLIDATE MATERIAL AND SCREED SURFACE.
16. MULTIPLE LIFTS: WHERE MULTIPLE LIFTS ARE USED, SCORE SURFACE OF LIFTS TO PROVIDE A ROUGH SURFACE FOR PLACING SUBSEQUENT LIFTS AND INSTALL PER MANUFACTURERS RECOMMENDATIONS.
17. FINISHING: ALLOW SURFACES OF LIFTS THAT ARE TO REMAIN EXPOSED TO BECOME FIRM AND THEN FINISH TO A SURFACE MATCHING ADJACENT CONCRETE.
18. CURE IN STRICT ACCORDANCE WITH MANUFACTURERS RECOMMENDATIONS.
19. THE BOTTOM OF CONCRETE SLAB SHALL BE REPAIRED WITH SIKAQUICK FNP. REMOVE ALL LOOSE CONCRETE, DIRT, OIL, GREASE AND OTHER BOND INHIBITING MATERIALS FROM THE SURFACE. DO NOT REMOVE ALL POORLY CONSOLIDATED CONCRETE. REMOVE ALL CORROSION FROM THE REINFORCEMENT WITH A WIRE BRUSH. FORM THE BOTTOM OF THE SLAB OVER THE EXISTING AREA TO BE REPAIRED. DRILL 2" DIAMETER HOLES THROUGH THE SLAB, CENTERED IN THE REPAIR AREA. START THE FIRST 2" DIAMETER HOLE APPROXIMATELY 2' FROM THE BEGINNING OF THE REPAIR AREA AND SPACE THE HOLES APPROXIMATELY EVERY 3'-4". CONCRETE SHALL BE SATURATED SURFACE DRY PRIOR TO REPAIR. INSTALL PER MANUFACTURERS RECOMMENDATIONS.
20. THE CONCRETE ALONG THE SIDE OF THE HATCHES SHALL BE REPAIRED PER REPAIR NOTE 5. FORM THE SIDE OF THE ENTIRE REPAIR AREA. DRILL (3)- 3" DIAMETER HOLES CENTERED ON THE REPAIR AREA AND EQUALLY SPACED ALONG THE LENGTH OF THE REPAIR. INSTALL PER MANUFACTURERS RECOMMENDATIONS.
21. THE CORNER OF THE CONCRETE WALL AND SLAB SHALL BE REPAIRED PER REPAIR NOTE 5. FORM THE SLAB AND WALL ALONG THE ENTIRE REPAIR AREA. AFTER THE REMOVALS ARE COMPLETE, COORDINATE WITH THE ENGINEER ON THE SIZE OF THE REPAIR AREA PRIOR TO EXECUTING THE REPAIR. INSTALL PER MANUFACTURERS RECOMMENDATIONS.
22. REPAIR PER REPAIR NOTE 6. AFTER THE SIKA QUICK VOH HAS CURED FOR A MINIMUM OF 3 DAYS, APPLY 2 COATS OF SIKAGARD 62 OVER A MINIMUM 2'X2' AREA. INSTALL PER MANUFACTURERS RECOMMENDATIONS.



Project Status	
PROJECT NUMBER	123.0172.03
DATE	10/27/2023
SHEET TITLE	
CONCRETE REPAIR DETAILS	
SHEET NO.	
S3.01	


Door Embed Notes/Details:

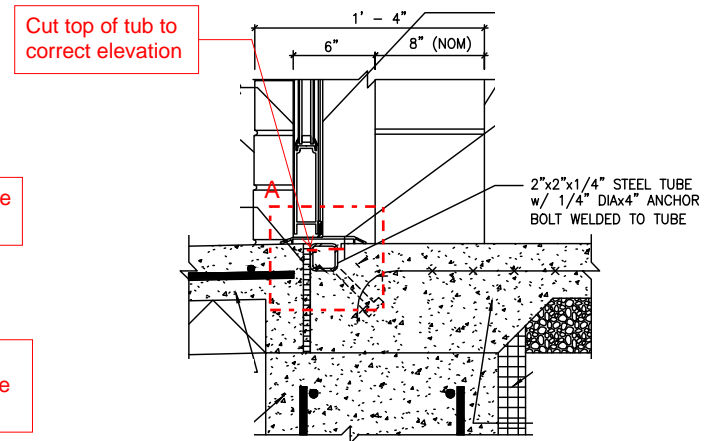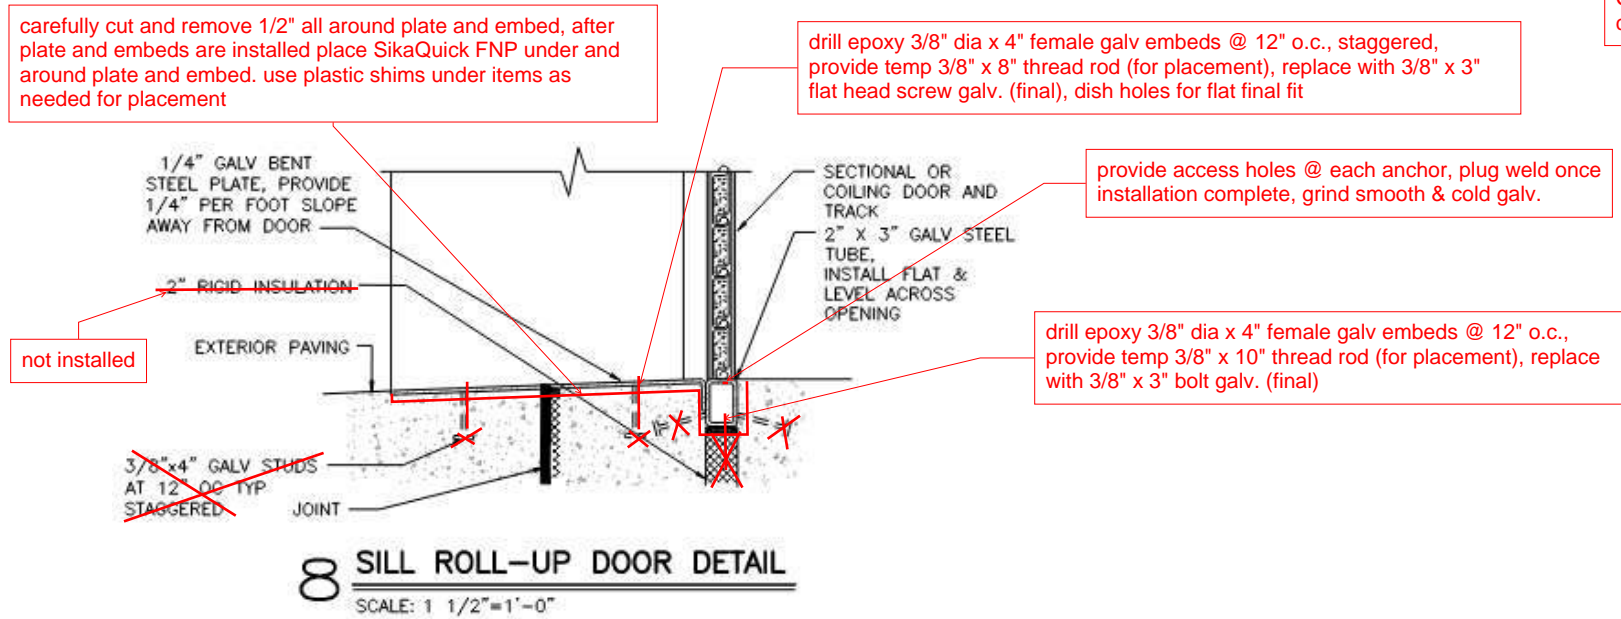

5 ALUM FRAME THRESHOLD

SCALE: 1 1/2" = 1'-0"

Note: SikaQuick FNP inside tube must not contain aggragate!

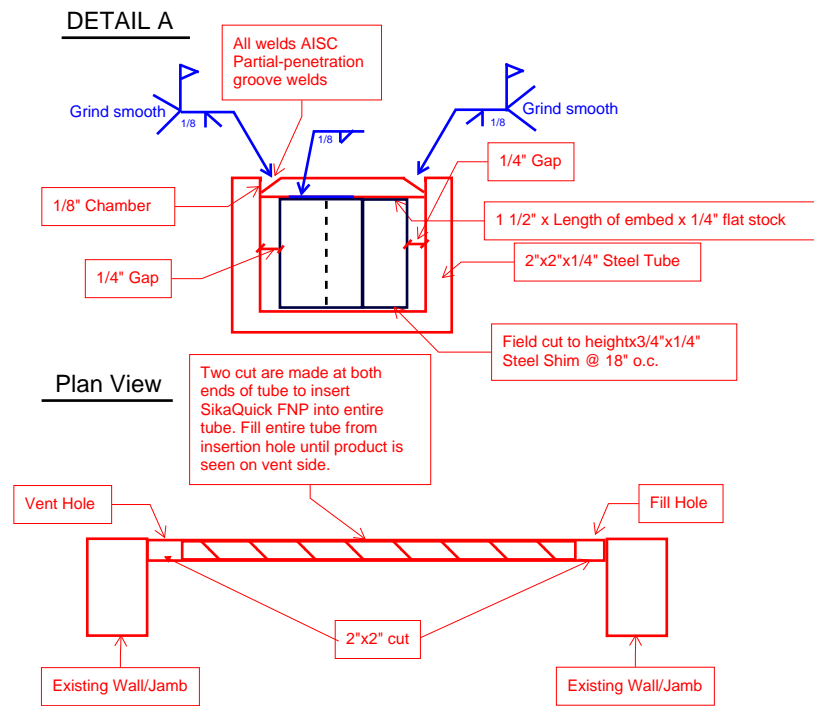


Modified Detail from HRG SHT. A.502

DOOR					DOOR SCHEDULE			DETAILS			RATING (HR)	HARDWARE GROUP NUMBER	REMARKS
NO.	LOCATION	SIZE (WxHxD)	MAT'L	TYPE	SIZE (WxHxD)	MAT'L	TYPE	HEAD	JAMB	SILL			
SERIES 100 - MAIN LIFT STATION - SCREEN ROOM													
1001A	SCREEN STAIR ENCLOSURE	3'-0" X 7'-0" X 1 3/4"	AL	D1	3'-4" X 7'-4" X 5 3/4"	AL	F1	3/A.502	4/A.502	5/A.502		1	Exterior
1001B	SCREEN STAIR ENCLOSURE	3'-0" X 7'-0" X 1 3/4"	FRP	D1	3'-4" X 7'-4" X 5 3/4"	FRP	F1	1/A.502	2/A.502		1.5	2	Interior
1001C	SCREEN STAIR ENCLOSURE - LOWER	3'-0" X 7'-0" X 1 3/4"	FRP	D1	3'-4" X 7'-4" X 5 3/4"	FRP	F1	1/A.502	2/A.502		1.5	2	Interior
1003	UPPER LEVEL SCREEN ROOM	6'-0" X 7'-0" X 1 3/4"	AL	D2	6'-4" X 7'-4" X 5 3/4"	AL	F2	3/A.502	4/A.502	5/A.502		4	Double Exterior
SERIES 110 - MAIN LIFT STATION - PUMP/SERVICE AREA													
1101A	PUMP STAIR ENCLOSURE	3'-0" X 7'-0" X 1 3/4"	AL	D1	3'-4" X 7'-4" X 5 3/4"	AL	F1	3/A.502	4/A.502	5/A.502		1	Exterior
1101B	PUMP STAIR ENCLOSURE	3'-0" X 7'-0" X 1 3/4"	FRP	D1	3'-4" X 7'-4" X 5 3/4"	FRP	F1	1/A.502	2/A.502		1.5	3	Interior
1101C	PUMP STAIR ENCLOSURE-LOWER	3'-0" X 7'-0" X 1 3/4"	FRP	D1	3'-4" X 7'-4" X 5 3/4"	FRP	F1	1/A.502	2/A.502		1.5	2	Interior
1103A	SERVICE ROOM	3'-0" X 7'-0" X 1 3/4"	AL	D1	3'-4" X 7'-4" X 5 3/4"	AL	F1	3/A.502	4/A.502	5/A.502		1	Exterior
1103B	SERVICE ROOM	8'-0"X10'-0"	AL	D3		AL		6/A.502	7/A.502	8/A.502			Colling
1104A	ELECTRICAL ROOM	6'-0" X 7'-0" X 1 3/4"	AL	D2	6'-4" X 7'-4" X 5 3/4"	AL	F2	3/A.502	4/A.502	5/A.502		5	Double Exterior
1104B	ELECTRICAL ROOM	3'-0" X 7'-0" X 1 3/4"	AL	D1	3'-4" X 7'-4" X 5 3/4"	AL	F1	3/A.502	4/A.502	5/A.502		6	Exterior
1105	RESTROOM	3'-0" X 7'-0" X 1 3/4"	AL	D1	3'-4" X 7'-4" X 5 3/4"	AL	F1	1/A.502	2/A.502			7	Interior
NOTE: AL = ALUMINUM; FRP = FIBERGLASS REINFORCED PLASTIC													

Highlighted yellow are the doors embeds that are missing or have been improperly installed

Table from HRG SHT. A.504

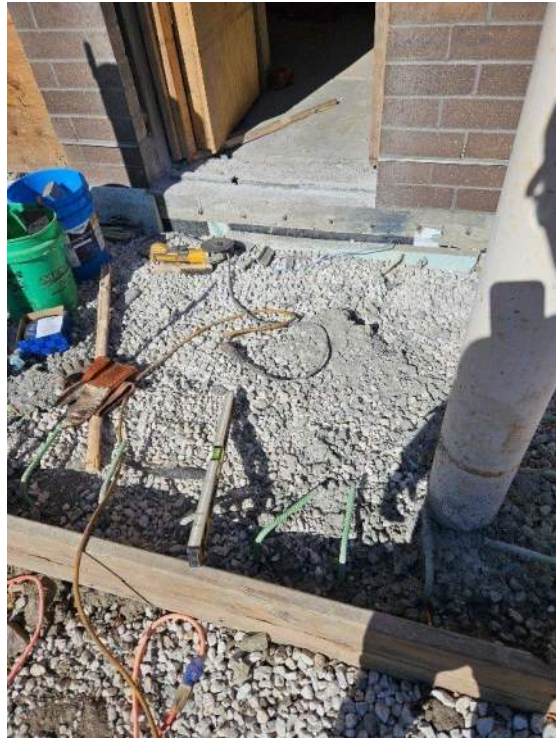

Before Repair



Before Repair



Before Repair




Before Repair


Door Embeds




After Repair

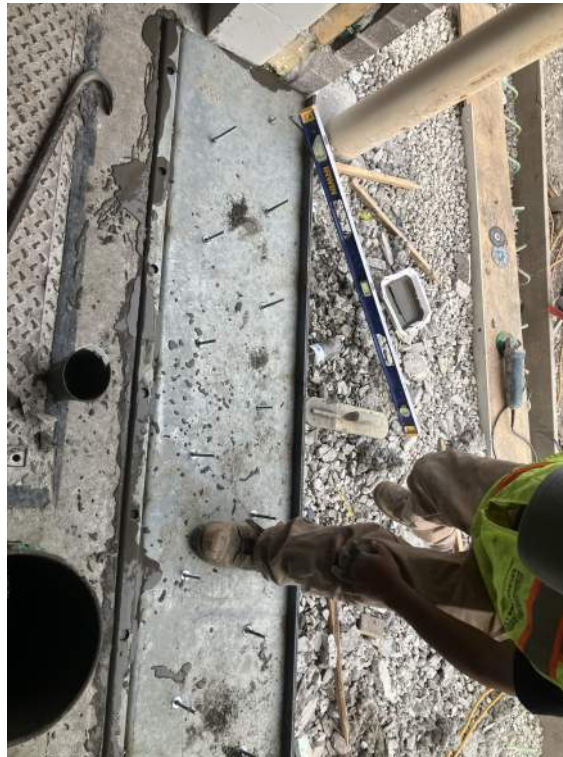

After Repair

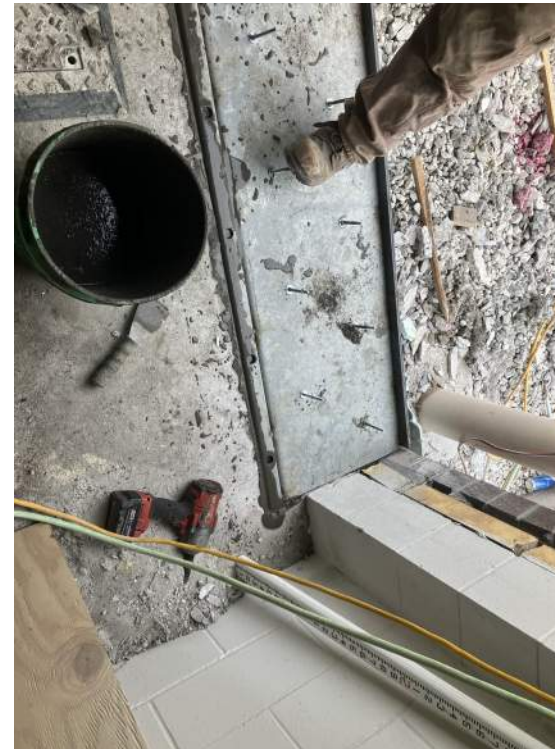

After Repair

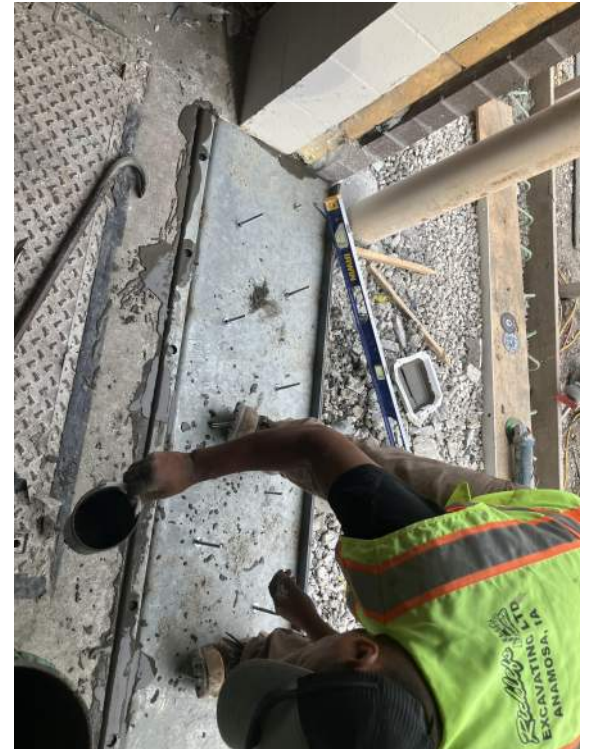

After Repair

Door Embeds

PRODUCT DATA SHEET

Sikagard®-62

High-build, protective, solvent-free, colored epoxy coating

PRODUCT DESCRIPTION

Sikagard®-62 is a High-build, protective, solvent-free, colored epoxy coating.

USES

Sikagard®-62 may only be used by experienced professionals.

Use as a high build, corrosion-resistant, protective coating, as a protective lining for secondary containment structures or as a seamless flooring system.

CHARACTERISTICS / ADVANTAGES

- Exceptional tensile strength.
- Good chemical resistance for long-term protection.
- Convenient A:B = 1:1 mixing ratio.
- Easy, paint-like viscosity.
- Available in 3 standard colors: gray, red, and tan.
- Excellent bonding to all common structural substrates.
- Super abrasion resistance for long-term wear.
- Sikagard® 62 gray in ANSI/NSF 61 potable water compliant
- Material is USDA certifiable.

PRODUCT INFORMATION

Packaging	4 gal. units
Appearance / Color	Gray, red, tan.
Shelf Life	2 years in original, unopened containers.
Storage Conditions	Store dry at 40°-95°F (4°-35°C). Condition material to 65°-75°F (18°-24°C) before using.
Viscosity	Mixed: Approximately 3,500 cps.

TECHNICAL INFORMATION

Abrasion Resistance	14 day	51 liters/mil.	(ASTM D-968)
	Abrasion (Taber Abrader)		
	Weight loss, 1,000 cycles (H-22 wheel, 1,000 gm weight)		
	7 day	0.61 gm	(ASTM D-1044)
Tensile Strength	14 day	5,400 psi (37.3 MPa)	(ASTM D-638)

Elongation at Break	14 day	2.7%	(ASTM D-638)
Tensile Adhesion Strength	Adhesion Classification 1 day	4A	(ASTM-3359)
Permeability to Water Vapor	Water Absorption (24 hour immersion) 7 day	0.1%	(ASTM D-570)

APPLICATION INFORMATION

Mixing Ratio	Component 'A' : Component 'B'=1:1 by volume.
Coverage	Approximately 150-250 ft. ² /gal. depending on condition of substrate.
Pot Life	Approximately 35 to 40 minutes. (60 gram mass). Tack-Free Time: Approximately 4 hours. Open Time: Light foot traffic: 5-7 hours. Rubber-wheel traffic: 8-10 hours.
Cure Time	Immersion and Chemical Exposure: Minimum cure: 3 days

APPLICATION INSTRUCTIONS

SUBSTRATE PREPARATION

Surface must be clean and sound. It may be dry or damp, but free of standing water. Remove dust, laitance, grease, curing compounds, impregnations, waxes and any other contaminants.

Preparation Work: Concrete - Should be cleaned and prepared to achieve a laitance and contaminant free, open textured surface by blast cleaning or equivalent mechanical means.

Steel - Should be cleaned and prepared thoroughly by blast cleaning.

MIXING

Pre-mix each component. Proportion equal parts by volume of Components 'A' and 'B' into a clean mixing container. Mix with a low-speed (400-600 rpm) drill using a Sika paddle for 3 minutes, until uniform in color.

APPLICATION

Apply coating using high-quality roller, brush or spray. Two coats are recommended. Apply second coat as soon as the first coat is tack-free and the traffic of application will not damage the first coat. The second coat, however, must be applied within 48 hours since a longer delay will require additional surface preparation. Do not spray with slip resistant granules mixed into the coating. For use as a seamless flooring system, consult Technical Service.

LIMITATIONS

- Minimum substrate and ambient temperature for application 50°F (10°C).

- Maximum moisture content of concrete substrate by weight when measured with a Tramex CME or CMExpert type concrete moisture meter is 4%.
- Do not apply over wet, glistening surface.
- Material is a vapor barrier after cure.
- Do not apply to porous surfaces exhibiting moisture-vapor transmission during the application. Consult Technical Service.
- Minimum age of concrete prior to application is 21-28 days, depending on curing and drying conditions.
- Do not apply to exterior, on-grade substrates.
- Use oven-dried aggregate only.
- Do not thin with solvents.
- Not an aesthetic product. Color may alter due to variations in lighting and/or UV exposure.
- On 'green or 'damp' concrete, EpoCem can be used as a pore filler to reduce vapor drive and potential osmotic blistering.

BASIS OF PRODUCT DATA

Results may differ based upon statistical variations depending upon mixing methods and equipment, temperature, application methods, test methods, actual site conditions and curing conditions.

OTHER RESTRICTIONS

See Legal Disclaimer.

ENVIRONMENTAL, HEALTH AND SAFETY

For further information and advice regarding transportation, handling, storage and disposal of chemical products, user should refer to the actual Safety Data Sheets containing physical, environmental, toxicological and other safety related data. User must read the current actual Safety Data Sheets before using

any products. In case of an emergency, call CHEMTREC at 1-800-424-9300, International 703-527-3887.

LEGAL DISCLAIMER

- KEEP CONTAINER TIGHTLY CLOSED
- KEEP OUT OF REACH OF CHILDREN
- NOT FOR INTERNAL CONSUMPTION
- FOR INDUSTRIAL USE ONLY
- FOR PROFESSIONAL USE ONLY

Prior to each use of any product of Sika Corporation, its subsidiaries or affiliates ("SIKA"), the user must always read and follow the warnings and instructions on the product's most current product label, Product Data Sheet and Safety Data Sheet which are available at usa.sika.com or by calling SIKA's Technical Service Department at 1-800-933-7452. Nothing contained in any SIKA literature or materials relieves the user of the obligation to read and follow the warnings and instructions for each SIKA product as set forth in the current product label, Product Data Sheet and Safety Data Sheet prior to use of the SIKA product.

SIKA warrants this product for one year from date of installation to be free from manufacturing defects and to meet the technical properties on the current Product Data Sheet if used as directed within the product's shelf life. User determines suitability of product for intended use and assumes all risks. User's and/or buyer's sole remedy shall be limited to the purchase price or replacement of this product exclusive of any labor costs. **NO OTHER WARRANTIES EXPRESS OR IMPLIED SHALL APPLY INCLUDING ANY WARRANTY OF MERCHANTABILITY OR FITNESS FOR A PARTICULAR PURPOSE. SIKA SHALL NOT BE LIABLE UNDER ANY LEGAL THEORY FOR SPECIAL OR CONSEQUENTIAL DAMAGES. SIKA SHALL NOT BE RESPONSIBLE FOR THE USE OF THIS PRODUCT IN A MANNER TO INFRINGE ON ANY PATENT OR ANY OTHER INTELLECTUAL PROPERTY RIGHTS HELD BY OTHERS.**

Sale of SIKA products are subject to the Terms and Conditions of Sale which are available at <https://usa.sika.com/en/group/SikaCorp/termsandconditions.html> or by calling 1-800-933-7452.

Sika Corporation
201 Polito Avenue
Lyndhurst, NJ 07071
Phone: +1-800-933-7452
Fax: +1-201-933-6225
usa.sika.com

Sika Mexicana S.A. de C.V.
Carretera Libre Celaya Km. 8.5
Fracc. Industrial Balvanera
Corregidora, Queretaro
C.P. 76920
Phone: 52 442 2385800
Fax: 52 442 2250537



Product Data Sheet
Sikagard®-62
March 2020, Version 04.02
020606010010000001

Sikagard-62-en-US-(03-2020)-4-2.pdf



PRODUCT DATA SHEET

Sikacrete[®]-211 SCC Plus

One-component, cementitious, polymer-modified, self consolidating concrete mix with an integral migrating corrosion inhibitor

PRODUCT DESCRIPTION

Sikacrete[®]-211 SCC Plus is a one-component, self consolidating concrete containing factory blended coarse aggregate. This self consolidating concrete bag is silica fume and polymer modified and also contains a migrating corrosion inhibitor.

USES

- Full depth repairs
- On grade, above and below grade on concrete
- On horizontal surfaces
- Vertical and overhead surfaces when formed and pumped or poured
- As a structural repair material for parking facilities, industrial plants, walkways, bridges, tunnels, dams, and balconies
- Filler for voids and cavities

CHARACTERISTICS / ADVANTAGES

- Self Consolidating Concrete - Excellent placement characteristics
- Polymer-modified
- Integral penetrating corrosion inhibitor
- Silica fume enhanced
- Prepackaged coarse aggregate. Eliminates the need to extend material in the field. Eliminates the risk of reactive aggregate
- Can be pumped or poured into forms and gets excellent consolidation without vibrating

PRODUCT INFORMATION

Packaging	65 lb. (29.5 kg) bag
Shelf Life	12 months from date of production if stored properly in original, unopened and undamaged sealed packaging
Storage Conditions	Store dry at 40–95 °F (4–35 °C) Protect from moisture. If damp, discard material

TECHNICAL INFORMATION

Compressive Strength	1 day	2,000 psi (13.8 MPa)	(ASTM C-39) 73 °F (23 °C) 50 % R.H.
	7 days	5,500 psi (37.9 MPa)	
	28 days	6,500 psi (44.8 MPa)	
Flexural Strength	1 day	500 psi (3.4 MPa)	(ASTM C-293) 73 °F (23 °C) 50 % R.H.
	7 days	750 psi (5.2 MPa)	
	28 days	1,000 psi (6.9 MPa)	
Splitting tensile strength	7 days	750 psi (5.2 MPa)	(ASTM C-496) 73 °F (23 °C) 50 % R.H.
	28 days	1,000 psi (6.9 MPa)	
Tensile Adhesion Strength	1 day	250 psi (1.7 MPa)	(ASTM C-1583) 73 °F (23 °C) 50 % R.H.
	7 days	300 psi (2.1 MPa)	
Slant Shear Strength	1 day	1,000 psi (6.9 MPa)	(ASTM C-882 modified)*
	7 days	1,500 psi (10.3 MPa)	
	28 days	2,500 psi (17.2 MPa)	
* Mortar scrubbed into substrate at 73 °F (23 °C) and 50 % R.H.			
Shrinkage	28 days	< 0.05 %	(ASTM C-157 modified)
Rapid Chloride Permeability	28 days	< 650 Coulombs	(ASTM C-1202 AASHTO T-277)
Sulfate Resistance	0.006*		(ASTM C-1012)
*Length change after 6 months at 73 °F (23 °C) and 50 % R.H.			
Freeze-Thaw Stability	300 cycles	> 99 %	(ASTM C-666)
Freeze Thaw De-Icing Salt Resistance	50 cycles	2	(ASTM C-672)

APPLICATION INFORMATION

Mixing Ratio	5.5-6 pints (2.6-2.8 L)		
Coverage	0.50 ft³ (0.01 m³) per bag (Coverage figures do not include allowance for surface profile and porosity or material waste)		
Layer Thickness	Min.	Max.	
	1" (25 mm)	8" (203 mm)	
	<ul style="list-style-type: none">▪ Thicker applications have been done successfully.▪ Please consult Sika® Technical Service.		
Consistency	Initial spread	25-30" (6.4-7.6 cm)	(ASTM C-1611)
	Spread at 30 min.	> 15" (3.9 cm)	
Product Temperature	65–75 °F (18–24 °C)		
Ambient Air Temperature	> 45 °F (7 °C)		
Substrate Temperature	> 45 °F (7 °C)		
Pot Life	~ 60 minutes		
	As the temperature will affect the pot life, application temperature:		

- Above 73 °F (23 °C) will reduce the pot life and slump
- Below 73 °F (23 °C) will extend the pot life and slump

BASIS OF PRODUCT DATA

Results may differ based upon statistical variations depending upon mixing methods and equipment, temperature, application methods, test methods, actual site conditions and curing conditions.

LIMITATIONS

- As with all cement based materials, avoid contact with aluminum to prevent adverse chemical reaction and possible product failure. Insulate potential areas of contact by coating aluminum bars, rails, posts, with an appropriate epoxy such as Sikadur® 32 Hi-Mod.
- Refer to Sika® Antisol®-250 W product data sheet for use.

ENVIRONMENTAL, HEALTH AND SAFETY

For further information and advice regarding transportation, handling, storage and disposal of chemical products, user should refer to the actual Safety Data Sheets containing physical, environmental, toxicological and other safety related data. User must read the current actual Safety Data Sheets before using any products. In case of an emergency, call CHEMTREC at 1-800-424-9300, International 703-527-3887.

DIRECTIVE 2004/42/CE - LIMITATION OF EMISSIONS OF VOC

0 g/L

(EPA Method 24)

APPLICATION INSTRUCTIONS

SURFACE PREPARATION

Concrete

- Surface must be clean and sound. Remove all deteriorated concrete, dirt, oil, grease, and other bond-inhibiting materials from the area to be repaired.
- Be sure repair area is not less than 1" (25 mm) deep.
- Preparation work should be done by appropriate means. Obtain an exposed aggregate surface with a minimum surface profile of $\pm 1/8"$ (3 mm) (CSP-7-8) on clean, sound concrete.
- Substrate should be Saturated Surface Dry (SSD) with clean water prior to application. No standing water should remain during application.

Reinforcing Steel

- Steel reinforcement should be thoroughly prepared by mechanical cleaning to remove all traces of rust.
- Where corrosion has occurred, the steel should be high-pressure washed with clean water after mechanical cleaning.
- For priming and protection of reinforcing steel use

Sika® Armatec® 110 EpoCem (consult PDS).

MIXING

- Start mixing with 5.5 pints (2.6 L) of water.
- An additional 0.5 pint (0.2 L) can be added if needed.
- Do not over water as excess water will cause segregation.
- Add Sikacrete®-211 SCC Plus while continuing to mix.
- Mechanically mix to a uniform consistency, for 3 minutes with a low-speed drill (400–600 rpm) and paddle or in appropriate-size mortar mixer or concrete mixer.

APPLICATION

- Pre-wet surface to SSD.
- Ensure good intimate contact with the substrate is achieved. To accomplish this, material should be scrubbed into the substrate or other suitable means should be employed such as vibration of the material or pumping under pressure.
- Tap form lightly while pouring or pumping, do not vibrate.
- Pump with a variable pressure pump.
- Continue pumping until a 3 to 5 psi increase in normal line pressure is evident then STOP pumping.
- Form should not deflect.
- Vent to be capped when steady flow is evident, and forms stripped when appropriate.

CURING TREATMENT

- As per ACI recommendations for Portland cement concrete, curing is required.
- Moist cure with wet burlap and polyethylene, a fine mist of water or Sika® Antisol®-250 W*.
- Curing compounds adversely affect the adhesion of following layers of mortar, leveling mortar or protective coatings.
- Moist curing should commence immediately after finishing.
- Protect newly applied material from direct sunlight, wind, rain and frost.

* Pretesting of curing compound is recommended.

OTHER RESTRICTIONS

See Legal Disclaimer.

LEGAL DISCLAIMER

- KEEP CONTAINER TIGHTLY CLOSED
- KEEP OUT OF REACH OF CHILDREN
- NOT FOR INTERNAL CONSUMPTION
- FOR INDUSTRIAL USE ONLY
- FOR PROFESSIONAL USE ONLY

Prior to each use of any product of Sika Corporation, its subsidiaries or affiliates ("SIKA"), the user must always read and follow the warnings and instructions on the product's most current product label, Product Data Sheet and Safety Data Sheet which are available at usa.sika.com or by calling SIKA's Technical Service Department at 1-800-933-7452. Nothing contained in any SIKA literature or materials relieves the user of the obligation to read and follow the warnings and instructions for each SIKA product as set forth in the current product label, Product Data Sheet and Safety Data Sheet prior to use of the SIKA product.

SIKA warrants this product for one year from date of installation to be free from manufacturing defects and to meet the technical properties on the current Product Data Sheet if used as directed within the product's shelf life. User determines suitability of product for intended use and assumes all risks. User's and/or buyer's sole remedy shall be limited to the purchase price or replacement of this product exclusive of any labor costs.

NO OTHER WARRANTIES EXPRESS OR IMPLIED SHALL APPLY INCLUDING ANY WARRANTY OF MERCHANTABILITY OR FITNESS FOR A PARTICULAR PURPOSE. SIKA SHALL NOT BE LIABLE UNDER ANY LEGAL THEORY FOR SPECIAL OR CONSEQUENTIAL DAMAGES. SIKA SHALL NOT BE RESPONSIBLE FOR THE USE OF THIS PRODUCT IN A MANNER TO INFRINGE ON ANY PATENT OR ANY OTHER INTELLECTUAL PROPERTY RIGHTS HELD BY OTHERS.

Sale of SIKA products are subject to the Terms and Conditions of Sale which are available at <https://usa.sika.com/en/group/SikaCorp/termsandconditions.html> or by calling 1-800-933-7452.

Sika Corporation

201 Polito Avenue
Lyndhurst, NJ 07071
Phone: +1-800-933-7452
Fax: +1-201-933-6225
usa.sika.com



Product Data Sheet

Sikacrete®-211 SCC Plus
August 2022, Version 01.05
020302020010000040

Sikacrete-211SCCPlus-en-US-(08-2022)-1-5.pdf



PRODUCT DATA SHEET

ATTACHMENT C
(4 pages)

Sika® Armatec®-110 EpoCem

BONDING PRIMER AND REINFORCEMENT CORROSION PROTECTION

PRODUCT DESCRIPTION

Sika® Armatec®-110 EpoCem is a cementitious epoxy resin compensated 3-component, solvent-free, coating material with corrosion inhibitor, used as bonding primer and reinforcement corrosion protection.

USES

- Suitable in concrete repair as corrosion protection for reinforcement
- Suitable as a bonding primer on mortar, steel, and on placing fresh, plastic concrete to existing hardened concrete
- Protection to reinforcing steel in areas of thin concrete cover

CHARACTERISTICS / ADVANTAGES

- Contains EpoCem® technology - improved bonding agent
- Extended open times for repair mortars
- Excellent adhesion to concrete and steel
- Contains corrosion inhibitor
- Good resistance to water and chloride penetration
- High shear strength
- Long pot life
- Can be brushed on or applied using spray gun
- Can be used exterior on-grade
- Excellent bonding bridge for cement or epoxy based repair mortars
- High strength, unaffected by moisture when cured
- Non-flammable, solvent free

PRODUCT INFORMATION

Chemical Base	Portland cement, epoxy resin, selected aggregates and additives.				
Packaging	Unit	A	B	C	ABC
	3.5 gal (13.2 L)	47.6 oz (1.4 L)	122.1 oz (3.6 L)	46.82 lb (21.3 kg)	A + B in carton, C in bag
	1.65 gal (6.2 L)	22.7 oz (0.67 L)	57.6 oz (1.7 L)	5.5 lb (2.5 kg) (4 bags)	Factory- proportioned units in a pail
Appearance / Color	Component A			White liquid	
	Component B			Colorless liquid	
	Component C			Gray powder	
Shelf Life	12 months from date of production if stored properly in original, unopened and undamaged sealed packaging				
Storage Conditions	Store dry at 40–95 °F (4–35 °C)				

Protect Component A and B from freezing. If frozen, discard.
Protect Component C from moisture. If damp, discard.

TECHNICAL INFORMATION

Compressive Strength	3 days	4,500 psi (31.0 MPa)	(ASTM C-109) 73 °F (23 °C) 50 % R.H.
	7 days	6,500 psi (44.8 MPa)	
	28 days	8,500 psi (58.6 MPa)	
Flexural Strength	28 days	1,250 psi (8.6 MPa)	(ASTM C-348) 73 °F (23 °C) 50 % R.H.
Splitting Tensile Strength	28 days	600 psi (4.1 MPa)	(ASTM C-496) 73 °F (23 °C) 50 % R.H.
Tensile Adhesion Strength	Bond of steel reinforcement on concrete		
	Sika® Armatec® 110	625 psi (4.3 MPa)	(ASTM C-1583) 73 °F (23 °C) 50 % R.H.
	EpoCem coated		
	Epoxy coated	508 psi (3.5 MPa)	
	Plain reinforcement	573 psi (4.0 MPa)	
Slant Shear Strength	Bonding agent properties (14 d. moist cure, plastic to hardened concrete)		
	Wet on wet	2,800 psi (19.3 MPa)	(ASTM C-882) 73 °F (23 °C) 50 % R.H.
	24 hr. open time	2,600 psi (17.9 MPa)	
Permeability to Water Vapor	Control	7.32 x 10 ⁻¹⁰ ft/sec	
	145 psi (10 bar)	8.92 x 10 ⁻¹⁵ ft/sec	
Diffusion Resistance to Water Vapor	μ H ₂ O ~100		
Permeability to CO ₂	μ CO ₂ ~14,000		
Corrosion Test	Time-to-Corrosion Study <ul style="list-style-type: none"> Sika® Armatec®-110 EpoCem more than tripled the time to corrosion Reduced corrosion rate by over 40 % 		

APPLICATION INFORMATION

Fresh Mortar Density	A+B+C ~125 lb/ft³ (~2.0 kg/l)		
Coverage	Bonding agent	80 ft²/gal (7.4 m²/l)	
	Corrosion Protection	40 ft²/gal (3.7 m²/l)	
	(Coverage figures do not include allowance for surface profile and porosity or material waste)		
Layer Thickness		Min. thickness of 1 coat	Coat
	Bonding agent	20 mils	1
	Corrosion Protection	20 mils	2
Product Temperature	65°-75°F (18°-24°C)		
Ambient Air Temperature	40–95 °F (5–35 °C)		
Substrate Temperature	40–95 °F (5–35 °C)		
Pot Life	~ 90 minutes		
Waiting / Recoat Times	Sika repair mortars and non-fast setting concrete can be applied on Sika® Armatec®-110 EpoCem within a maximum time of:		

Temperature	Maximum Waiting Time
80°- 95 °F (26°- 35 °C)	6 hours
65°-79 °F (18°- 26 °C)	12 hours
50°- 64° F (10°- 17° C)	16 hours
40°- 49° F (4°- 9° C)	wet-on-wet

APPLICATION INSTRUCTIONS

SURFACE PREPARATION

Concrete

- Free from dust, loose material, surface contamination and materials which reduce bond or prevent suction or wetting by repair materials.
- Delaminated, weak, damaged and deteriorated concrete and where necessary sound concrete shall be removed by suitable means.
- Substrate must be Saturated Surface Dry (SSD) with no standing water.

Steel reinforcement

- Rust, scale, mortar, concrete, dust and other loose and deleterious material which reduces bond or contributes to corrosion shall be removed by blast cleaning or other means of mechanical abrasion and reinforcement.
- Should be fully exposed and have all corrosion removed.

MIXING

- Sika® Armatec®-110 EpoCem can be mixed with a low-speed (< 250 rpm) electric drill mixer.
- Shake components A and B thoroughly before opening.
- Pour liquid components A and B into a suitable mixing vessel and mix for 30 seconds.
- While still mixing components A and B slowly add powder component C.
- Mix the three components together for a minimum 3 minutes until blend is uniform and free of lumps, minimizing addition of air.
- Mix only the quantity that you can be applied within the pot life.
- DO NOT ADD WATER.

APPLICATION

As reinforcement corrosion protection

- Apply by stiff-bristle brush or spray at 80 ft² /gal.
- Take special care to properly coat the underside of the totally exposed steel.
- Allow coating to dry 2-3 hours at 73 °F, then apply a second coat at the same coverage.
- Allow to dry again before the repair mortar or concrete is applied.
- Pour or place repair within 7 days

As a bonding primer

- Apply using a stiff-bristle brush or broom. To achieve good bond, Sika® Armatec®-110 EpoCem must be applied well into the substrate, filling all pores and ensure complete coverage of all surface irregularities (minimum layer thickness 1/64" (0.5 mm).
- Spray apply with Goldblatt Pattern Pistol or equal equipment.
- Apply the freshly mixed patching mortar or concrete wet on wet, or up to the maximum recommended open time, onto the bonding slurry.

CURING TREATMENT

Sika® Armatec®-110 EpoCem must be protected against contamination and rain until application of the repair mortar.

CLEANING OF TOOLS

Clean all tools and application equipment with water immediately after use. Hardened material can only be mechanically removed.

LIMITATIONS

- Avoid application in direct sun and/or strong wind and/or rain.
- Do not add water.
- Not a vapor barrier.
- Apply only to sound, prepared substrates.
- Not recommended for use with expansive grouts and SikaQuicks
- Use of semi-dry mortars onto Sika® Armatec®-110 EpoCem must be applied "wet on wet"
- When used in overhead applications with hand placed patching mortars, use "wet on wet" for maximum mortar built thickness.
- Substrate profile as specified by the overlay or repair material is still required.
- As with all cement based materials, avoid contact with aluminum to prevent adverse chemical reaction and possible product failure. Insulate potential areas of contact by coating aluminum bars, rails, posts etc. with an appropriate epoxy such as Sikadur® Hi-Mod 32.

Product Data Sheet

Sika® Armatec®-110 EpoCem

March 2020, Version 01.02

020302020050000003

BUILDING TRUST



BASIS OF PRODUCT DATA

Results may differ based upon statistical variations depending upon mixing methods and equipment, temperature, application methods, test methods, actual site conditions and curing conditions.

OTHER RESTRICTIONS

See Legal Disclaimer.

ENVIRONMENTAL, HEALTH AND SAFETY

For further information and advice regarding transportation, handling, storage and disposal of chemical products, user should refer to the actual Safety Data Sheets containing physical, environmental, toxicological and other safety related data. User must read the current actual Safety Data Sheets before using any products. In case of an emergency, call CHEMTREC at 1-800-424-9300, International 703-527-3887.

DIRECTIVE 2004/42/CE - LIMITATION OF EMISSIONS OF VOC

A+B+C combined _____ 50 g/l

LEGAL DISCLAIMER

- KEEP CONTAINER TIGHTLY CLOSED
- KEEP OUT OF REACH OF CHILDREN
- NOT FOR INTERNAL CONSUMPTION
- FOR INDUSTRIAL USE ONLY
- FOR PROFESSIONAL USE ONLY

Prior to each use of any product of Sika Corporation, its subsidiaries or affiliates ("SIKA"), the user must always read and follow the warnings and instructions on the product's most current product label, Product Data Sheet and Safety Data Sheet which are available at usa.sika.com or by calling SIKA's Technical Service Department at 1-800-933-7452. Nothing contained in any SIKA literature or materials relieves the user of the obligation to read and follow the warnings and instructions for each SIKA product as set forth in the current product label, Product Data Sheet and Safety Data Sheet prior to use of the SIKA product.

SIKA warrants this product for one year from date of installation to be free from manufacturing defects and to meet the technical properties on the current Product Data Sheet if used as directed within the product's shelf life. User determines suitability of product for intended use and assumes all risks. User's and/or buyer's sole remedy shall be limited to the purchase price or replacement of this product exclusive of any labor costs. **NO OTHER WARRANTIES EXPRESS OR IMPLIED SHALL APPLY INCLUDING ANY WARRANTY OF MERCHANTABILITY OR FITNESS FOR A PARTICULAR PURPOSE. SIKA SHALL NOT BE LIABLE UNDER ANY LEGAL THEORY FOR SPECIAL OR CONSEQUENTIAL DAMAGES. SIKA SHALL NOT BE RESPONSIBLE FOR THE USE OF THIS PRODUCT IN A MANNER TO INFRINGE ON ANY PATENT OR ANY OTHER INTELLECTUAL PROPERTY RIGHTS HELD BY OTHERS.**

Sale of SIKA products are subject to the Terms and Conditions of Sale which are available at <https://usa.sika.com/en/group/SikaCorp/termsandconditions.html> or by calling 1-800-933-7452.

Sika Corporation
201 Polito Avenue
Lyndhurst, NJ 07071
Phone: +1-800-933-7452
Fax: +1-201-933-6225
usa.sika.com

Sika Mexicana S.A. de C.V.
Carretera Libre Celaya Km. 8.5
Fracc. Industrial Balvanera
Corregidora, Queretaro
C.P. 76920
Phone: 52 442 2385800
Fax: 52 442 2250537



Product Data Sheet
Sika® Armatec®-110 EpoCem
March 2020, Version 01.02
020302020050000003

SikaArmtec-110EpoCem-en-US-(03-2020)-1-2.pdf



Product Data Sheet

Edition 4.23.2018

SikaQuick® FNP

SikaQuick® FNP

Fast-setting, one-component, polymer-modified, self consolidating, structural repair mortar with fiber and integral corrosion inhibitor for form and pour/pumpable applications

Description	SikaQuick FNP is a self consolidating mortar for form and pour/pumping in concrete repair applications. It provides high pumpability for structural repair of columns and beams.
Where to Use	<ul style="list-style-type: none"> ■ Horizontal, vertical and overhead repairs ■ Parking garages, bridges, beams, columns, tunnels, building facades, retaining walls and other structural applications ■ Pre-placed aggregate applications ■ Marine structures such as piers, dams, sea walls, etc.
Advantages	<ul style="list-style-type: none"> ■ High fluidity for ease of pumping and pouring in congested repairs ■ Fiber reinforced ■ Integral corrosion inhibitor ■ One-component for easy mixing ■ Up to 8" (203mm) in thickness with aggregate - 3" (76mm) neat ■ Freeze/Thaw resistant ■ Extremely low shrinkage ■ Excellent bond strength
Coverage	~0.5 cu.ft. per 55 lb bag.
Packaging	55 lb bag; 48 bags per pallet

Typical Data (Material and curing conditions @ 73°F (23°C) and 50% R.H.)

RESULTS MAY DIFFER BASED UPON STATISTICAL VARIATIONS DEPENDING UPON MIXING METHODS AND EQUIPMENT, TEMPERATURE, APPLICATION METHODS, TEST METHODS, ACTUAL SITE CONDITIONS AND CURING CONDITIONS.

Shelf Life:	1 year in original, unopened packaging.
Storage Conditions:	Store dry at 40°-95°F (4°-35°C).
Condition material:	Condition material to 65°- 75°F before using.
Pot Life	60 minutes
Initial Set (ASTM C 266)	70-100 min
Final Set (ASTM C 266)	2-3 hours
VOC (Method EPA 24)	0 g/L

Compressive Strength (ASTM C 109)	psi (MPa)
Day 1	3,500 (24.1)
Day 7	6,000 (41.4)
Day 28	7,500 (51.7)

Flexural Strength (ASTM C 293)	psi (MPa)
Day 1	700 (4.8)
Day 7	1,300 (9)
Day 28	1,500 (10.3)

Modulus of Elasticity (ASTM C 469)	psi
Day 28	5x10 ⁶ psi

Chloride Perm. (ASTM C 1202/ AASHTO T277)	< 750 coulombs
--	----------------

Freeze Thaw Resistance (ASTM C 666)	98%
--	-----

Scaling Resistance (ASTM C 672)	0 (No Scaling)
--	----------------

Shrinkage (ASTM C 157 modified per ASTM C 928)	< 0.06%
---	---------

Direct Bond Strength (ASTM C 1583)	500-600 psi (3.4 - 4.1 MPa)
---	-----------------------------



PRIOR TO EACH USE OF ANY SIKA PRODUCT, THE USER MUST ALWAYS READ AND FOLLOW THE WARNINGS AND INSTRUCTIONS ON THE PRODUCT'S MOST CURRENT PRODUCT DATA SHEET, PRODUCT LABEL AND SAFETY DATA SHEET WHICH ARE AVAILABLE ONLINE AT [HTTP://USA.SIKA.COM/](http://usa.sika.com/) OR BY CALLING SIKA'S TECHNICAL SERVICE DEPARTMENT AT 800.933.7452 NOTHING CONTAINED IN ANY SIKA MATERIALS RELIEVES THE USER OF THE OBLIGATION TO READ AND FOLLOW THE WARNINGS AND INSTRUCTIONS FOR EACH SIKA PRODUCT AS SET FORTH IN THE CURRENT PRODUCT DATA SHEET, PRODUCT LABEL AND SAFETY DATA SHEET PRIOR TO PRODUCT USE.

How to Use

Surface Preparation

Remove all deteriorated concrete, dirt, oil, grease, and all bond-inhibiting materials from surface. Be sure repair area is not less than 1/4 in. in depth. Preparation work should be done by high pressure water blast, scabbler, or other appropriate mechanical means to obtain an exposed aggregate surface with a minimum surface profile of $\pm 1/8$ in. (CSP-7-8). Saturate surface with clean water. Substrate should be Saturated Surface Dry (SSD) with no standing water during application.

Reinforcing Steel: Steel reinforcement should be thoroughly prepared by mechanical cleaning to remove all traces of rust. Where corrosion has occurred, the steel should be high-pressure washed with clean water after mechanical cleaning. For priming and protection of reinforcing steel use Sika® Armatec® 110 EpoCem (consult Product Data Sheet).

Mixing

Start with 7/8 gal of water and add up to 1 gal per 55lbs bag in a mixing container. Add SikaQuick® FNP while continuing to mix. Mix to a uniform consistency, maximum 3 minutes. Mechanically mix with a low-speed drill (400-600 rpm) a mud paddle.

Application

- Pre-wet surface to SSD.
- Ensure good intimate contact with the substrate. To accomplish this, material should be scrubbed into the substrate or other suitable means should be employed such as vibration of the material or pumping under pressure.
- Vibrate form while pouring or pumping.
- Pump with a variable pressure pump. Continue pumping until a 3 to 5 psi increase in normal line pressure is evident, then STOP pumping.
- Form should not deflect. Vent to be capped when steady flow is evident and forms stripped when appropriate.
- For applications greater than 3" in depth, add 3/8" coarse aggregate. The addition rate is 25 lbs. of aggregate per bag of SikaQuick® FNP. (25 lbs. of 3/8" aggregate is approximately 2.0 gallons by loose volume of aggregate). The aggregate must be non-reactive (reference ASTM C-1260, C-227 and C-289), clean, well graded, saturated surface dry, have low absorption and high density, and comply with ASTM C-33 size number 8 per Table 2. Variances in aggregate may result in different strengths. No additional mix water is required.

Curing

As per ACI recommendations for portland cement concrete, curing is required. Moist cure with wet burlap and polyethylene, a fine mist of water or a water based* compatible curing compound. Curing compounds adversely affect the adhesion of following layers of mortar, leveling mortar or protective coatings. Moist curing should commence immediately after finishing. Protect newly applied material from direct sunlight, wind, rain and frost. *Pretesting of curing compound is recommended.

Limitations

- Application thickness recommended:

	Min	Max
Neat	1/4"	3"
Extended	1"	8"

- Minimum ambient and surface temperatures 40°F (4°C) and rising at time of application. Refer to the American Concrete Institute (ACI) for cold-weather or hot-weather application guidelines.
- Do not add any additives (plasticizers, accelerators, retarders, etc.) or cement to SikaQuick® FNP
- As with all cement based materials, avoid contact with aluminum to prevent adverse chemical reaction and possible product failure. Insulate potential areas of contact by coating aluminum bars, rails, posts, with an appropriate epoxy such as Sikadur® 32 Hi-Mod.
- Egg beater paddle type is not recommended for SikaQuick® FNP as it will introduce a lot of air into the mix

PRIOR TO EACH USE OF ANY SIKA PRODUCT, THE USER MUST ALWAYS READ AND FOLLOW THE WARNINGS AND INSTRUCTIONS ON THE PRODUCT'S MOST CURRENT PRODUCT DATA SHEET, PRODUCT LABEL AND SAFETY DATA SHEET WHICH ARE AVAILABLE ONLINE AT [HTTP://USA.SIKA.COM/](http://usa.sika.com/) OR BY CALLING SIKA'S TECHNICAL SERVICE DEPARTMENT AT 800.933.7452 NOTHING CONTAINED IN ANY SIKA MATERIALS RELIEVES THE USER OF THE OBLIGATION TO READ AND FOLLOW THE WARNINGS AND INSTRUCTIONS FOR EACH SIKA PRODUCT AS SET FORTH IN THE CURRENT PRODUCT DATA SHEET, PRODUCT LABEL AND SAFETY DATA SHEET PRIOR TO PRODUCT USE.

KEEP CONTAINER TIGHTLY CLOSED • KEEP OUT OF REACH OF CHILDREN • NOT FOR INTERNAL CONSUMPTION • FOR INDUSTRIAL USE ONLY

All information provided by Sika Corporation ("Sika") concerning Sika products, including but not limited to, any recommendations and advice relating to the application and use of Sika products, is given in good faith based on Sika's current experience and knowledge of its products when properly stored, handled and applied under normal conditions in accordance with Sika's instructions. In practice, the differences in materials, substrates, storage and handling conditions, actual site conditions and other factors outside of Sika's control are such that Sika assumes no liability for the provision of such information, advice, recommendations or instructions related to its products, nor shall any legal relationship be created by or arise from the provision of such information, advice, recommendations or instructions related to its products. The user of the Sika product(s) must test the product(s) for suitability for the intended application and purpose before proceeding with the full application of the product(s). Sika reserves the right to change the properties of its products without notice. All sales of Sika product(s) are subject to its current terms and conditions of sale which are available at www.usa.sika.com or by calling 800-933-7452.

Prior to each use of any Sika product, the user must always read and follow the warnings and instructions on the product's most current Product Data Sheet, product label and Safety Data Sheet which are available online at www.usa.sika.com or by calling Sika's Technical Service Department at 800-933-7452. Nothing contained in any Sika materials relieves the user of the obligation to read and follow the warnings and instruction for each Sika product as set forth in the current Product Data Sheet, product label and Safety Data Sheet prior to product use.

LIMITED WARRANTY: Sika warrants this product for one year from date of installation to be free from manufacturing defects and to meet the technical properties on the current Product Data Sheet if used as directed within shelf life. User determines suitability of product for intended use and assumes all risks. Buyer's sole remedy shall be limited to the purchase price or replacement of product exclusive of labor or cost of labor. **NO OTHER WARRANTIES EXPRESS OR IMPLIED SHALL APPLY INCLUDING ANY WARRANTY OF MERCHANTABILITY OR FITNESS FOR A PARTICULAR PURPOSE. SIKA SHALL NOT BE LIABLE UNDER ANY LEGAL THEORY FOR SPECIAL OR CONSEQUENTIAL DAMAGES. SIKA SHALL NOT BE RESPONSIBLE FOR THE USE OF THIS PRODUCT IN A MANNER TO INFRINGE ON ANY PATENT OR ANY OTHER INTELLECTUAL PROPERTY RIGHTS HELD BY OTHERS.**

Visit our website at www.usa.sika.com

1-800-933-SIKA NATIONWIDE

Regional Information and Sales Centers. For the location of your nearest Sika sales office, contact your regional center.

Sika Corporation
201 Polito Avenue
Lyndhurst, NJ 07071
Phone: 800-933-7452
Fax: 201-933-6225

Sika Canada Inc.
601 Delmar Avenue
Pointe Claire
Quebec H9R 4A9
Phone: 514-697-2610
Fax: 514-694-2792

Sika Mexicana S.A. de C.V.
Carretera Libre Celaya Km. 8.5
Fracc. Industrial Balvanera
Corregidora, Queretaro
C.P. 76920
Phone: 52 442 2385800
Fax: 52 442 2250537



PRODUCT DATA SHEET

ATTACHMENT E
(5 pages)

SikaQuick® VOH

Fast Setting, one component, cementitious vertical and overhead repair mortar with superior high build properties

PRODUCT DESCRIPTION

SikaQuick® VOH is a fast setting, one component, ready-to-use repair mortar for vertical and overhead applications using specialty cement blends. SikaQuick® VOH LD is a low dust formula also available as a separate item.

USES

- Fast repairs to overhead and vertical concrete and mortar surfaces on grade, above and below grade.
- As a repair material for building facades, parking structures, industrial plants, bridges, etc.
- As a fast setting repair material for new construction defects.

CHARACTERISTICS / ADVANTAGES

- Minimal time required between lifts.
- Fast finishing time
- Time/labor-saving material; application up to 3" (76.2 mm) on vertical surfaces in one layer
- Easy to use; just add water
- High bond strength ensures excellent adhesion
- High early and ultimate strength
- Increased freeze/thaw durability and resistance to deicing salts
- Suitable for exterior and interior applications.
- Overhead thickness up to 2" (50 mm)
- Fiber reinforced and polymer modified
- Contains corrosion inhibitor
- Use in cold temperatures with SikaQuick WinterBoost (20° - 45 °F)
- Low dust version available

APPROVALS / STANDARDS

- Meets ASTM C-928, type R2

PRODUCT INFORMATION

Chemical Base	<ul style="list-style-type: none">▪ SikaQuick® VOH is a polymer modified, cement blends.▪ SikaQuick® VOH LD is a polymer modified, cement blends with dust reduction technology.
Packaging	<ul style="list-style-type: none">▪ 44 lb (20 kg) bag
Appearance / Color	Gray powder
Shelf Life	12 months from date of production if stored properly in original, unopened and undamaged sealed packaging.
Storage Conditions	Store dry at 40–95 °F (4–35 °C)

TECHNICAL INFORMATION

Compressive Strength	73 °F (23 °C)		20 °F (-7 °C) with 1 cup of SikaQuick® Winter Boost	(ASTM C-109) 50 % R.H.
	3 hours	> 1,500 psi (10.3 MPa)	400 psi (2.8 MPa)	
	1 day	> 3,000 psi (20.7 MPa)	1,800 psi (12.4 MPa)	
	7 days	> 4,500 psi (31.0 MPa)	2,400 psi (16.6 MPa)	
	28 days	5,500 psi (37.9 MPa)	4,500 psi (31.0 MPa)	
	* Consult SikaQuick® Winter Boost Product Data Sheet.			
Modulus of Elasticity in Compression	7 days	2.2x10 ⁶ psi (15.2 GPa)		(ASTM C-469)
Flexural Strength	1 day	400 psi (2.8 MPa)		(ASTM C-293)
	7 days	600 psi (4.1 MPa)		73 °F (23 °C)
	28 days	1,000 psi (6.9 MPa)		50 % R.H.
Splitting tensile strength	1 day	200 psi (1.4 MPa)		(ASTM C-496)
	7 days	250 psi (1.7 MPa)		73 °F (23 °C)
	28 days	500 psi (3.4 MPa)		50 % R.H.
Slant Shear Strength	1 day	1,000 psi (6.9 MPa)		(ASTM C-882 modified*)
	7 days	1,600 psi (11.0 MPa)		
	28 days	2,000 psi (13.8 MPa)		
* Mortar scrubbed into substrate at 73 °F (23 °C) and 50 % R.H.				
Pull-Out Resistance	> 250 psi (1.7 MPa) Substrate failure		(ASTM C-1583) 73 °F (23 °C) 50 % R.H.	
Shrinkage	< 0.05 %		(ASTM C-157 modified per ASTM C-928)	
Rapid Chloride Permeability	28 days	Low range		(ASTM C-1202 AASHTO T-277)

APPLICATION INFORMATION

Mixing Ratio	6–6.5 pts (2.8-3.1 L) per bag		
Fresh mortar density	125 lb/ft ³ (2.0 kg/L)		(ASTM C-138)
Coverage	0.44 ft ³ (0.01 m ³) per bag (Coverage figures do not include allowance for surface profile and porosity or material waste)		
Layer Thickness		Min.	Max.
	Overhead	1/8" (3 mm)*	2" (51 mm)
	Vertical	1/8" (3 mm)*	3" (75 mm)
* Minimum thickness is 1/2" (12.7 mm) with the use of SikaQuick® Winter Boost			
Product Temperature	65–75 °F (18–24 °C)		

Ambient Air Temperature	> 45 °F (7 °C) 20 - 45 °F (-6.7 - 7 °C) with the use of SikaQuick® Winter Boost	
Substrate Temperature	> 45 °F (7 °C) 20 - 45 °F (-6.7 - 7 °C) with the use of SikaQuick® Winter Boost	
Set Time	10-25 min	(ASTM C-266)
Final set time	< 35 min	(ASTM C-266)
* To control setting times, cold water should be used in hot weather and hot water used in cold weather.		
Application Time	~ 15 minutes	
Finishing time	20–30 minutes	
Waiting / Recoat Times	Time between lifts	Final set time
	Acrylic water based	4 hrs
	Epoxy/PU based	6 hrs
Compatibility and adhesion testing is always recommended.		

APPLICATION INSTRUCTIONS

SURFACE PREPARATION

- Surface must be clean, sound and free of frost.
- Remove all deteriorated concrete, dirt, oil, grease, and other bond-inhibiting materials from the area to be repaired.
- Preparation work should be done by high pressure water blast, scabbling or other appropriate mechanical means to obtain an exposed aggregate surface profile of $\pm 1/16"$ (1.6 mm) (CSP-5).
- To ensure optimum repair results, the effectiveness of decontamination and preparation should be assessed by a pull-off test.
- Saw cutting of edges is preferred and a dovetail is recommended.
- Substrate should be Saturated Surface Dry (SSD) with clean water prior to application. No standing water should remain during application.

With SikaQuick® Winter Boost

- All the above recommendations must be followed.
- The concrete must be frost free before the application.

PRIMING

- **Reinforcing steel:** Steel reinforcement should be thoroughly prepared by mechanical cleaning to remove all traces of rust. Where corrosion has occurred due to the presence of chlorides, the steel should be high pressure washed with clean water after mechanical cleaning. For priming of reinforcing steel use Sika® Armatex® 110 EpoCem (consult PDS).
- **Concrete Substrate:** A scrub coat of SikaQuick® VOH / SikaQuick® VOH LD can be applied prior to placement of the mortar. The repair mortar must be applied into the wet scrub coat before it dries.

MIXING

- Wet down all tools and mixer to be used.
- Mix mechanically with a low-speed drill (400–600 rpm) and mixing paddle or mortar mixer.
- Mix to a uniform consistency, maximum 3 minutes.
- Manual mixing can be tolerated only for less than a full unit.
- Thorough mixing and proper proportioning of the powder and liquid is necessary.
- Inaccurate proportioning of the powder to liquid will result in a finished product that may not conform to the typical published performance property values.

With water

- Start mixing with 6 pints (2.8 L) of water per bag.
- Adjust the water dosage by a maximum amount of +/- 1/2 pint, if necessary, to achieve the desired consistency.
- Do not over-water. Over-watering may result in difficulty handling and/or not meeting stated property values.

With Sika Latex R

- Start mixing with 6 pints (2.8 L) of Sika Latex® R per bag.
- Adjust the Sika Latex® R dosage by a maximum amount of +/- 1/2 pint, if necessary, to achieve the desired consistency.
- Do not overdose with SikaLatex® R. Using too much SikaLatex®-R may result in difficulty handling and/or not meeting typical published performance property values.

With SikaQuick® Winter Boost

- Pour the recommended volume of clean, potable water [$> 34^{\circ}\text{F}$ (-1°C)] into a suitably sized and clean mixing container.
- Add 1/2 or 1 cup per bag into the water and mix until it is dissolved.
- Add the contents of the SikaQuick® VOH / SikaQuick® VOH LD bag while continuing to mix.

Product Data Sheet

SikaQuick® VOH

September 2020, Version 01.04

020302040040000019

- Refer to the current Product Data Sheet for complete and detailed instructions on the use of the SikaQuick® Winter Boost.

APPLICATION

- The mixed SikaQuick® VOH / SikaQuick® VOH LD must be worked well into the prepared substrate, filling all pores and voids.
- Compact well. Force material against edge of repair working towards the center. Thoroughly compact the mortar around exposed reinforcement.
- After filling repair, consolidate, then screed.
- Finish with steel, magnesium, wood, plastic floats, or damp sponges, depending on the desired surface texture.

MULTIPLE LIFTS

- Where multiple lifts are required, score top surface on each lift to produce a roughened substrate for next lift.
- Allow preceding lift to harden and achieve initial set before applying fresh material.
- SSD previous lift by lightly misting with clean water. Remove all standing droplets.
- Repeat procedure until desired installation thickness is achieved. Finish the final lift of SikaQuick® VOH / SikaQuick® VOH LD as described above.
- If previous layers are over 6 hours old, mechanically prepare the substrate and dampen.

CURING TREATMENT

- As per ACI recommendations for Portland cement concrete, curing is required.
- Moist cure with wet burlap and polyethylene, a fine mist of water or Sika® Antisol®-250 W*.
- Curing compounds adversely affect the adhesion of following lifts of mortar, leveling mortar or protective coatings.
- Moist curing should commence immediately after finishing.
- Protect freshly applied mortar from direct sunlight, wind, rain and frost.

* Pretesting of curing compound is recommended.

CLEANING OF TOOLS

- Uncured product may be cleaned from tools and surfaces with water.
- Cured product must be removed mechanically.

LIMITATIONS

- Do not use solvent based curing compounds.
- As with all cement based materials, avoid contact with aluminum to prevent adverse chemical reaction and possible product failure. Insulate potential areas of contact by coating aluminum bars, rails, posts etc. with an appropriate epoxy such as Sikadur® Hi-Mod 32.
- Remixing product after it begins to set is prohibited.
- Bonding agents like Sika® Armatec® 110 EpoCem and others, which cure at a slower rate than SikaQuick®

- VOH / SikaQuick® VOH LD, should not be used. If bonding agents are used, follow cure times for the bonding agents used as a guide prior to putting SikaQuick® VOH / SikaQuick® VOH LD in service. Assure suitability with the manufacturer of the bonding agent.
- Not a vapor barrier
- If a bonding agent is absolutely necessary, and surfaces are not scheduled to receive a vapor barrier coating, consider Sikadur® 32, Hi-Mod and moist cure for a minimum 24 hours prior to putting SikaQuick® VOH / SikaQuick® VOH LD into service.
- SikaQuick® VOH / SikaQuick® VOH LD is not a vapor barrier after cure.
- Ensure temperature do not drop below 20°F the first 3 hours after application of the SikaQuick® VOH mixed with SikaQuick® Winter Boost.
- Refer to Sika® Antisol®-250 W product data sheet for use.

BASIS OF PRODUCT DATA

Results may differ based upon statistical variations depending upon mixing methods and equipment, temperature, application methods, test methods, actual site conditions and curing conditions.

OTHER RESTRICTIONS

See Legal Disclaimer.

ENVIRONMENTAL, HEALTH AND SAFETY

For further information and advice regarding transportation, handling, storage and disposal of chemical products, user should refer to the actual Safety Data Sheets containing physical, environmental, toxicological and other safety related data. User must read the current actual Safety Data Sheets before using any products. In case of an emergency, call CHEMTREC at 1-800-424-9300, International 703-527-3887.

LEGAL DISCLAIMER

- KEEP CONTAINER TIGHTLY CLOSED
- KEEP OUT OF REACH OF CHILDREN
- NOT FOR INTERNAL CONSUMPTION
- FOR INDUSTRIAL USE ONLY
- FOR PROFESSIONAL USE ONLY

Prior to each use of any product of Sika Corporation, its subsidiaries or affiliates ("SIKA"), the user must always read and follow the warnings and instructions on the product's most current product label, Product Data Sheet and Safety Data Sheet which are available at usa.sika.com or by calling SIKA's Technical Service Department at 1-800-933-7452. Nothing contained in any SIKA literature or materials relieves the user of the obligation to read and follow the warnings and instructions for each SIKA product as set forth in the current product label, Product Data Sheet and Safety

Data Sheet prior to use of the Sika product.

Sika warrants this product for one year from date of installation to be free from manufacturing defects and to meet the technical properties on the current Product Data Sheet if used as directed within the product's shelf life. User determines suitability of product for intended use and assumes all risks. User's and/or buyer's sole remedy shall be limited to the purchase price or replacement of this product exclusive of any labor costs.

NO OTHER WARRANTIES EXPRESS OR IMPLIED SHALL APPLY INCLUDING ANY WARRANTY OF MERCHANTABILITY OR FITNESS FOR A PARTICULAR PURPOSE. Sika SHALL NOT BE LIABLE UNDER ANY LEGAL THEORY FOR SPECIAL OR CONSEQUENTIAL DAMAGES. Sika SHALL NOT BE RESPONSIBLE FOR THE USE OF THIS PRODUCT IN A MANNER TO INFRINGE ON ANY PATENT OR ANY OTHER INTELLECTUAL PROPERTY RIGHTS HELD BY OTHERS.

Sale of Sika products are subject to the Terms and Conditions of Sale which are available at <https://usa.sika.com/en/group/SikaCorp/termsandconditions.html> or by calling 1-800-933-7452.

Sika Corporation

201 Polito Avenue
Lyndhurst, NJ 07071
Phone: +1-800-933-7452
Fax: +1-201-933-6225
usa.sika.com

Sika Mexicana S.A. de C.V.

Carretera Libre Celaya Km. 8.5
Fracc. Industrial Balvanera
Corregidora, Queretaro
C.P. 76920
Phone: 52 442 2385800
Fax: 52 442 2250537



Product Data Sheet

SikaQuick® VOH
September 2020, Version 01.04
020302040040000019

SikaQuickVOH-en-US-(09-2020)-1-4.pdf

